

AN AUTOMOTIVE DEALERSHIP FOR

Roger Beasley VOLVO

OF GEORGETOWN

INTERSTATE HIGHWAY 35 SOUTH
GEORGETOWN, TEXAS

OWNER/ PARTNER:
DAVID STEIN


ARCHITECT:



CIVIL ENGINEERING:



STRUCTURAL ENGINEERING:

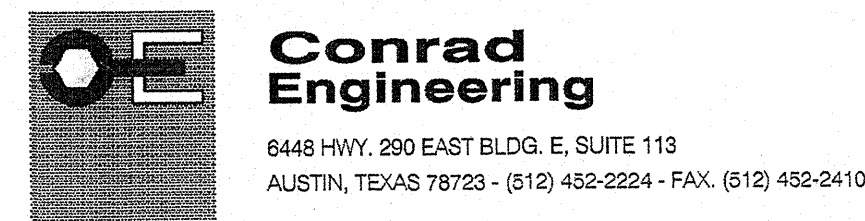

M.E.P. ENGINEERING:

MYERS & ASSOCIATES
455 HIGHWAY 195, SUITE B
GEORGETOWN, TEXAS 78628
PHONE: (512) 930-2399 FAX: (512)


AS-BUILTS

BUILDING CODE DESIGN CRITERIA			
BUILDING CODE:	1994 STANDARD, 1994 STANDARD PLUMBING		
AMENDMENTS:	C2A "RESTRICTED COMMERCIAL FIRST HEIGHT		
ZONING CLASSIFICATION:	16.45 - ACRES		
PROJECT LOT SIZE:			
FIRE ZONE			
BUILDING PRINCIPLE USE:	AUTOMOBILE SHOWROOM AND AND AUTOMOBILE REPAIR GARAGE PARTS		
BUILDING OCCUPANCY:	M2.0		
OCCUPANCY TYPE:	S-2 BUSINESS		
TYPE OF CONSTRUCTION:	TYPE IV - UNPROTECTED		
MAX. BLDG. HEIGHT (TABLE 502)	UNSPRINKLERED	SPRINKLERED	
'S' BUSINESS	45'-2 STORIES	60'-0 STORIES	
'S' STORAGE	45'-2 STORIES	60'-4 STORIES	
'S' S-2 (LOW HAZARD)	45'-2 STORIES	60'-4 STORIES	
MAX. BLDG. AREA (TABLE 502)	'S' BUSINESS	17,000 SQ. FT.	34,000 SQ. FT.
'S' STORAGE	'S' BUSINESS	16,000 SQ. FT.	32,000 SQ. FT.
GENERAL AREA	'S' BUSINESS	34,000 SQ. FT.	68,000 SQ. FT.
MODIFICATION (4/2/1997/7-0-200)	'S' STORAGE	32,000 SQ. FT.	64,000 SQ. FT.
PROPOSED BLDG. HEIGHT:	'S' BUSINESS	2-STORY 24'-0" AT PARAPET	
'S' STORAGE (REPAIR GARAGE)	'S' STORAGE	1-STORY 24'-0" AT PARAPET	
OCCUPANCY LOAD CALCULATION:	AREA	OCC. LOAD	
TYPE			
GROUND FLOOR BUSINESS:	8,209 SQ.FT.	85 (100 GROSS)	
GROUND FLOOR S-2 LOW HAZARD STORAGE: (PARTS)	2,445 SQ.FT.	9 (100 GROSS)	
GROUND FLOOR SPECIAL STORAGE (AUTO REPAIR AREA):	13,043 SQ.FT.	44 (100 GROSS)	
RECEPTION MEZZANINE	456 SQ.FT.	5 (100 GROSS)	
TOTAL GROUND FLOOR USABLE AREA	24,173 SQ.FT.	141 OCCUPANTS	
SECOND FLR. BUSINESS	3,038 SQ.FT.	31 (100 GROSS)	
TOTAL BUILDING USABLE SPACE	27,208 SQ.FT.	172 OCCUPANTS	
MEAN OF EGRESS: (GROSS WIDTH PER PERSON SERVED)	REQ'D.	MIN. WIDTH	PROVIDED
GROUND FLOOR BUSINESS:	18.6 (IN.)	(2) 36"	(8) 36"
SECOND FLOOR BUSINESS: (PARTS STORAGE)	8.8 (IN.)	(1) 36"	(1) 36"
GROUND FLOOR STORAGE: (AUTO REPAIR AREA):	18.0 (IN.)	(2) 36"	(3) 36"
GROUND FLOOR STORAGE (AUTO REPAIR AREA):	8.8 (IN.)	(2) 36"	(2) 36"
PLUMBING FIXTURE CALCULATION (TABLE 407)	W.C.	LAVS.	URINALS
BUSINESS OCCUPANCY:			
REQUIRED PLUMBING FIXTURES			
FIRST FLOOR	M-2, F-3	M-2, F-3	M-2, F-3
SECOND FLOOR	M-1, F-3	M-1, F-3	M-2, F-3
PROVIDED PLUMBING FIXTURES			
FIRST FLOOR	M-2, F-3	M-2, F-3	M-1, F-3
SECOND FLOOR	M-2, F-3	M-2, F-3	M-2, F-3
STORAGE (AUTO REPAIR AND PARTS)	W.C.	LAVS.	URINALS
REQUIRED PLUMBING FIXTURES			
PROVIDED PLUMBING FIXTURES	M-1, F-1	M-1, F-1	M-2, F-3
HANDICAPPED REGULATIONS:	M-2, F-1	M-2, F-1	M-1, F-3
STAND PIPES:			
SPRINKLER LOCATIONS:	NONE		
EMERGENCY POWER:	NONE		
FIRE ALARM:	NONE		
DESIGN LOADS:			
FIRE RESISTIVE REQUIREMENTS:			
Structure Members:			
Columns	NO HRS.		
Floor System	NO HRS.		
Roof System	NO HRS.		
Exterior Walls	NO HRS.		
Ex-Well Opening Protection			
NO RATING DUE TO PROXIMITY TO FIRE SEPARATION DISTANCE			
Partitions			
NO			
Vertical Shafts			
1 HOUR			
Celling			
NON-COMBUSTIBLE			
OCCUPANCY SEPARATION:			
BUSINESS TO S-2 LOW HAZARD STORAGE:	2 HOUR		
BUSINESS TO SPECIAL STORAGE (AUTO REPAIR AREA):	2 HOUR		
S-2 LOW HAZARD STORAGE TO SPECIAL STORAGE (AUTO REPAIR AREA):	2 HOUR		

SHEET INDEX		
CIVIL	ARCHITECTURAL	ENGINEERING
COVER	COVER	STRUCTURAL
2 TITLE SHEET / NOTES	A1.0 SITE PLAN (ARCHITECTURAL)	S1.0 STRUCTURAL NOTES
3 EROSION CONTROL PLAN	L1.0 LANDSCAPE PLAN	S2.0 PIER PLAN
4 DIMENSION / PAVING PLAN	L1.1 LANDSCAPE PLANTING DETAILS	S3.0 FOUNDATION PLAN
5 GRADING PLAN	A2.0 DIMENSION CONTROL PLAN PLAN	S4.0 FOUNDATION DETAILS
6 UTILITY PLAN	A2.1 FIRST FLOOR PLAN - SHOWROOM/ SALES: 1/4" = 1'-0"	S4.1 FOUNDATION DETAILS
7 POND DETAILS	A2.2 FIRST FLOOR PLAN - SERVICE DEPARTMENT: 1/4" = 1'-0"	S5.0 WATER QUALITY POND PLAN AND DETAILS
8 TxDOT DRIVEWAY DETAILS	A2.3 SECOND FLOOR PLAN	
8a TxDOT DRIVEWAY PROFILE	A2.4 ENLARGED RESTROOM PLANS/ INTERIOR ELEVATIONS	
9 STANDARD DETAIL SHEET	A3.0 EXTERIOR ELEVATIONS	MECHANICAL ENGINEERING:
	A4.0 BUILDING CROSS SECTIONS	M1.0 FIRST FLOOR HVAC PLAN
	A4.1 BUILDING CROSS SECTIONS	M1.1 SECOND FLOOR HVAC PLAN
	A4.2 WALL SECTIONS	M2.0 MECHANICAL DETAILS
	A4.3 WALL SECTIONS	M2.1 MECHANICAL SCHEDULES
	A4.4 WALL SECTIONS	M2.2 MECHANICAL SCHEDULES
	A5.0 SECTION DETAILS	
	A5.1 FIRST & SECOND FLOOR REFLECTED CEILING PLAN	ELECTRICAL ENGINEERING:
	A7.0 ROOF PLAN	E1.0 SITE PLAN - ELECTRICAL
	A7.1 PRE-ENGINEERED METAL BUILDING DETAILS	E2.0 FIRST FLOOR LIGHTING PLAN
	A8.0 DOOR & WINDOW SCHEDULES	E2.1 SECOND FLOOR LIGHTING PLAN
	A8.1 DOOR & WINDOW HEAD, JAMB & SILL DETAILS	E3.0 FIRST FLOOR POWER PLAN
	A8.2 DETAILS	E3.1 SECOND FLOOR POWER PLAN
	A8.3 ROOM FINISH SCHEDULE	E4.0 ELECTRICAL SCHEDULES
	A9.0 FIRST & SECOND FLOOR FINISH PLAN	E4.1 ELECTRICAL PANELS & RISER
	A9.1 A.D.A. REQUIREMENTS	E4.2 ELECTRICAL RISER DIAGRAM & SCHEDULES
		PLUMBING
		P1.0 FIRST FLOOR PLUMBING PLAN
		P1.1 SECOND FLOOR PLUMBING PLAN
		P2.0 PLUMBING WASTE WATER ISOMETRIC
		P2.1 PLUMBING HW & CW ISOMETRIC
		P2.2 PLUMBING DETAILS
		P2.3 PLUMBING SCHEDULES

ROGER BEASLEY VOLVO - GEORGETOWN

SITE DEVELOPMENT PLAN WATER POLLUTION ABATEMENT PLAN

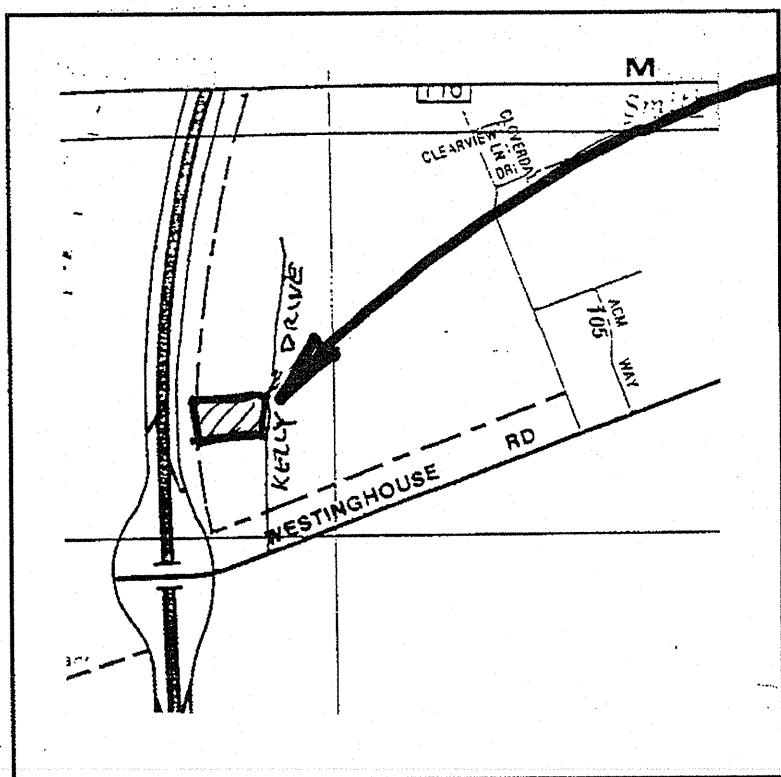

LOCATION MAP

GENERAL NOTES:

1. THIS PROJECT IS LOCATED IN THE FRIDAY CREEK WATERSHED. THIS SITE IS NOT OVER THE EDWARDS AQUIFER RECHARGE ZONE.
2. ALL RESPONSIBILITY FOR THE ADEQUACY OF THESE PLANS REMAINS WITH THE ENGINEER WHO PREPARED THEM. IN REVIEWING THESE PLANS, THE CITY OF GEORGETOWN MUST RELY ON THE ADEQUACY OF THE WORK OF THE DESIGN ENGINEER.
3. CONTRACTOR SHALL CALL THE ONE CALL CENTER (472-2822) FOR UTILITY LOCATIONS PRIOR TO ANY WORK IN CITY EASEMENTS OR STREET R.O.W.
4. FOR SLOPES OR TRENCHES GREATER THAN FIVE FEET IN DEPTH, ALL CONSTRUCTION OPERATION SHALL BE ACCOMPLISHED IN ACCORDANCE WITH APPLICABLE REGULATIONS OF THE U.S. OCCUPATIONAL SAFETY AND HEALTH ADMINISTRATION (OSHA). (OSHA STANDARDS MAY BE PURCHASED FROM THE GOVERNMENT PRINTING OFFICE, INFORMATION AND RELATED REFERENCE MATERIALS MAY BE PURCHASED FROM OSHA, 811 EAST 6TH STREET, AUSTIN, TEXAS.)
5. THIS SITE IS NOT WITHIN THE BOUNDARIES OF THE 100 YEAR FEMA FLOOD PLAIN. PANEL NO. 48491C02300, SEPT 27, 1991.
6. THE CONTRACTOR MUST INSURE PROPER PERMITS ARE POSTED ON SITE.

SEQUENCE OF CONSTRUCTION:

1. Install temporary erosion controls.
2. Pre construction meeting with City, Engineer, and Contractor.
3. Rough grade site.
4. Construct utilities, building & base parking.
5. Complete landscape and final parking.
6. Remove E/S controls.

AMERICANS W/ DISABILITIES ACT & TEXAS ACCESSIBILITY STANDARDS

The applicant, property owner, and occupant of the premises are responsible with all laws, regulations, and restrictions which may be applicable to the property and its use in regard to the above accessibility regulations.

CONSTRUCTION NOTES:

The contractor shall verify the size and location of all existing utilities prior to utility excavation. Any discrepancies with any information shown on the plans shall be reported immediately to the ENGINEER. Pavement and foundation design shall be performed by others.

TEMPORARY EROSION CONTROL:

The contractor shall install erosion/sedimentation controls and tree/natural area protective fencing prior to any site preparation work (clearing, grading or excavation).

The placement of erosion/sedimentation controls shall be in accordance with the C.O.A. Environmental Criteria Manual, the approved Erosion and Sedimentation Control Plan, The Village's NPS Pollution Control Permit, Village ordinances, and the Village TCSS Manual.

A pre-construction conference shall be held on-site with the contractor, design engineer/permit applicant and Village Building Official after installation of the erosion/sedimentation controls and tree/natural area protection measures and prior to beginning any site preparation work. The contractor shall notify the Village Building Official, 263-2151 at least 48 hours prior to the meeting date.

Any significant variation in materials or locations of controls or fences from those shown on the approved plans must be approved by the Engineer, VOSC & Village Engineer.

The contractor is required to inspect the controls and fences at weekly intervals and after significant rainfall events to insure that they are functioning properly. The person(s) responsible for maintenance of controls and fences shall immediately make any necessary repairs to damaged areas. Silt accumulation at controls must be removed when the depth reaches six (6) inches.

PERMANENT EROSION CONTROL:

Permanent Erosion Control: All disturbed areas shall be restored as noted below:

- (a) A minimum of four inches of topsoil shall be placed in all drainage channels (except rock) and between the curb and right-of-way line.

- (b) The seeding for permanent erosion control shall be applied over areas disturbed by construction as follows:
 1. From September 15 to March 1, seeding shall be with a combination of 2 pounds per 1000 square feet of unhusked Bermuda and 7 pounds per 1000 feet of Winter rye with a purity of 95% with 90% germination.
 2. From March 2 to September 14, seeding shall be with husked Bermuda at a rate of 3 pounds per 1000 square feet with a purity of 95% with 85% germination.
- (c) Fertilizer shall be slow release granular or pellet type and shall have an analysis of 15-15-15 and shall be applied at the rate of 23 pounds per acre once at the time of planting and again once during the time of establishment.

- (d) The planted area shall be irrigated or sprinkled in a manner that will not erode the topsoil, but will sufficiently soak the soil to a depth of six inches. The irrigation shall occur at ten-day intervals during the first two months. Rainfall occurrences of 1/2 inch or more shall postpone the watering schedule for one week.
- (e) Mulch type used shall be cellulose fiber, applied at a rate of 45 to 80 pounds per 1000 square yard.
- (f) Restoration shall be acceptable when the grass has grown at least 1 1/2 inches high with 95% coverage, provided no bare spots larger than 16 square feet exist.
- (g) When required, native grass seeding shall comply with requirements of the City of Austin Environmental Criteria Manual.

The contractor shall dispose of surplus excavated material from the site to a suitable location.

EDWARDS AQUIFER NOTE:

The site is located in the Edwards Aquifer contributing zone and is < 5 acres, therefore no TNRC Permit is required.

Texas Natural Resource Conservation Commission

Water Pollution Abatement Plan

General Construction Notes

1. Written construction notification must be given to the appropriate TNRC regional office no later than 48 hours prior to commencement of the regulated activity. Information must include the date on which the regulated activity will commence, the name of the approved plan for the regulated activity, and the name of the prime contractor and the name and telephone number of the contact person.
2. All contractors conducting regulated activities associated with this project must be provided with complete copies of the approved Water Pollution Abatement Plan and the TNRC letter indicating the specific conditions of its approval. During the course of these regulated activities, the contractors are required to keep on-site copies of the approved plan and approval letter.
3. If any sensitive feature is discovered during construction, all regulated activities near the sensitive feature must be suspended immediately. The appropriate TNRC regional office must be immediately notified of any sensitive features encountered during construction. The regulated activities near the sensitive feature may not proceed until the TNRC has reviewed and approved the methods proposed to protect the sensitive feature and the Edwards Aquifer from any potentially adverse impacts to water quality.
4. No temporary aboveground hydrocarbon and hazardous substance storage tank system is installed within 150 feet of a domestic, industrial, irrigation, or public water supply well, or other sensitive feature.
5. Prior to commencement of construction, all temporary erosion and sedimentation (E&S) control measures must be properly selected, installed, and maintained in accordance with the manufacturers specifications and good engineering practices. Controls specified in the temporary storm water section of the approved Edwards Aquifer Protection Plan are required during construction. If inspections indicate a control has been used inappropriately, or incorrectly, the applicant must replace or modify the control for site situations. The controls must remain in place until disturbed areas are revegetated and the areas have become permanently stabilized.
6. If sediment escapes the construction site, off-site accumulations of sediment must be removed at a frequency sufficient to minimize offsite impacts to water quality (e.g., fugitive sediment in street being washed into surface streams or sensitive features by the next rain).
7. Sediment must be removed from sediment traps or sedimentation ponds not later than when design capacity has been reduced by 50%. A permanent stake must be provided that can indicate when the sediment occupies 50 % of the basin volume.

8. Litter, construction debris, and construction chemicals exposed to stormwater shall be prevented from becoming a pollutant source for stormwater discharges (e.g., screening outfalls, picked up dirt).

9. All spoils (excavated material) generated from the project site must be stored on-site with proper E&S controls. For storage or disposal of spoils at another site on the Edwards Aquifer Recharge Zone, the owner of the site must receive approval of a water pollution abatement plan for the placement of fill material or mass grading prior to the placement of spoils at the other site.

10. Stabilization measures shall be initiated as soon as practicable in portions of the site where construction activities have temporarily or permanently ceased, but in no case more than 14 days after the construction activity in that portion of the site has temporarily or permanently ceased. Where the initiation of stabilization measures by the 14th day after construction activity temporary or permanently ceases is precluded by weather conditions, stabilization measures shall be initiated as soon as practicable. Where construction activity on a portion of the site is temporarily ceased, and earth disturbing activities will be resumed within 21 days, temporary stabilization measures do not have to be initiated on that portion of site. In areas experiencing droughts where the initiation of stabilization measures by the 14th day after construction activity has temporarily or permanently ceased is precluded by seasonal arid conditions, stabilization measures shall be initiated as soon as practicable.

11. The following records shall be maintained and made available to the TNRC upon request: the dates when major grading activities occur; the dates when construction activities temporarily or permanently cease on a portion of the site; and the dates when stabilization measures are initiated.

12. The holder of any approved Edwards Aquifer protection plan must notify the appropriate regional office in writing and obtain approval from the executive director prior to initiating any of the following:

A. any physical or operational modification of any water pollution abatement structure(s), including but not limited to ponds, dams, berms, sewage treatment plants, and diversionary structures;

B. any change in the nature or character of the regulated activity from that which was originally approved or a change which would significantly impact the ability of the plan to prevent pollution of the Edwards Aquifer;

C. any development of land previously identified as undeveloped in the original water pollution abatement plan.

Austin Regional Office
1921 Cedar Bend, Suite 150
Austin, Texas 78758-5336
Phone: (512) 338-2829
Fax: (512) 339-3795
San Antonio Regional Office
140 Helmer, Suite 360
San Antonio, Texas 78232-5042
Phone: (210) 480-3096
Fax: (210) 545-4329

THESE GENERAL CONSTRUCTION NOTES MUST BE INCLUDED ON THE CONSTRUCTION PLANS PROVIDED TO THE CONTRACTOR AND ALL SUBCONTRACTORS.

FIRE PROTECTION NOTES:

1. Hydrants must be installed with the center of the four-inch opening at least 18 inches above finished grade. The four-inch opening must face the driveway or street with three to six-foot setbacks from the curbsides. No obstruction is allowed within three feet of any hydrant and the four-inch opening must be totally unobstructed from the street.
2. TIMING OF INSTALLATION: When fire protection facilities are installed by the developer, such facilities shall include all surface access roads which shall be installed and made serviceable prior to and during the time of construction. Where alternative methods of protection, as approved by the Fire Chief, are provided, the above may be modified or waived.
3. All pervious/decorative paving shall be engineered and installed for 80,000 lb. live-vehicle loads.
4. Commercial dumpsters and containers with an individual capacity of 1.5 cubic yards or greater shall not be stored or placed within 10 feet of opening, combustible walls, or combustible eave lines.
5. Vertical clearance required for fire apparatus is 13 feet, 6 inches for full width of access drive.

INDEX TO DRAWINGS

SHEET NO.	DESCRIPTION
COVER	TITLE SHEET/NOTES
2	EROSION CONTROL PLAN
3	DIMENSION / PAVING PLAN
4	GRADING PLAN
5	UTILITY PLAN
6	DRAINAGE AREA MAP
7	POND DETAILS
8	TxDOT DRIVEWAY DETAILS
9	STANDARD DETAIL SHEET

SITE ADDRESS:
NOT YET ASSIGNED

LEGAL DESCRIPTION:

LOT 3, BLOCK "A", KELLEY TRUST,
PHASES ONE, TWO, & THREE
CABINET S, SLIDES 339-341

SUBMITTAL DATE: _____

SUBMITTED BY:

STEVE WENZEL, P.E.



10.2.02
DATE

APPROVED BY:

CITY OF GEORGETOWN

DATE

APPROVED BY:

ELECTRIC DEPT.

DATE

APPROVED BY:

CITY OF GEORGETOWN, PLANNER

DATE

APPROVED BY:

FIRE DEPT.

DATE

REVISIONS/CORRECTIONS

NO.	DESCRIPTION	CITY OF GEORGETOWN

Wenzel
Engineering Inc.

7005 Kenosha Pass
Austin, Texas 78749
512 - 301-7480


CRUSHED LIMESTONE BASE
Base material should be composed of crushed limestone meeting the requirements of TxDOT Item 247, Type A, Grade 1. The base should be compacted to a minimum of 95 percent of the maximum density as determined by the modified moisture/density relation (ASTM D 1557) at -3 to +3 percent of optimum moisture content. (As an option, compaction to at least 100 percent of the TEX 113E maximum dry density may be considered).

L LIGHT DUTY FLEXIBLE PAVEMENT DETAIL


C CONCRETE PAVEMENT TRAFFIC AREAS DETAIL
NTS

CITY OF GEORGETOWN NOTE:
ALL FIRE LANE PAVING MUST BE INSTALLED
PRIOR TO STEEL ERECTION.


SCALE: 1" = 30'

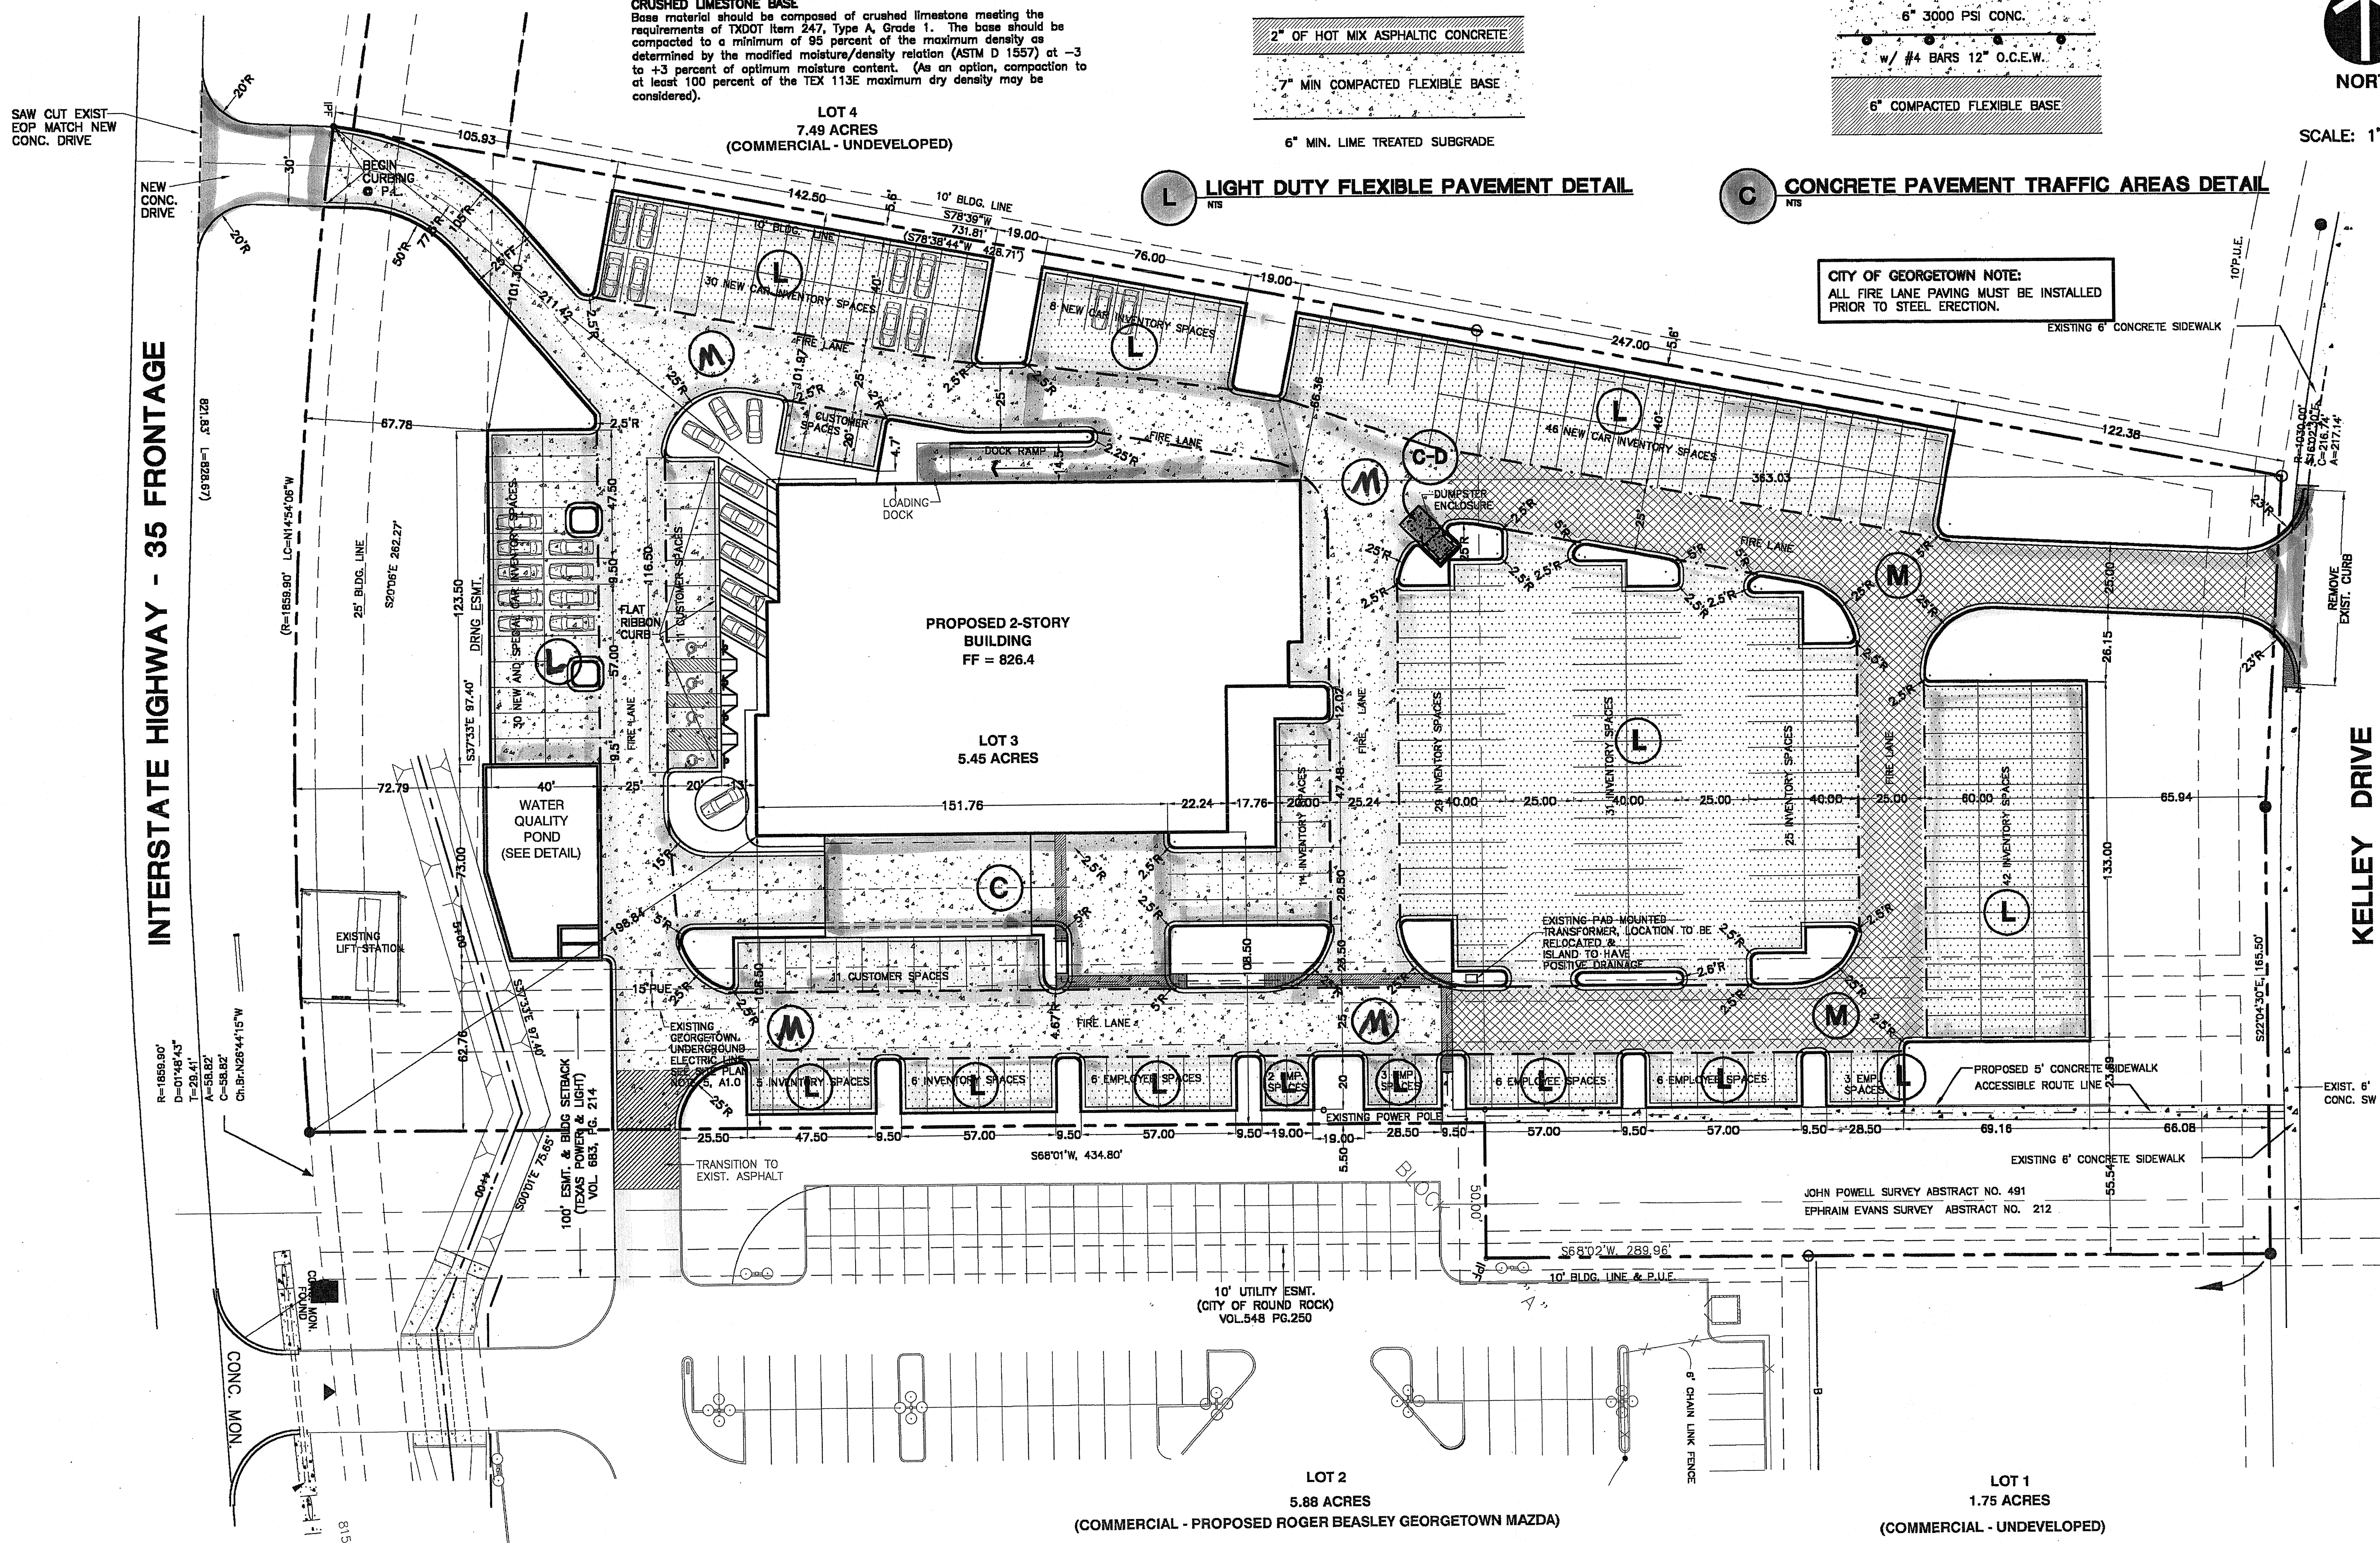

3 of 9

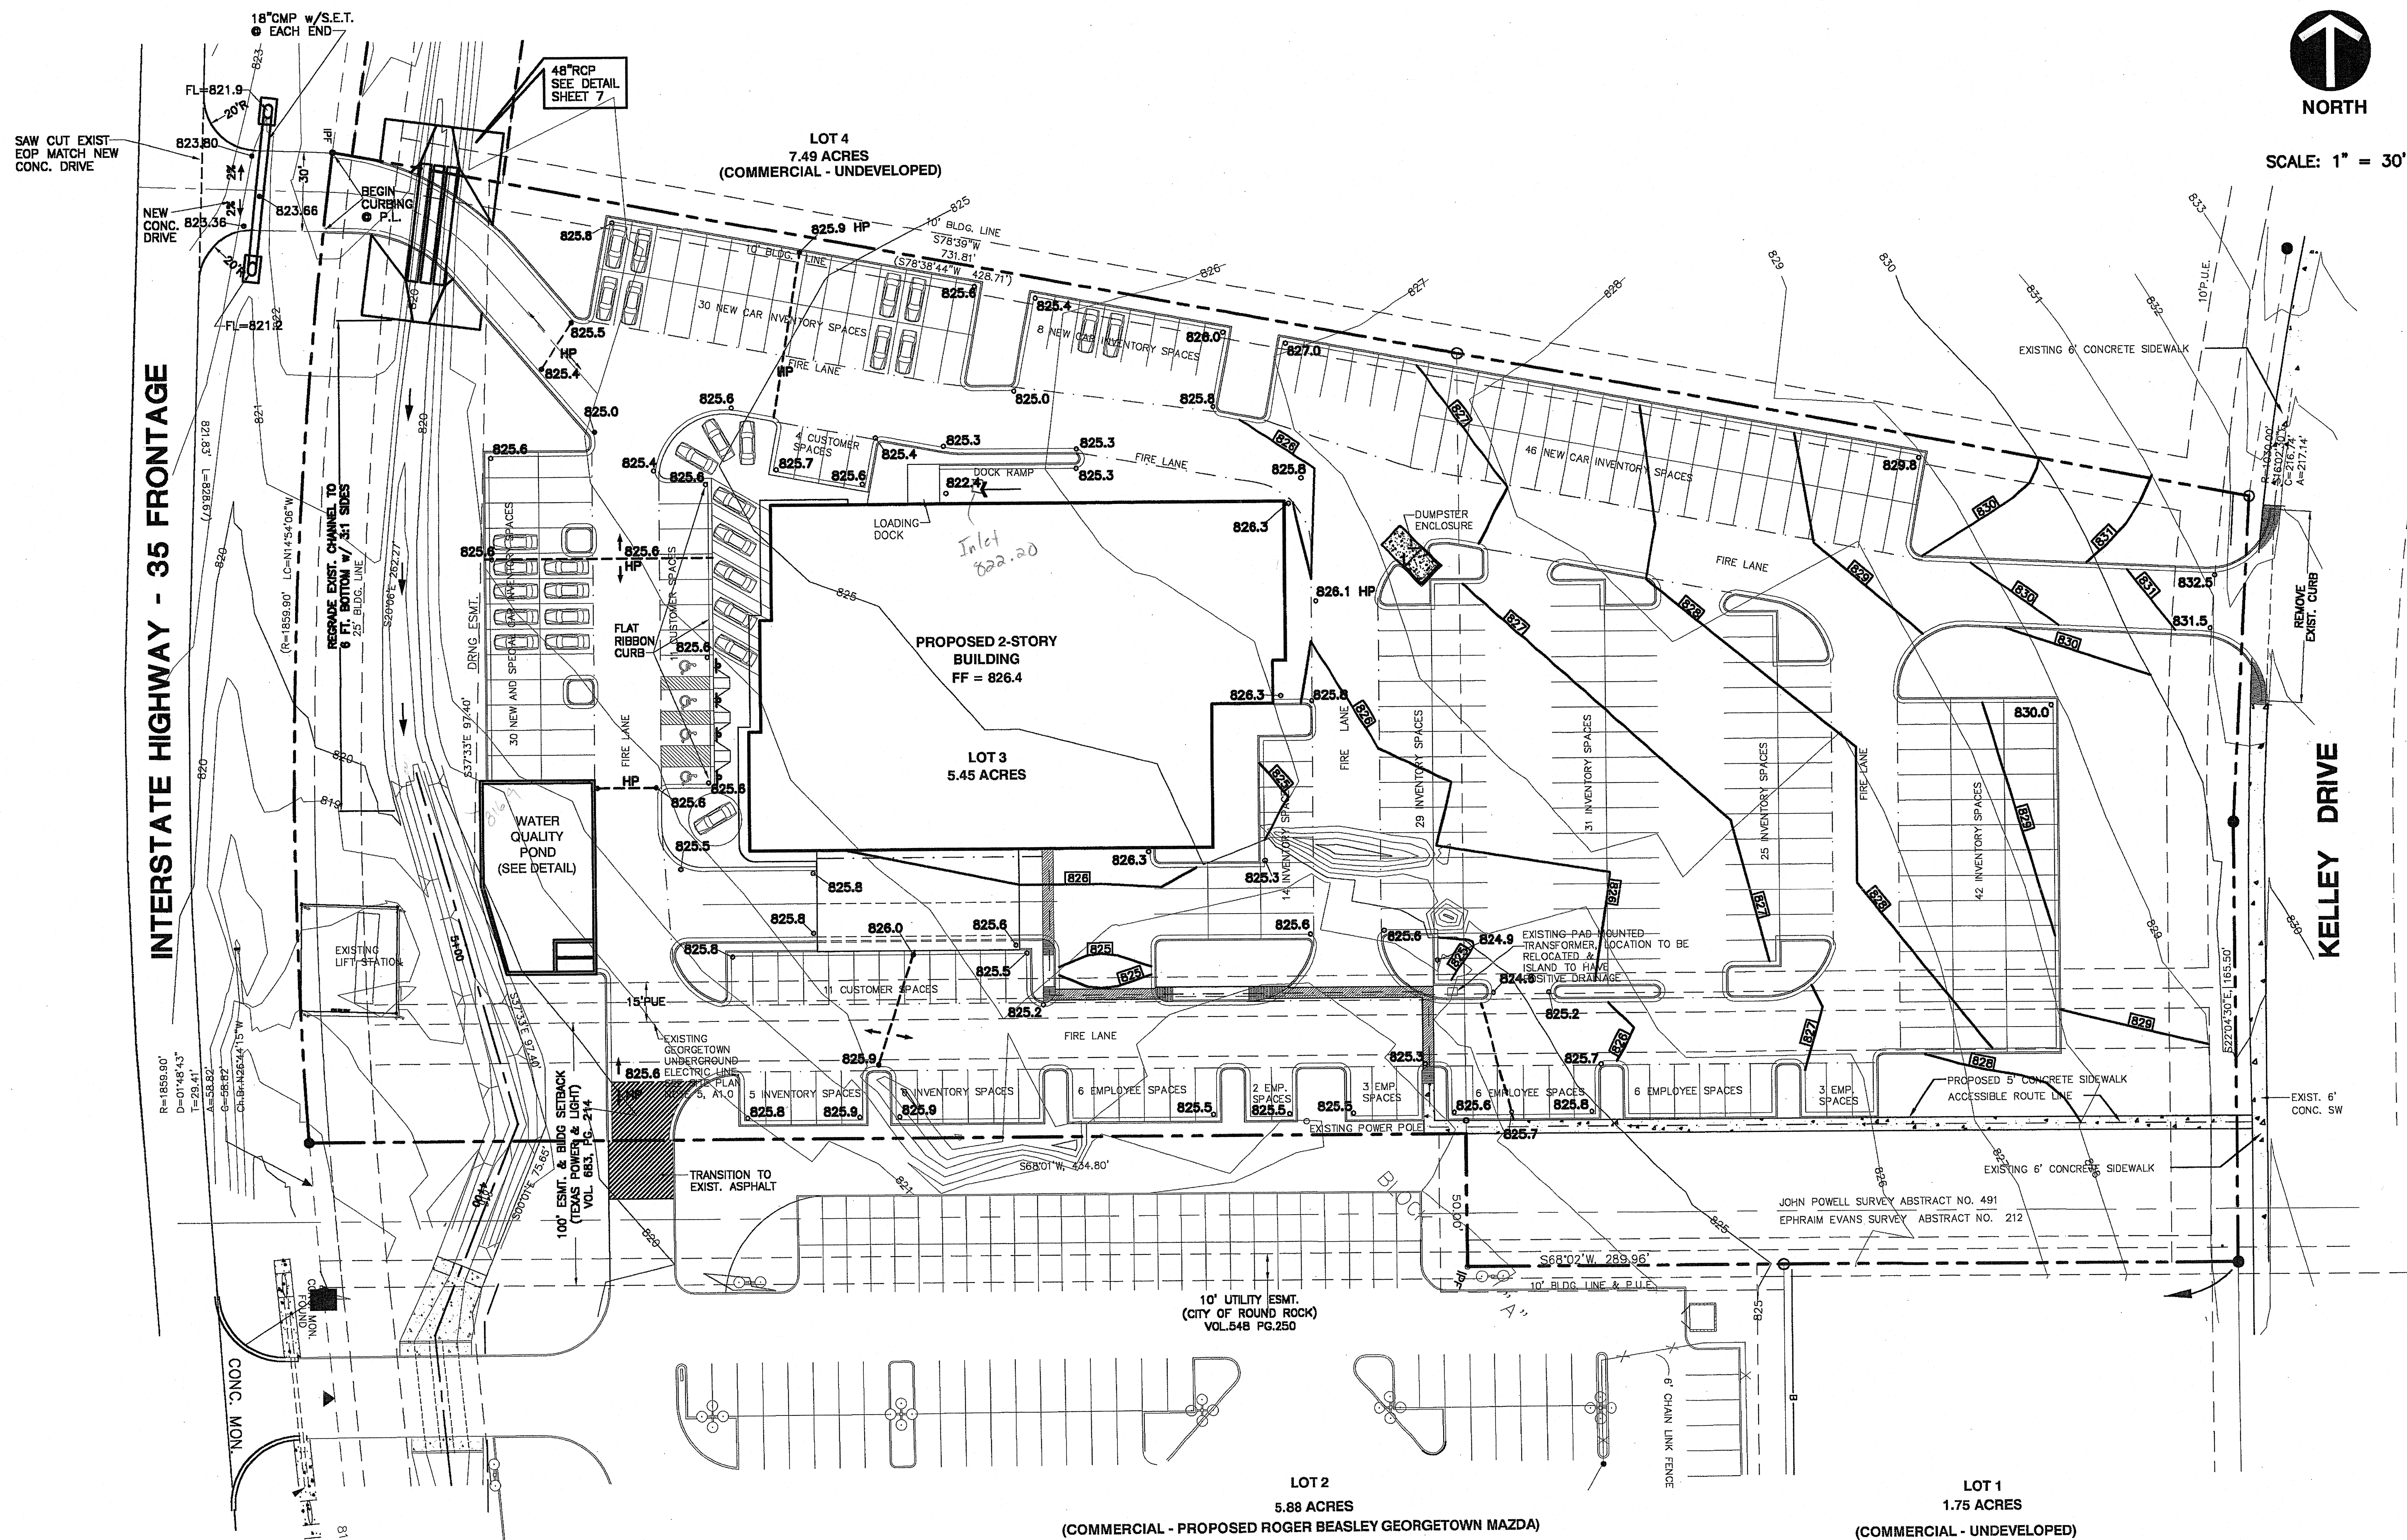

REVISIONS:

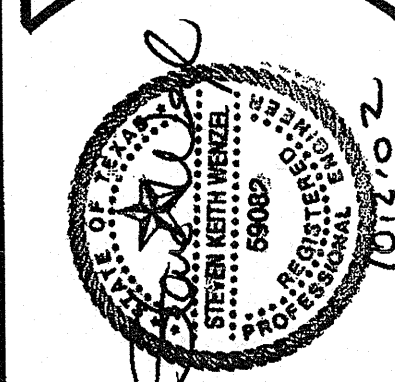


DESIGN BY: SKW
DRAWN BY: JB
CHECK BY: SKW

Wenzel
Engineering Inc.
7005 KENOSHA PASS
Austin, Texas 78748
512 - 301-7480

ROGER BEASLEY VOLVO
GEORGETOWN
GRADING PLAN

JOB NUMBER:
NAME:
DATE: 02 OCT 2002
PAGE NUMBER:




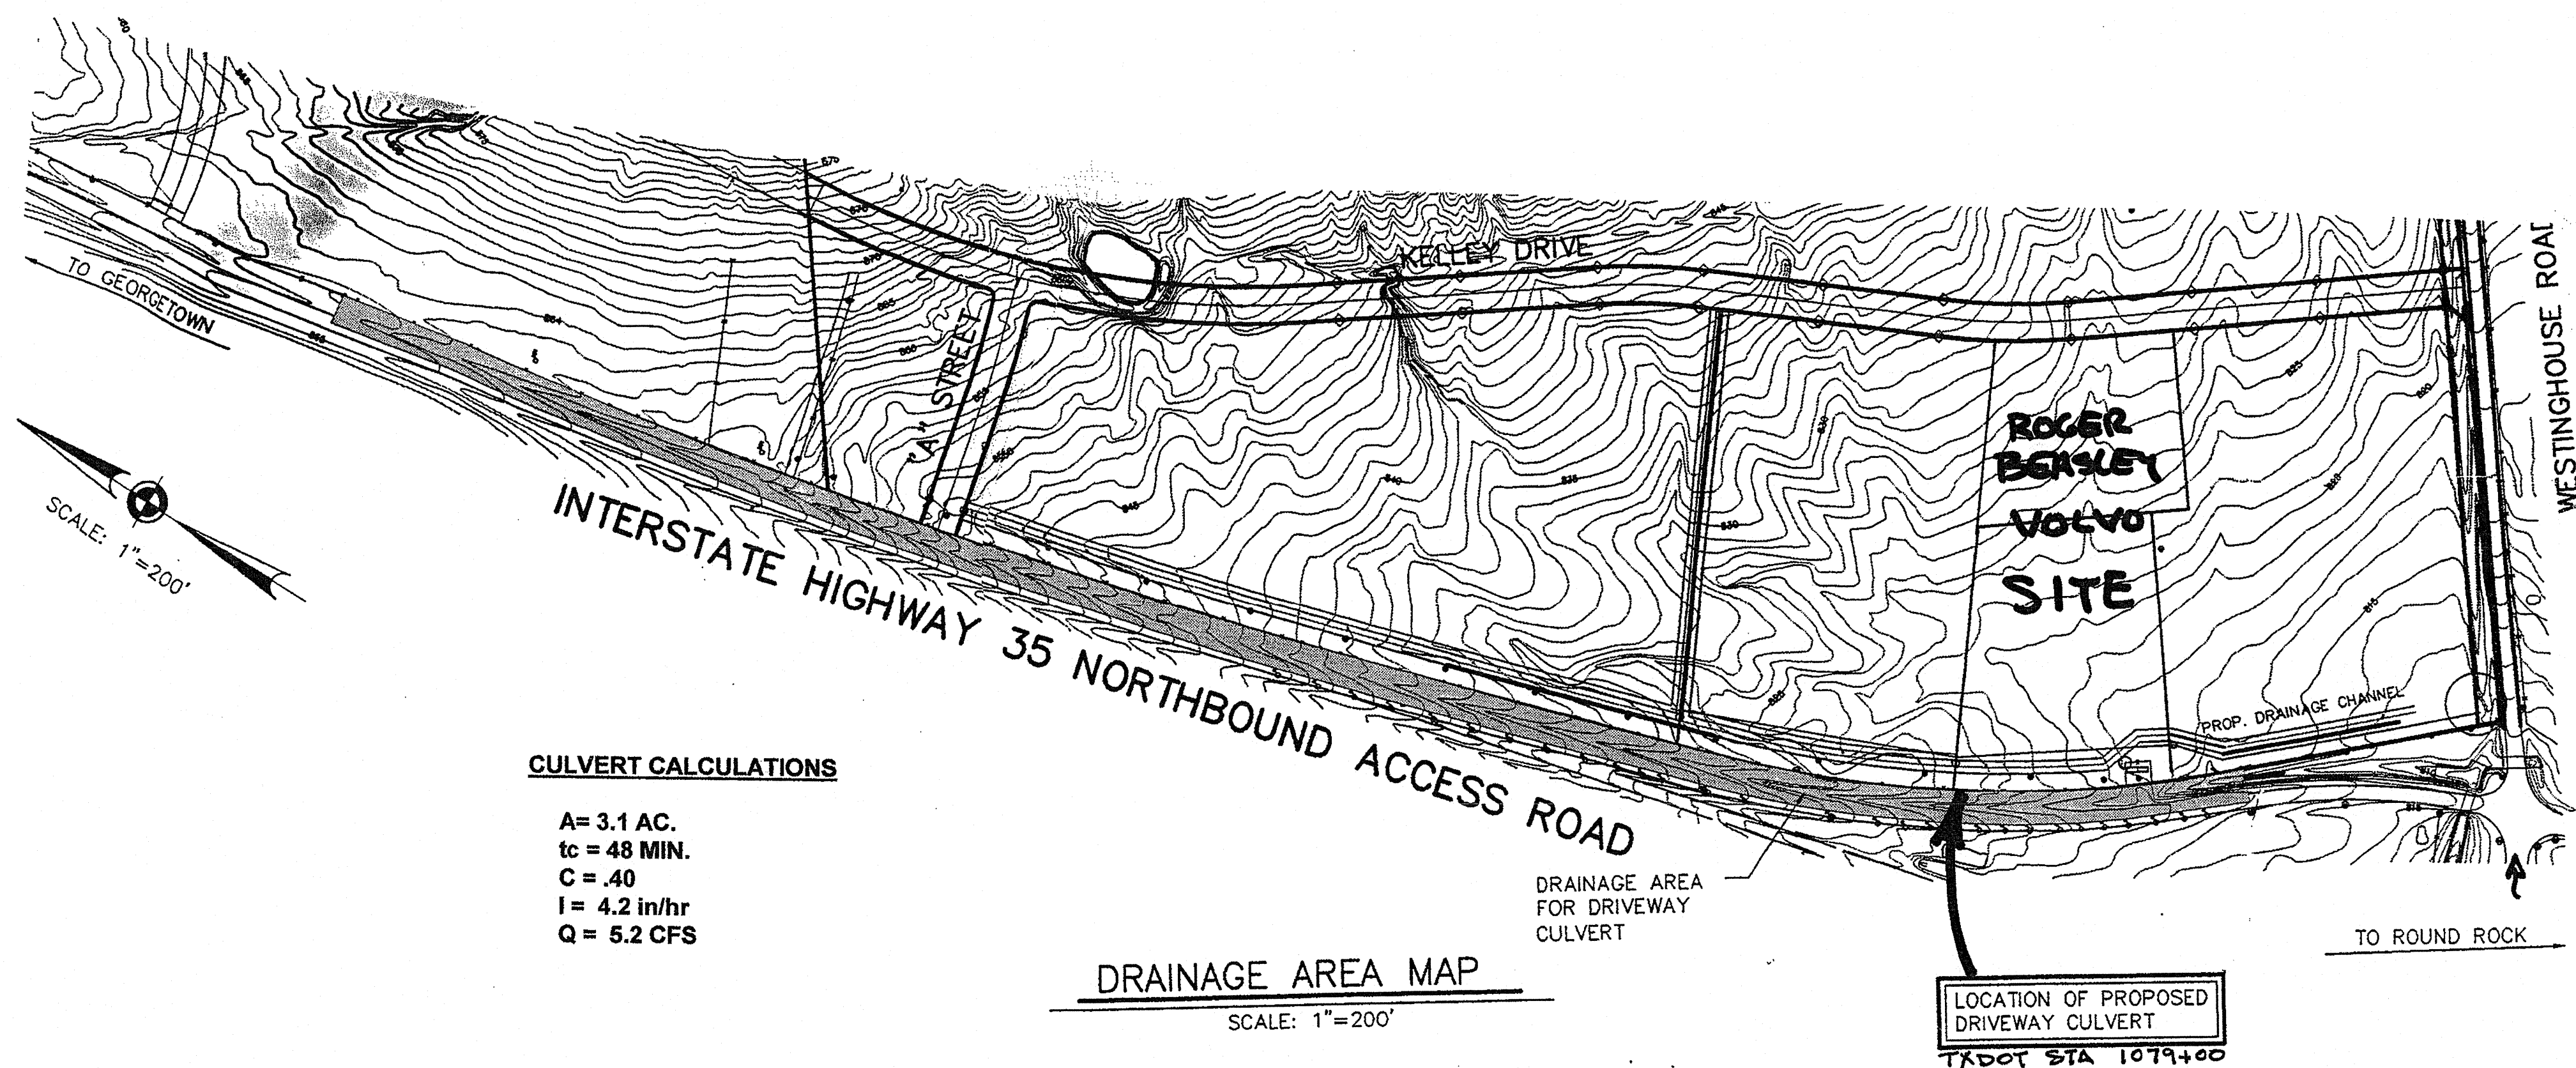


CULVERT CALCULATIONS

A = 3.1 AC.
 tc = 48 MIN.
 C = .40
 I = 4.2 in/hr
 Q = 5.2 CFS

DRAINAGE AREA MAP

SCALE: 1"=200'

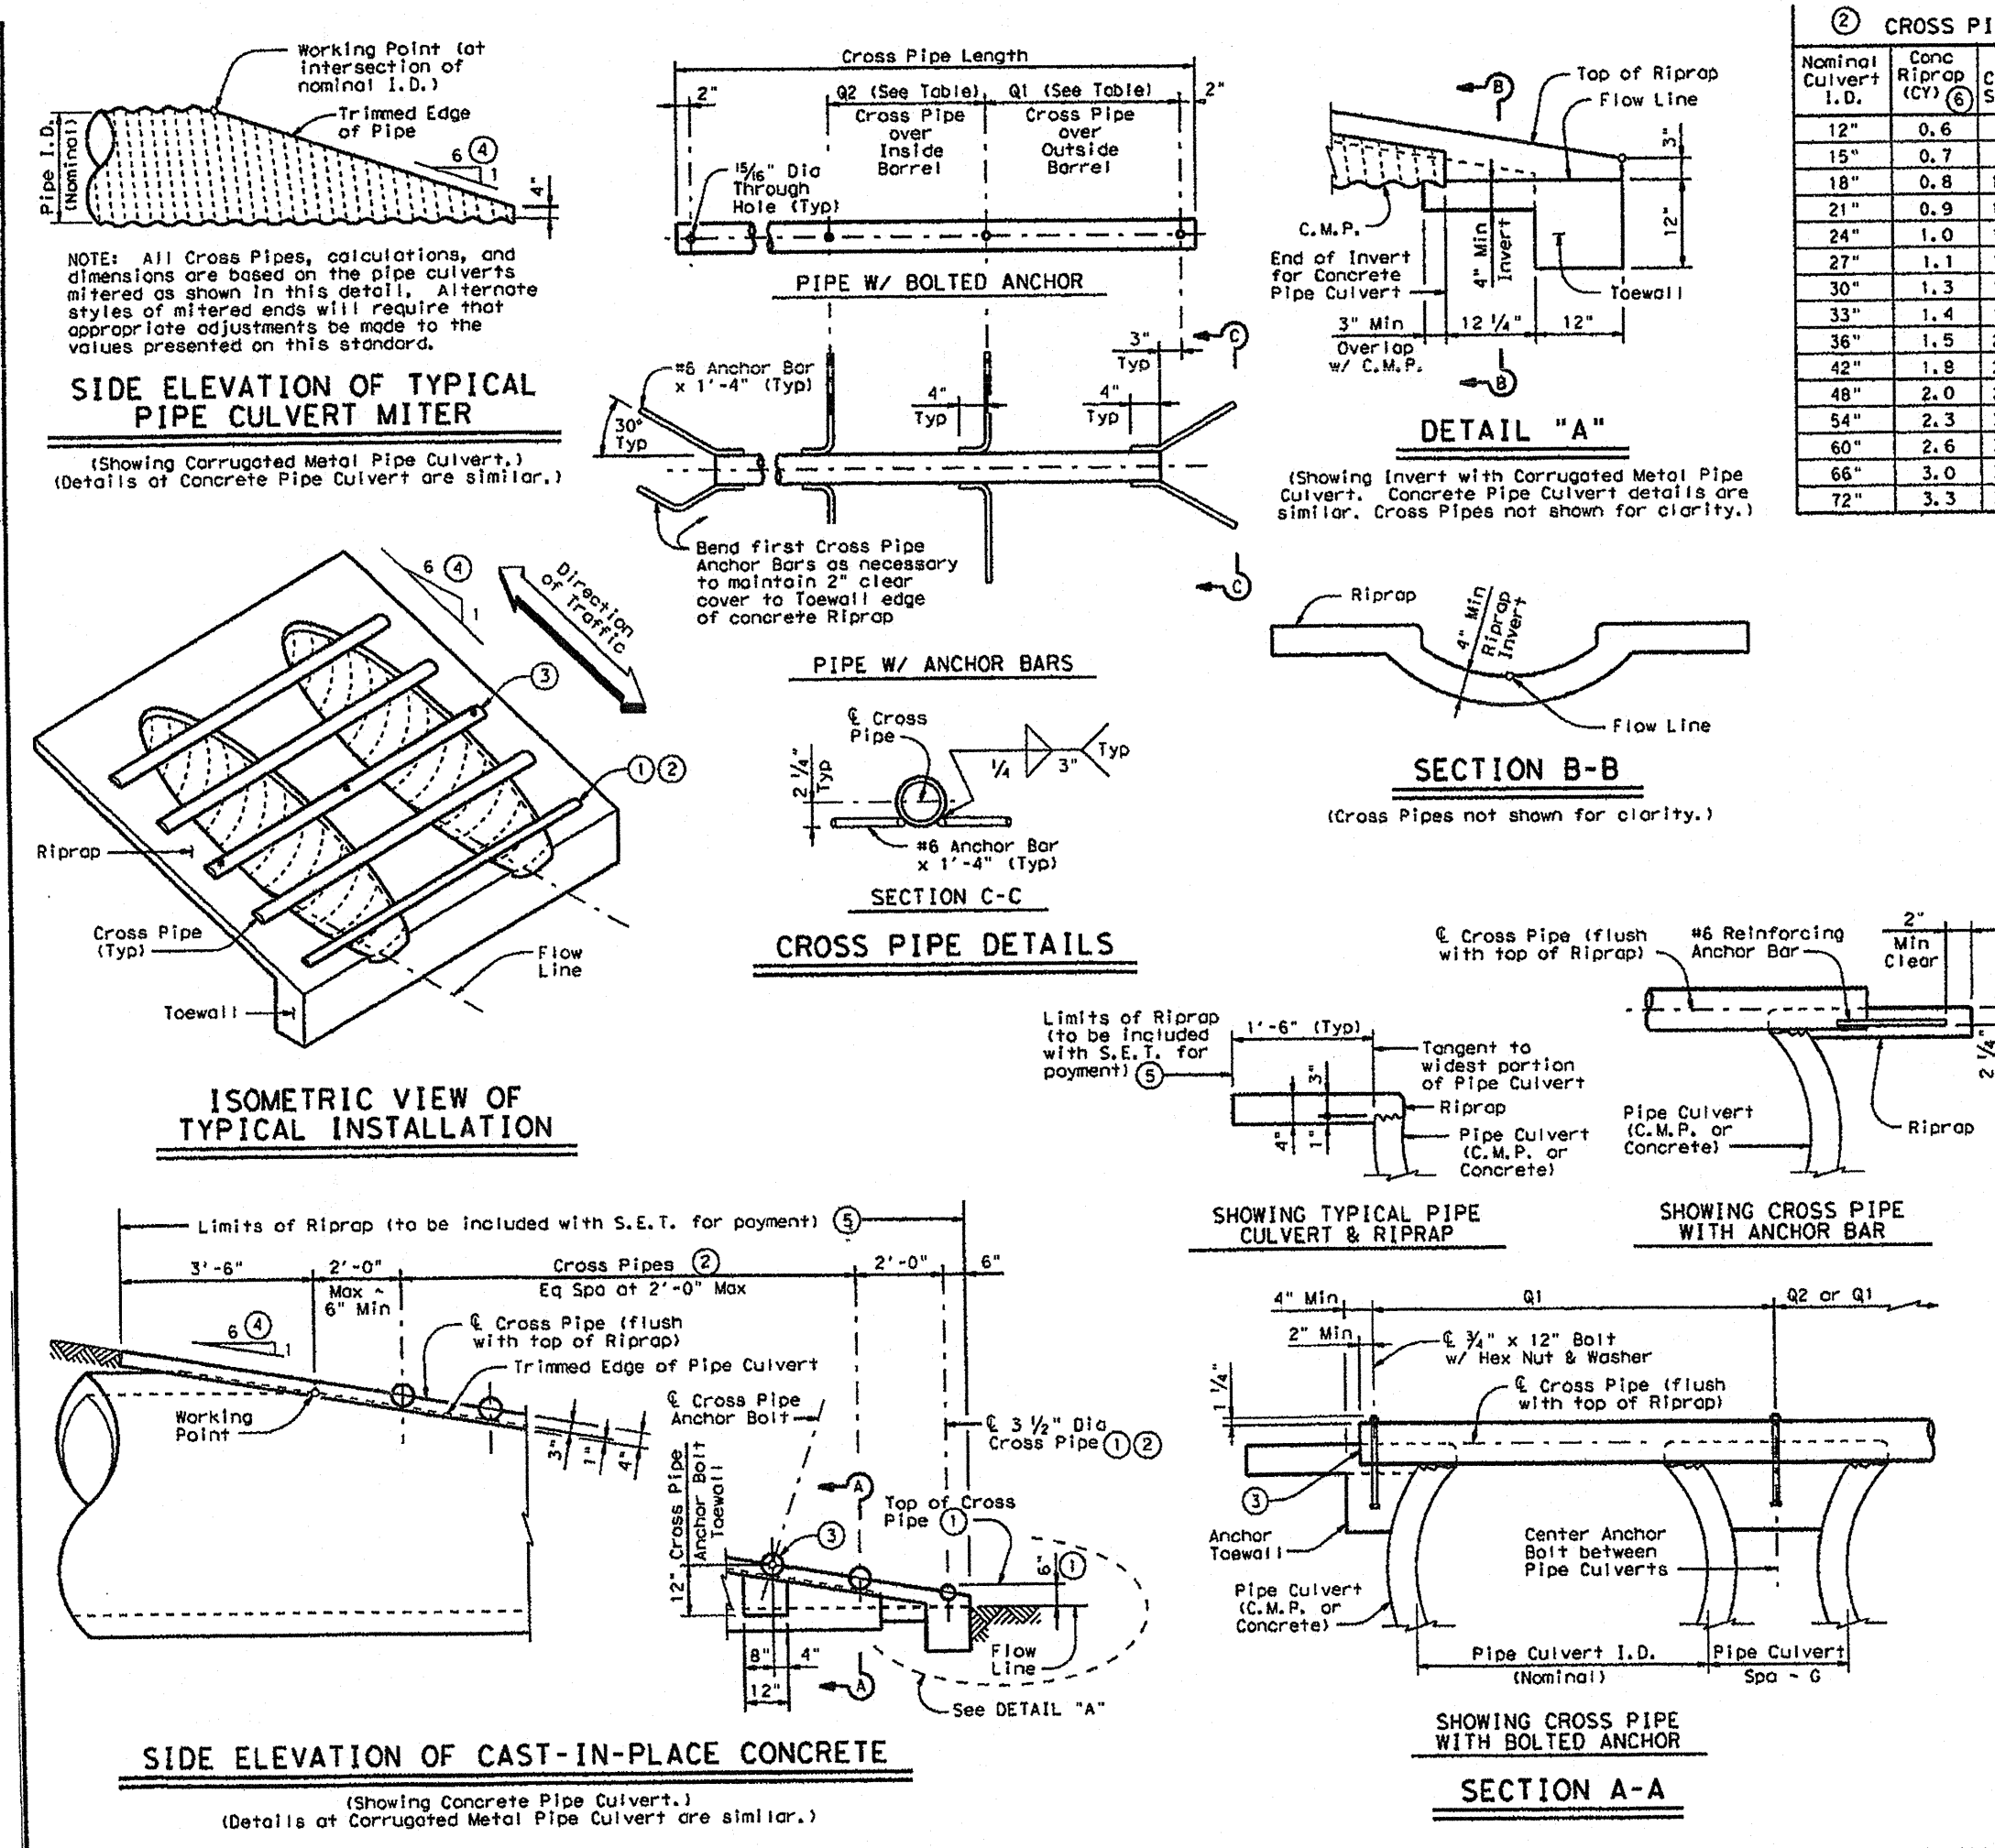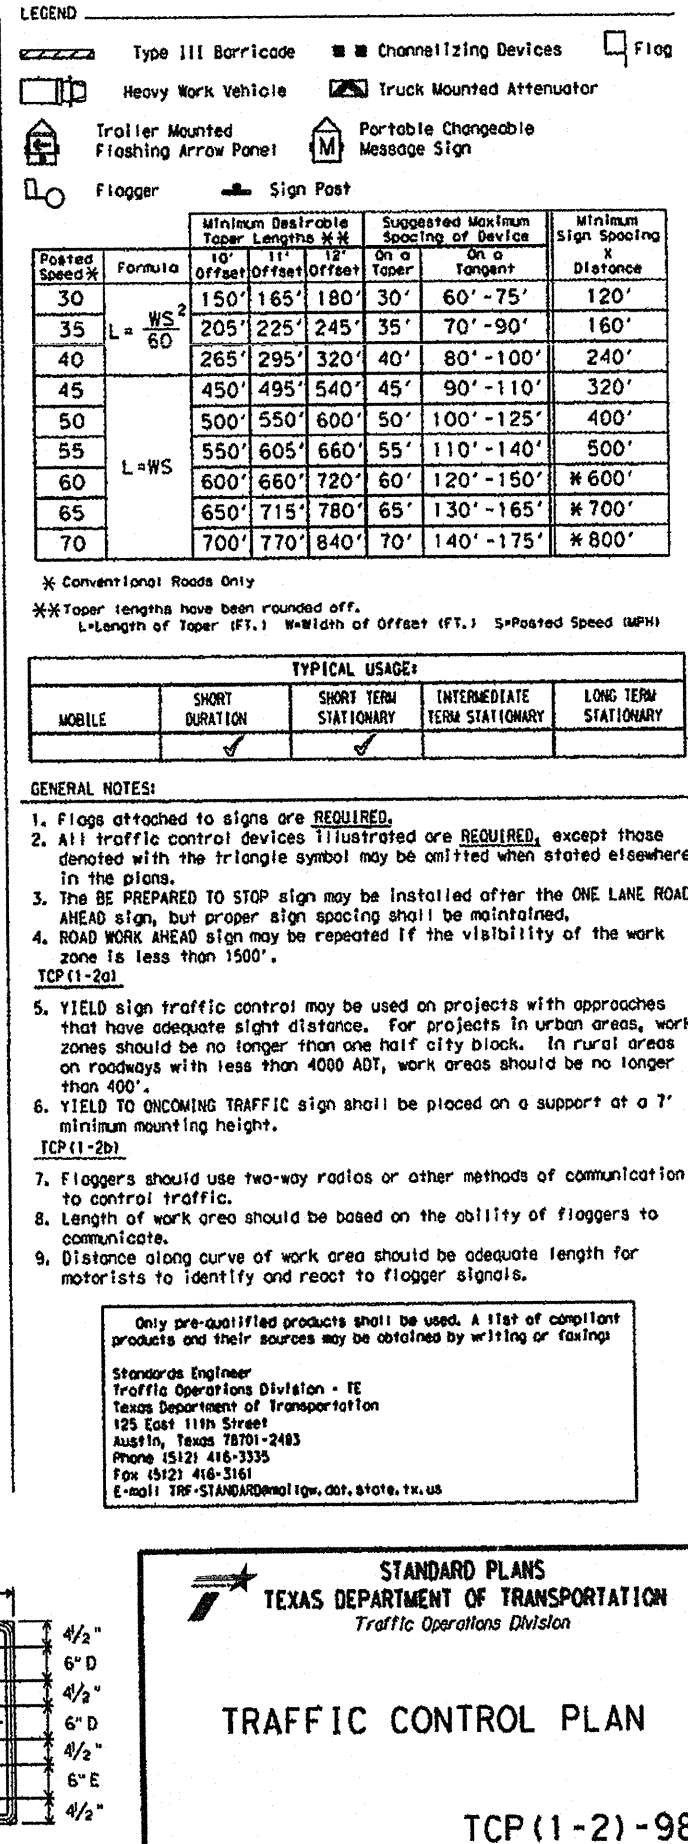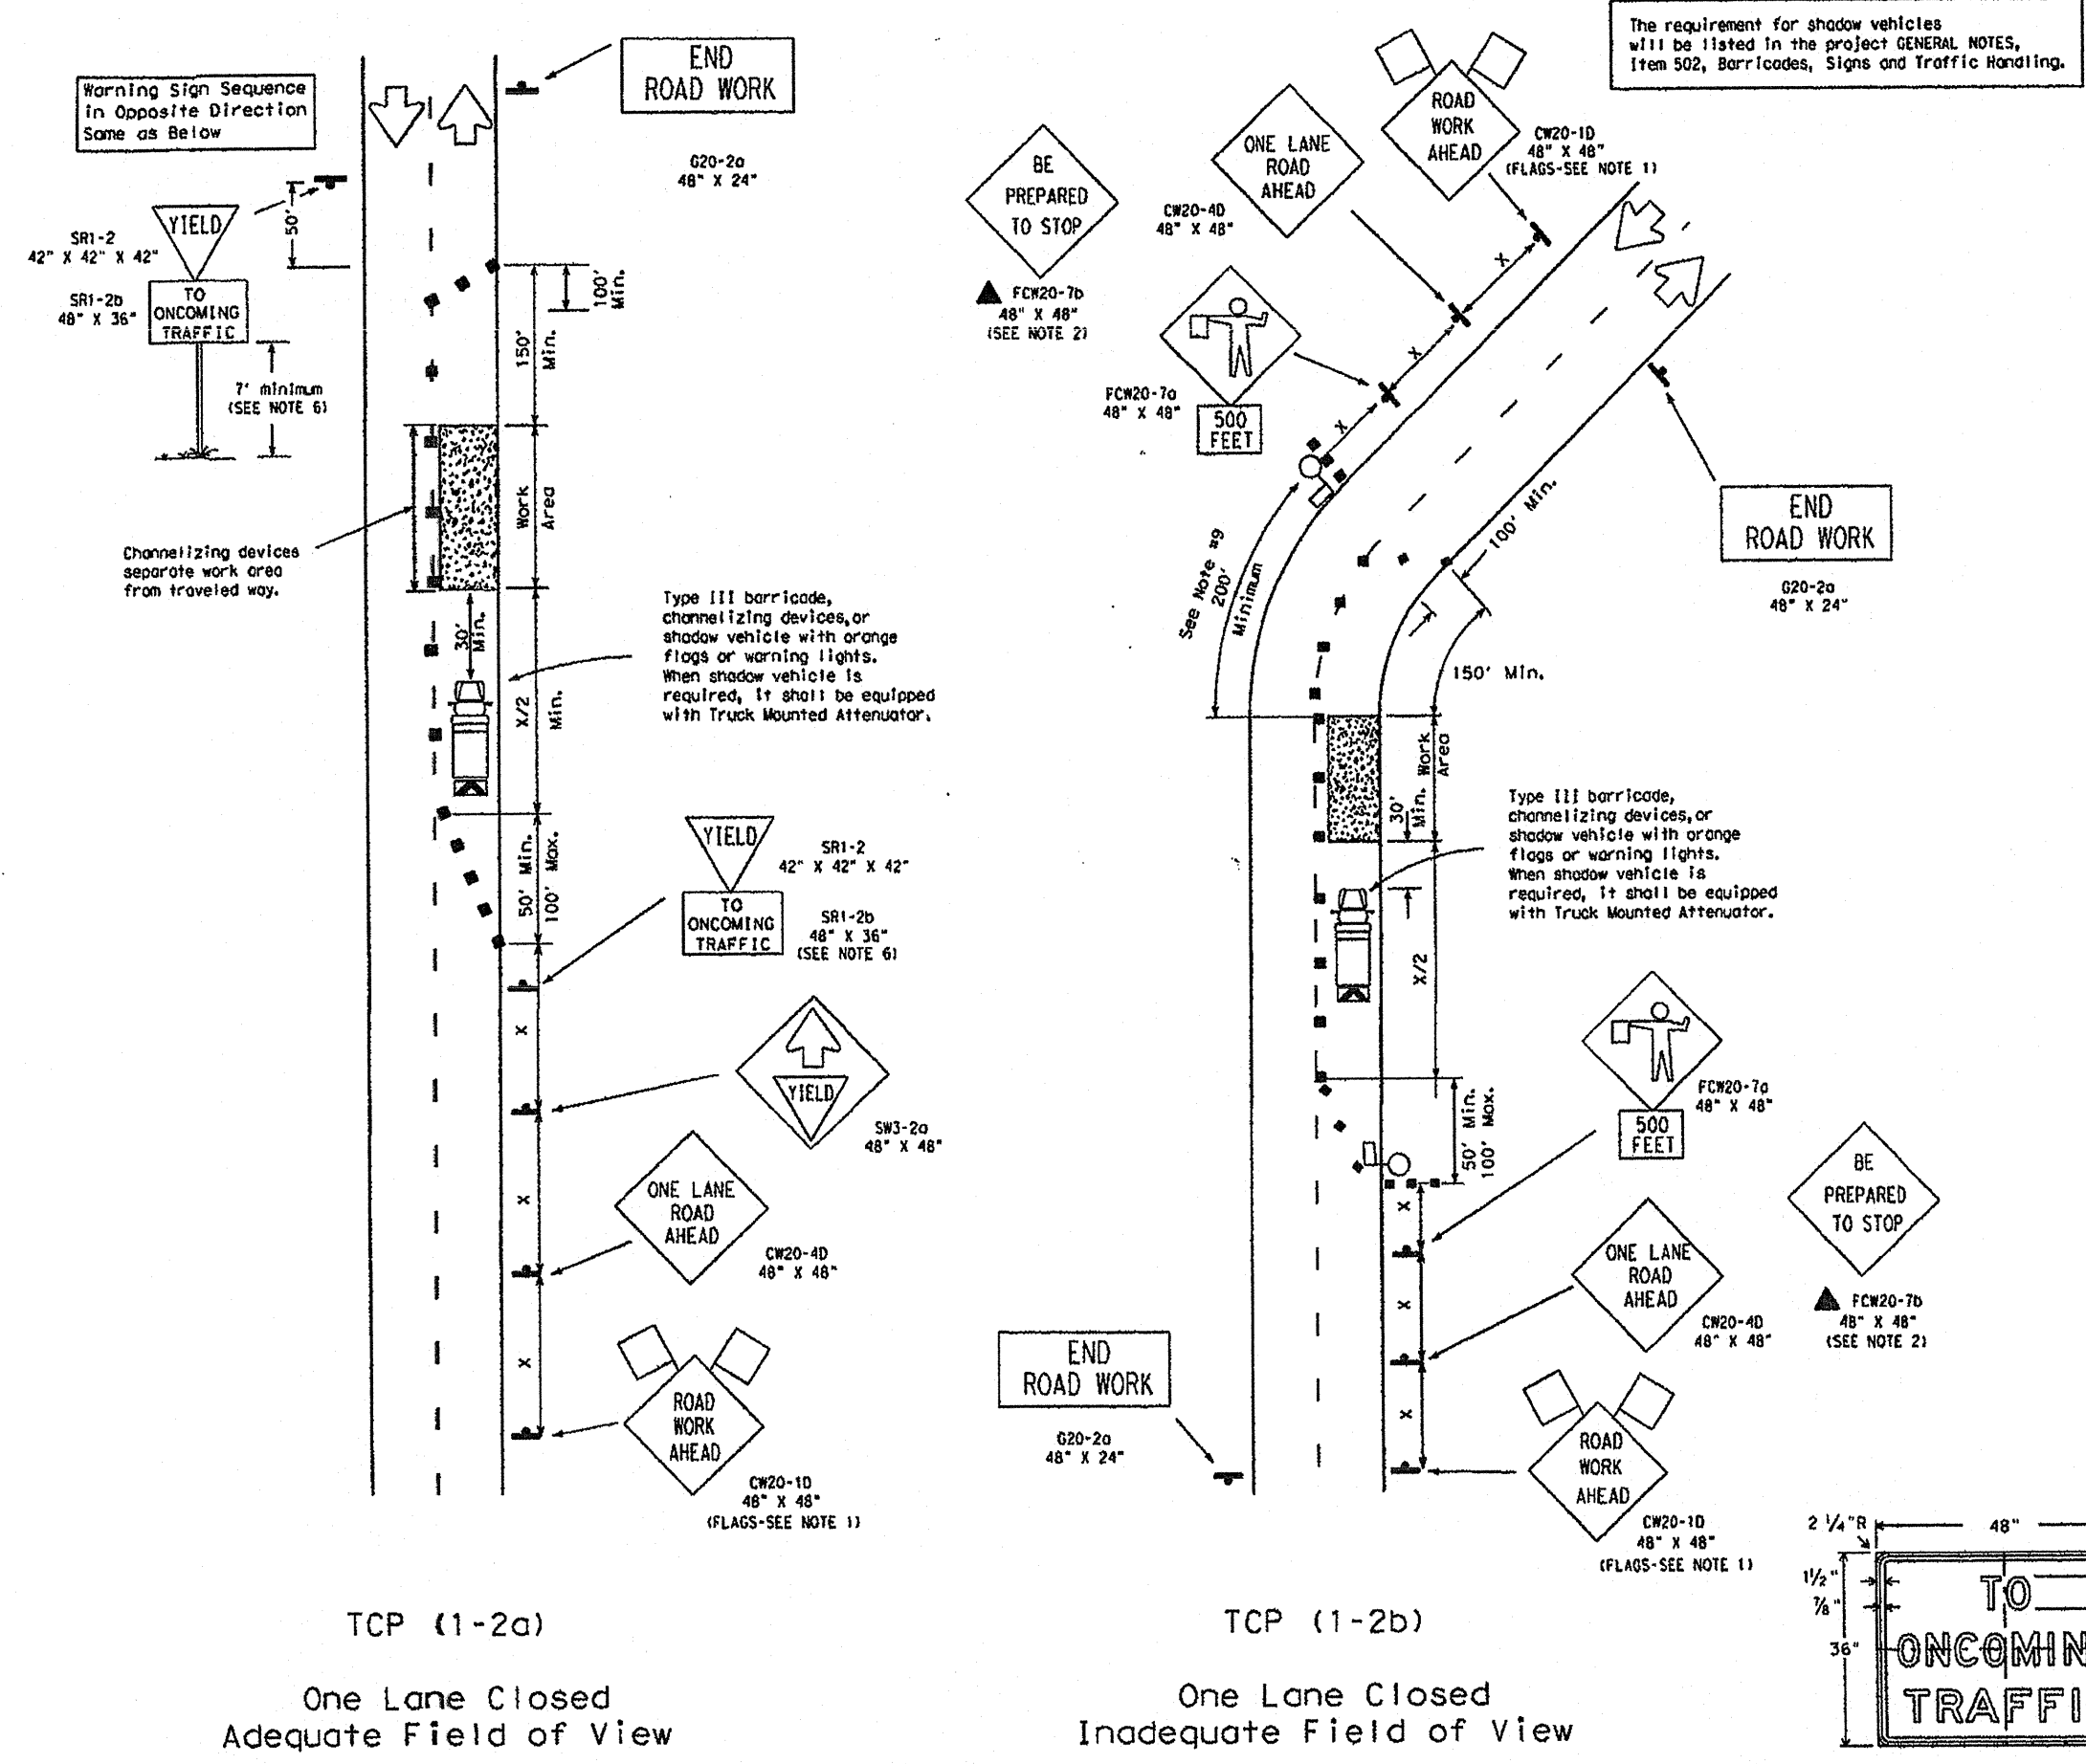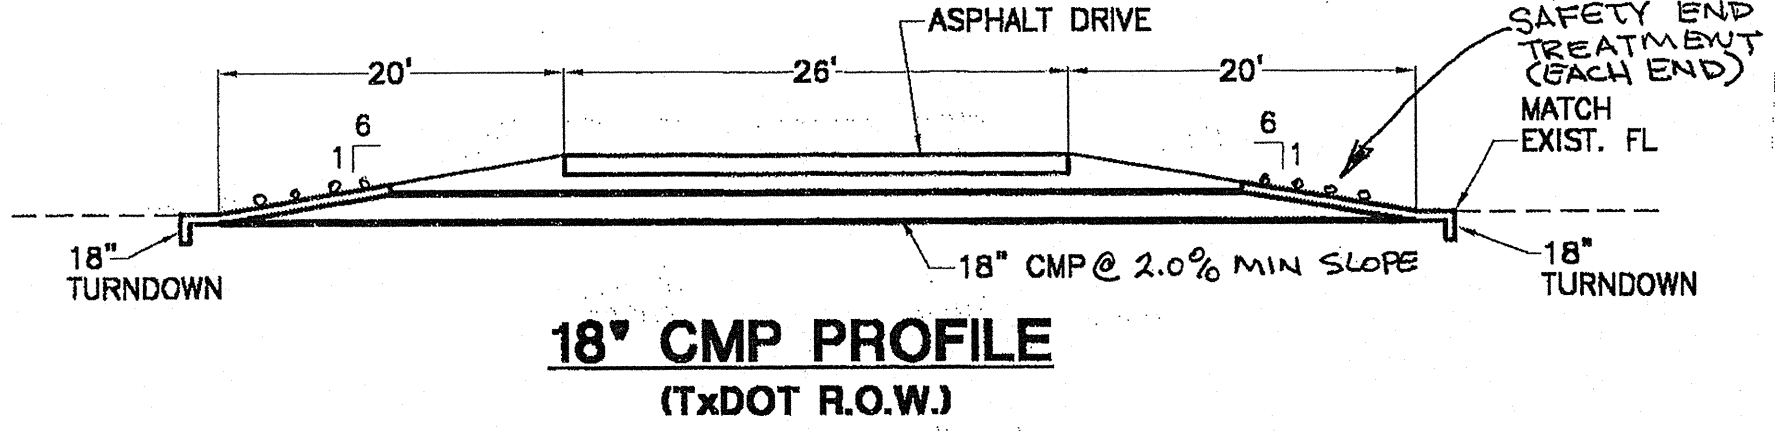

② CROSS PIPE LENGTHS, REQUIRED PIPE SIZES, & RIPRAP QUANTITIES

Height of Culvert (ft.)	Cross Pipe Length (ft.)	Required Pipe Size (in.)	Riprap Quantity (cu yd)
12	12	36"	1.0
15	15	42"	1.5
18	18	48"	2.0
21	21	54"	2.5
24	24	60"	3.0
27	27	66"	3.5
30	30	72"	4.0
33	33	78"	4.5
36	36	84"	5.0
39	39	90"	5.5
42	42	96"	6.0
45	45	102"	6.5
48	48	108"	7.0
51	51	114"	7.5
54	54	120"	8.0
57	57	126"	8.5
60	60	132"	9.0
63	63	138"	9.5
66	66	144"	10.0
69	69	150"	10.5
72	72	156"	11.0

GENERAL NOTES:

- The proper installation of the first cross pipe is critical for vehicle safety. The top of the first cross pipe must be placed at no more than 6" above the first bottom pipe, as shown in the PIPE SIZE table. The first bottom pipe shall be 3" Standard Pipe (14" O.D.).
- The third cross pipe from the bottom of the culvert shall always be installed using a bolted connection. Cross pipes of 60" or greater are required for vehicle safety.
- Size of cross pipes, except the first bottom pipe, shall be taken to ensure that riprap concrete does not flow into the cross pipe as to permit dislodgement of the riprap. The riprap shall be placed in the cross pipe as to permit dislodgement of the riprap. The riprap shall be placed in the cross pipe as to permit dislodgement of the riprap.
- Match cross slopes as shown elsewhere in the plans. Cross slopes of 60" or greater are required for vehicle safety.
- Riprap piles beyond the limits shown will be sold as concrete riprap in accordance with Item 432, "Riprap".
- Quantities shown are for one end of one reinforced concrete pipe culvert. For multiple pipe culverts or for corrugated metal pipe culverts, quantities will need to be adjusted. Riprap quantities are for contractor's information only.

SAFETY END TREATMENT FOR 12" DIA TO 72" DIA PIPE CULVERTS TYPE II - PARALLEL DRAINAGE

SETP-PD

SAFETY END TREATMENT FOR 12" DIA TO 72" DIA PIPE CULVERTS TYPE II - PARALLEL DRAINAGE

ROGER BEASLEY VOLVO GEORGETOWN TxDOT DRIVEWAY DETAILS

DESIGN BY: SKW
 DRAWN BY: JB
 CHECK BY: SKW

enzel Engineering Inc.
 7005 KENOSHA PASS
 Austin, Texas 78749
 512 - 301-7480

JOB NUMBER: NAME: DATE: 02 AUG 2002 PAGE NUMBER: 8 of 9

VOLVO GEORGETOWN 48" CULVERTS

DRAINAGE AREA PROPOSED CONDITIONS

REACH	FLOW TYPE	SLOPE (%)	LENGTH (ft)	"n"	Tc (min)
1	1	2	300	0.3	15.2
2	2	3	400	0.3	6.7
3	3	1	2200	0.3	12.2
*assume 3 fps					
TOTAL Tc					34.04

Storm Frequency	"C"	Intensity (in/hr)	Q (cfs)
2 year	0.81	3.01	107.9
10 year	0.88	4.32	173.0
25 year	0.73	5.12	219.2
100 year	0.81	6.35	303.3


CULVERT CAPACITY:

1-48" RCP
Q=CA 2gh C=0.8, h=3, A=12.5
Q=104 CFS
FOR 3-48" RCP = 312 CFS
CHECK PIPE SLOPE FOR 1.48"
@1.0% = 150 CFS, OK


CHANNEL CAPACITY:
TRAPEZOIDAL SECTION W/ 6FT BOTTOM, 3:1 SIDES,
MANNINGS:

		Side Slopes		Bottom Width	Manning	Depth (ft.)	Slope %	V (fps)	Q cap. (cfs)
Section	Ditch Type	Left (z:1)	Right (z:1)						
Minimum	Typical	TRAP	3.00	3.00	6.00	0.03	3.00	0.9	7.9
									313.1


Surface Type	Area (ac)	2 yr	10 yr	25 yr	100 yr
Asphalt	19.00	0.73	0.81	0.88	0.95
Gravel	21.00	0.75	0.83	0.88	0.97
Grass	19.00	0.33	0.38	0.42	0.49
TOTAL	59.00	0.81	0.88	0.73	0.81

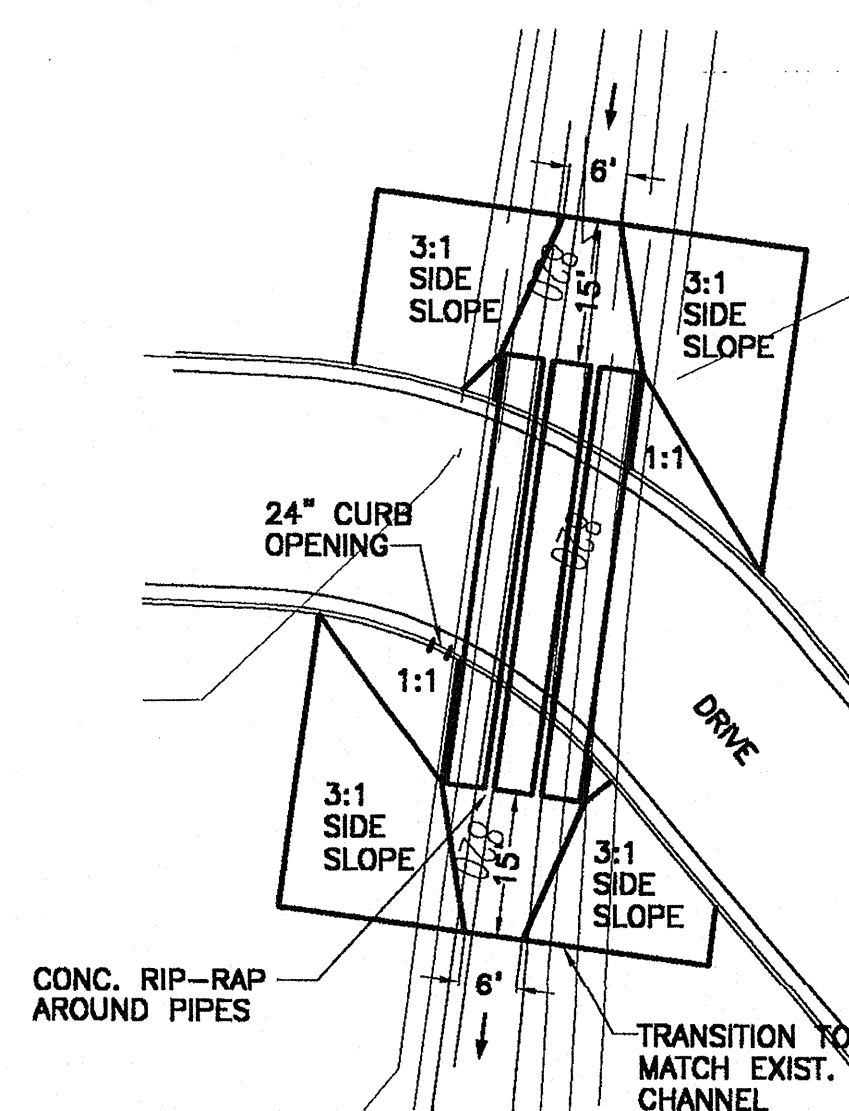


3-48" RCP DETAIL

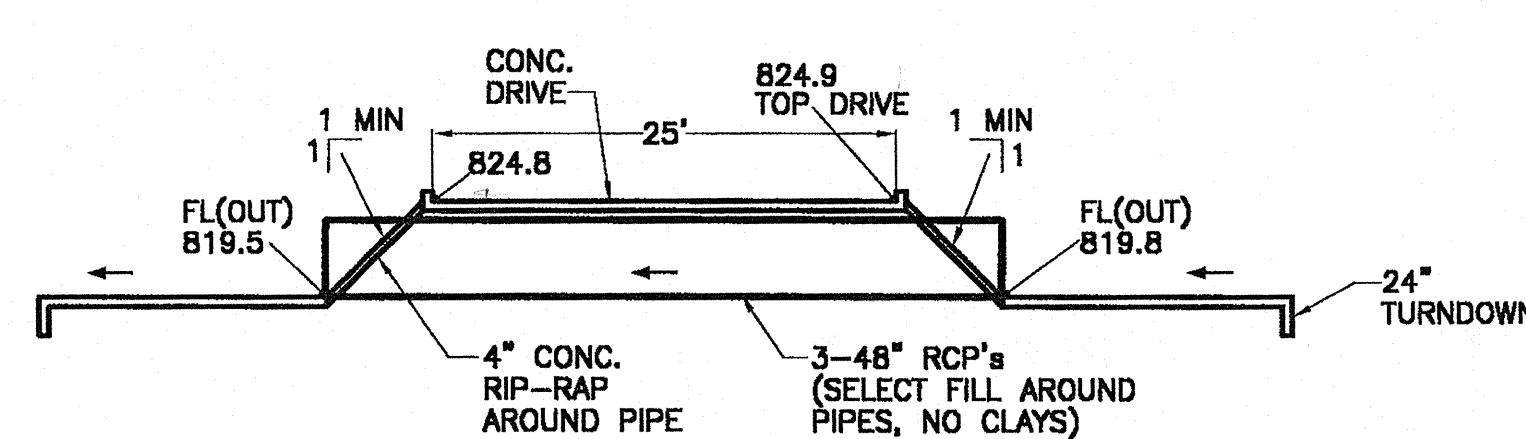

3-48" RCP PROFILE

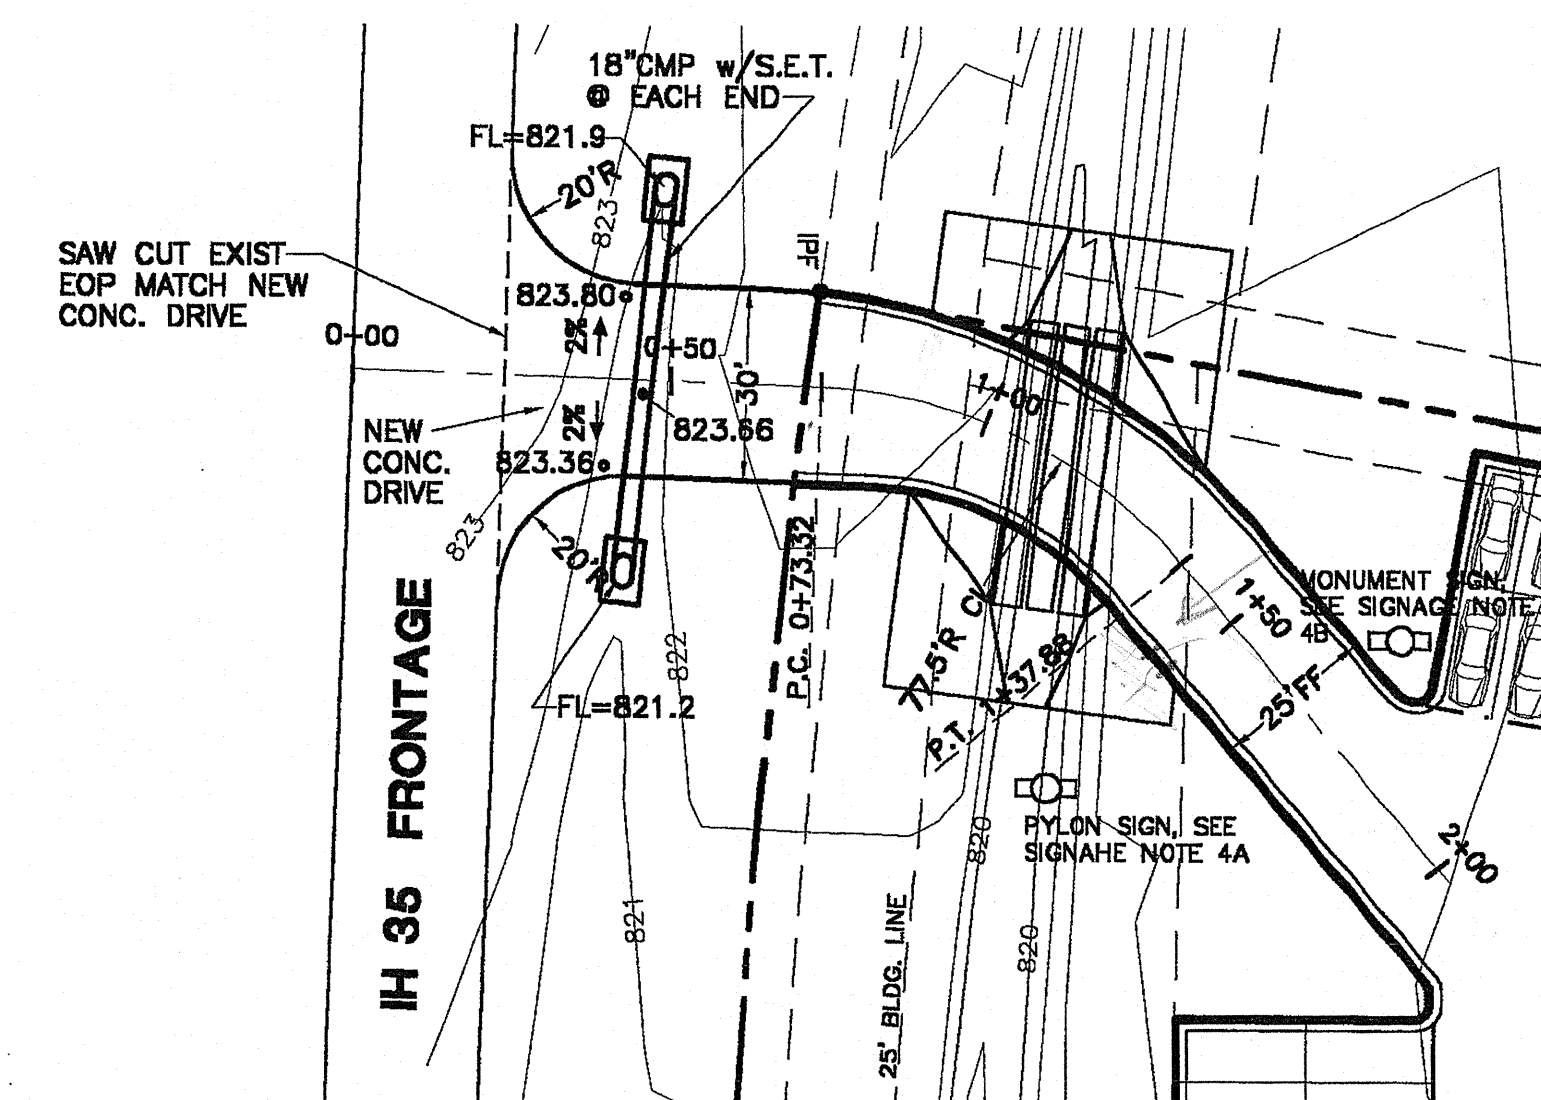

DRIVEWAY PLAN VIEW
1" = 30'

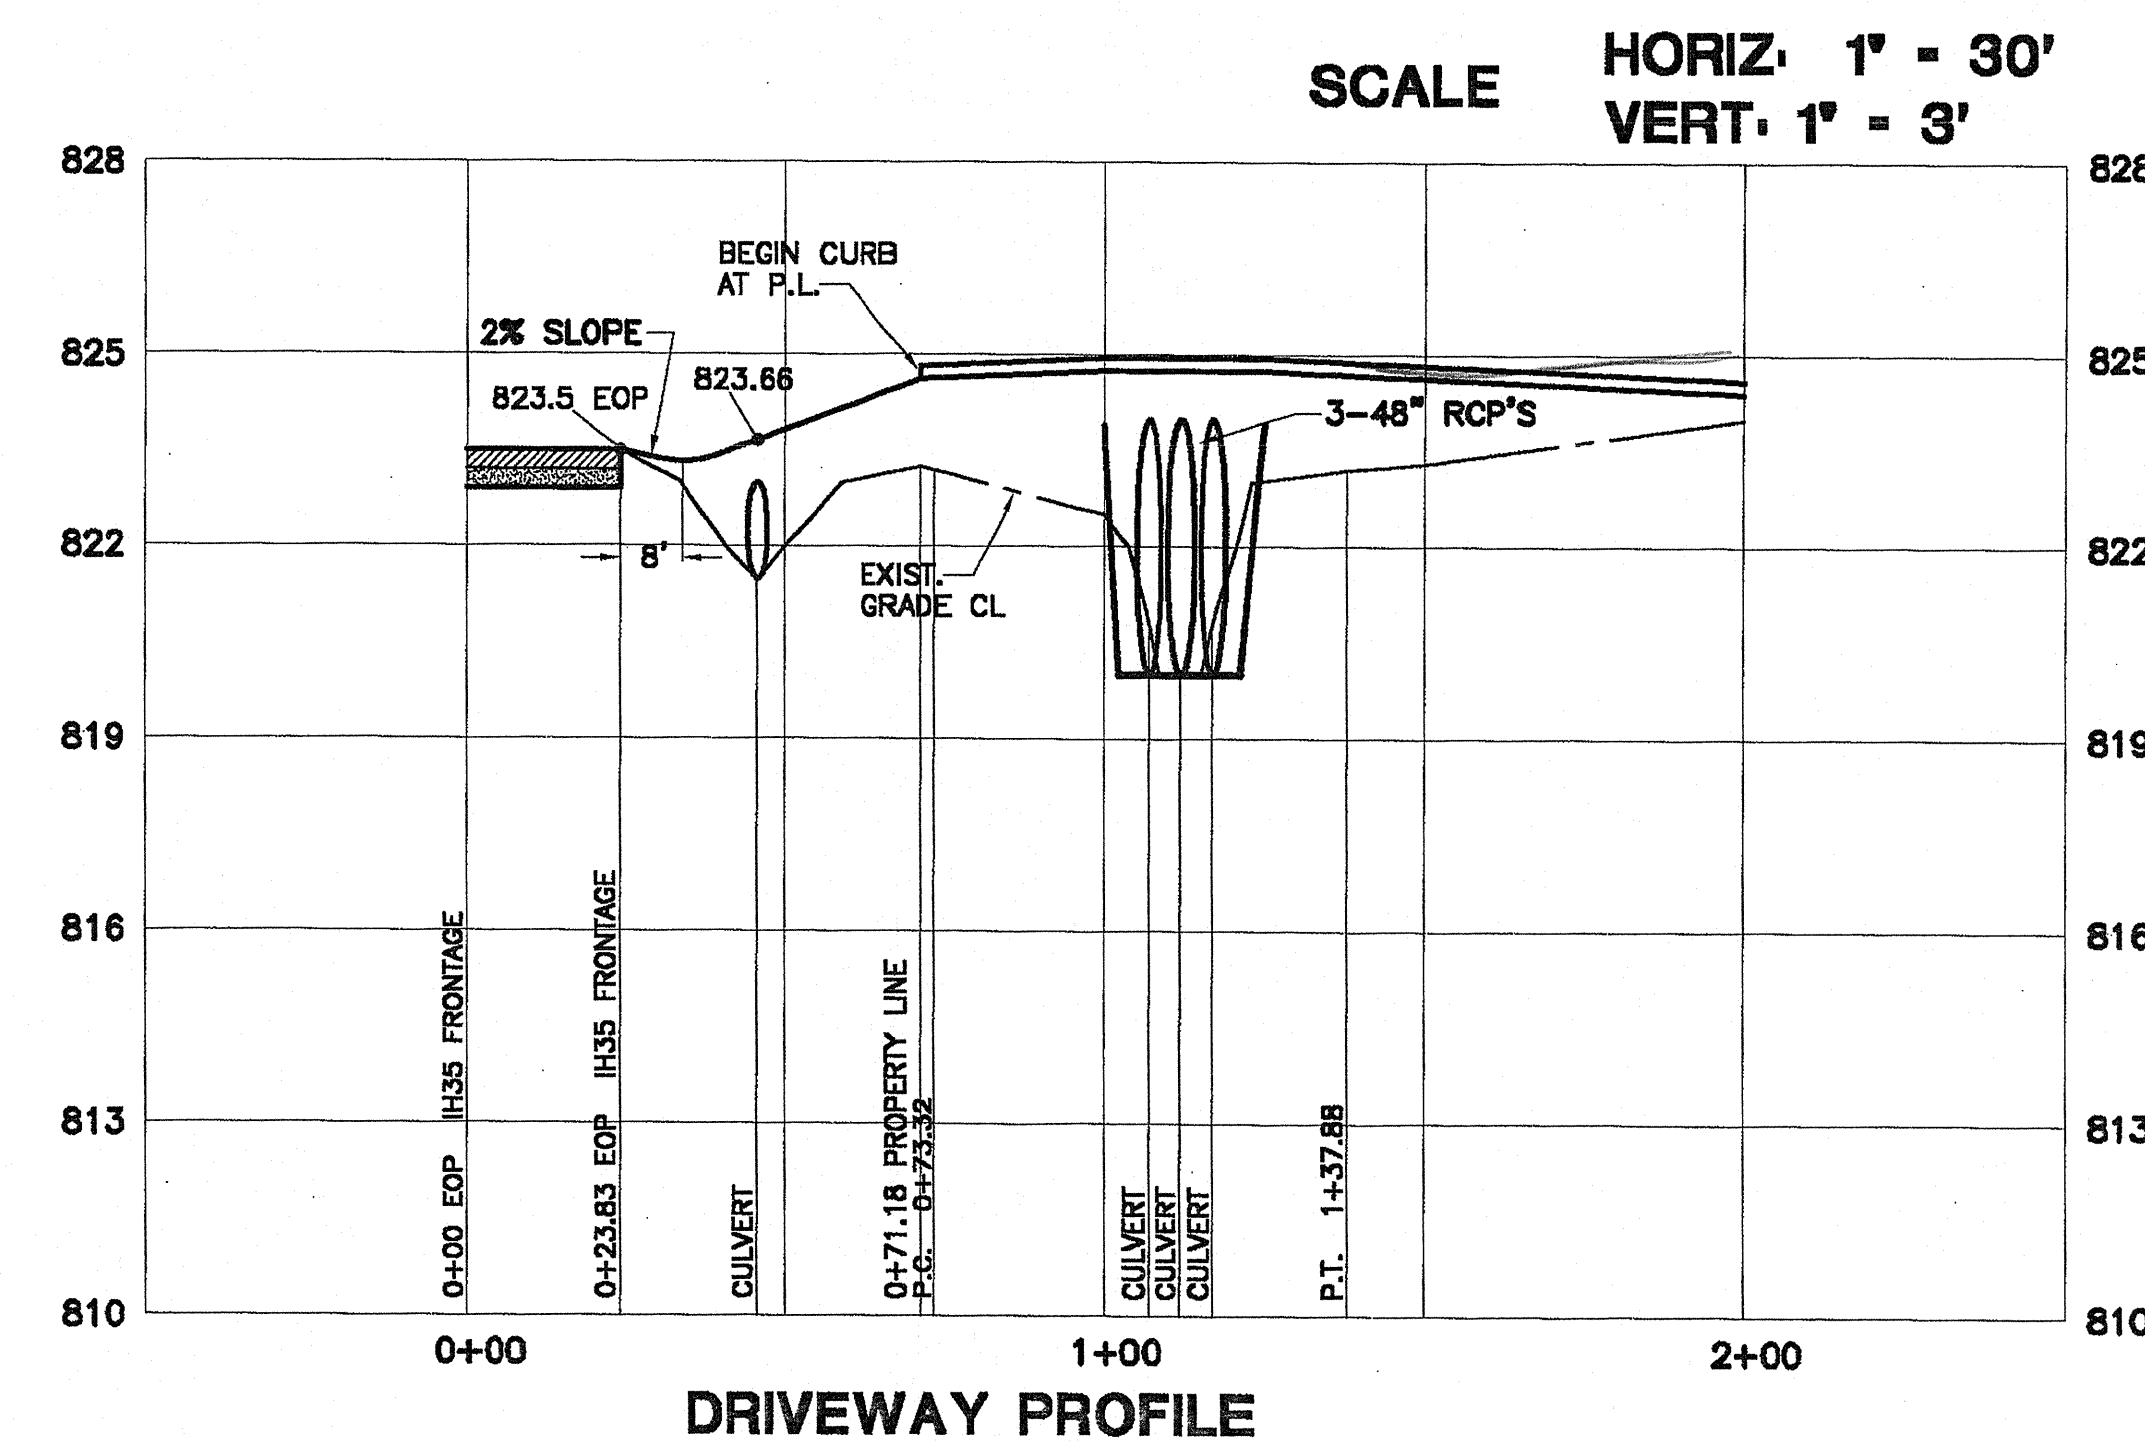


DRIVEWAY PROFILE

NOTES:

1. LANE CLOSURES ARE ONLY ALLOWED FROM 9 AM TO 4 PM MONDAY THROUGH FRIDAY. EXCEPT AS SHOWN ON THE DISTRICT DESIGN RESTRICTIONS.
2. LANE CLOSURES ARE NOT ALLOWED IF PAVEMENT IS WET OR ICY.
3. CONSTRUCTION WORK WITHIN THE STATE'S RIGHT OF WAY MUST BE SCHEDULED FOR MONDAY THROUGH FRIDAY.
4. THE CONTRACTOR IS TO CONTACT TxDOT AT 930-4700 AT LEAST 48 HOURS PRIOR TO WORKING IN THE RIGHT OF WAY.
5. THE PRIMARY CONTRACTOR IS RESPONSIBLE FOR KEEPING THE STATE ROADWAY FREE OF MUD, ROCKS AND OTHER DEBRIS. IF THE HIGHWAY BECOMES UNSAFE FOR TRAFFIC BECAUSE OF DEBRIS FROM THE CONSTRUCTION SITE, THE CONTRACTOR MUST CLEAN THE ROADWAY IMMEDIATELY AND SUSPEND WORK IF NECESSARY.
6. THE GENERAL CONTRACTOR MUST PROVIDE ON-SITE PARKING DURING ALL PHASES OF CONSTRUCTION. NO VEHICLES SHALL BE PARKED OR STORED WITHIN TxDOT RIGHT OF WAY.
7. ANY DROP OFF GREATER THAN TWO INCHES LEFT OPEN OVER NIGHT SHALL HAVE A 3:1 SAFETY WEDGE.

REVISIONS:

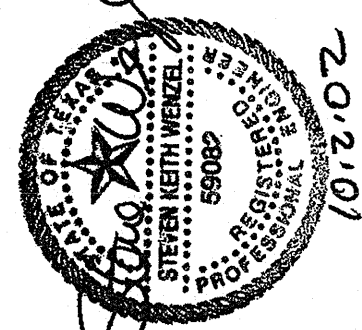

DESIGN BY: SKW
DRAWN BY: JB
CHECK BY: SKW

Enzel
Engineering Inc.
7005 KENOSHA PASS
Austin, Texas 78748
512 - 301-7480

**ROGER BEASLEY VOLVO
GEORGETOWN**
TxDOT DRIVEWAY DETAILS

JOB NUMBER:
NAME:
DATE: 02 OCT 2002
PAGE NUMBER:

8Aof9

ZONING

C2A

UTILITY DEMAND

FIRE FLOW: 1500 GPM
DOMESTIC WATER: 11,000 GPD
WASTE WATER: 5,000 GPD
ELECTRIC: 1325 AMP 480/277 VOLT 3 PHASE 4 WIRE

SITE INFORMATION

SITE AREA: 5.45 ACRES (237561 SQ. FT.)
IMPERVIOUS AREA ALLOWED: 166,293 SQ. FT. (70%)
IMPERVIOUS AREA PROPOSED: 78,755 SQ. FT. (33.1%)
IMPERVIOUS COVER BY BUILDINGS: 27,689 SQ. FT. (11.7%)
IMPERVIOUS COVER BY DRIVES, PARKING & SIDEWALKS: 51,066 SQ. FT. (21.4%)
TOTAL IMPERVIOUS PROPOSED: 156,827 SQ. FT. (66.9%)

BUILDING INFORMATION

SHOWROOM/SERVICE/PARTS
BUILDING AREA: 23,717 SQ. FT.
BUILDING USE: OFFICE/ SHOWROOM/ WAREHOUSE
BUILDING HEIGHT: 24'-6"

PARKING TABULATION

PARKING REQUIREMENTS:
OFFICE: 1 SPACE PER 200 SQ. FT.
WAREHOUSE: 1 SPACE PER 1,000 SQ. FT.
EMPLOYEE/CUSTOMER PARKING: 52 SPACES
INVENTORY SPACES: 260 SPACES
TOTAL VEHICLE SPACES: 312 SPACES

LEGAL DESCRIPTION

LOT 3, BLOCK A KELLEY TRUST PHASES ONE, TWO AND THREE
A SUBDIVISION OF RECORD IN CABINET 19, SLIDES 594-541
OF THE PLAT RECORDS OF WILLIAMSON COUNTY, TEXAS

DDP NOTES

- FEMA FLOOD PLAIN: ACCORDING TO F.E.M.A. FLOOD INSURANCE RATE MAP NO. 45441 DATED SEPTEMBER 27, 1991, NO PORTION OF THIS PROJECT IS LOCATED WITHIN THE 100 YEAR FLOODPLAIN.
- ELECTRIC SERVICE: DUAL SERVICE PROVIDER AREA. ELECTRIC SERVICE IS PROVIDED BY THE CITY OF GEORGETOWN. REQUIREMENTS SHALL BE COORDINATED THROUGH THE CITY'S ELECTRIC SYSTEM CONSULTANT, DAVID WHITE, MCCORD ENGINEERS AT 474-764-9956 AND DEVELOPMENT PROCESS TEAM MEMBER DURING DESIGN AND BEFORE CONSTRUCTION.
- DUMPSTERS: A SEVEN FOOT ENCLOSURE SHALL BE INCLUDED AROUND ALL DUMPSTERS. TYPE OF DUMPSTER SCREENING WILL BE FENCE ENCLOSURE TYPE, CONSISTENT WITH SECTION 6.505 FIGURE 2 OF THE ZONING ORDINANCE.
- WATER AND WASTE WATER SERVICE: WATER AND WASTE WATER SERVICE REQUIRED TO ALL PROPOSED PUBLIC BUILDINGS, AND ARE PROVIDED BY THE CITY OF GEORGETOWN.
- IRRIGATION: IRRIGATION TO BE PROVIDED TO LANDSCAPED AREAS AS INDICATED ON THE LANDSCAPE PLAN.



SITE PLAN NOTES

- CONTRACTOR TO FIELD VERIFY LOCATION & ELEVATION OF EXISTING WASTE WATER SERVICE.
- ALL DIMENSIONS ARE TO THE FACE OF CURB UNLESS OTHERWISE NOTED.
- ALL CURBS ARE SPILL CURBS UNLESS OTHERWISE NOTED.
- THE LOCATION OF EXISTING UNDERGROUND UTILITIES ARE SHOWN IN AN APPROXIMATE LOCATION ONLY. THE CONTRACTOR SHALL DETERMINE THE EXACT LOCATION OF ALL EXISTING UTILITIES BEFORE COMMENCING WORK. THE CONTRACTOR AGREES TO BE OCCASIONED BY HIS FAILURE TO EXACTLY LOCATE AND PRESERVE ANY ALL UNDERGROUND UTILITIES.
- ANY RELOCATION OF THE EXISTING GEORGETOWN UNDERGROUND ELECTRICAL LINE LOCATED WITHIN THE 15' P.U.E. NORTH OF THE T.P.L. TRANSMISSION R.O.L. WILL BE AT THE DEVELOPER'S EXPENSE.

SIGNAGE NOTES & CALCULATIONS (SIGNS AND BASES BY OWNERS SIGN CONSULTANT)

- MAXIMUM AREA OF A POLE SIGN SHALL BE 225 SQ. FT. PER FACE WITH A MAXIMUM OF TWO FACES. PROPERTIES WITH 11-35 FRONTAGE MAY HAVE ONE POLE SIGN FOR EACH 600 FEET OF FRONTAGE AND SHALL BE SPACED A MINIMUM OF 100 FEET APART. HEIGHT LIMIT SHALL BE A MAXIMUM OF 28 FEET.
- BUILDING SIGNAGE NOT TO EXCEED CITY OF GEORGETOWN REGULATIONS OF ONE (1) SQUARE FOOT OF WALL SIGNAGE PERMITTED FOR EACH LINEAR FOOT OF THE PRIMARY FACADE OF THE BUILDING EXCLUDING WING WALLS.
- MAXIMUM BUILDING SIGNAGE ALLOWABLE (1 SQ.FT./ 1 LINEAR FT.) - 170 SQ. FT.
- PROPOSED SITE SIGNAGE:
 - PLYON SIGN NOT TO EXCEED 28 FEET HIGH AND LIMITED TO 225 SQUARE FEET MAXIMUM. SIGN MUST BE LOCATED WITHIN 50' OF 11-35.
 - MONUMENT SIGN NOT TO EXCEED 8' IN HEIGHT AND LIMITED TO 64 SQUARE FEET MAXIMUM. SIGN MUST BE LOCATED BEYOND 50' OF 11-35.
 - MONUMENT SIGN NOT TO EXCEED 8' IN HEIGHT AND LIMITED TO 48 SQUARE FEET MAXIMUM.

GENERAL ABBREVIATIONS	
ABBREVIATION	DEFINITION
A.F.F.	ABOVE FINISH FLOOR
ALUM.	ALUMINUM
BLK'G	BLOCKING
B.O.S.	BOTTOM OF STEEL
BUS.	BUSINESS
C.	CENTER LINE
CMU	CONCRETE MASONRY UNIT
CONV.	CONVENIENCE
DIA.	DIAMETER
E.I.F.S.	EXTERIOR INSULATION FINISH SYSTEM
ELEV.	ELEVATOR
E.O.S.	EDGE OF SLAB
EQUIP.	EQUIPMENT
EXT.	EXTERIOR
F.G.	FINISH GRADE
FIN.	FINISH
F.A.M.	FACE OF MASONRY
G.A.	GAGE
GALV.	GALVANIZED
G.C.	GENERAL CONTRACTOR
GYP.	GYPSEUM BOARD
HR.	HOUR
INT.	INTERIOR
MAX.	MAXIMUM
MIN.	MINIMUM
N.I.C.	NOT IN CONTRACT
N.T.S.	NOT TO SCALE
O/C	ON CENTER
O.F.	OVERFLOO DRAIN
P.E.B.	PRE-ENGINEERED BUILDING
P.T.	PRESSURE TREATED
R.	RADIUS
R.D.	ROOF DRAIN
REF.	REFERENCE
S.S.	STAINLESS STEEL
SQ. FT.	SQUARE FEET
T.O.B.	TOP OF BEAM
T.O.C.	TOP OF CONCRETE
T.O.M.L.	TOP OF MASONRY LUG
T.O.S.	TOP OF STEEL
T.O.P.	TOP OF PARAPET
T.S.	TUBE STEEL
TYP.	TYPICAL
U.L.	UNDERWRITERS LABORATORY
U.S.G.	UNITED STATE GYPSEUM
O.H.	OVER HANG

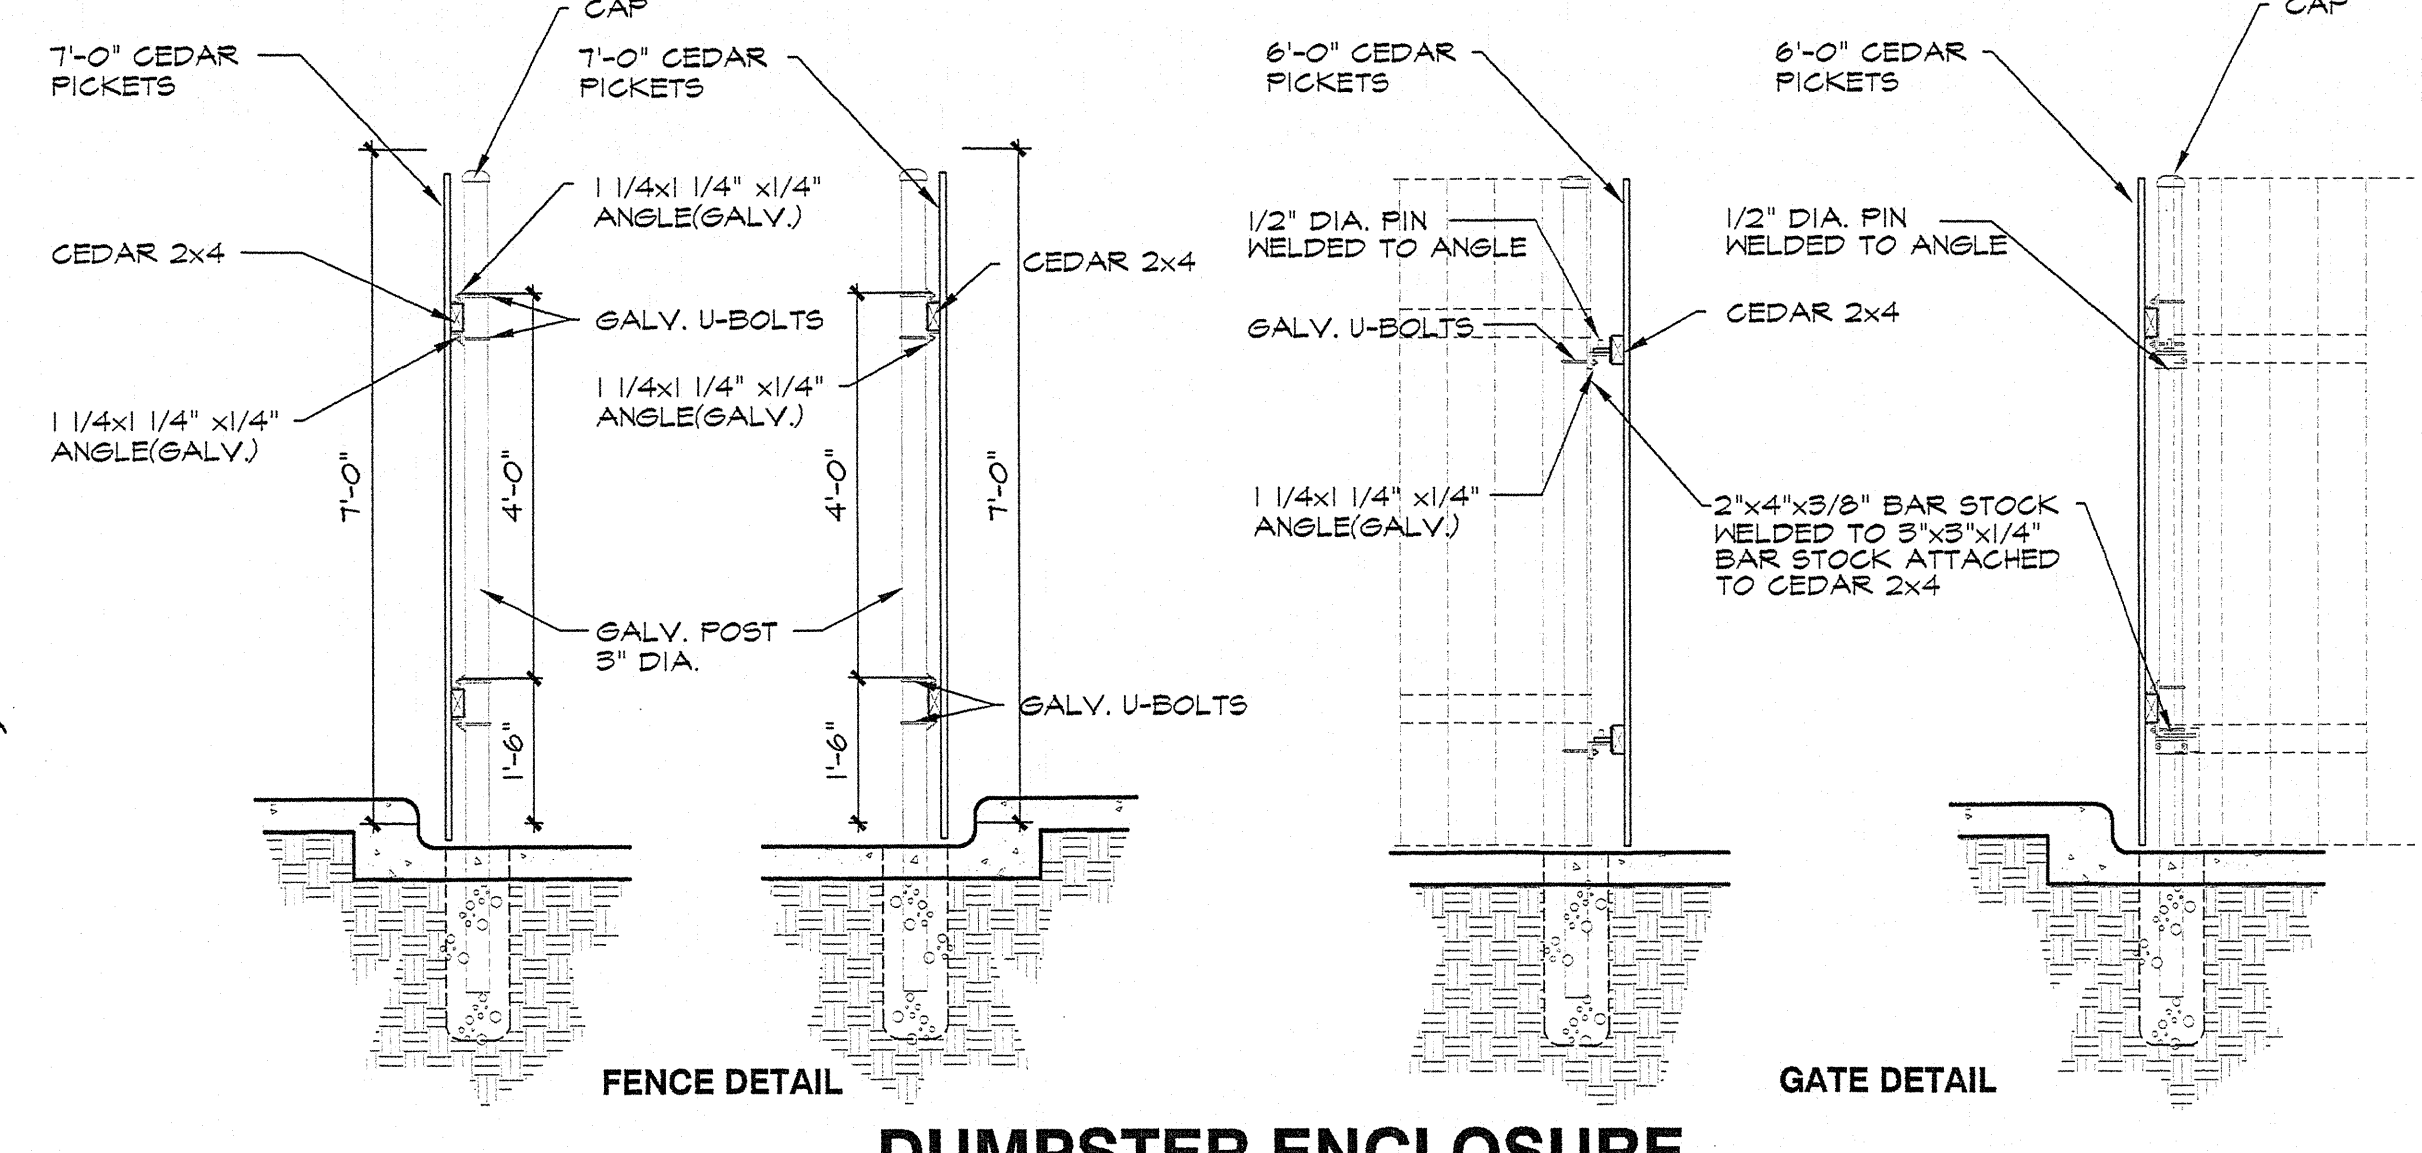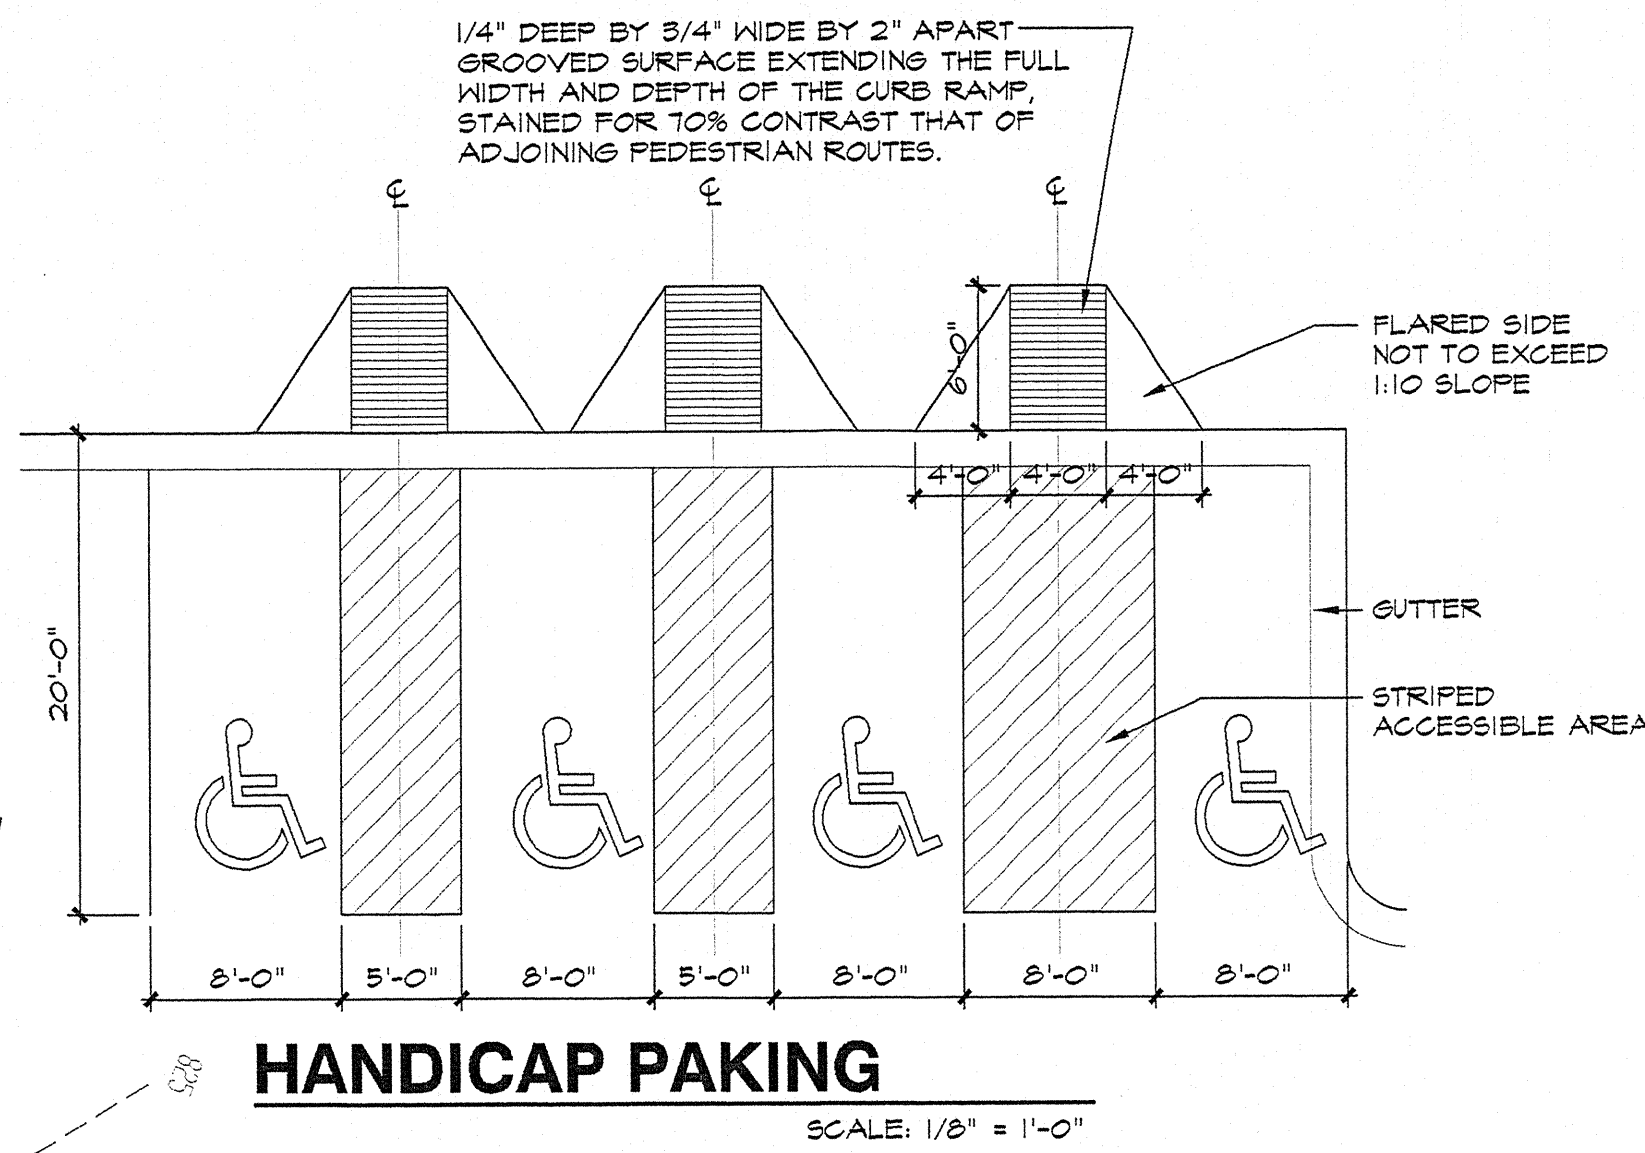

HANDICAP PAKING

SCALE: 1/8" = 1'-0"


DUMPSTER ENCLOSURE

SCALE: N.T.S.

FIRE LANE MARKINGS

SCALE: N.T.S.

INTERSTATE HIGHWAY - 35 FRONTAGE

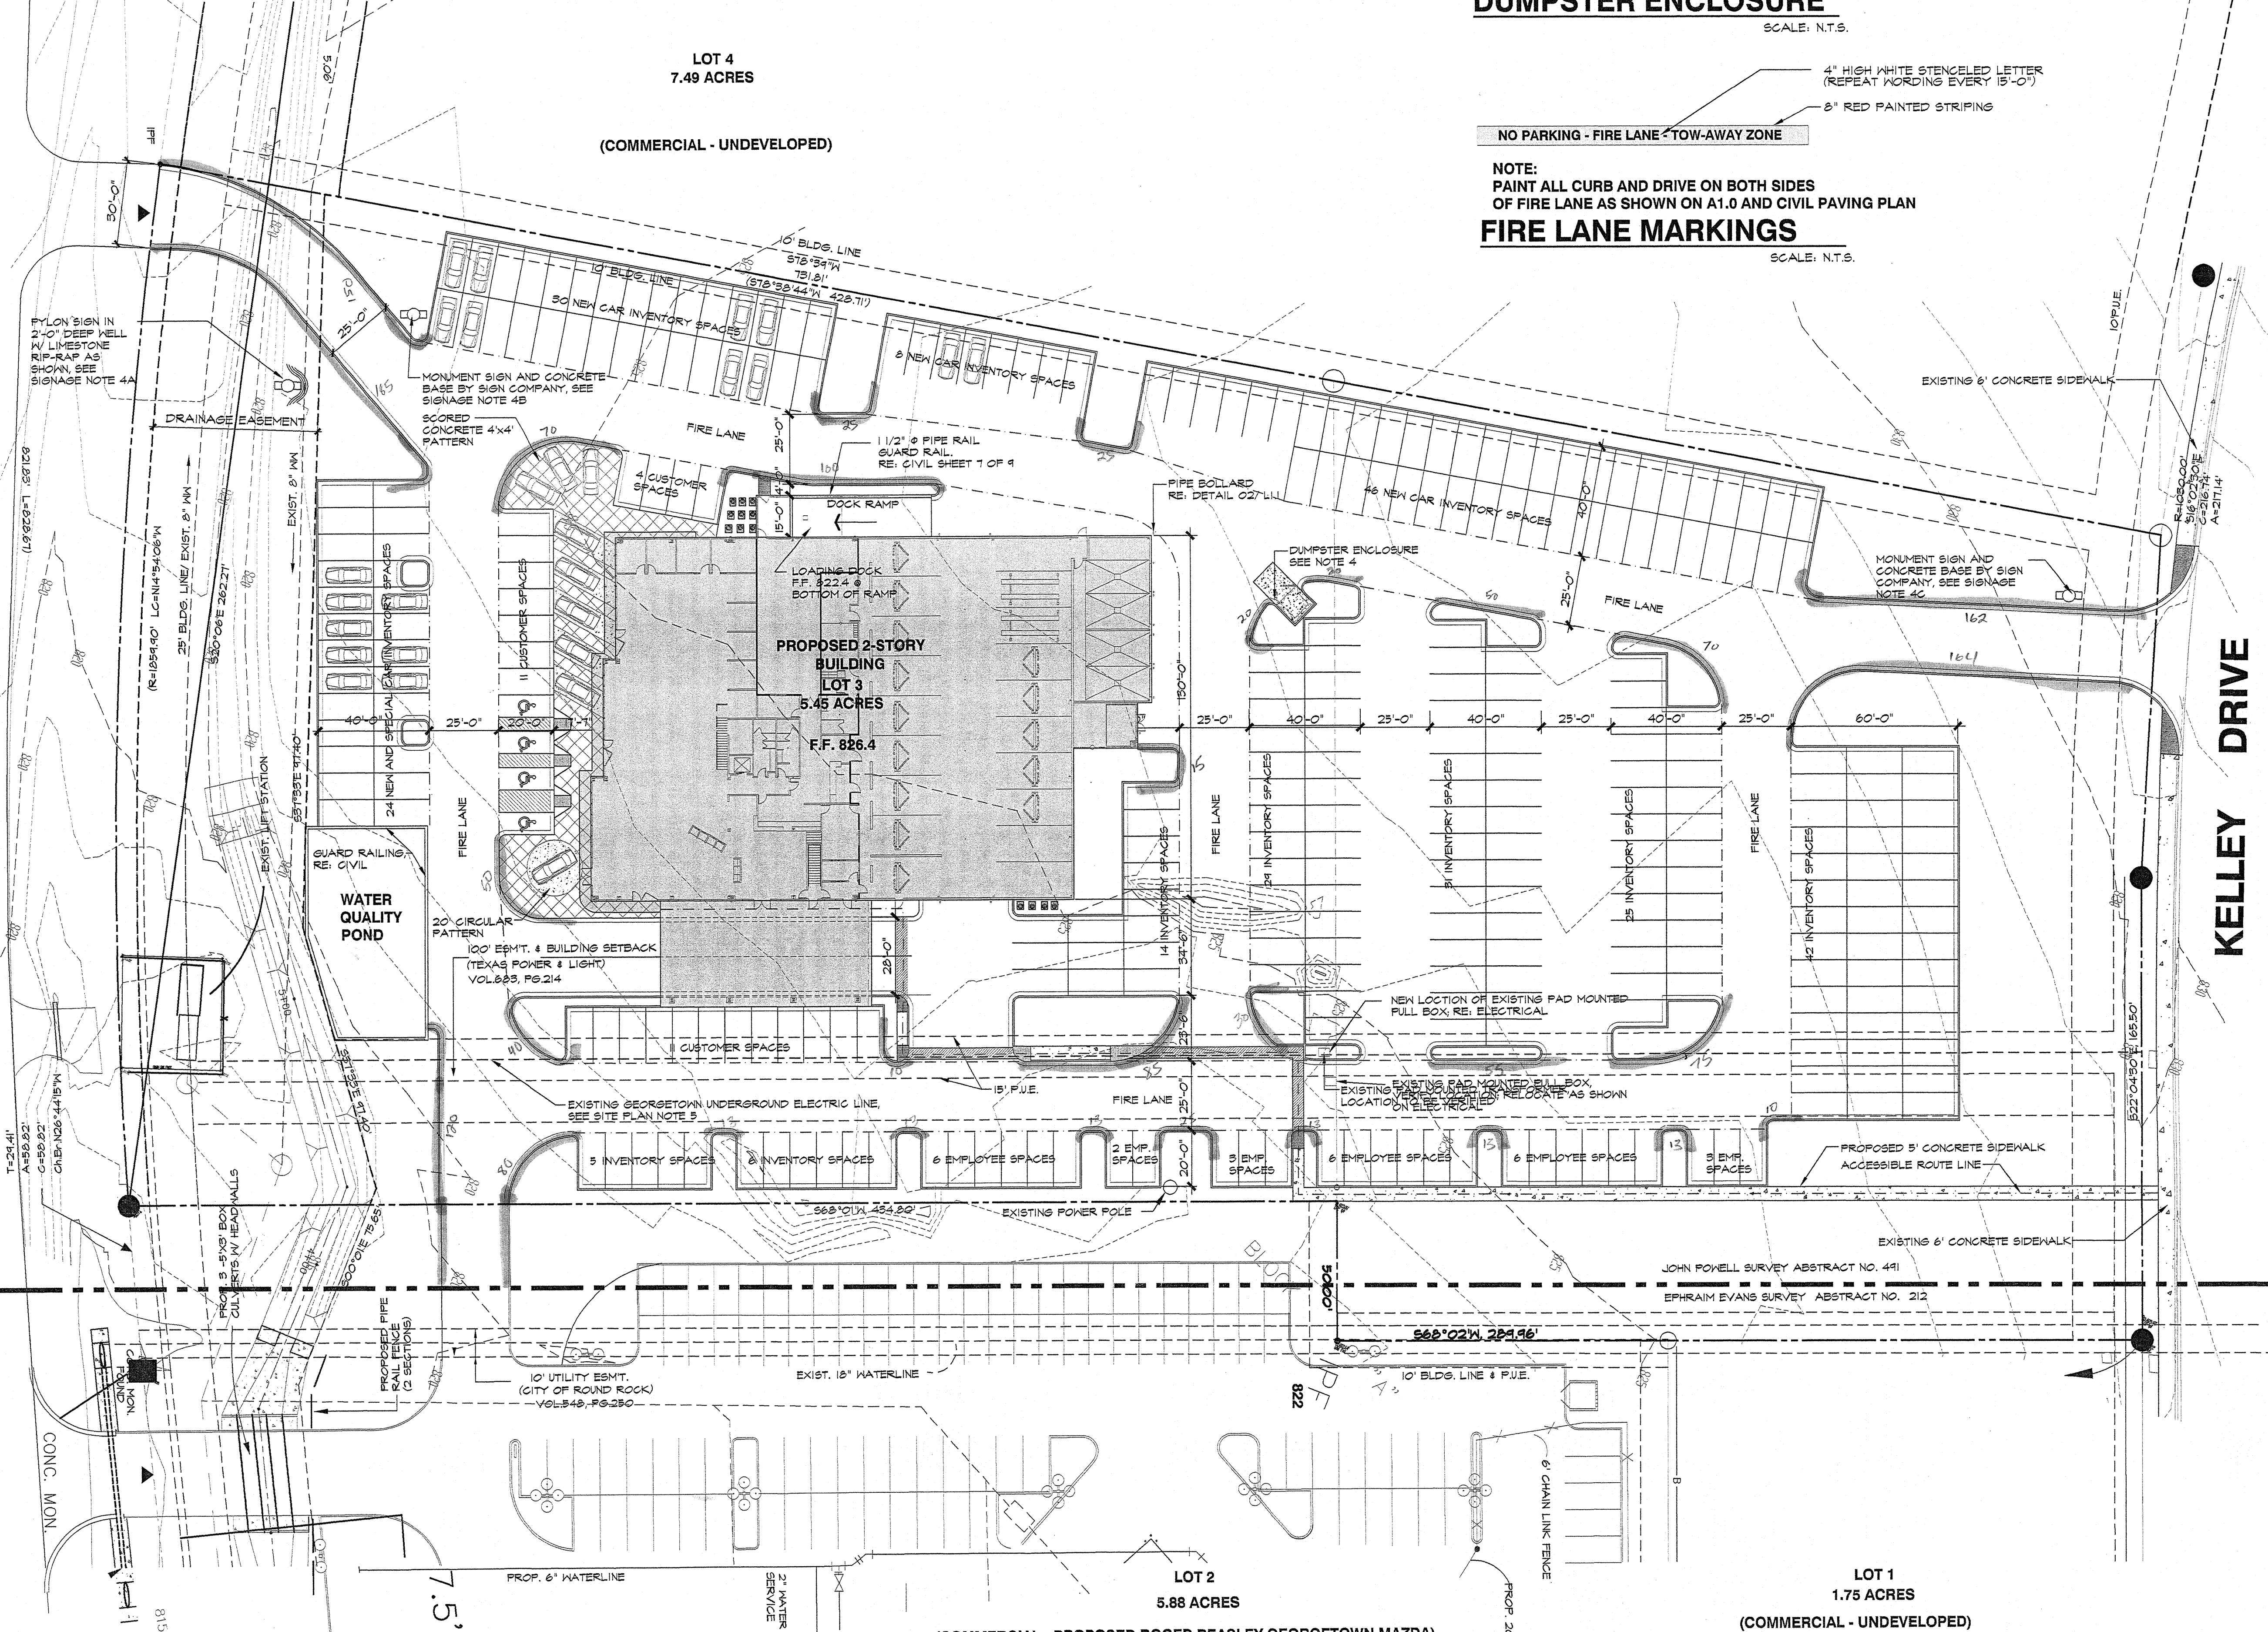

ARCHITECTURAL SITE PLAN

SCALE: 1" = 40'-0"


AN AUTOMOTIVE DEALERSHIP
ROGER BEASLEY VOLVO

INTERSTATE HIGHWAY 35 SOUTH
GEORGETOWN, TEXAS

ELISSA
ARCHITECTURAL
INC.
ARCHITECTURE AND PLANNING

P.O. BOX 833 GEORGETOWN, TX 78627
(512) 838-5553 FAX (512) 838-5518 www.eah.com

CONSULTANT
INFORMATION:

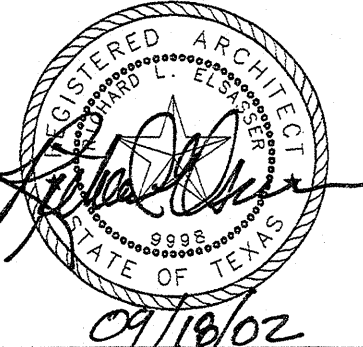


DATE:
09/18/02
REVISION DATE:

PROJECT NO.
02008

SHEET NO.

A1.0

INTERSTATE HIGHWAY - 35 FRONTAGE

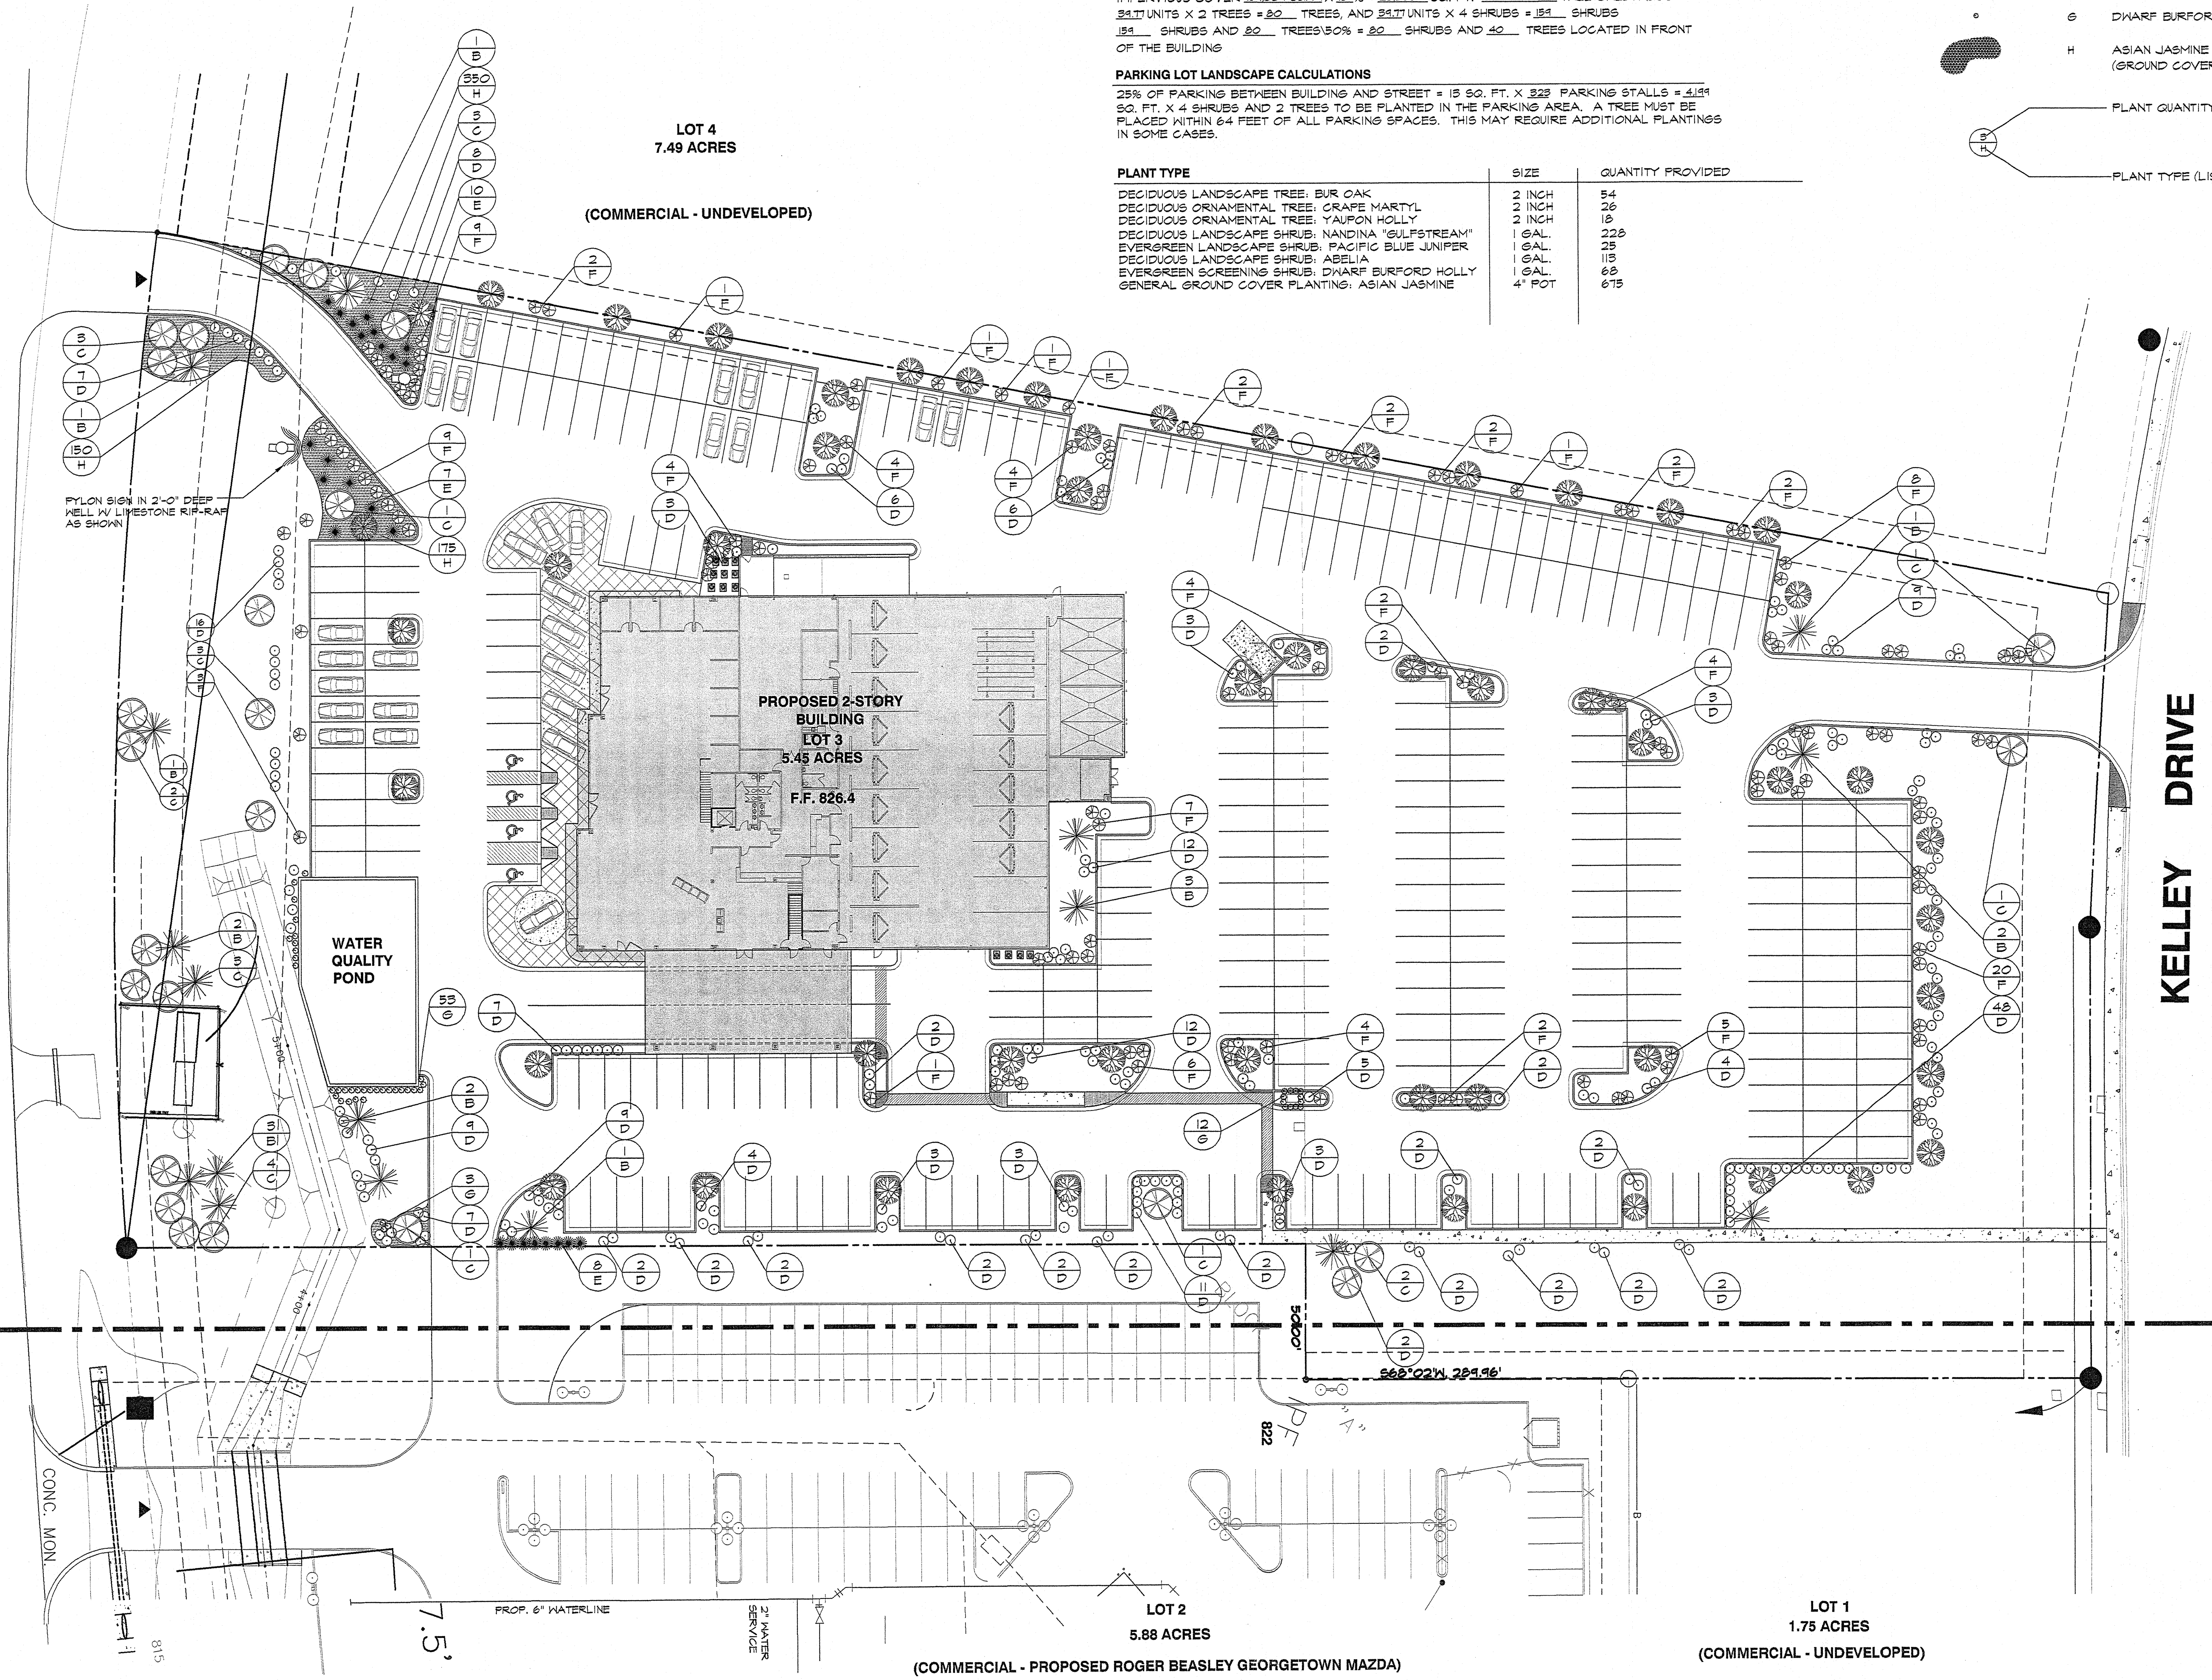

LANDSCAPE NOTES

1. A CONVENTIONAL AUTOMATIC IRRIGATION SYSTEM SHALL BE PROVIDED TO ALL LANDSCAPED AREAS.
2. IRRIGATION SYSTEM SHALL BE DESIGNED BY IRRIGATION CONTRACTOR AND PROVIDE CITY WITH SHOP DRAWING LAYOUT.
3. IRRIGATION SYSTEM SHALL HAVE RAIN AND FREEZE SENSORS BUILT INTO SYSTEM.
4. MAINTENANCE: THE CURRENT OWNER AND SUBSEQUENT OWNERS OF THE LANDSCAPED PROPERTY, OR THE MANAGER OR AGENT OF THE OWNER, SHALL BE RESPONSIBLE FOR THE MAINTENANCE OF ALL LANDSCAPED AREAS. SAID AREAS SHALL BE MAINTAINED SO AS TO PRESENT A HEALTHY, NEAT AND ORDERLY APPEARANCE AT ALL TIMES AND SHALL BE KEPT FREE OF REFUSE AND DEBRIS. MAINTENANCE SHALL INCLUDE THE REPLACEMENT OF ALL DEAD PLANT MATERIAL IF THAT MATERIAL HAS USED TO MEET THE REQUIREMENTS OF THE CITY OF GEORGETOWN ZONING ORDINANCE.
5. IRRIGATION CONTRACTOR SHALL PROVIDE AND INSTALL SLEEVES UNDER PAVING, CURB & GUTTER AND SIDEWALKS AS REQUIRED FOR IRRIGATION SYSTEM. COORDINATE WITH CONCRETE CONTRACTOR PRIOR TO PLACEMENT OF CONCRETE.

LANDSCAPE DATA

BUFFER TYPE (WIDTH) NORTH, EAST AND WEST
BUFFER TYPE (WIDTH) SOUTH
BUFFER REQUIREMENTS (NORTH, EAST, WEST)
BUFFER REQUIREMENTS (SOUTH)

1" (10'-0")
1" (15'-0")
1 DECIDUOUS SHRUB PER 100'
2 DECIDUOUS SHRUBS & 1 EVERGREEN PER 100'

REQUIRED LANDSCAPE AREA (15% OF IMPERVIOUS)
REQUIRED LANDSCAPE AREA AFTER EXISTING CANOPY CREDIT

25,865 SQ. FT.
0 SQ. FT.

PARKING LOT TREE REQUIREMENT (1 TREE / 64' OF PARKING SPACE)
PARKING LOT LANDSCAPE REQUIRED (15 SQ. FT. PER SPACE)
PARKING LOT SCREEN REQUIRED (6' MIN. OFFSET/ 60' SCREEN)

55 TREES
4,194 SQ. FT. OR 7 TREES
SHRUBS PROVIDED

BUFFER YARD DATA

	TYPE	REQUIRED	PROVIDED
NORTH BUFFER YARD	A	6 SHRUBS	17
SOUTH BUFFER YARD	A	6 SHRUBS 6 EVERGREENS	24 17

LANDSCAPE CALCULATIONS

IMPERVIOUS COVER 154,084 SQ. FT. X .15 = 23,113 SQ. FT. TREE CREDIT 600 = 34.17 UNITS X 2 TREES = 68 TREES, AND 34.17 UNITS X 4 SHRUBS = 134 SHRUBS
154 SHRUBS AND 82 TREES X 50% = 82 SHRUBS AND 42 TREES LOCATED IN FRONT OF THE BUILDING

PARKING LOT LANDSCAPE CALCULATIONS

25% OF PARKING BETWEEN BUILDING AND STREET = 15 SQ. FT. X 325 PARKING SPACES = 4,875 SQ. FT. X 4 SHRUBS AND 2 TREES TO BE PLANTED IN THE PARKING AREA. A TREE MUST BE PLACED WITHIN 64 FEET OF ALL PARKING SPACES. THIS MAY REQUIRE ADDITIONAL PLANTINGS IN SOME CASES.

PLANT TYPE

PLANT TYPE	SIZE	QUANTITY PROVIDED
DECIDUOUS LANDSCAPE TREE: BUR OAK	2 INCH	54
DECIDUOUS ORNAMENTAL TREE: GRAPE MYRTLE	2 INCH	26
DECIDUOUS ORNAMENTAL TREE: YAUPOH HOLLY	2 INCH	18
DECIDUOUS LANDSCAPE SHRUB: NANDINA 'SULFSTREAM'	1 GAL.	228
EVERGREEN LANDSCAPE SHRUB: PACIFIC BLUE JUNIPER	1 GAL.	25
DECIDUOUS LANDSCAPE SHRUB: ABELIA	1 GAL.	115
EVERGREEN SCREENING SHRUB: DWARF BURFORD HOLLY	1 GAL.	68
GENERAL GROUND COVER PLANTING: ASIAN JASMINE	4" POT	675

PLANT LIST

PLANT SYMBOL	TYPE	PLANT DESCRIPTION
A	A	BUR OAK, 2" CALIPER
B	B	YAUPOH HOLLY, 2" CALIPER
C	C	GRAPE MYRTLE, 2" CALIPER
D	D	NANDINA 'SULFSTREAM'
E	E	PACIFIC BLUE JUNIPER
F	F	ABELIA
G	G	DWARF BURFORD HOLLY
H	H	ASIAN JASMINE (GROUND COVER)

PLANT QUANTITY


PLANT TYPE (LISTED ABOVE)

AN AUTOMOTIVE DEALERSHIP
ROGER BEASLEY VOLVO

INTERSTATE HIGHWAY 35 SOUTH
GEORGETOWN, TEXAS

ELSASSER
ARCHITECTURAL
INC.
ARCHITECTURE AND PLANNING
P.O. BOX 555 GEORGETOWN, TX 78627
(512) 890-5555 FAX (512) 890-5515 www.elsa.com

CONSULTANT
INFORMATION:

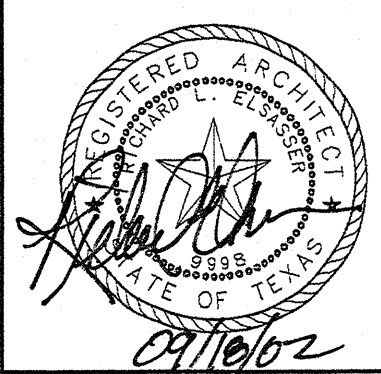

DATE:
09/18/02

REVISION DATE:

PROJECT NO.
02008


SHEET NO.

L1.0



LANDSCAPE PLAN

SCALE: 1" = 30'-0"

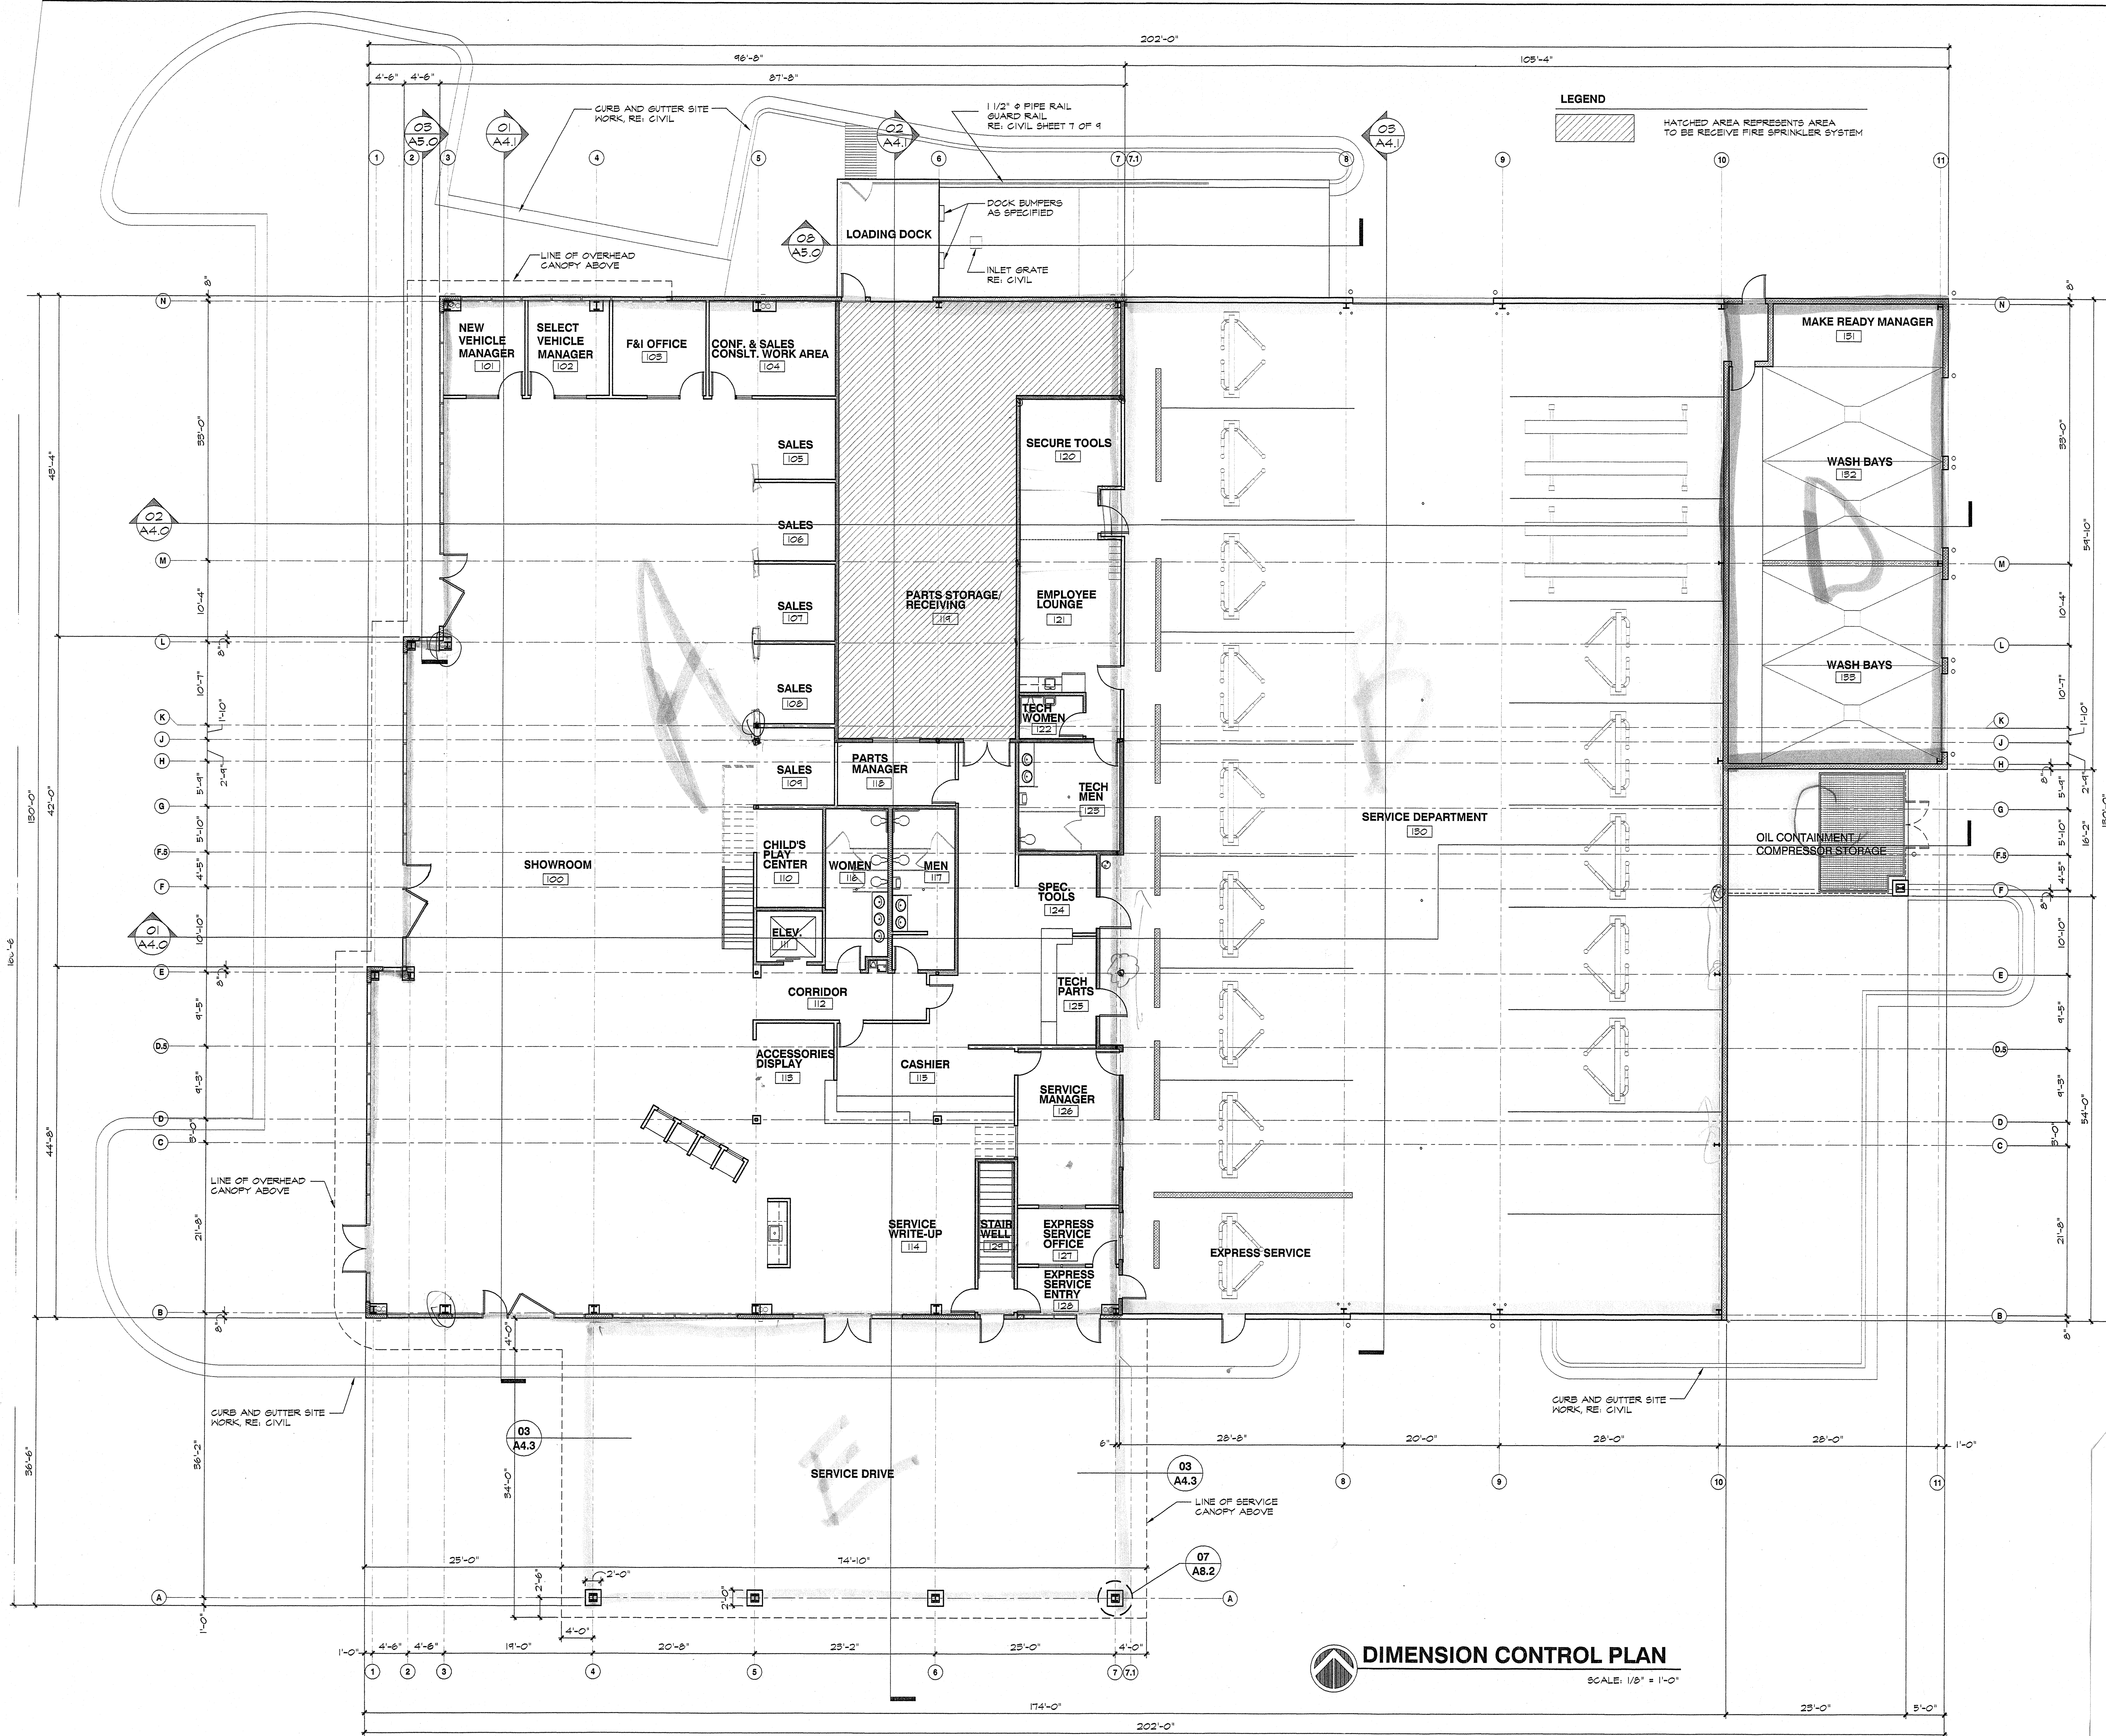

LEGEND
 HATCHED AREA REPRESENTS AREA TO BE RECEIVE FIRE SPRINKLER SYSTEM


DIMENSION CONTROL PLAN
 SCALE: 1/8" = 1'-0"

SEE
 REVISED

AN AUTOMOTIVE DEALERSHIP
ROGER BEASLEY VOLVO
 INTERSTATE HIGHWAY 35 SOUTH
 GEORGETOWN, TEXAS

ELASSER ARCHITECTURAL INC.
 ARCHITECTURE AND PLANNING
 P.O. BOX 833 GEORGETOWN, TX 78627
 (512) 530-5553 FAX (512) 530-2618 www.ea-h.com

CONSULTANT
 INFORMATION:

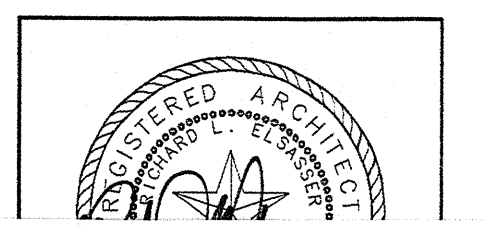

ARCHITECT'S
SUPPLEMENTAL INSTRUCTIONS
AIA DOCUMENT G710 - ELECTRONIC FORMAT

OWNER ☒
ARCHITECT ☒
CONSULTANT ☐
CONTRACTOR ☒
FIELD ☒
OTHER ☐

THIS DOCUMENT HAS IMPORTANT LEGAL CONSEQUENCES. CONSULTATION WITH AN ATTORNEY IS ENCOURAGED WITH RESPECT TO ITS COMPLETION OR MODIFICATION. AUTHENTICATION OF THIS ELECTRONICALLY DRAFTED AIA DOCUMENT MAY BE MADE BY USING AIA DOCUMENT 910.

PROJECT: Roger Beasley Volvo, 1135 S. Georgetown
(Name, address)

ARCHITECT'S SUPPLEMENTAL
INSTRUCTION NO: 01

OWNER: Roger Beasley Volvo

ARCHITECT: Elsassers Architectural, Inc.

TO: ETWoods Construction
(Contractor)

CONTRACT FOR: General Construction

ARCHITECT'S PROJECT NO: 02008

CONTRACT DATED: May 23, 2002

The Work shall be carried out in accordance with the following supplemental instructions issued in accordance with the Contract Documents without change in Contract Sum or Contract Time. Proceeding with the Work in accordance with these instructions indicates your acknowledgment that there will be no change in the Contract Sum or Contract Time.

Description:

Item #1: Relocate metal stud framing at Hi-Lo water cooler in the showroom between the Mens and Womens restrooms, as indicated on the enclosed partial plan sheet titled HI/LO WATER COOLER and dated 08/25/03.

Item #2: Relocate door into Tech Mens Restroom to accommodate column base plate. Also relocate the wall containing the door into Tech Womens Restroom to provide the required 1'-0" clear floor space to the push side of the strike jamb of the door into Tech Mens Restroom. The break room counter shall be reduced to 4'-10" in length. See enclosed partial plan sheet titled TECH WOMENS RESTROOM dated 08/25/03.


Attachments:
(Here insert listing of documents that support description.)

Partial Plan Sheets:
HI/LO WATER COOLER - dated 08/25/03
TECH WOMENS RESTROOM - dated 08/25/03

ISSUED BY:



Richard Elsassers 08/27/03

Richard Elsassers
Architect

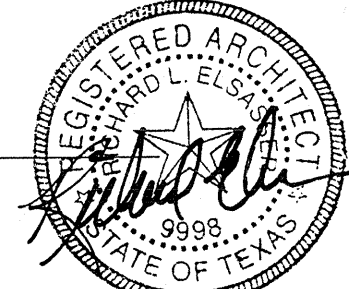

© 1992 THE AMERICAN INSTITUTE OF ARCHITECTS, 1735 NEW YORK AVENUE, N.W., WASHINGTON, D.C. 20006-5291. AIA DOCUMENT G710 - ARCHITECT'S SUPPLEMENTAL INSTRUCTIONS - 1992 EDITION - AIA® - WARNING: Unlicensed photocopying violates U.S. copyright laws and will subject the violator to legal prosecution. This document was electronically produced with permission of the AIA and can be reproduced in accordance with your license without violation until the date of expiration as noted below. User Document: g710-volvo-#1.aia - 8/27/2003. AIA License Number 1117238, which expires on 8/20/2004.

Electronic Format G710 - 1992

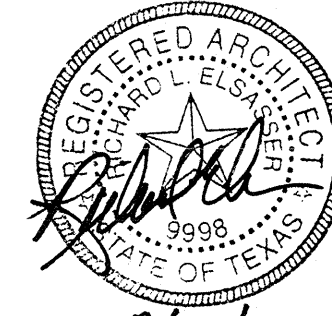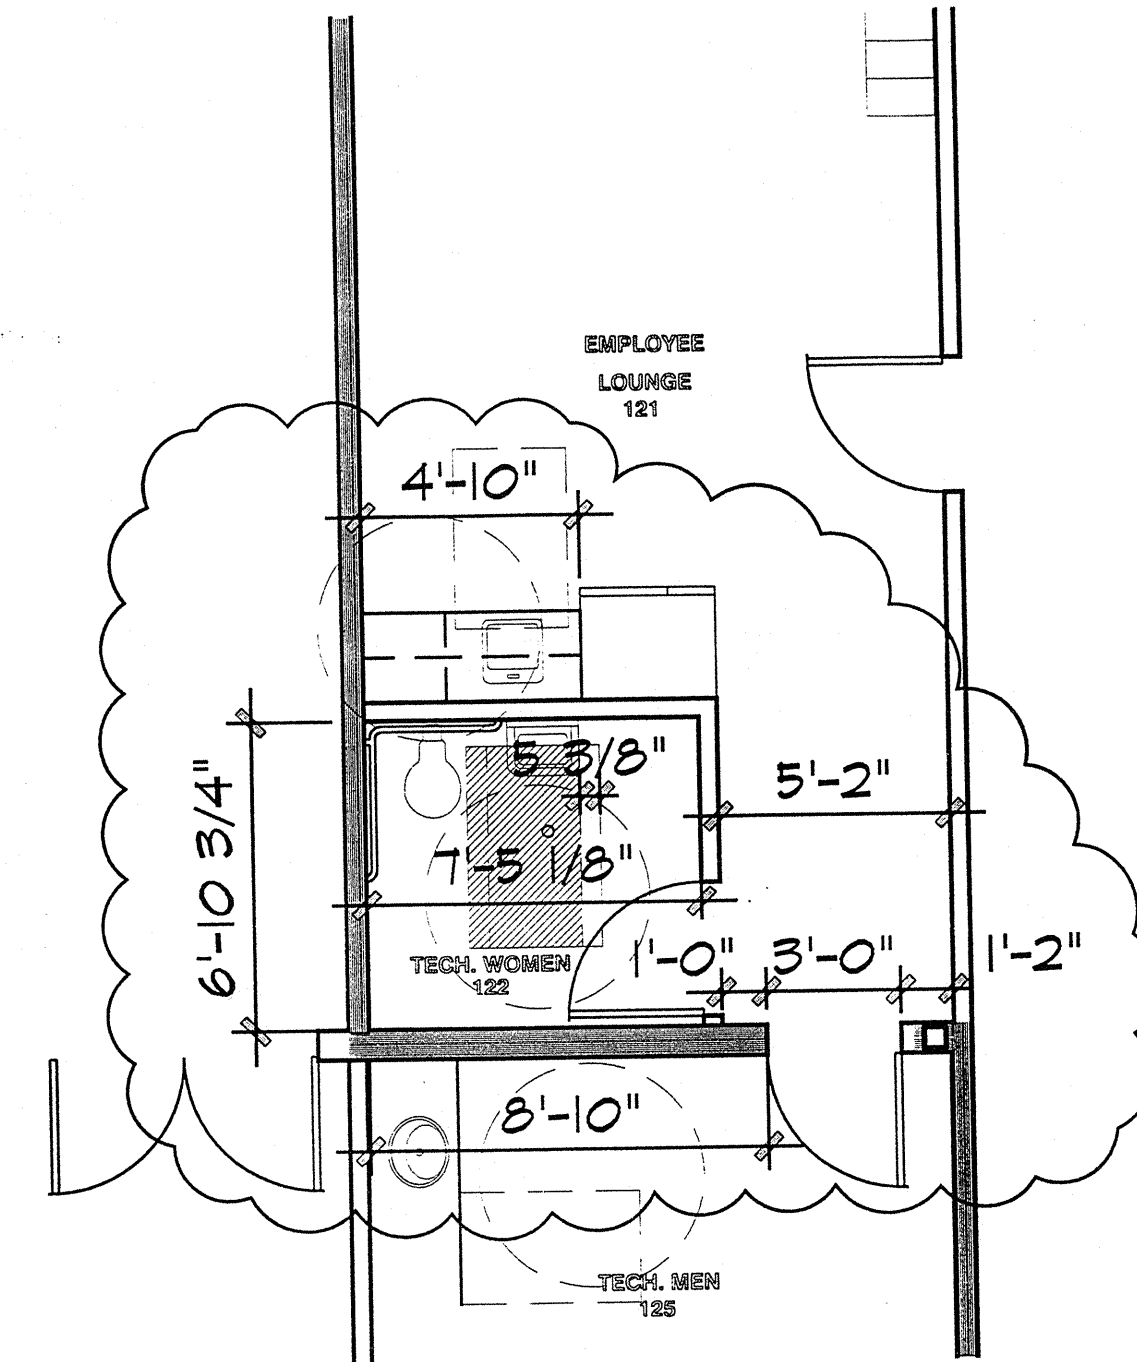


08/25/03
TECH WOMENS RESTROOM
SCALE 1/4" = 1'-0"

ELSASSERS
ARCHITECTURAL
INC.
ARCHITECTURE AND PLANNING
P.O. BOX 853 GEORGETOWN, TX 78627
(512) 930-5353 FAX (512) 930-5353 www.elsa.com

AN AUTOMOTIVE DEALERSHIP
ROGER BEASLEY VOLVO
INTERSTATE HIGHWAY 38 SOUTH
GEORGETOWN, TEXAS

AUG-25-03 09:28 AM ELSASSERS, ARCHITECTURAL 512 9305353 P-01

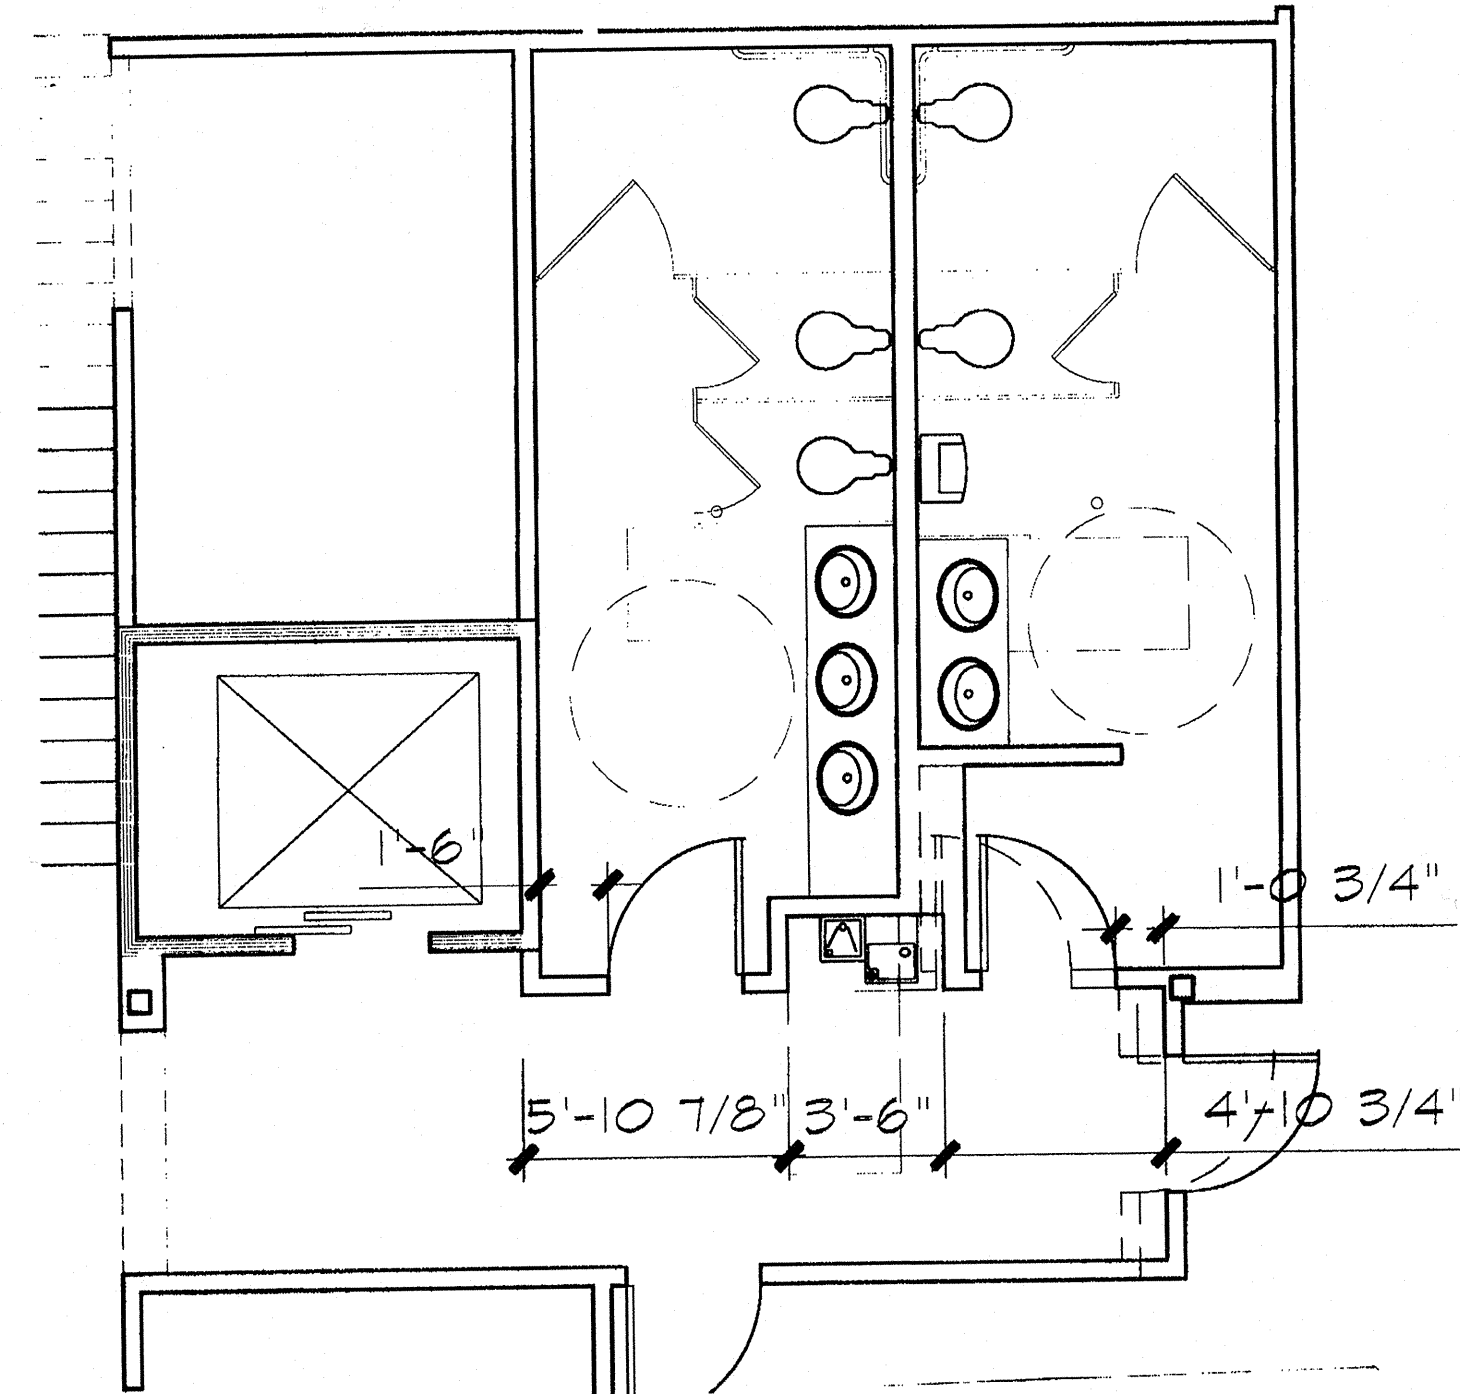

08/25/03
HI/LO WATER COOLER
SCALE 1/4" = 1'-0"

ELSASSERS
ARCHITECTURAL
INC.
ARCHITECTURE AND PLANNING
P.O. BOX 853 GEORGETOWN, TX 78627
(512) 930-5353 FAX (512) 930-5353 www.elsa.com

AN AUTOMOTIVE DEALERSHIP
ROGER BEASLEY VOLVO
INTERSTATE HIGHWAY 38 SOUTH
GEORGETOWN, TEXAS

PostNet Fax Note	7671	On 8/25/03	Page 1
From	ELSASSERS	To	BEASLEY
Cell Phone	930-5353	Cell Phone	930-5353
Phone #	930-5353	Phone #	930-5353
Fax #	930-5353	Fax #	930-5353

MATCH LINE SEE SHEET A2.2 FOR SERVICE DEPT. PLAN

CROSS HATCHED AREA INDICATES 2 HR. FIRE RATED PLANE SEE SECTION 02/A4.0

EXPANSION JOINT COVER RE. DETAIL 15/A8.2


EYE-WASH, RE. PLUMBING

EXPANSION JOINT COVER RE. DETAIL 15/A8.2

CROSS HATCHED AREA INDICATES 2 HR. FIRE RATED PLANE SEE SECTION 02/A4.0

ROLL DOWN FIRE SHUTTER ABOVE WINDOW, AS SPECIFIED

LINE OF SERVICE CANOPY ABOVE

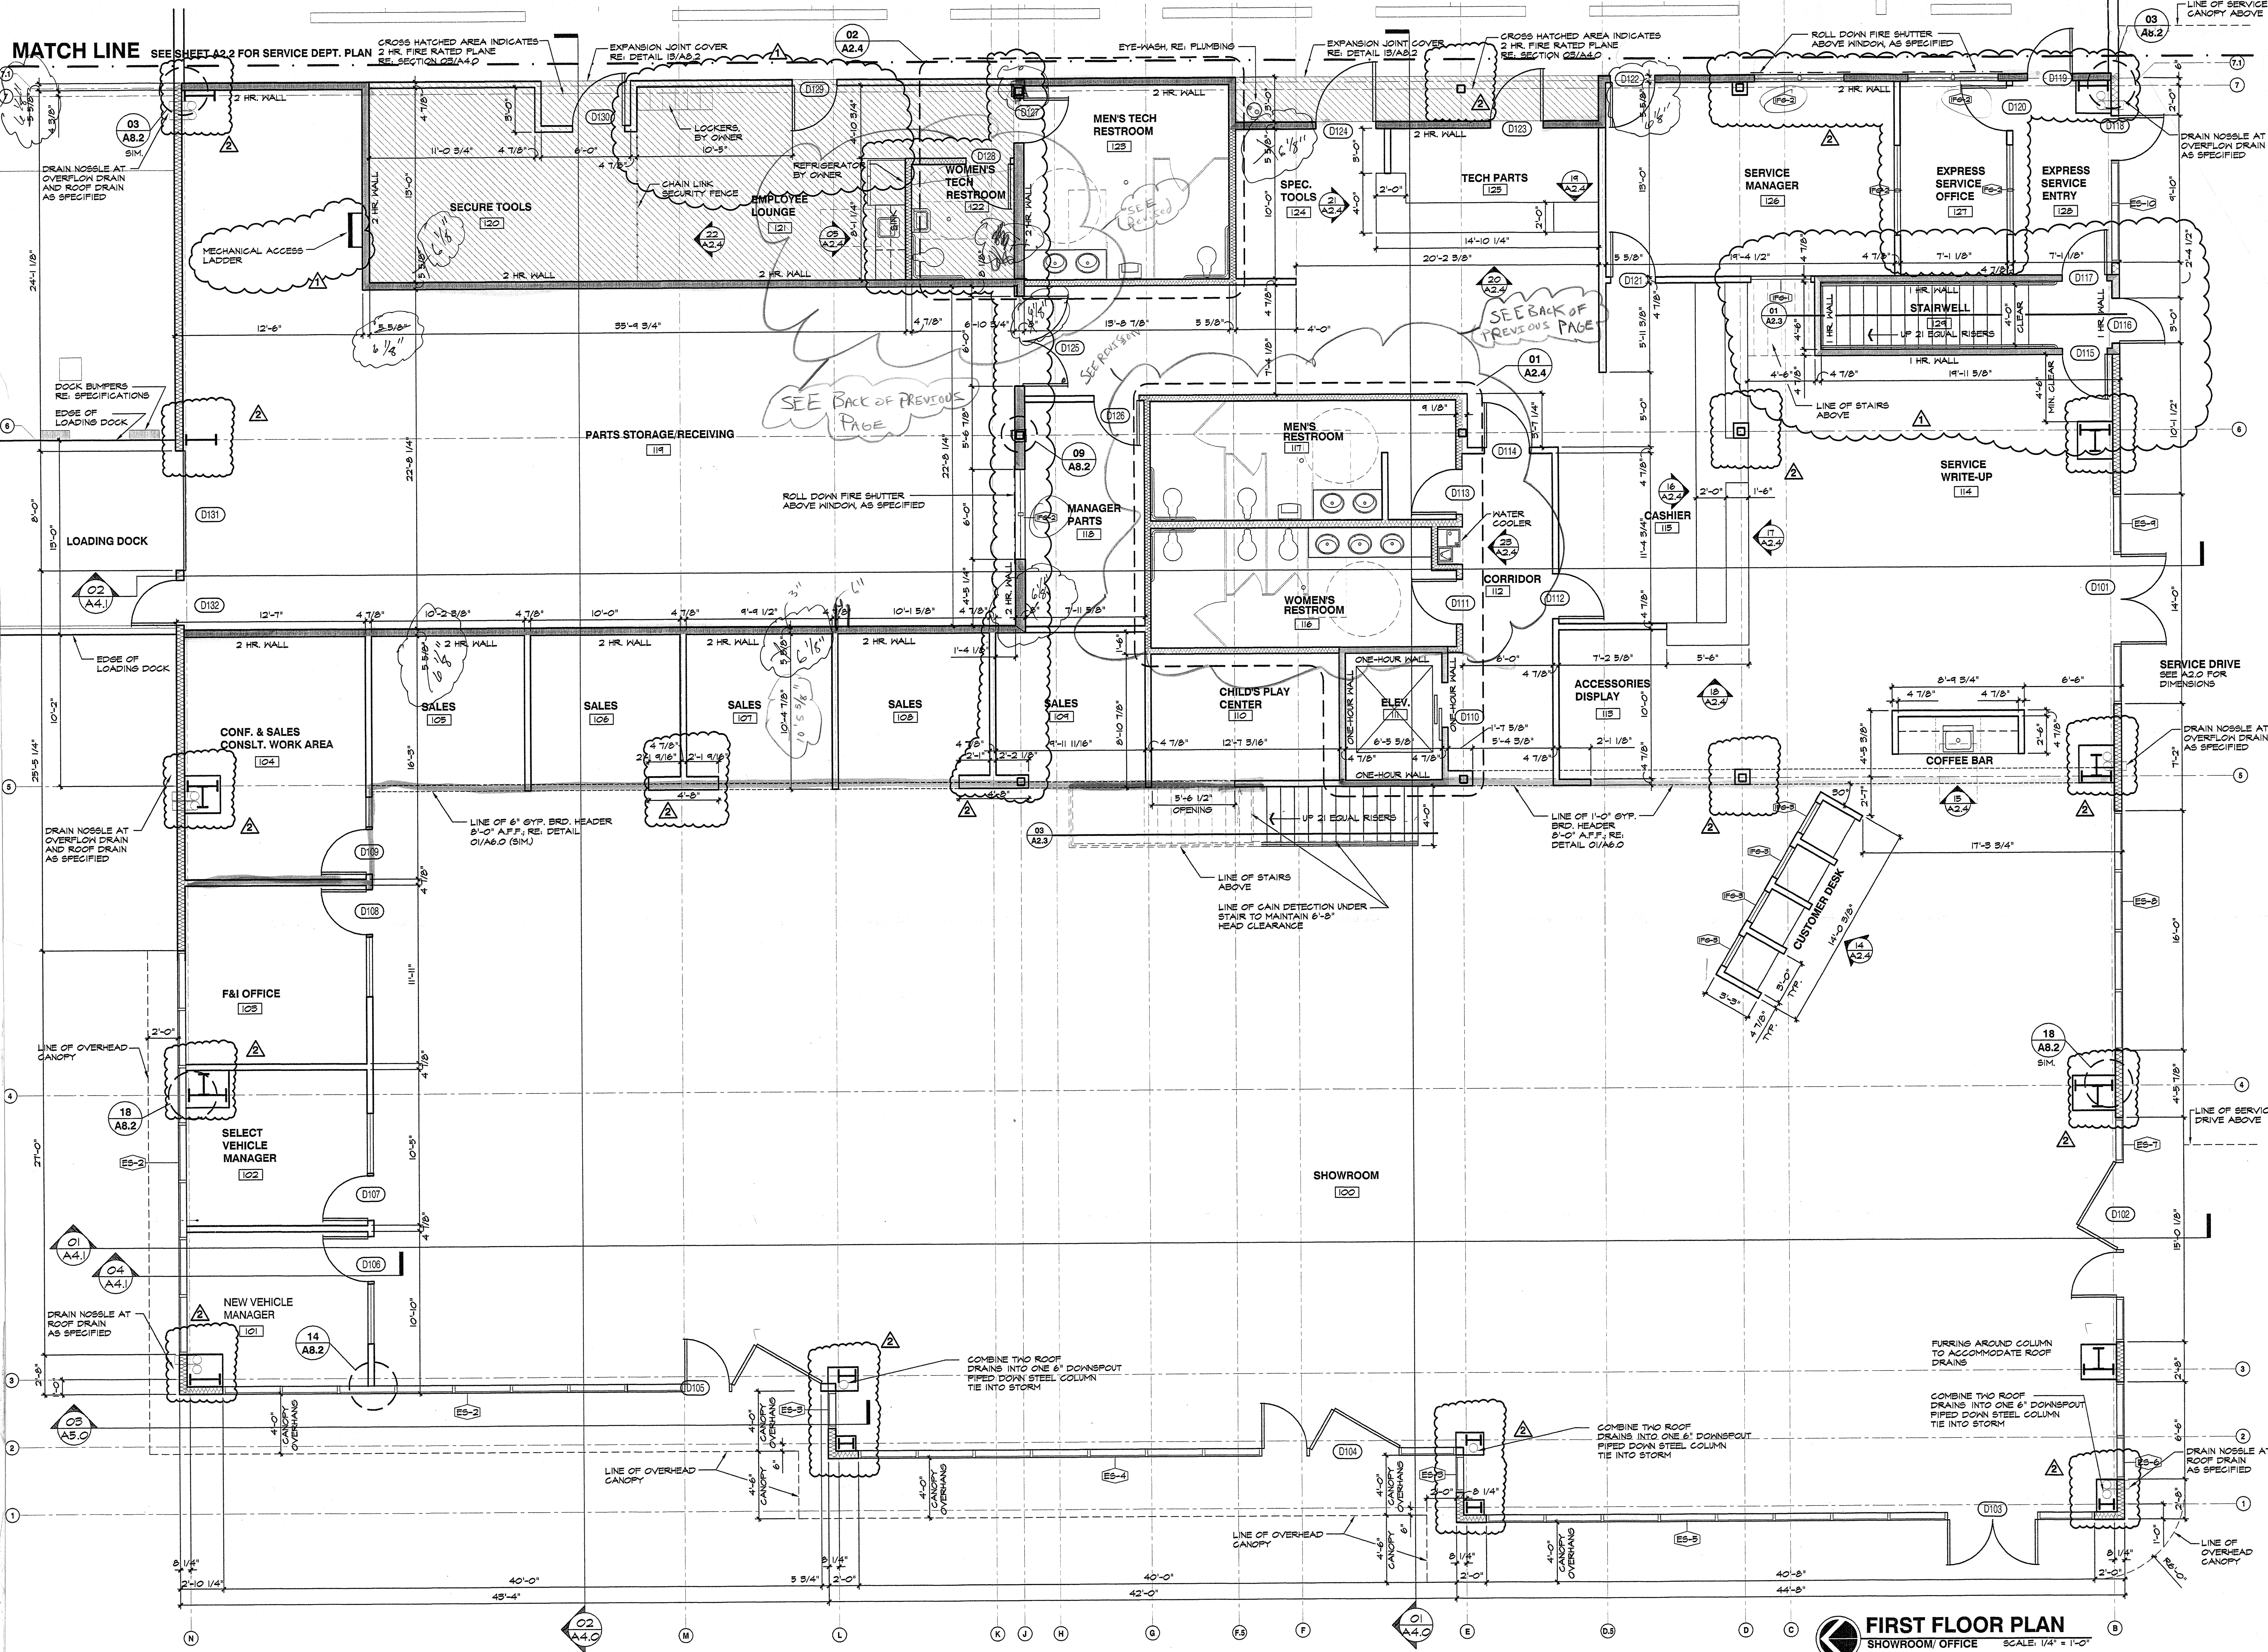

AN AUTOMOTIVE DEALERSHIP
ROGER BEASLEY VOLVO

INTERSTATE HIGHWAY 35 SOUTH
GEORGETOWN, TEXAS

ELCASSER ARCHITECTURAL INC.
ARCHITECTURE AND PLANNING
P.O. BOX 833 GEORGETOWN, TX 78627
(512) 506-5553 FAX (512) 500-2610 www.elcas.com

REV. #	DESCRIPTION	DATE
1	ADJUSTED STAIR WELL TO MEET A.P.A. COMMENTS, RELOCATED DOOR D124, ADDED MECHANICAL ACCESS LADDER	11/19/02
2	REVISED COLUMN SIZES AND LOCATIONS, RELOCATED CORRESPONDING WALLS AND WINDOWS	04/16/03

[Signature]
04/17/03


DATE: 09/18/02
PROJECT NO. 02008
SHEET NO.

FIRST FLOOR PLAN
SHOWROOM/OFFICE SCALE: 1/4" = 1'-0"

A2.1

MATCH LINE

SEE SHEET A2.2 FOR SERVICE DEPT. PLAN
CROSS HATCHED AREA INDICATES
2 HR. FIRE RATED PLANE
REL. DETAIL 02/A4.0

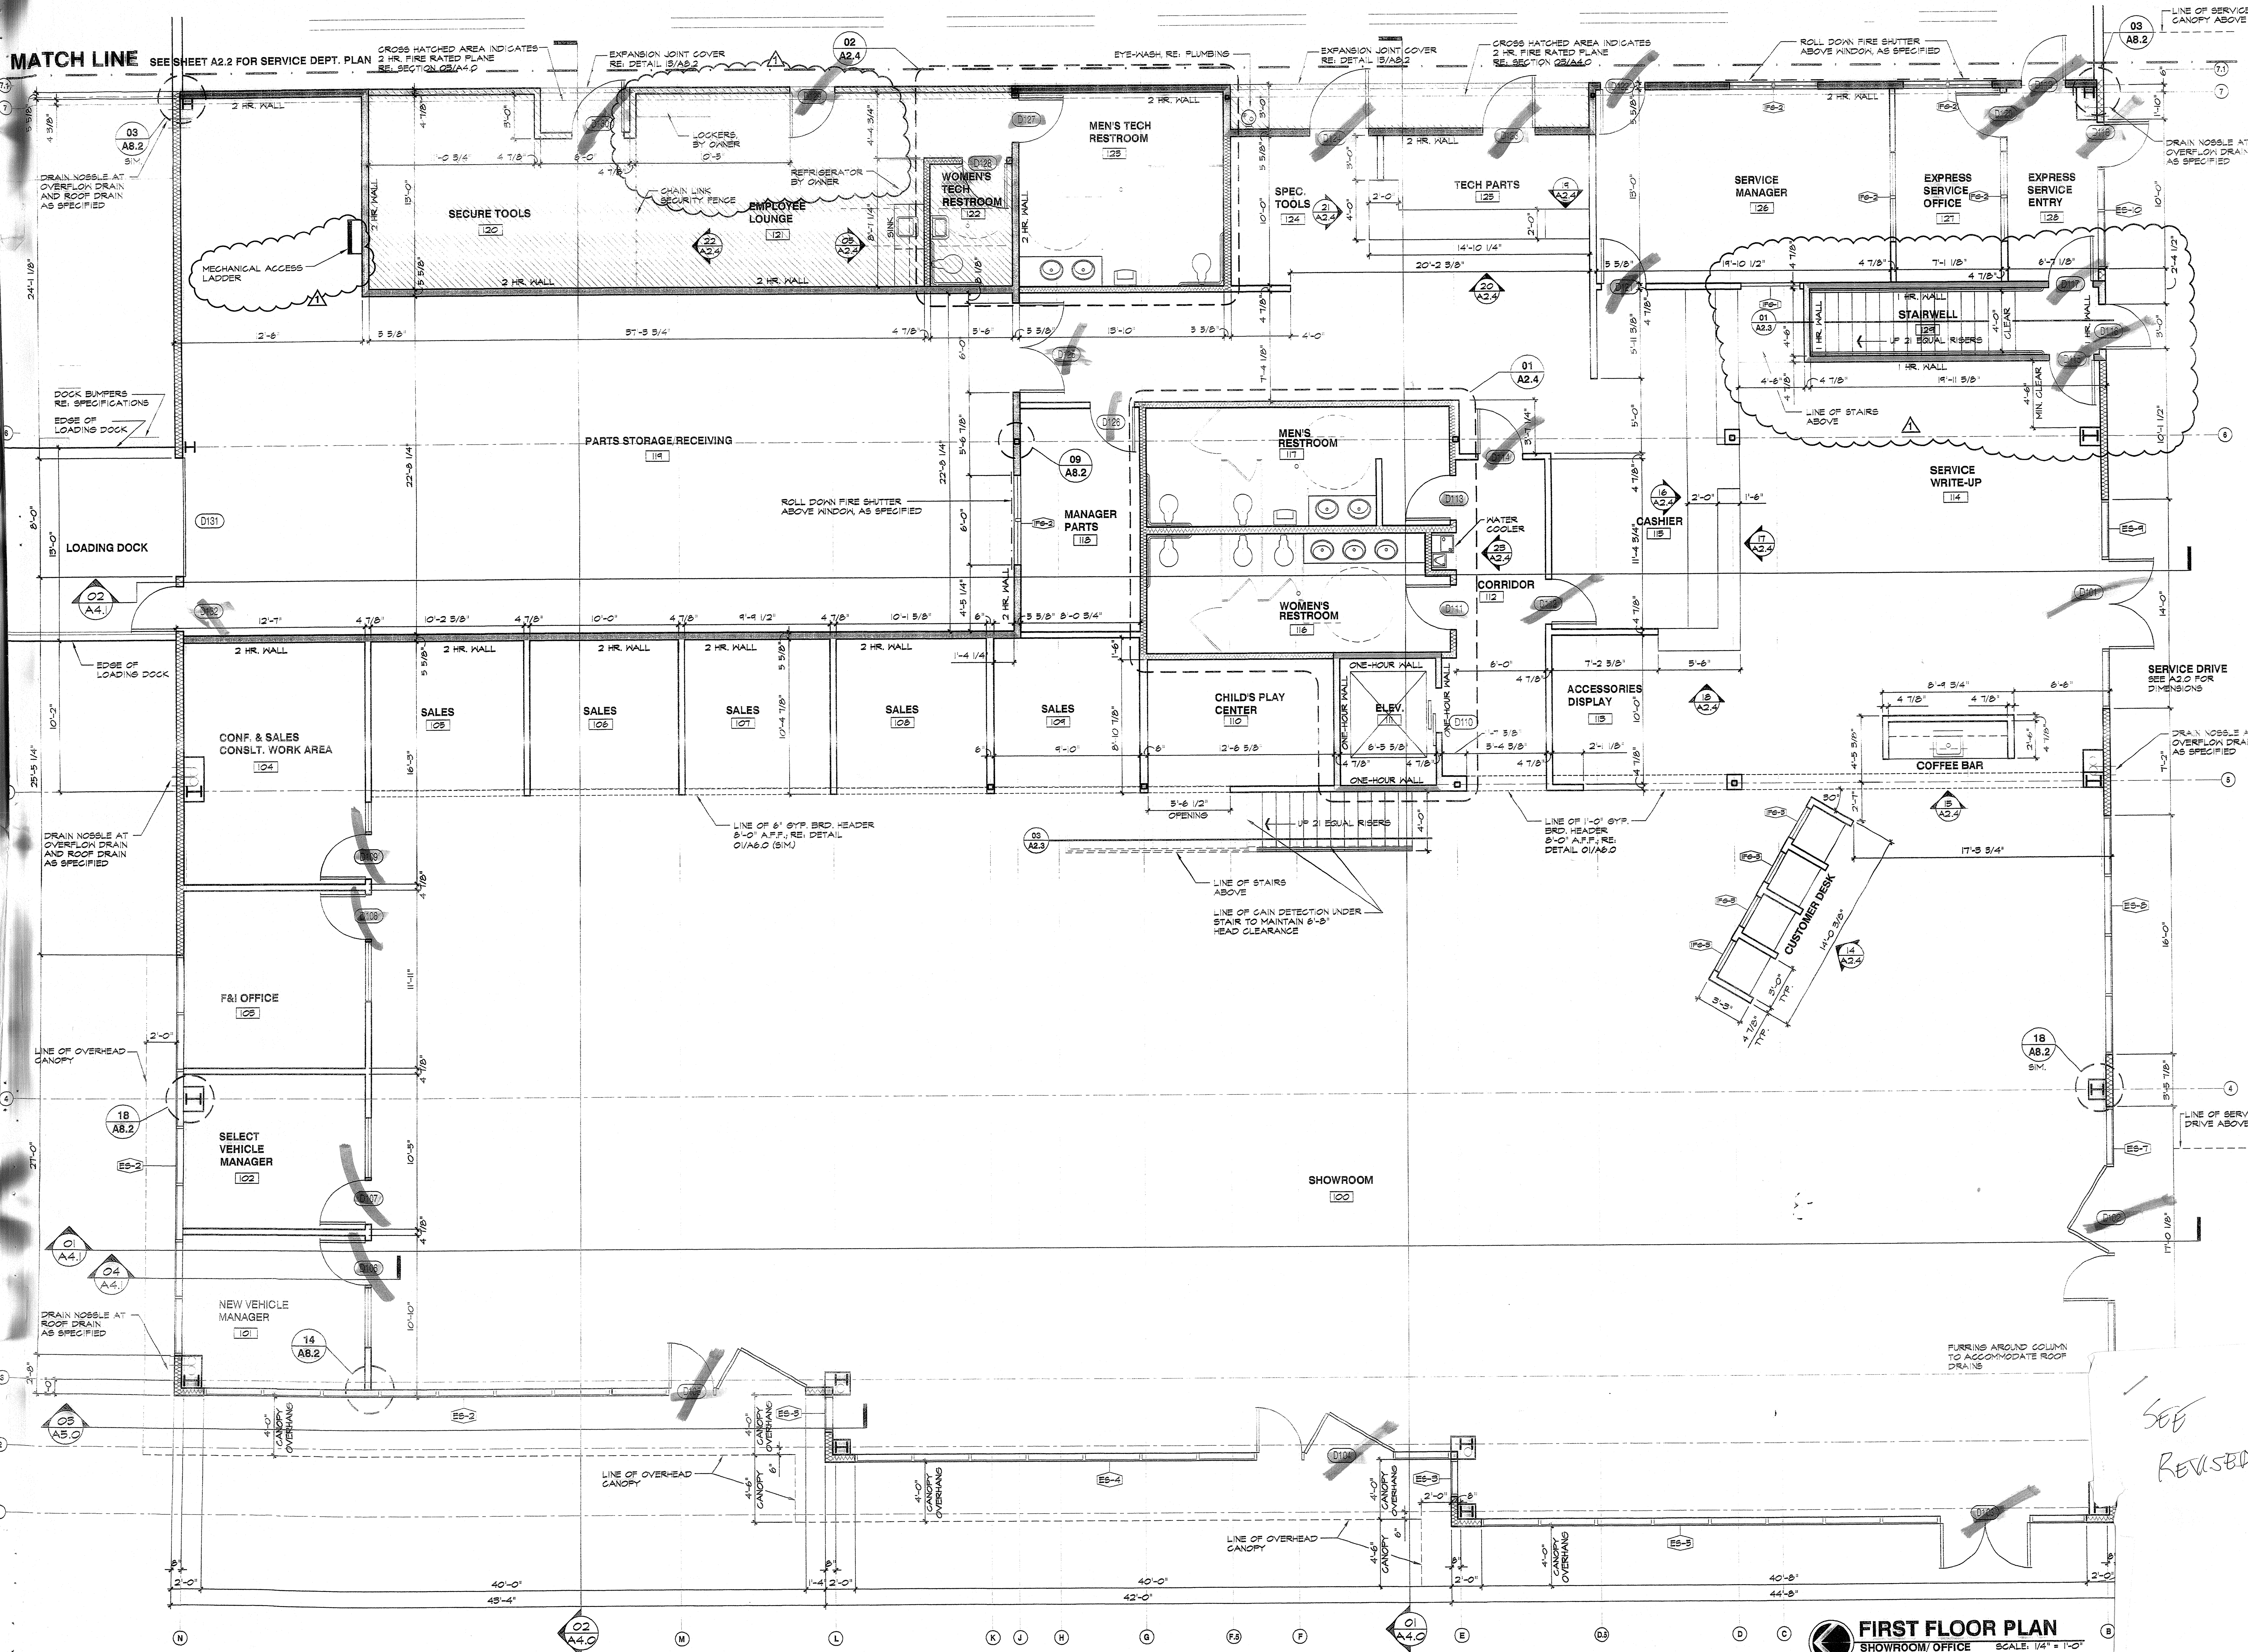

AN AUTOMOTIVE DEALERSHIP
ROGER BEASLEY VOLVO

INTERSTATE HIGHWAY 35 SOUTH
GEORGETOWN, TEXAS

ELASER ARCHITECTURAL INC.
ARCHITECTURE AND PLANNING
P.O. BOX 883 GEORGETOWN, TX 78627
(512) 864-5553 FAX (512) 152-2818 WWW.ELASER.COM


REV. #	DESCRIPTION	DATE
1	ACQUIRED STAIR WELL TO MEET A.D.A. COMMENTS, RELOCATED DOOR DET.	11/18/02

FIRST FLOOR PLAN
SHOWROOM/OFFICE
SCALE: 1/4" = 1'-0"

SEE
REVISED

MATCH LINE


SEE SHEET A2.2 FOR SERVICE DEPT. PLAN
2 HR. FIRE RATED PLANE
RE. DETAIL 02/A4.0

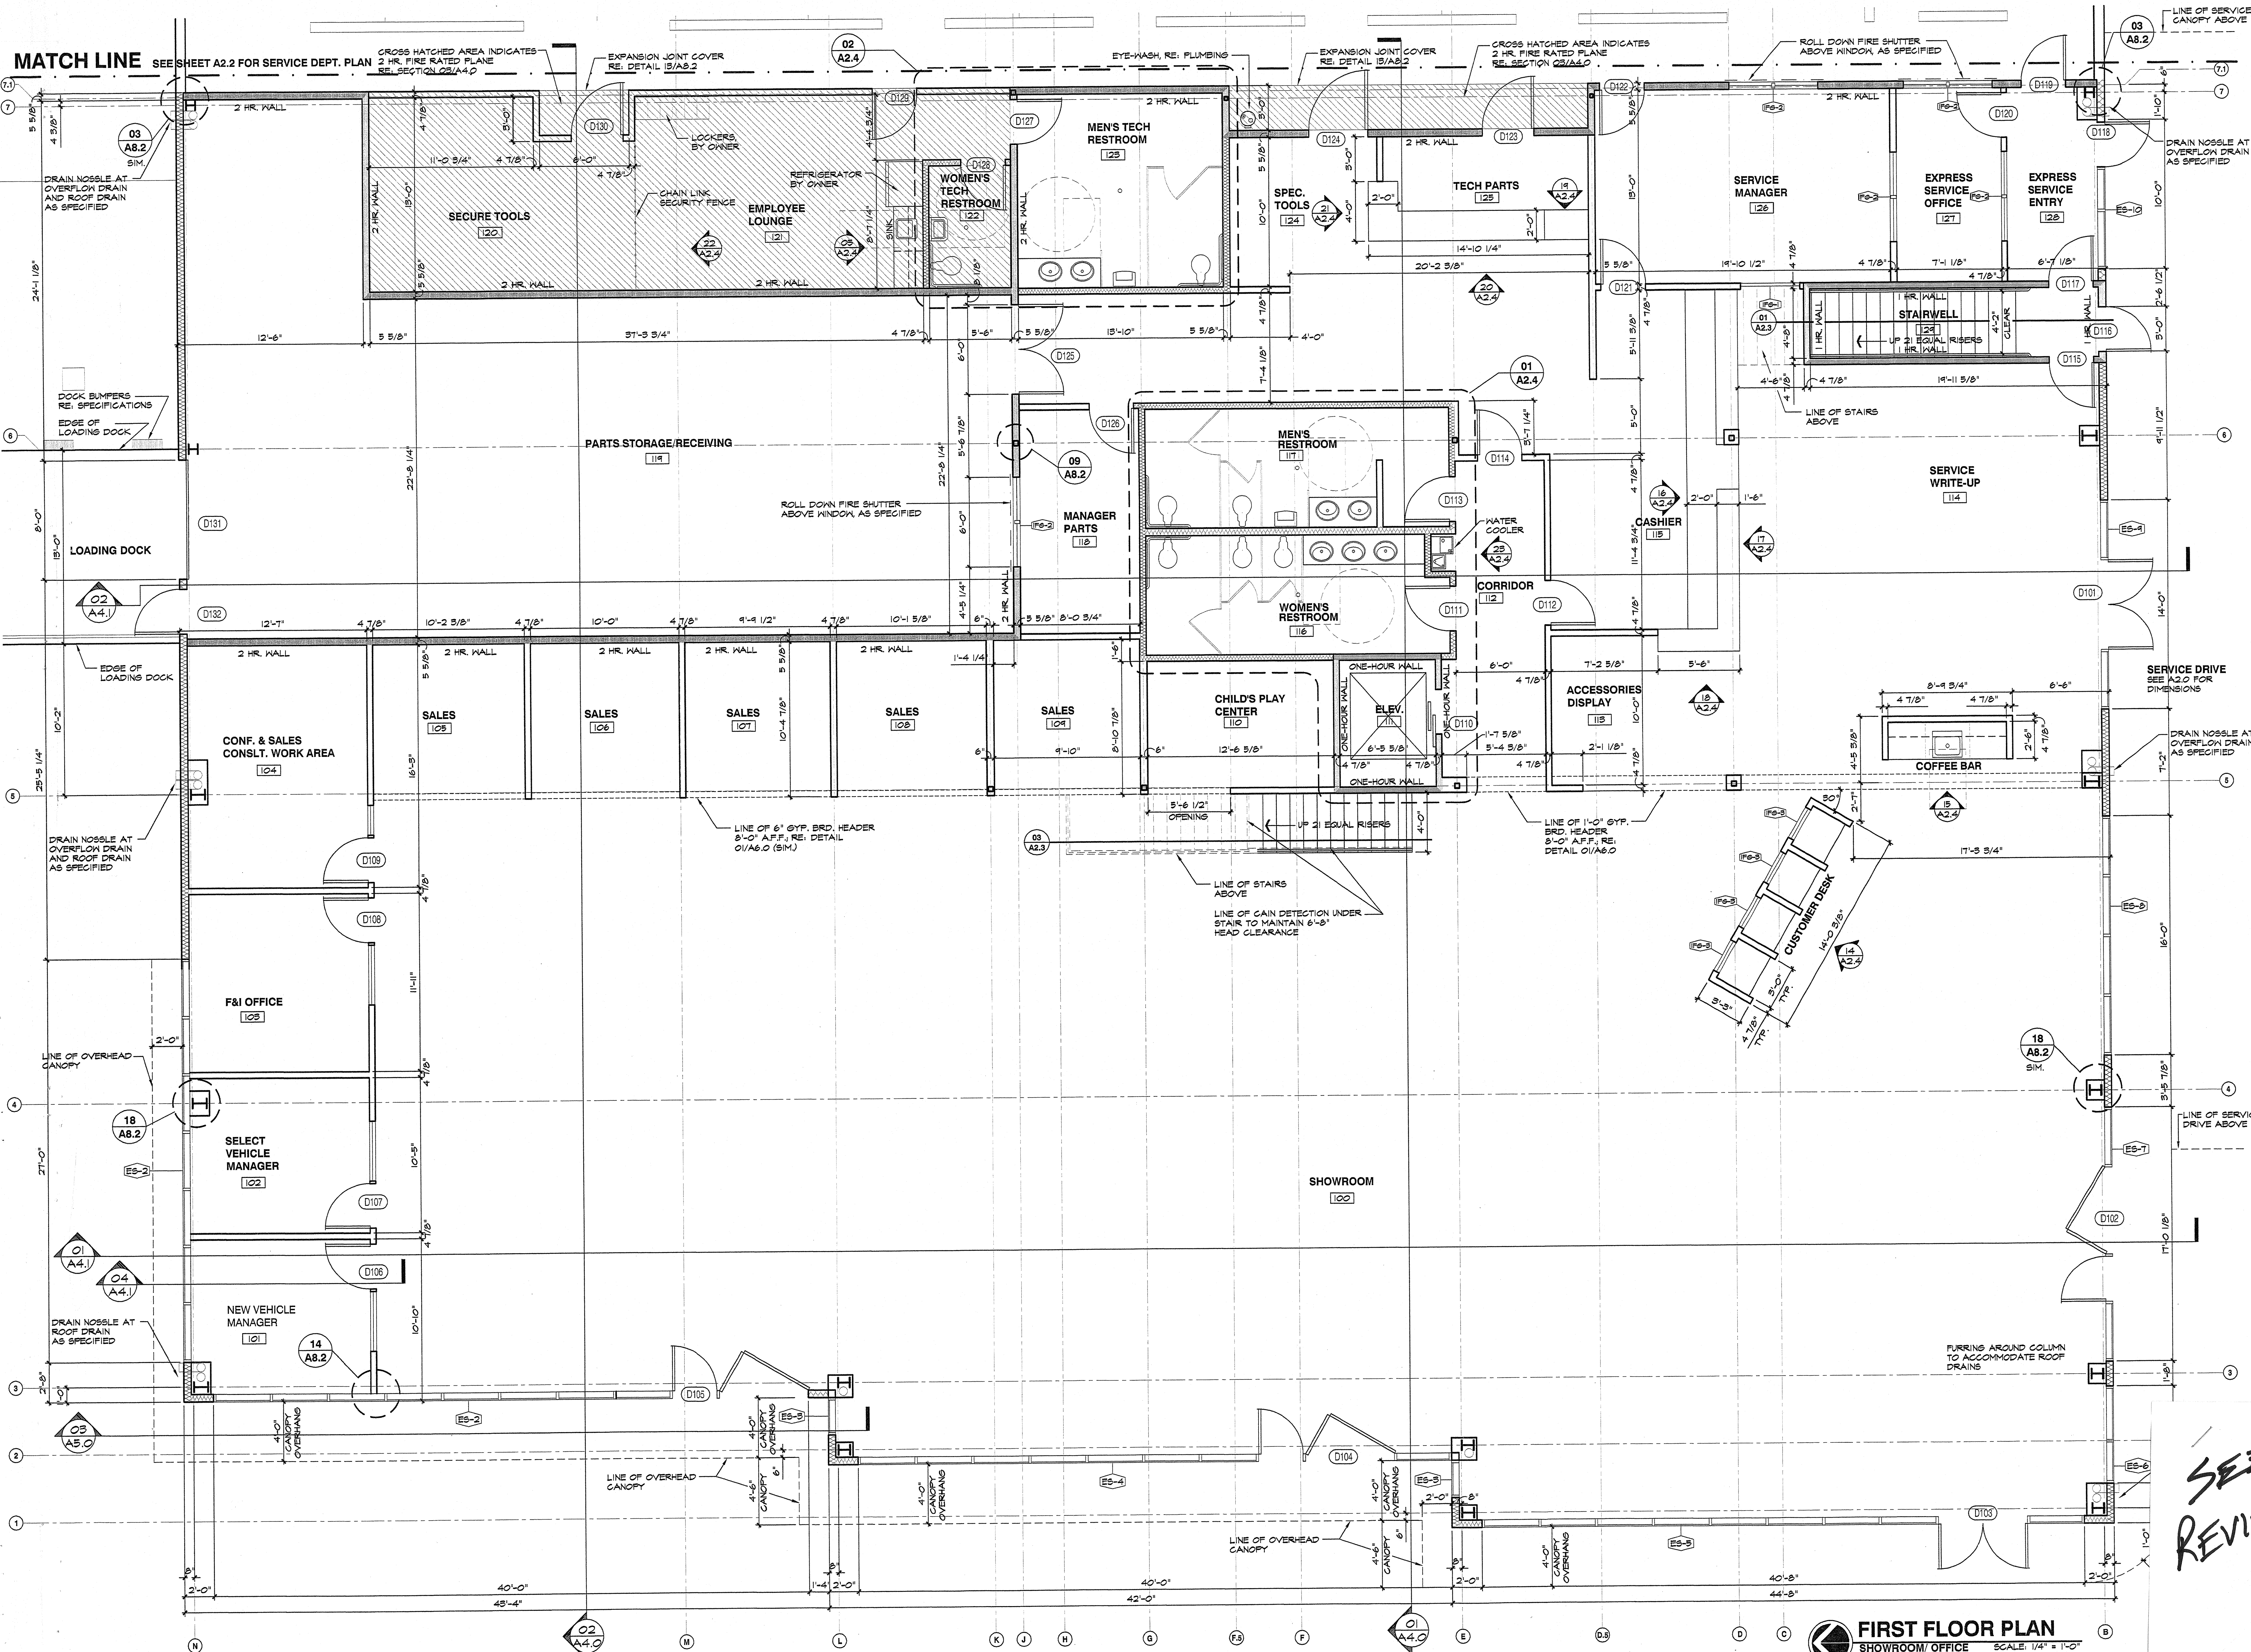

AN AUTOMOTIVE DEALERSHIP
ROGER BEASLEY VOLVO
INTERSTATE HIGHWAY 35 SOUTH
GEORGETOWN, TEXAS


EL SASSER ARCHITECTURAL INC.
ARCHITECTURE AND PLANNING
P.O. BOX 833 GEORGETOWN, TX 78627
610 530-5353 FAX (512) 580-2618 www.eah.com

CONSULTANT INFORMATION:

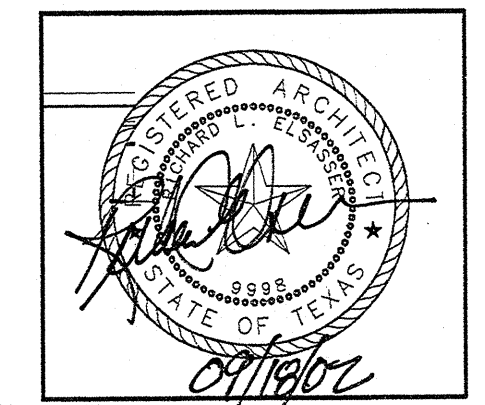

SEE
REVISED

FIRST FLOOR PLAN
SHOWROOM/OFFICE SCALE: 1/4" = 1'-0"

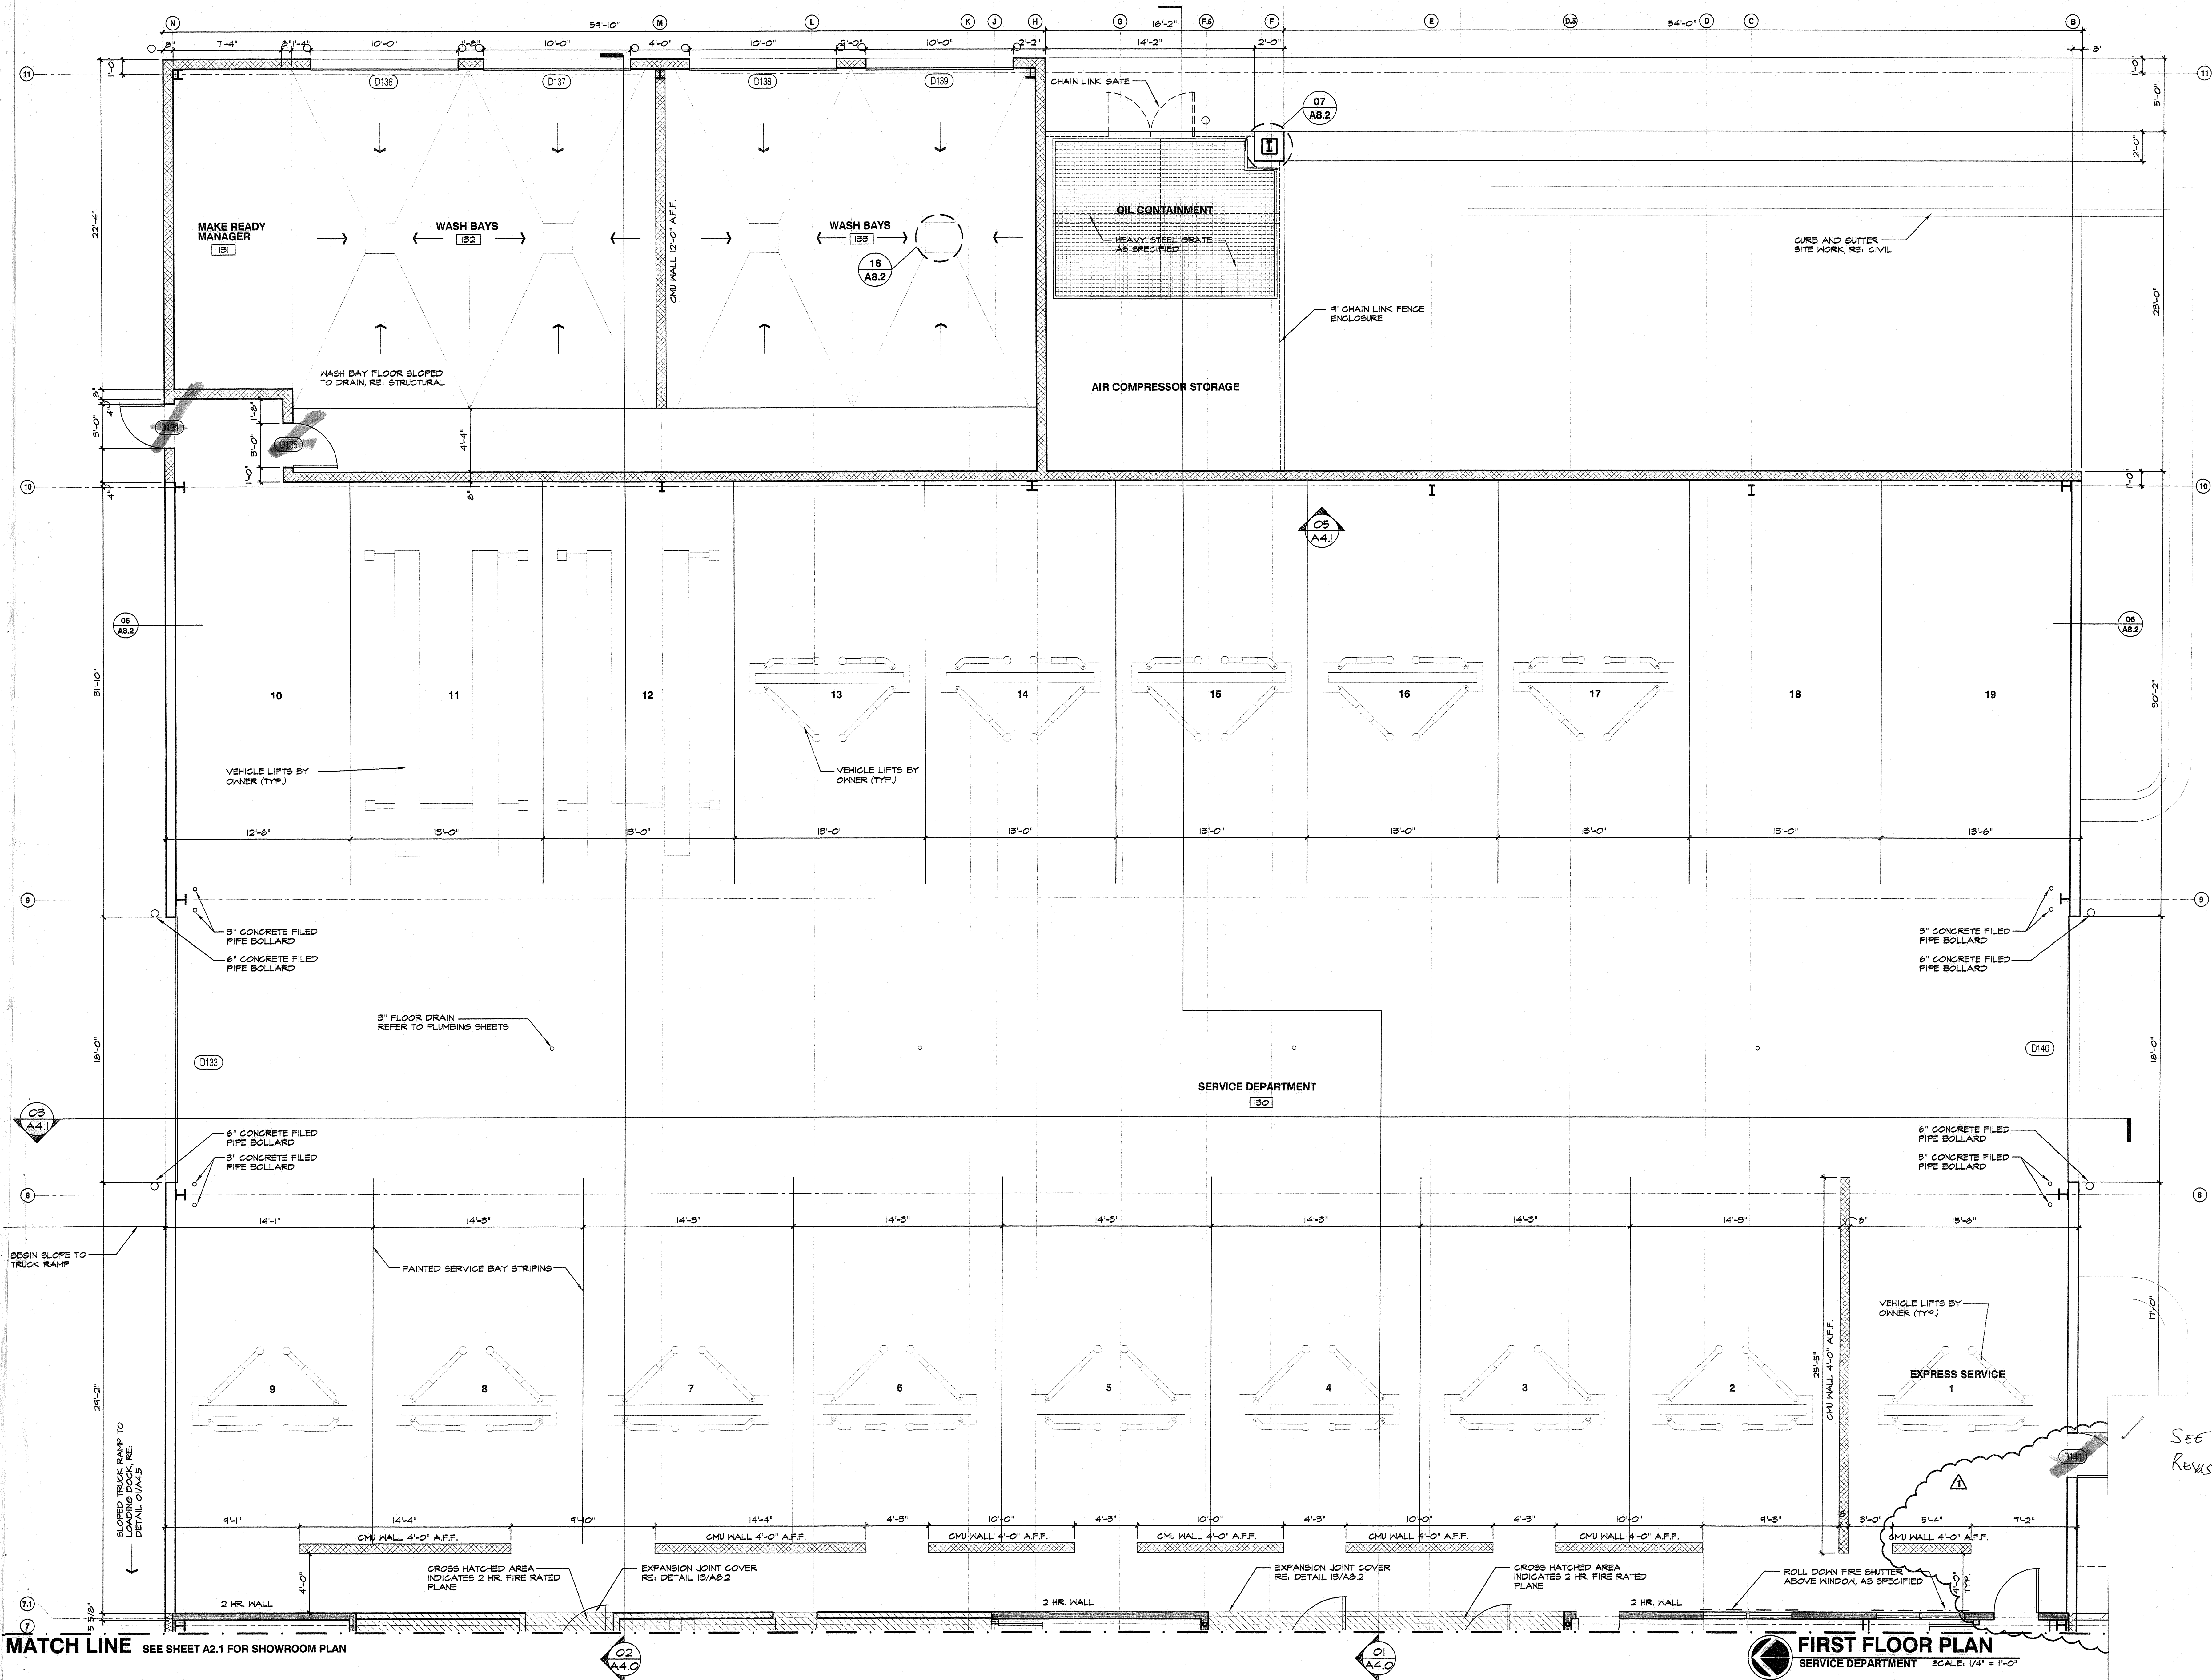

AN AUTOMOTIVE DEALERSHIP
ROGER BEASLEY VOLVO

INTERSTATE HIGHWAY 35 SOUTH
 GEORGETOWN, TEXAS


**ELSASSER
 ARCHITECTURAL
 INC.**
 ARCHITECTURE AND PLANNING
 P.O. BOX 833 GEORGETOWN, TX 78627
 (512) 980-5553 FAX (512) 980-2818 www.eah-tx.com

REV. #	DESCRIPTION	DATE
1	SHORTENED CMU WALL, RELOCATED DOOR D141	11/19/02



SEE
 REVISED


FIRST FLOOR PLAN
 SERVICE DEPARTMENT SCALE: 1/4" = 1'-0"

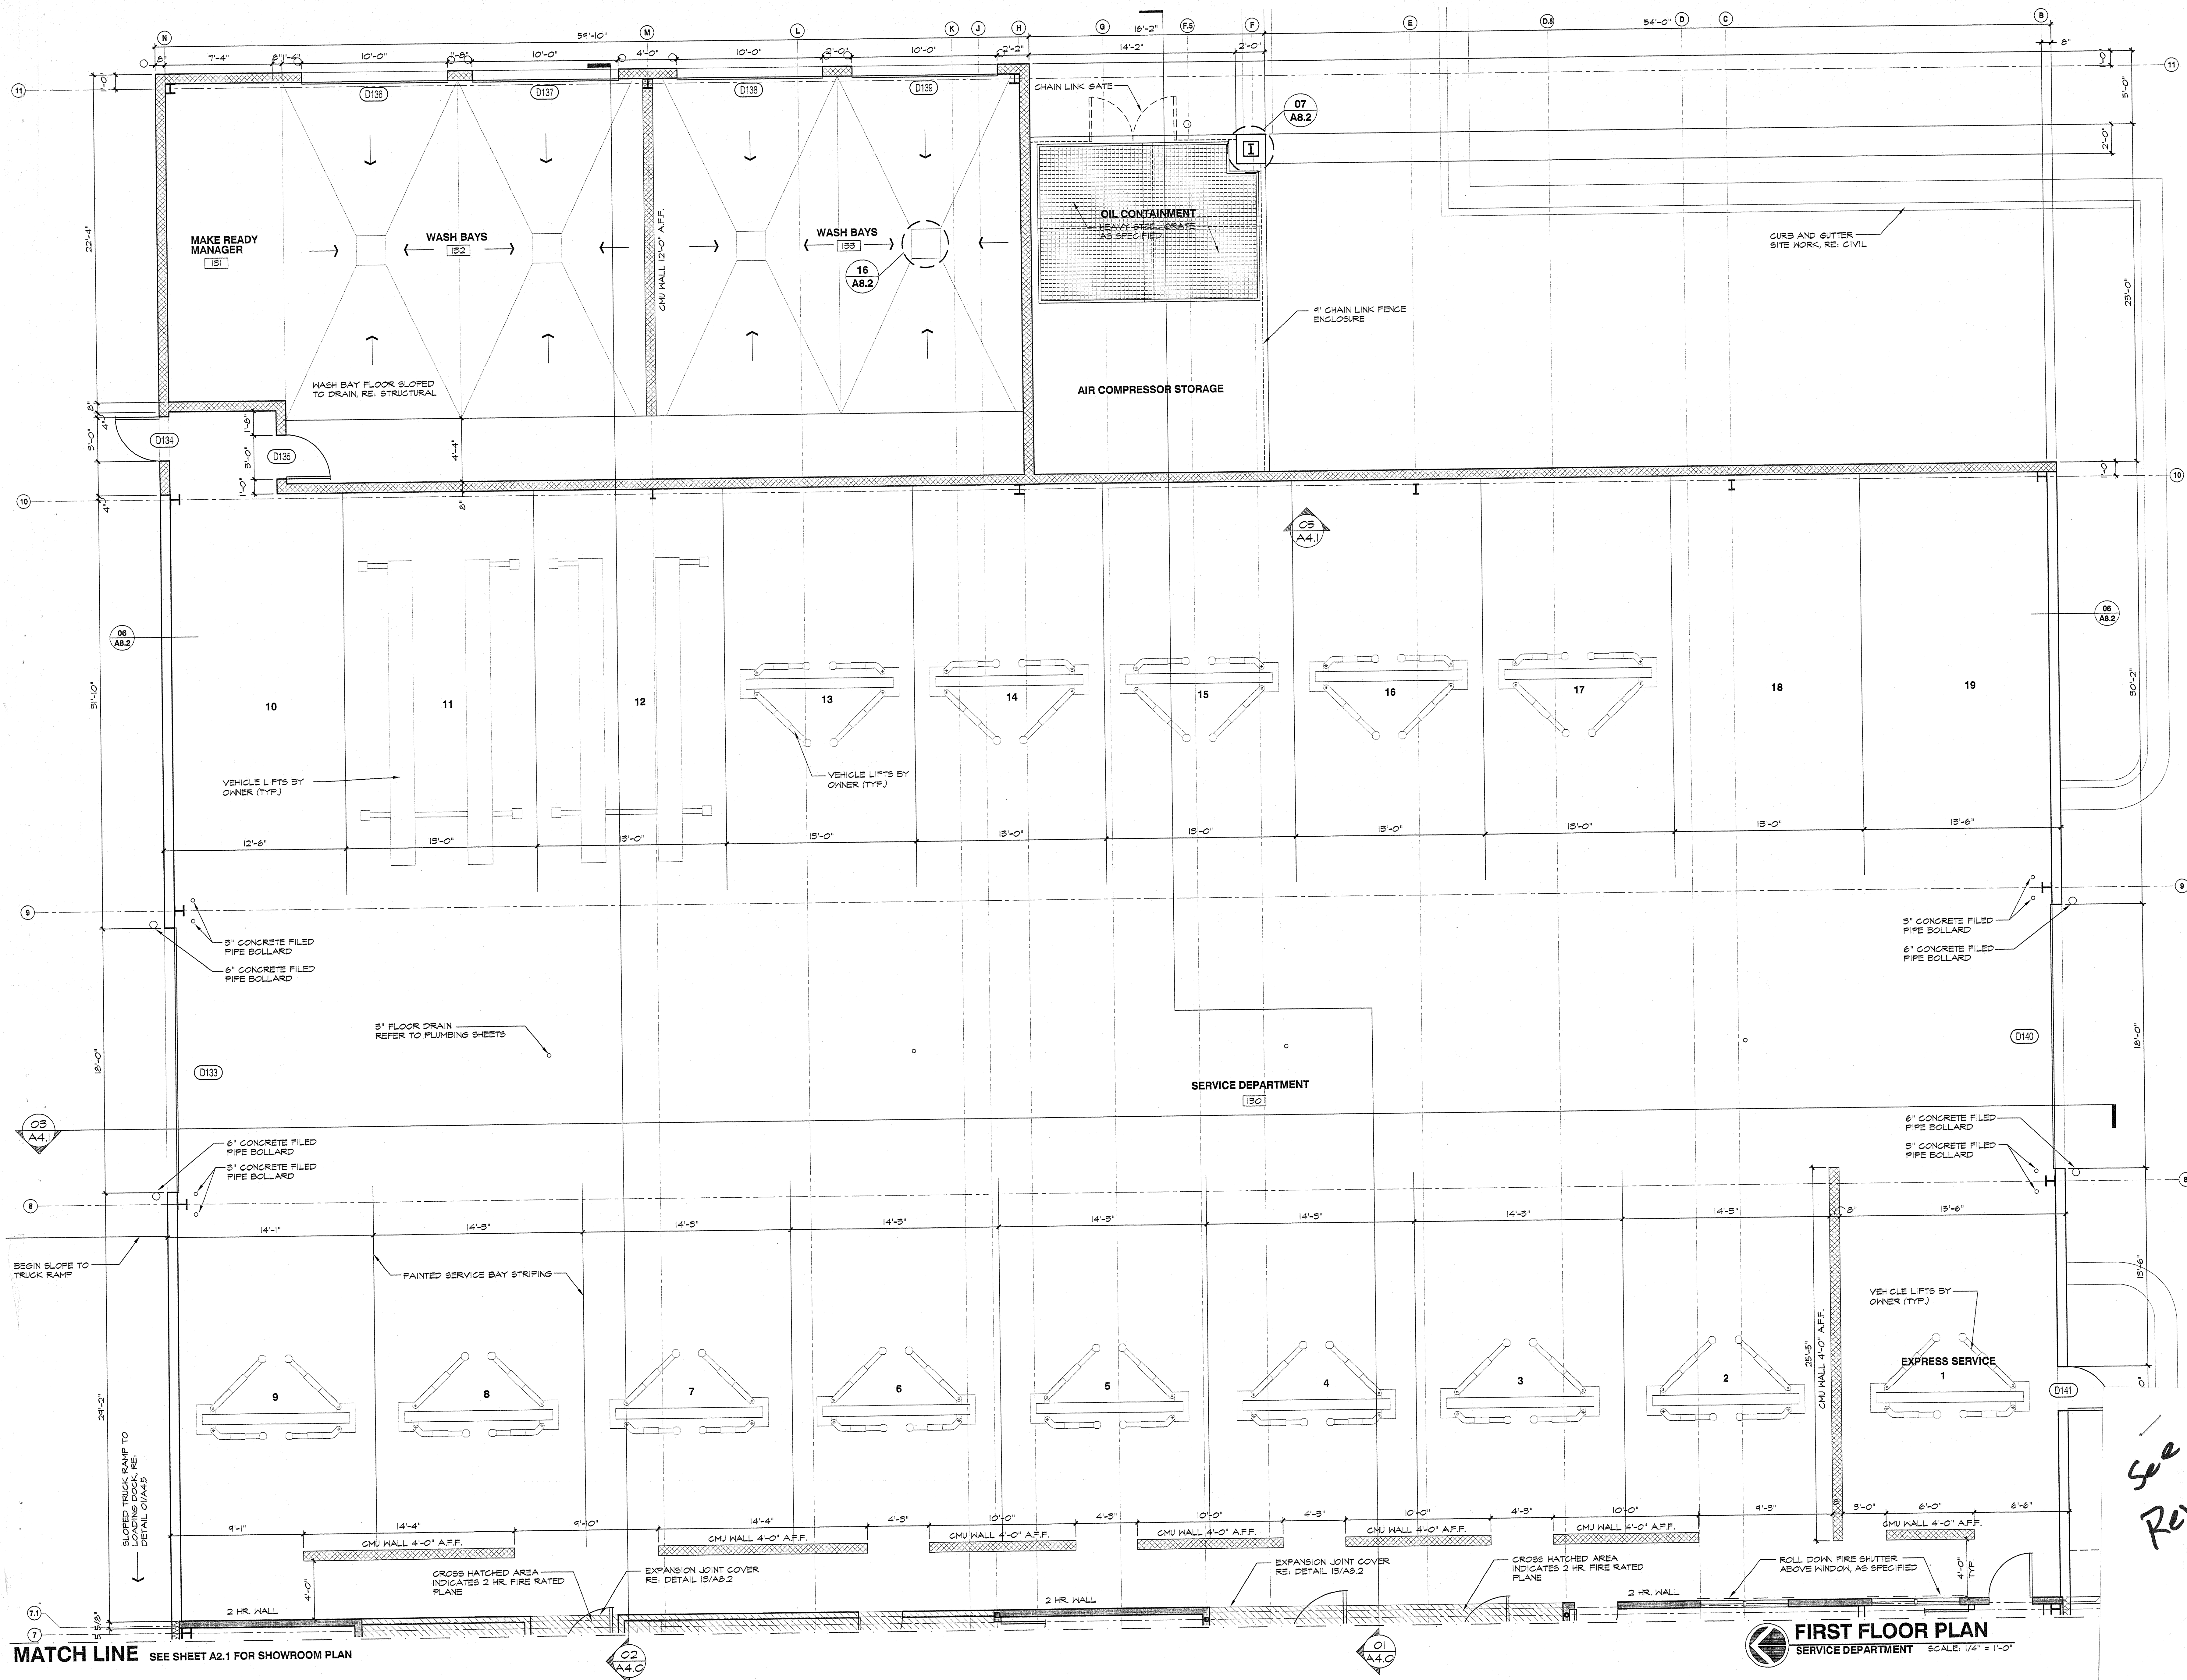

AN AUTOMOTIVE DEALERSHIP
ROGER BEASLEY VOLVO
 INTERSTATE HIGHWAY 35 SOUTH
 GEORGETOWN, TEXAS




ELIASER ARCHITECTURAL INC.
 ARCHITECTURE AND PLANNING
 P.O. BOX 933 GEORGETOWN, TX 78627
 (512) 860-5553 FAX (512) 860-5818 www.eai-h.com

CONSULTANT
 INFORMATION:

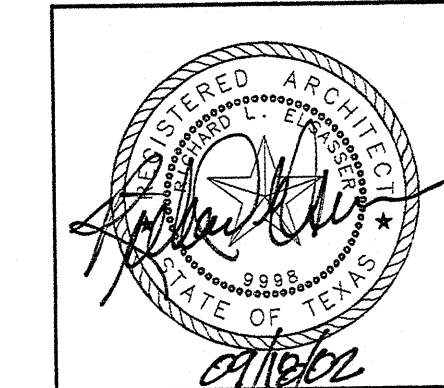

See Revised

FIRST FLOOR PLAN
 SERVICE DEPARTMENT SCALE: 1/4" = 1'-0"

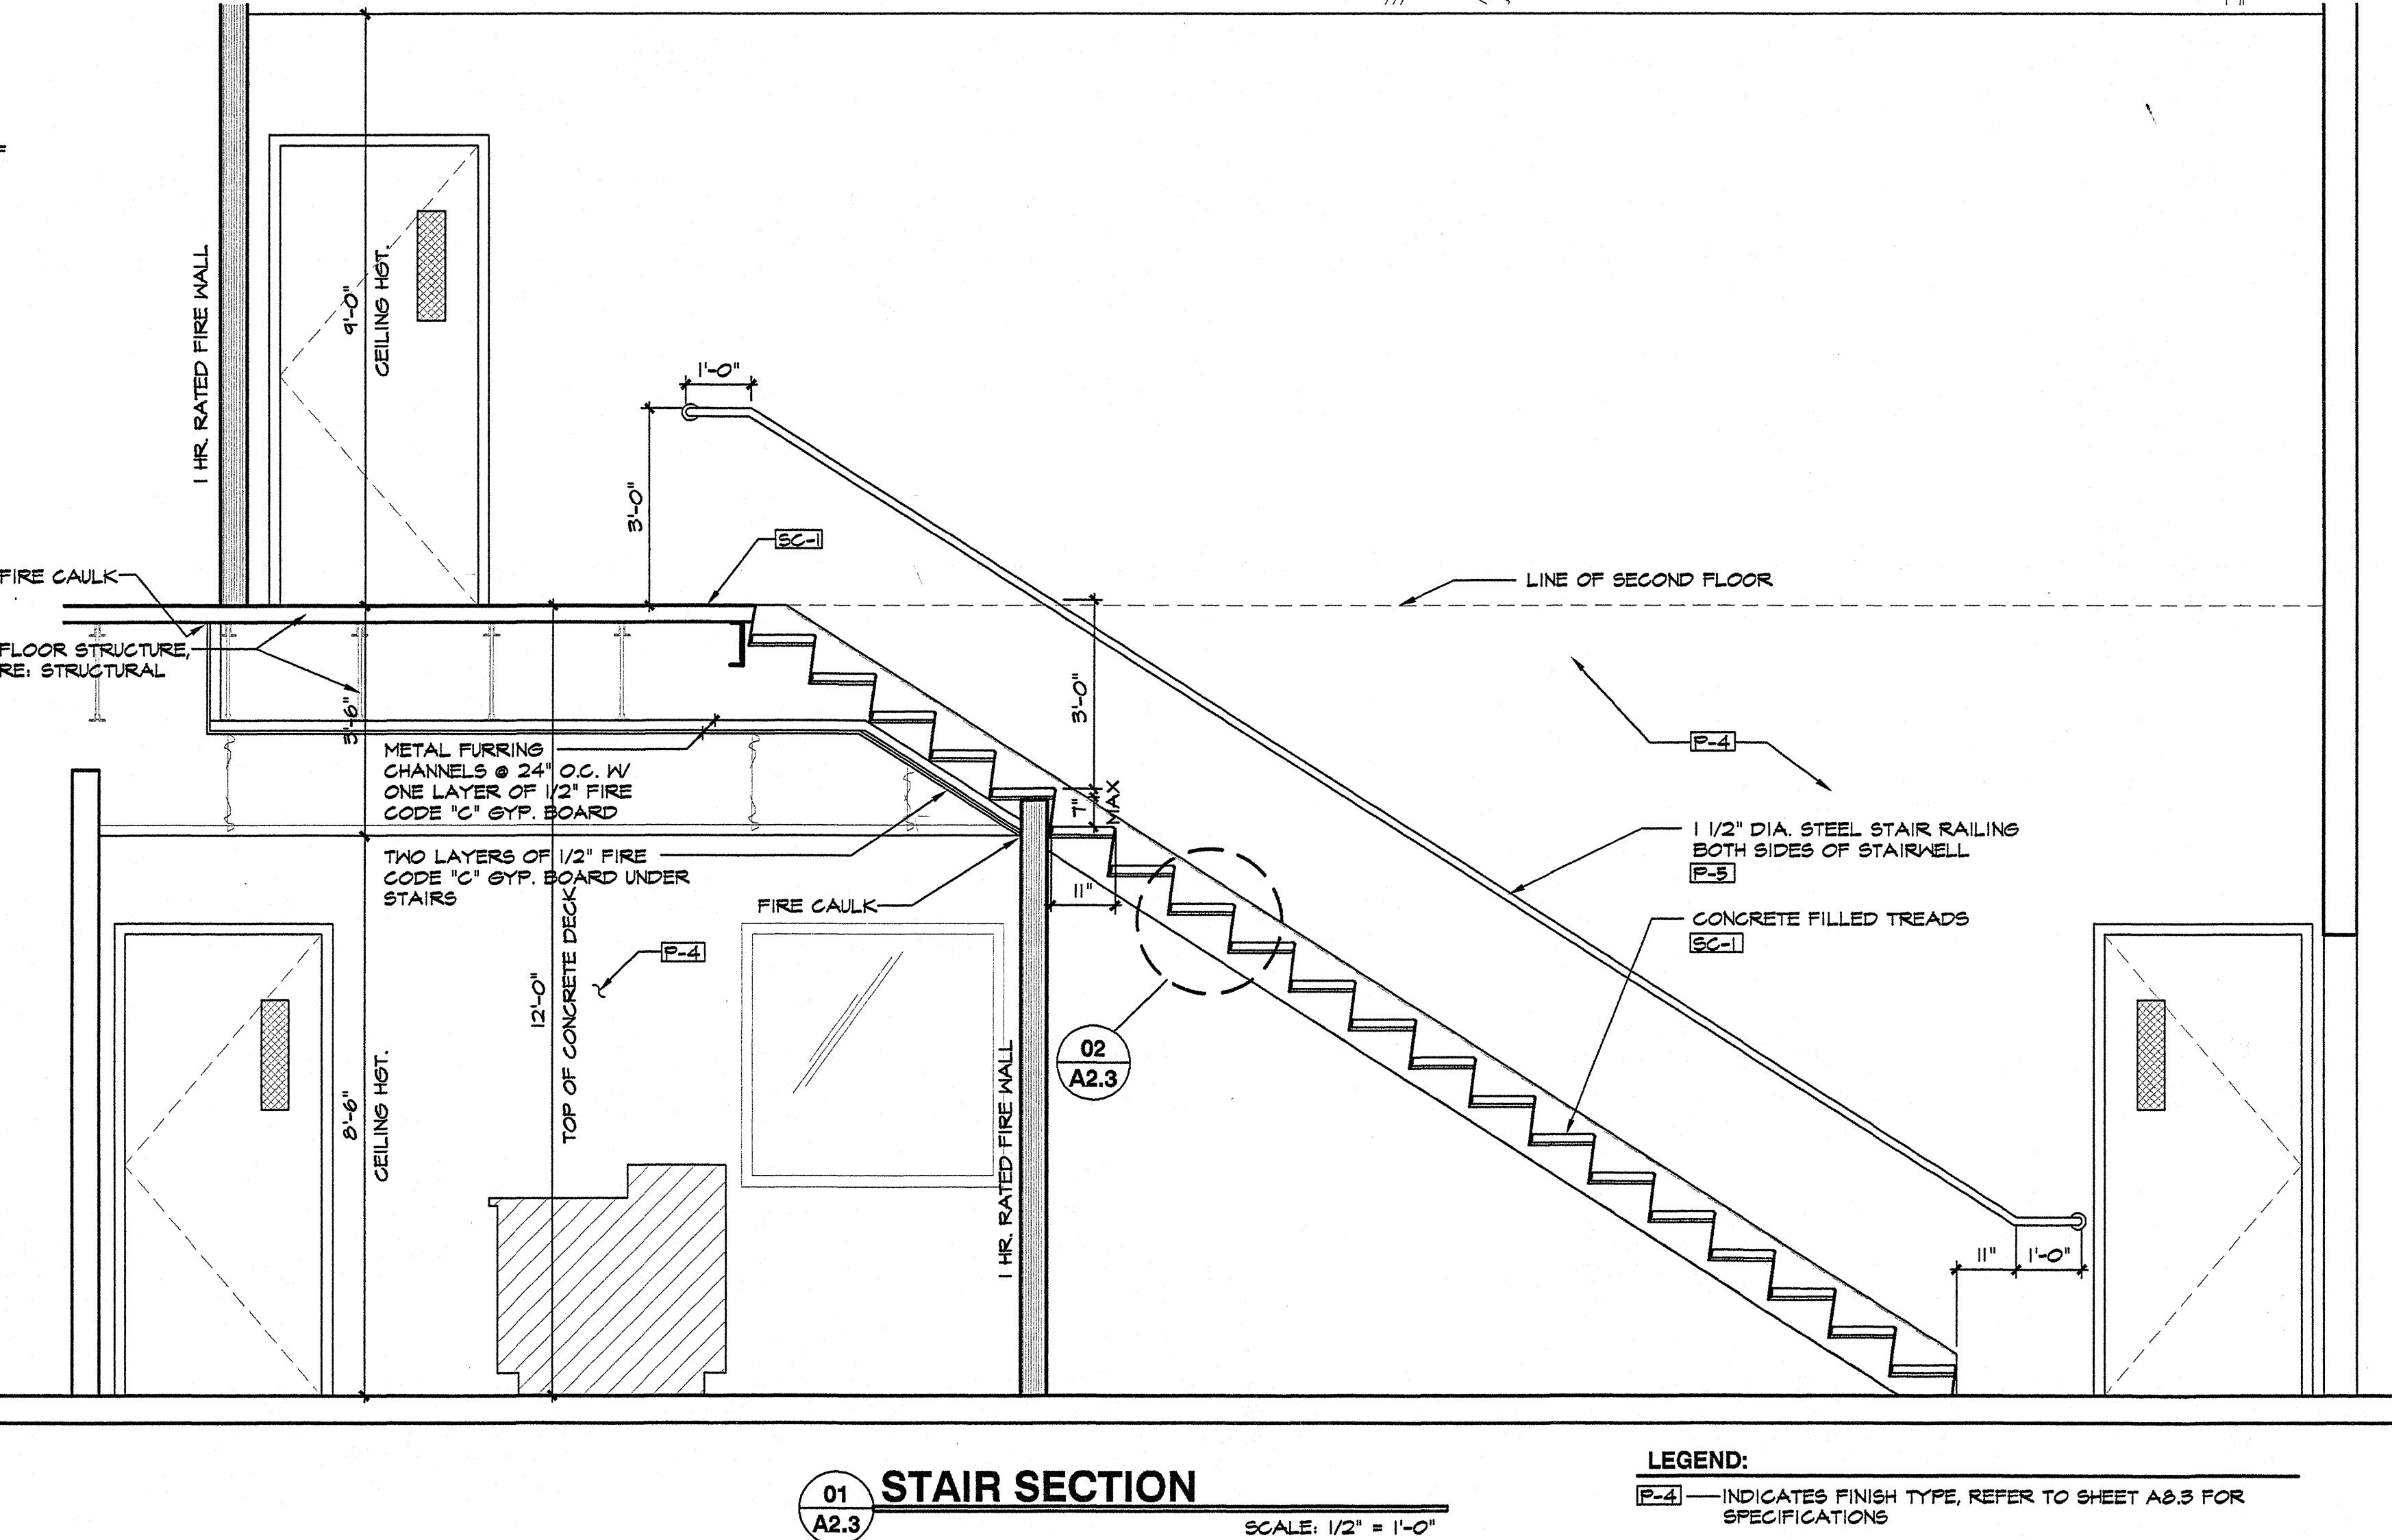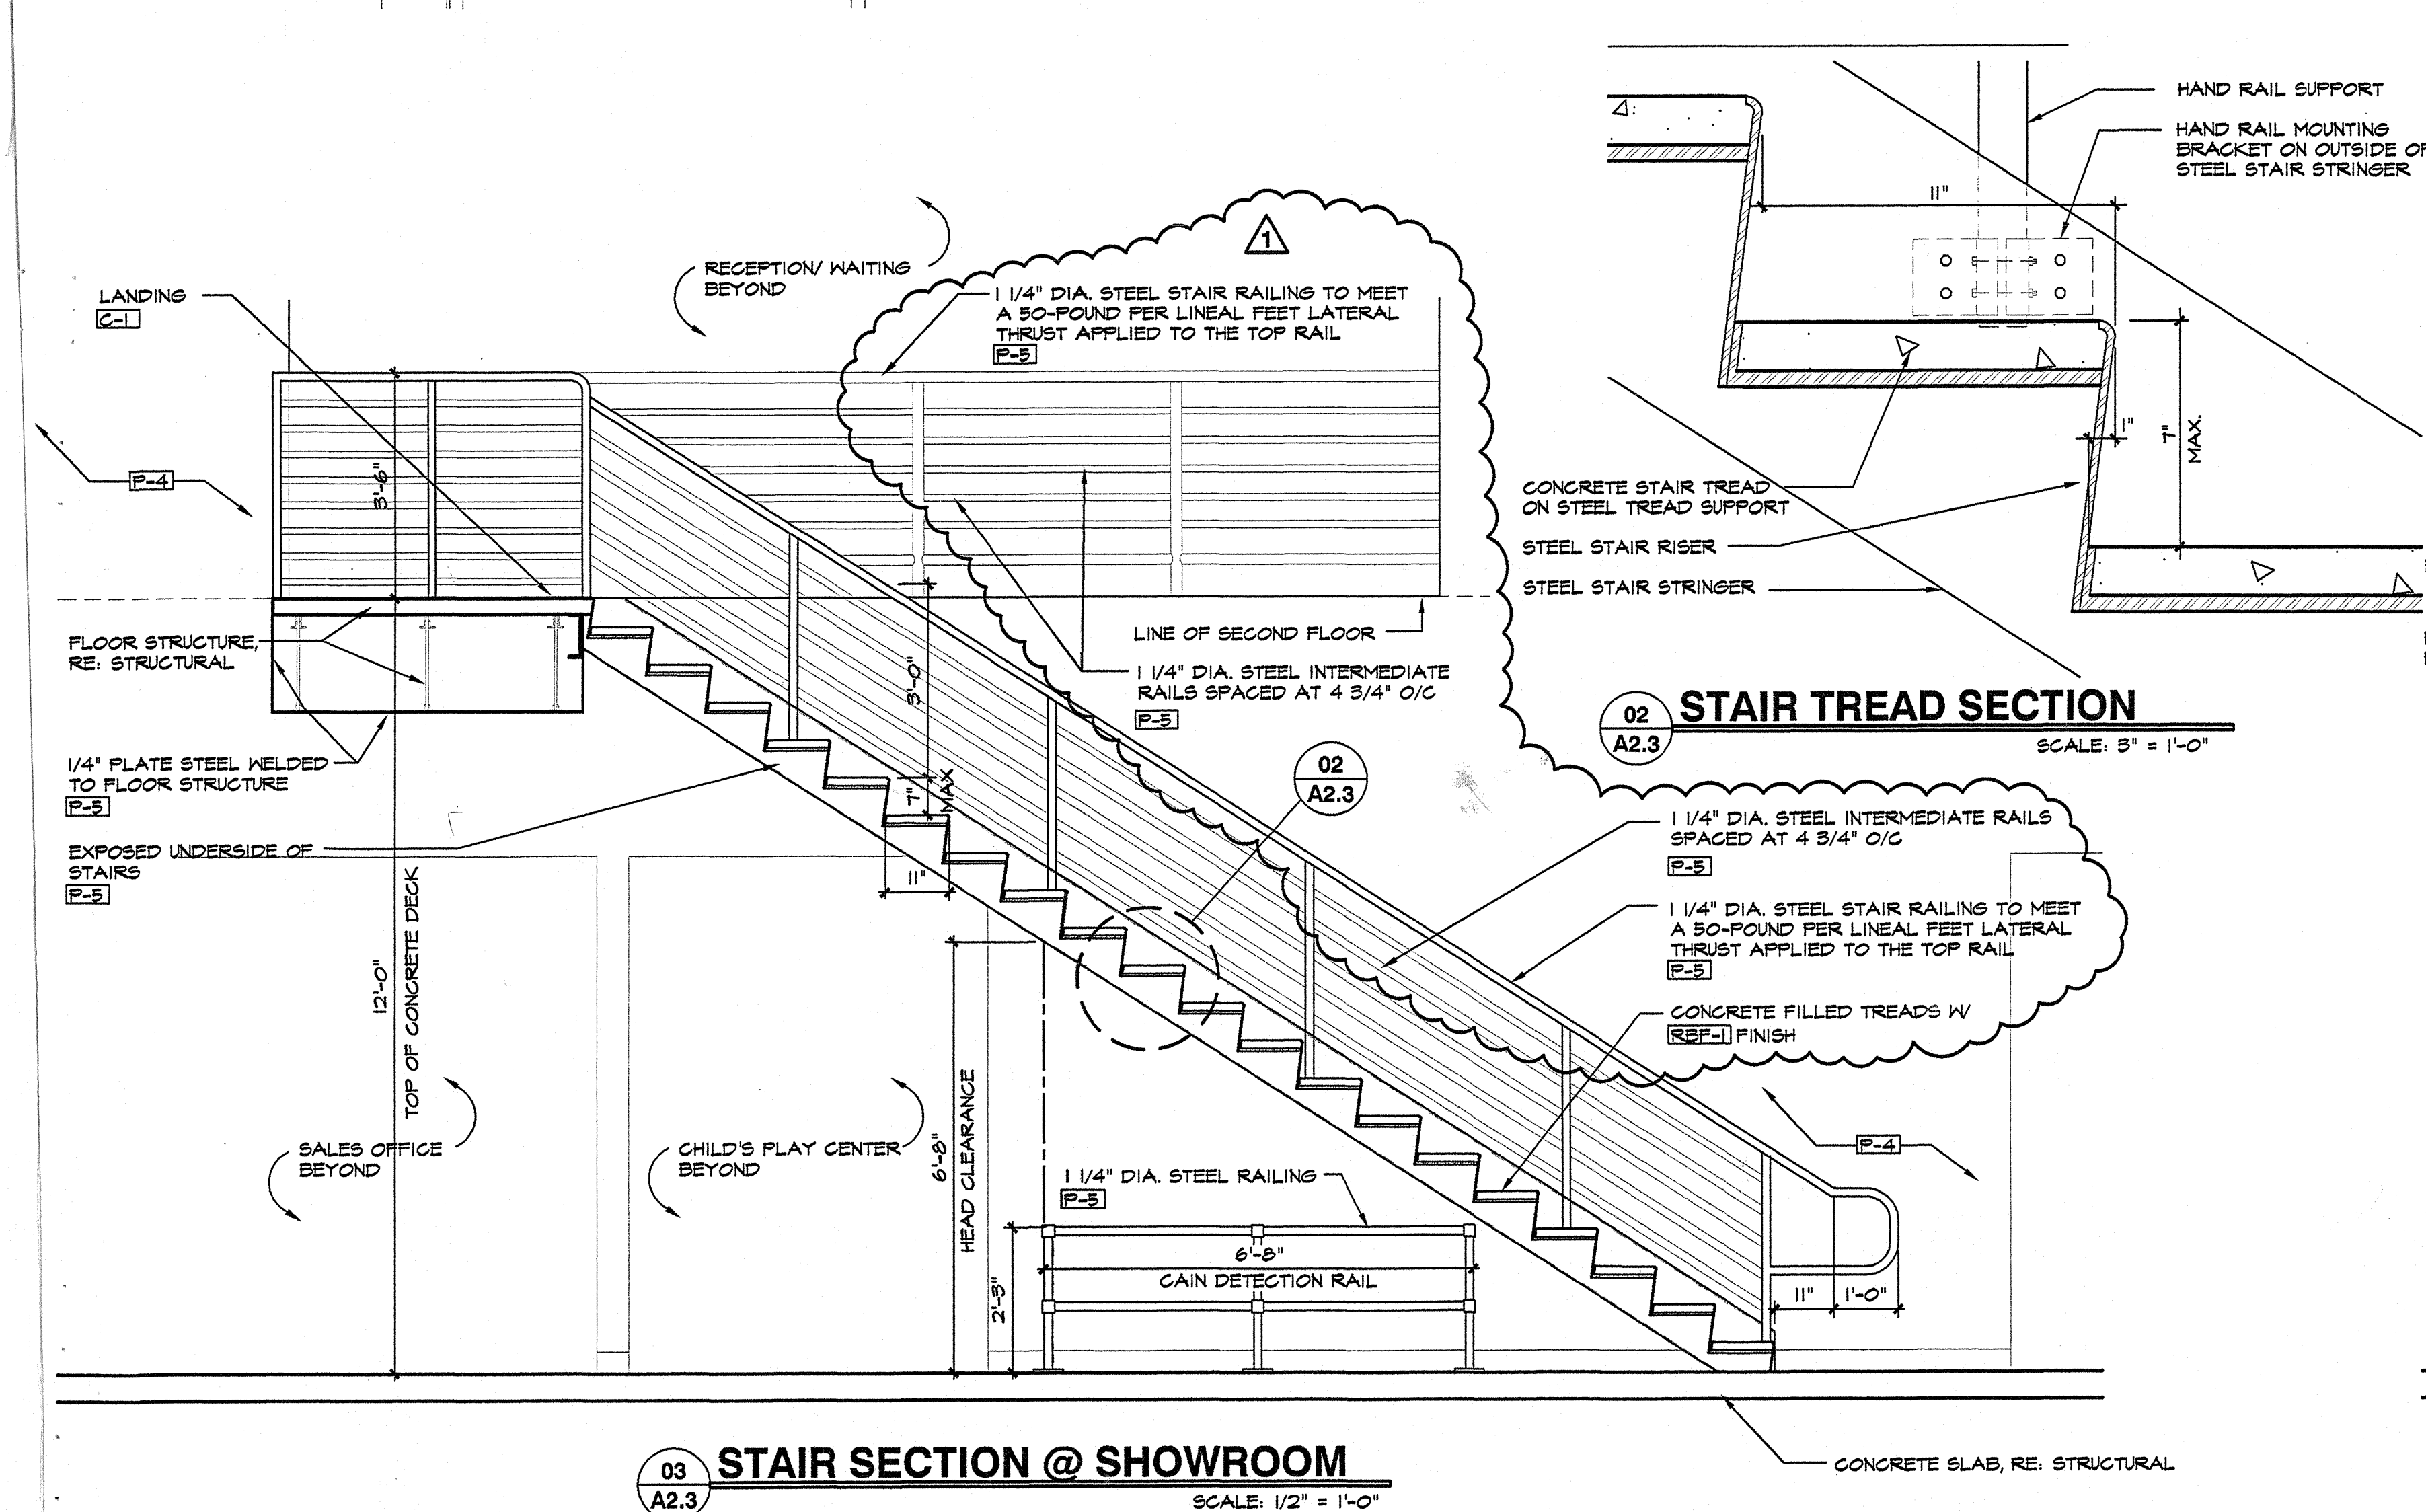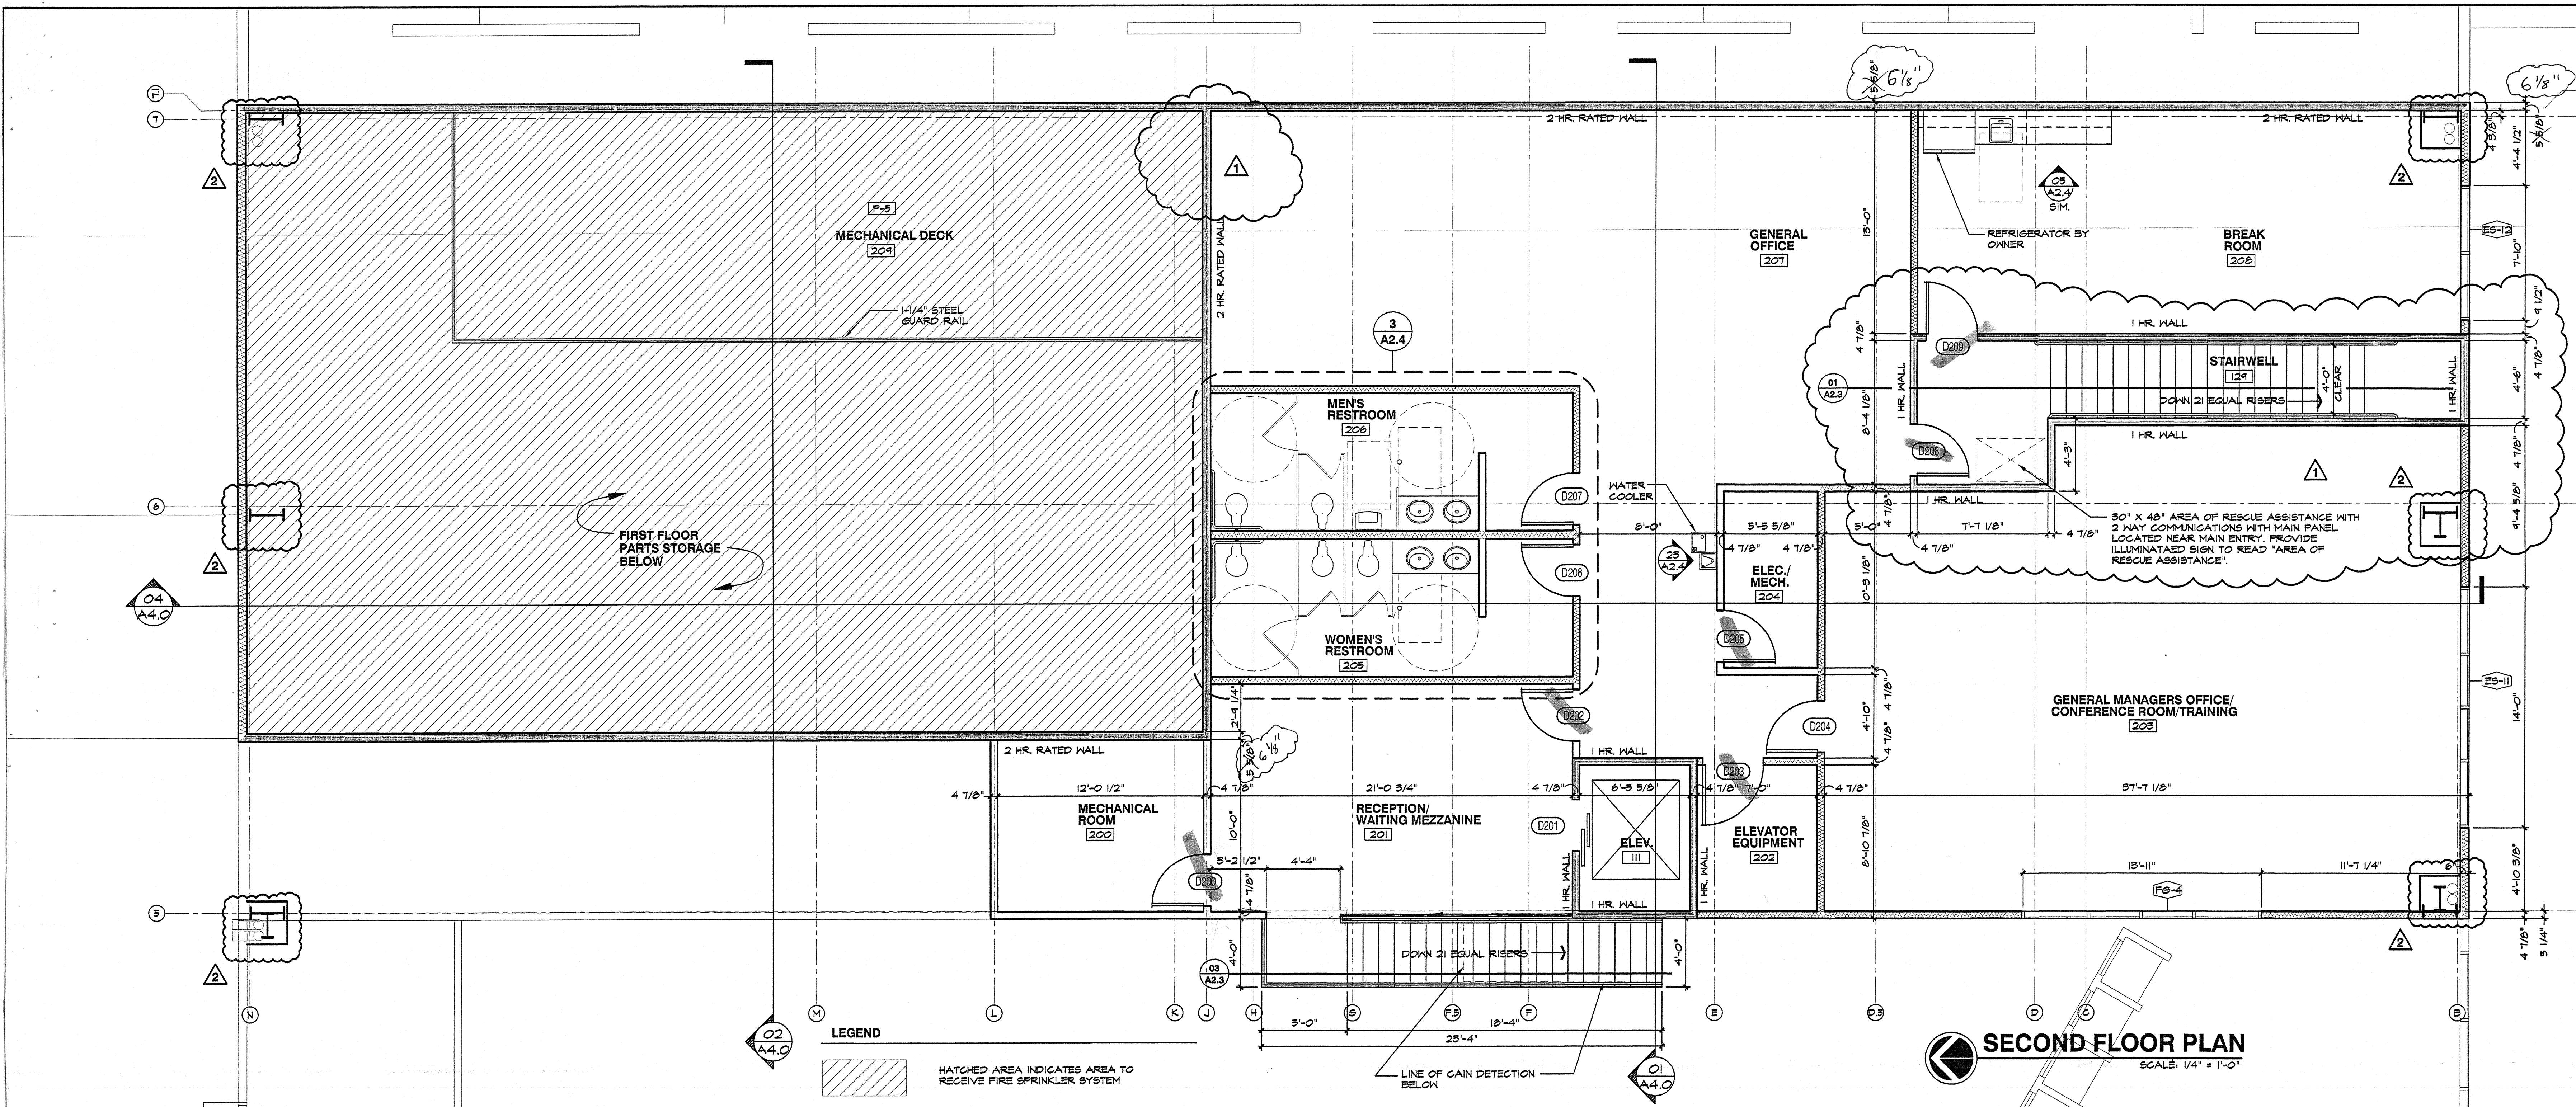

AN AUTOMOTIVE DEALERSHIP
ROGER BEASLEY VOLVO
INTERSTATE HIGHWAY 35 SOUTH
GEORGETOWN, TEXAS




EL SASSER ARCHITECTURAL INC.
ARCHITECTURE AND PLANNING
P.O. BOX 833 GEORGETOWN, TX 78627
(512) 590-5553 FAX (512) 590-5818 www.esa-h.com

REV. #	DESCRIPTION	DATE
1	ACQUIRED STAIRS FROM 10' TO 12' DEEPER AND 10' TO 12' WIDER	11/19/02
2	REVISED COLUMN SIZES AND LOCATIONS. RELOCATED CORRESPONDING WALLS AND WINDOWS	04/16/03

04/17/03

DATE: 09/18/02
PROJECT NO. 02008
SHEET NO.

A2.3

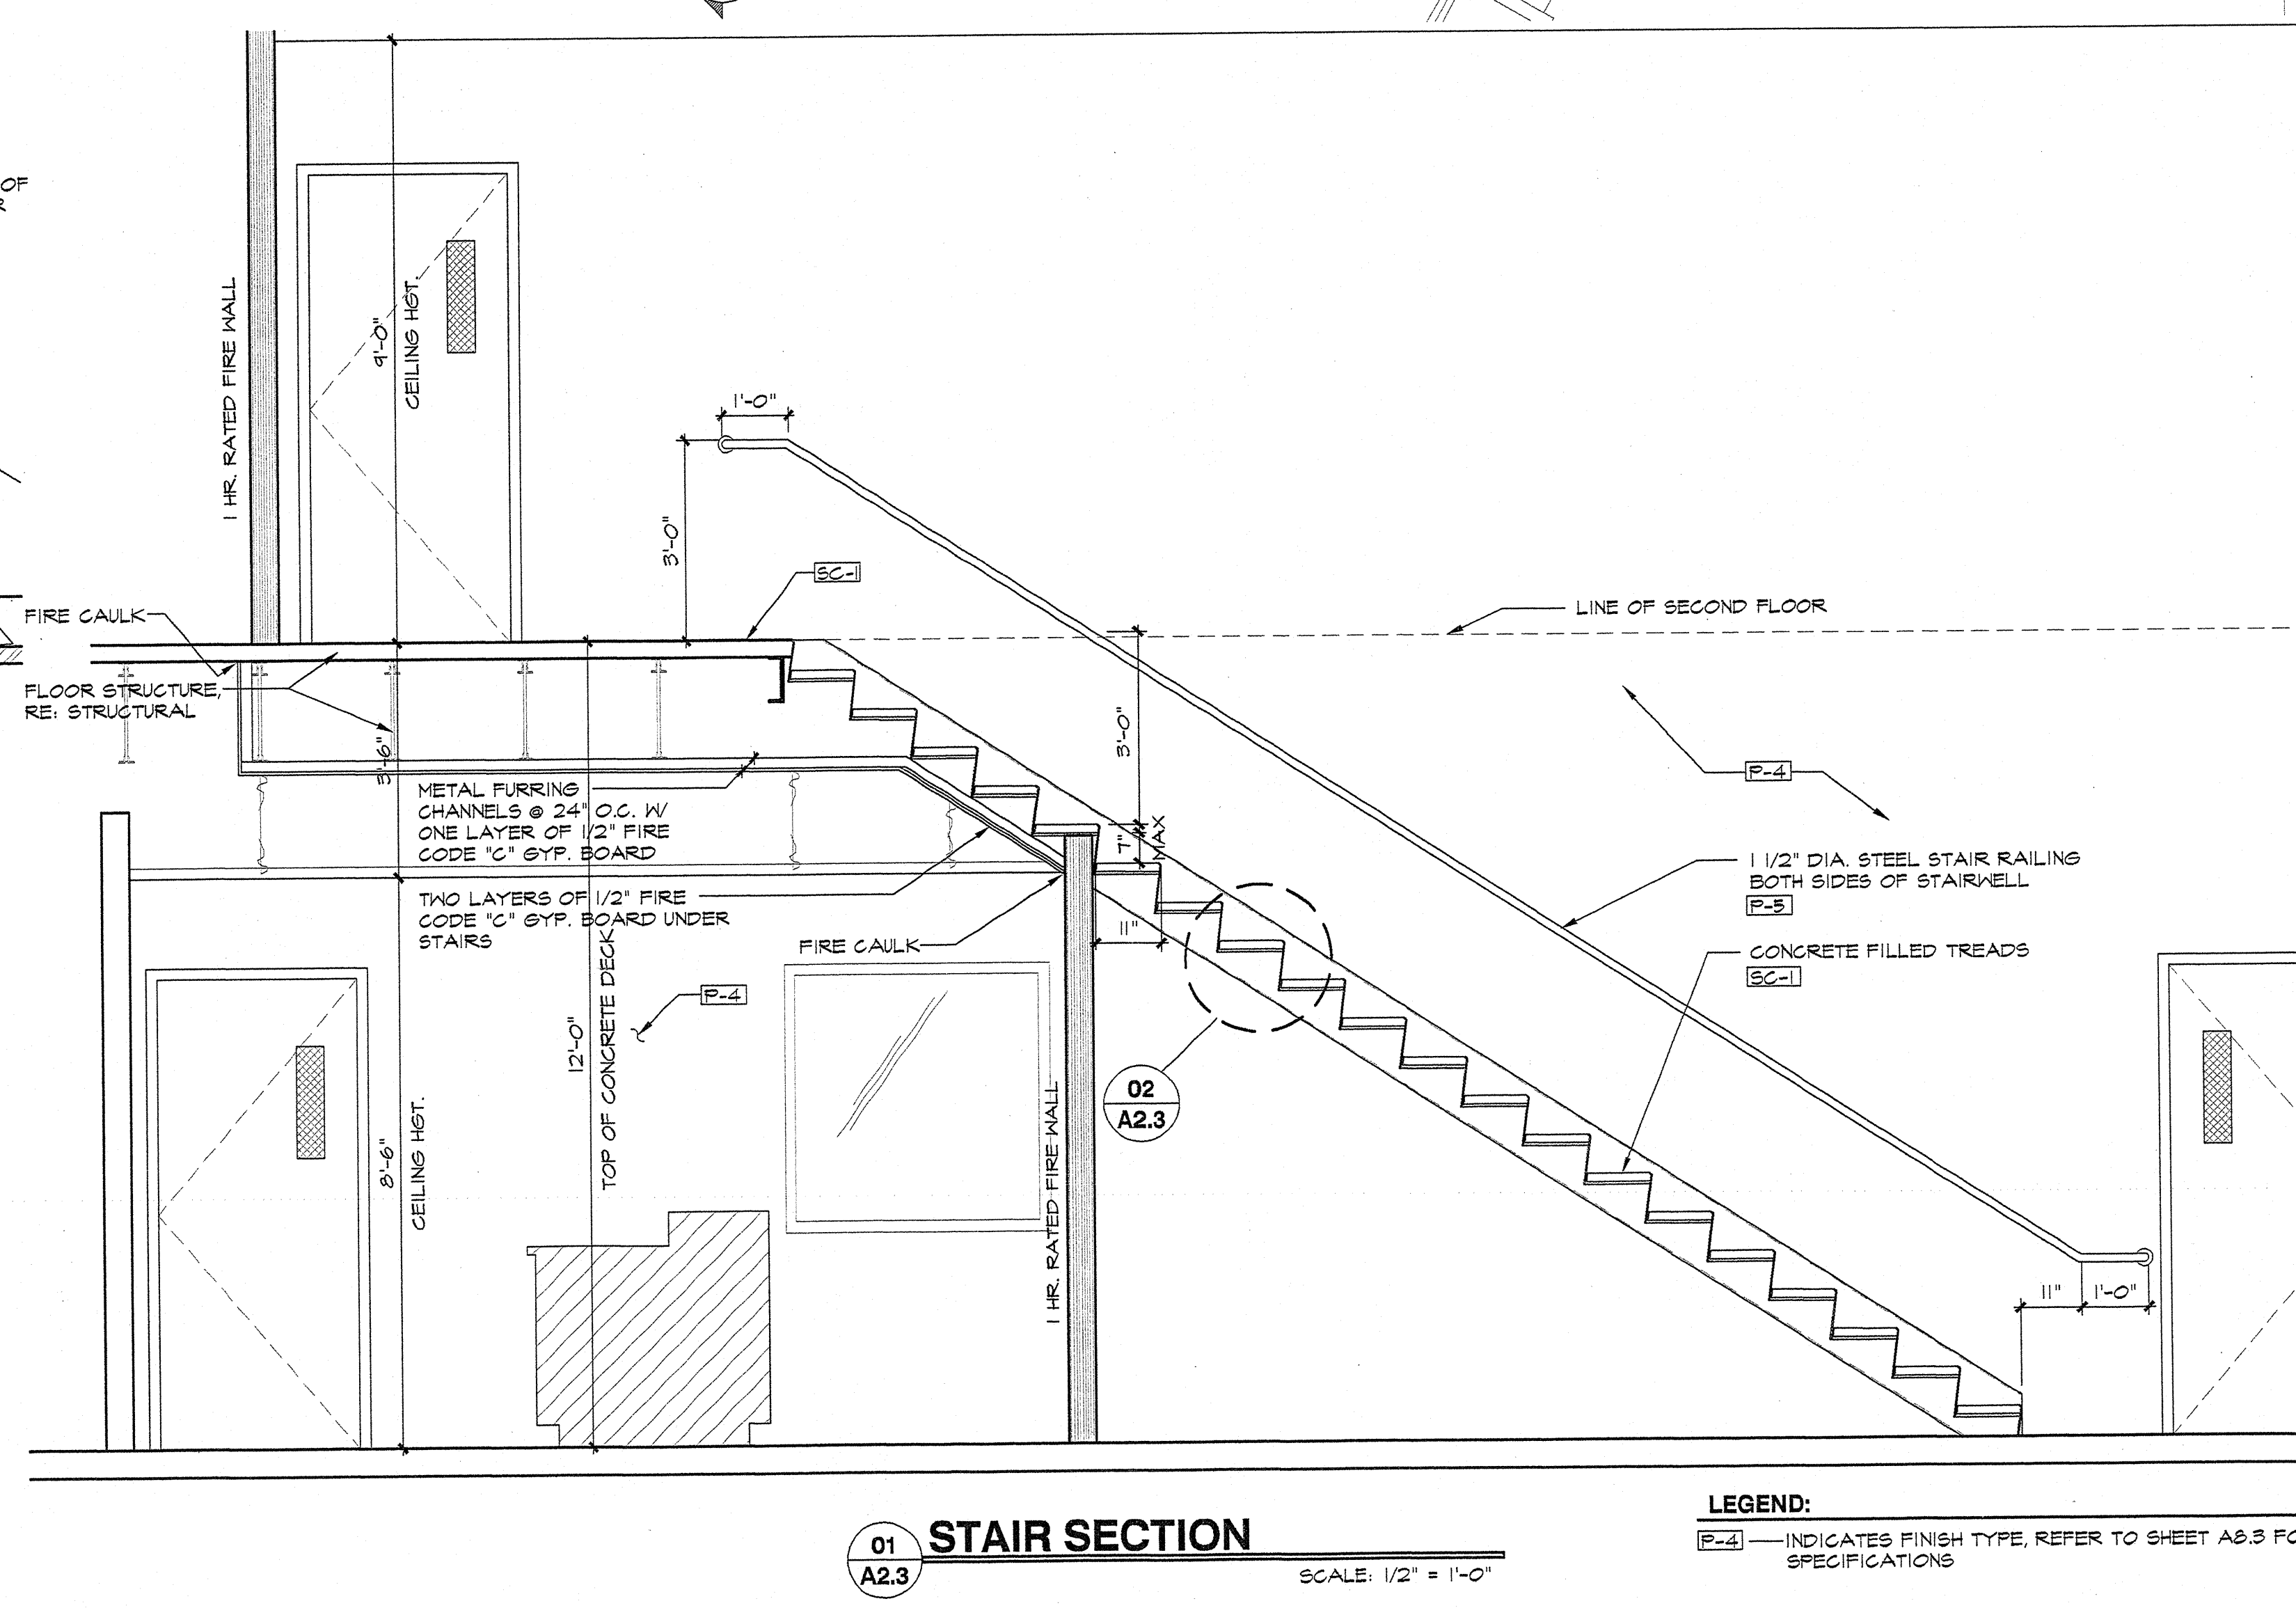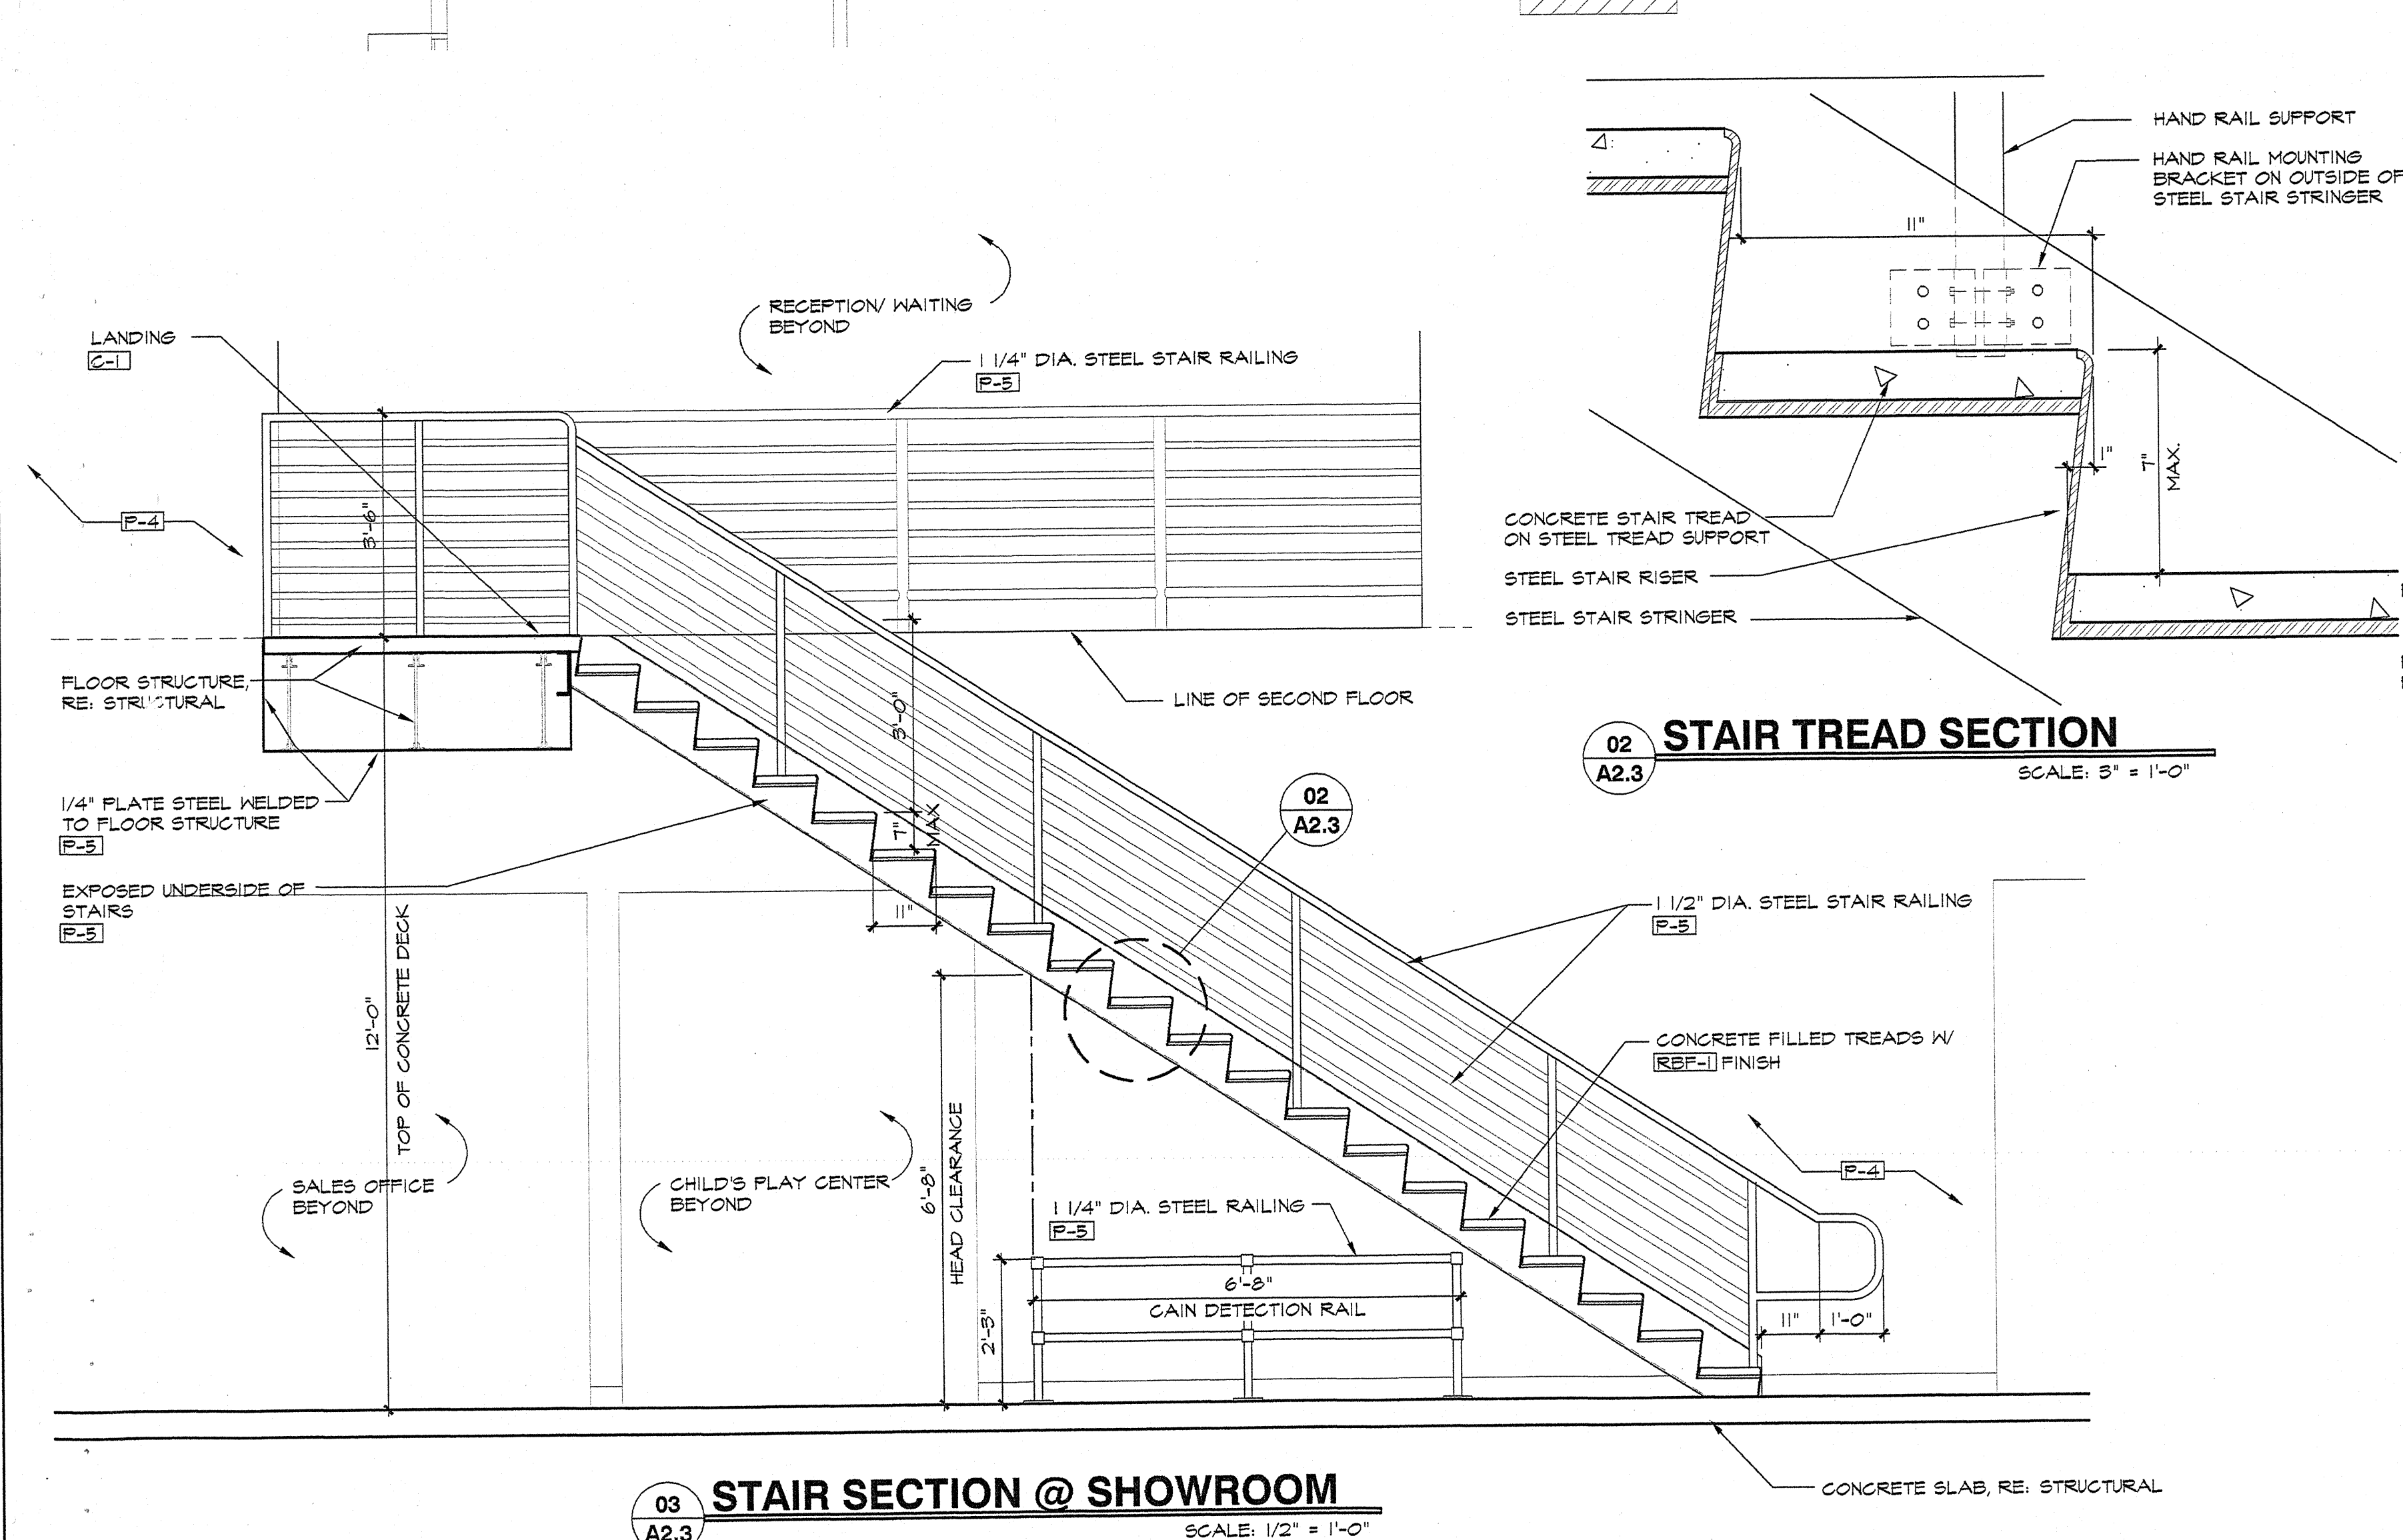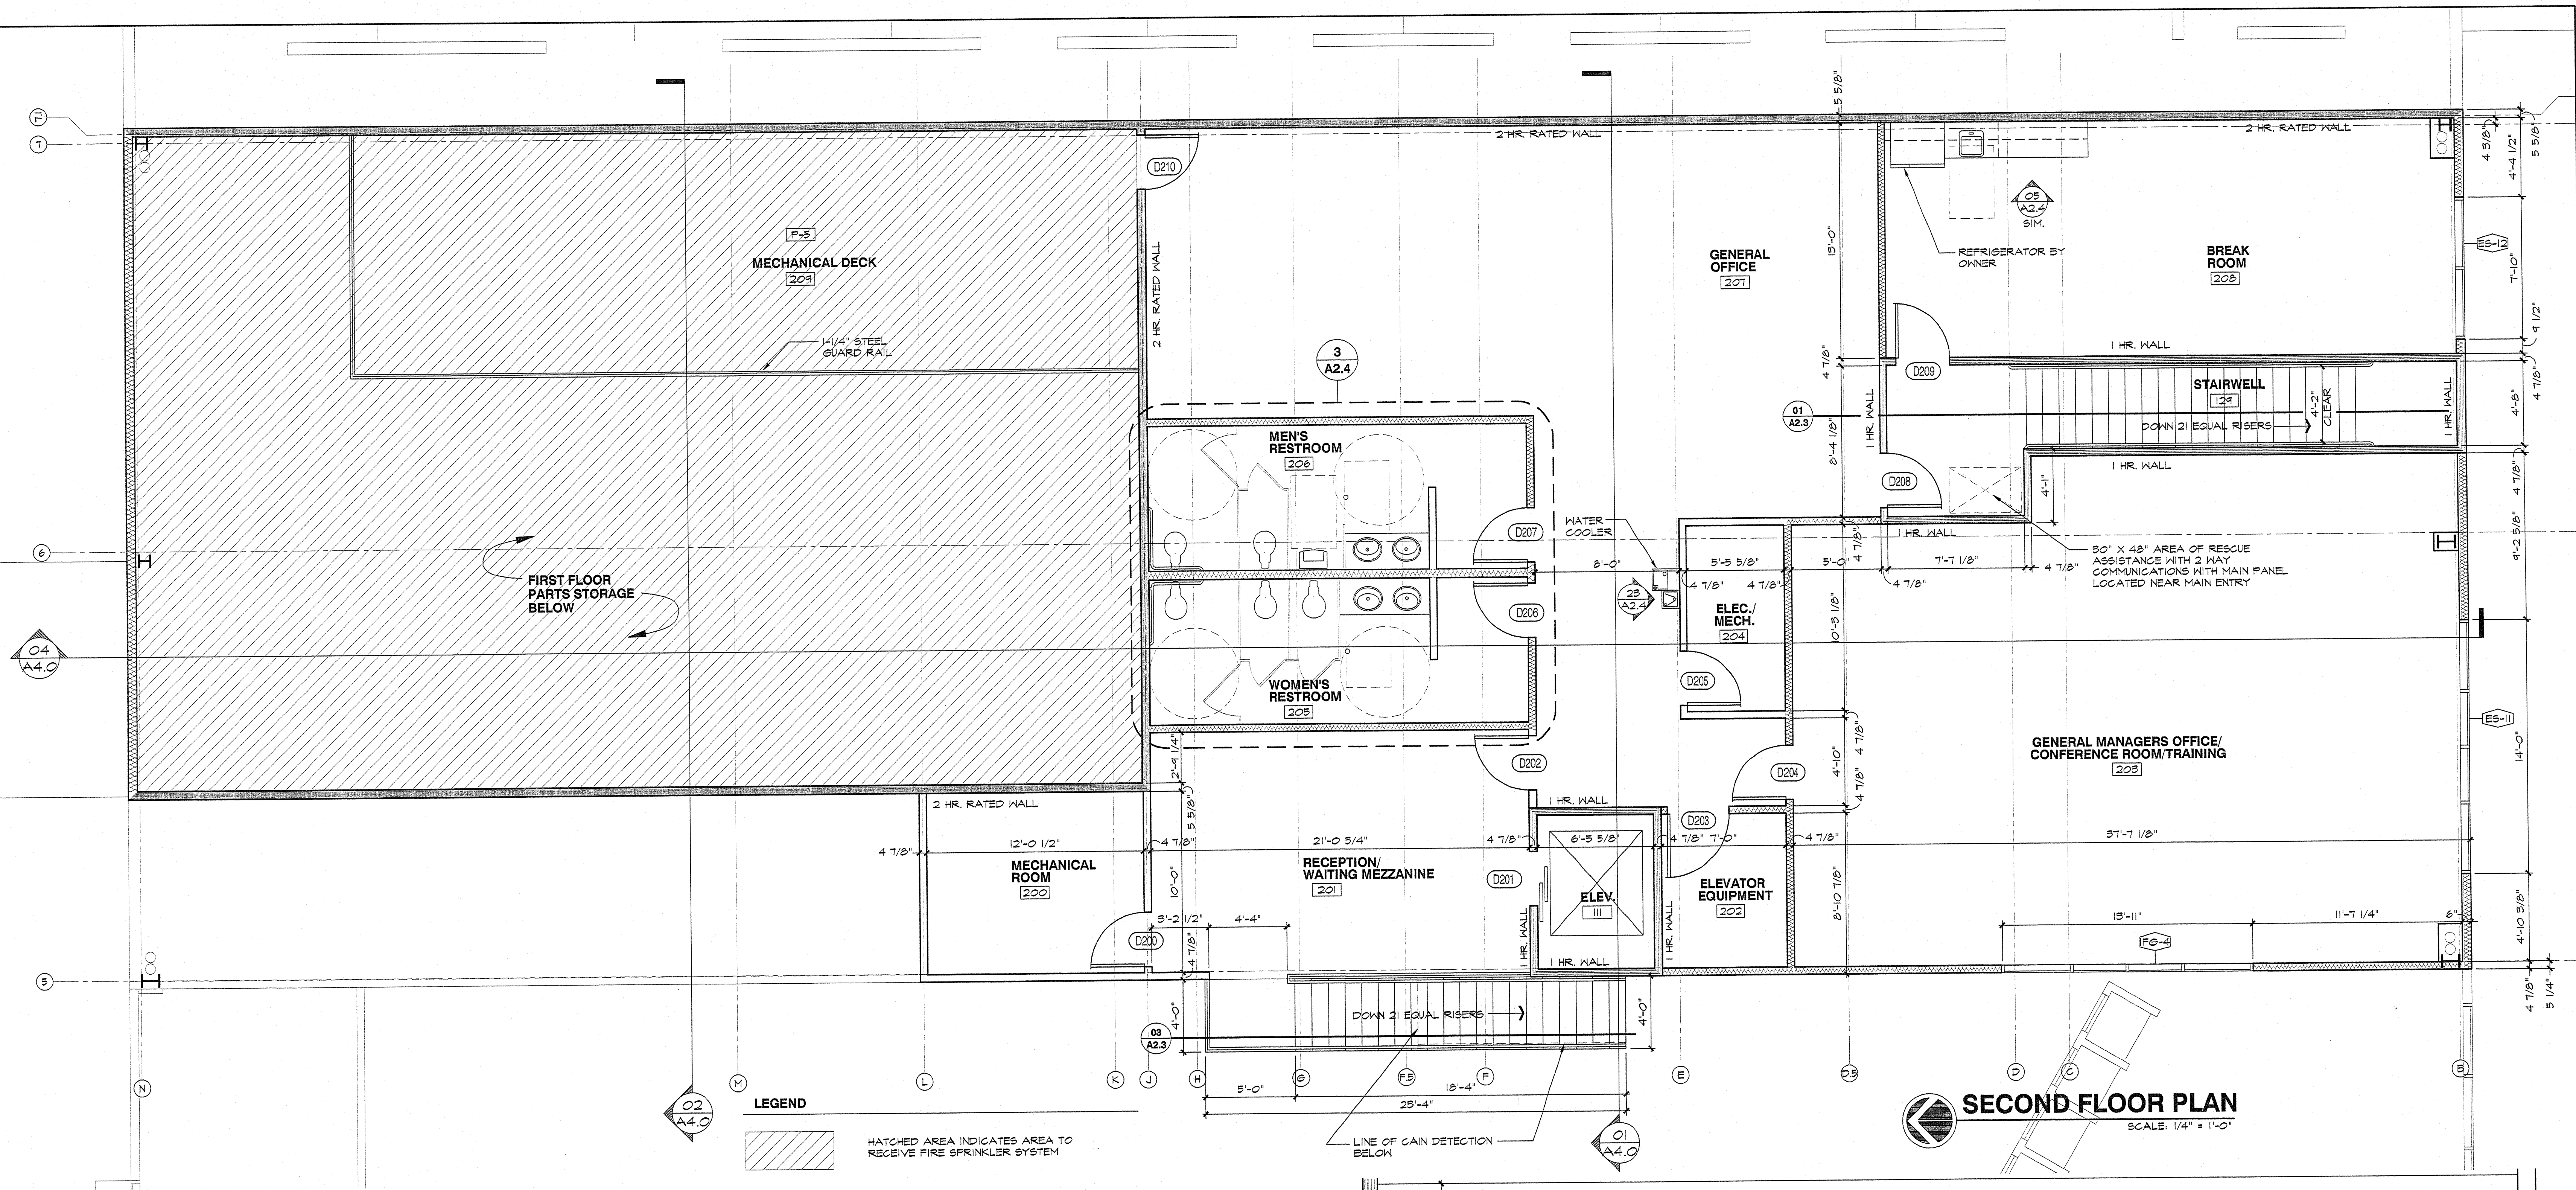

AN AUTOMOTIVE DEALERSHIP

ROGER BEASLEY VOLVO

1000 WEST 10TH AVENUE, SUITE 100, DENVER, CO 80202

AN AUTOMOTIVE DEALERSHIP

GEORGETOWN, TEXAS



**LOWEEN
ARCHITECTURAL
INC.**

ARCHITECTURE AND PLANNING


P.O. BOX 833 GEORGETOWN, TX 78627
(512) 930-5353 FAX (512) 930-2818 www.zei-bc.com

CONSULTANT
FORMATION:


SEE
REVISED

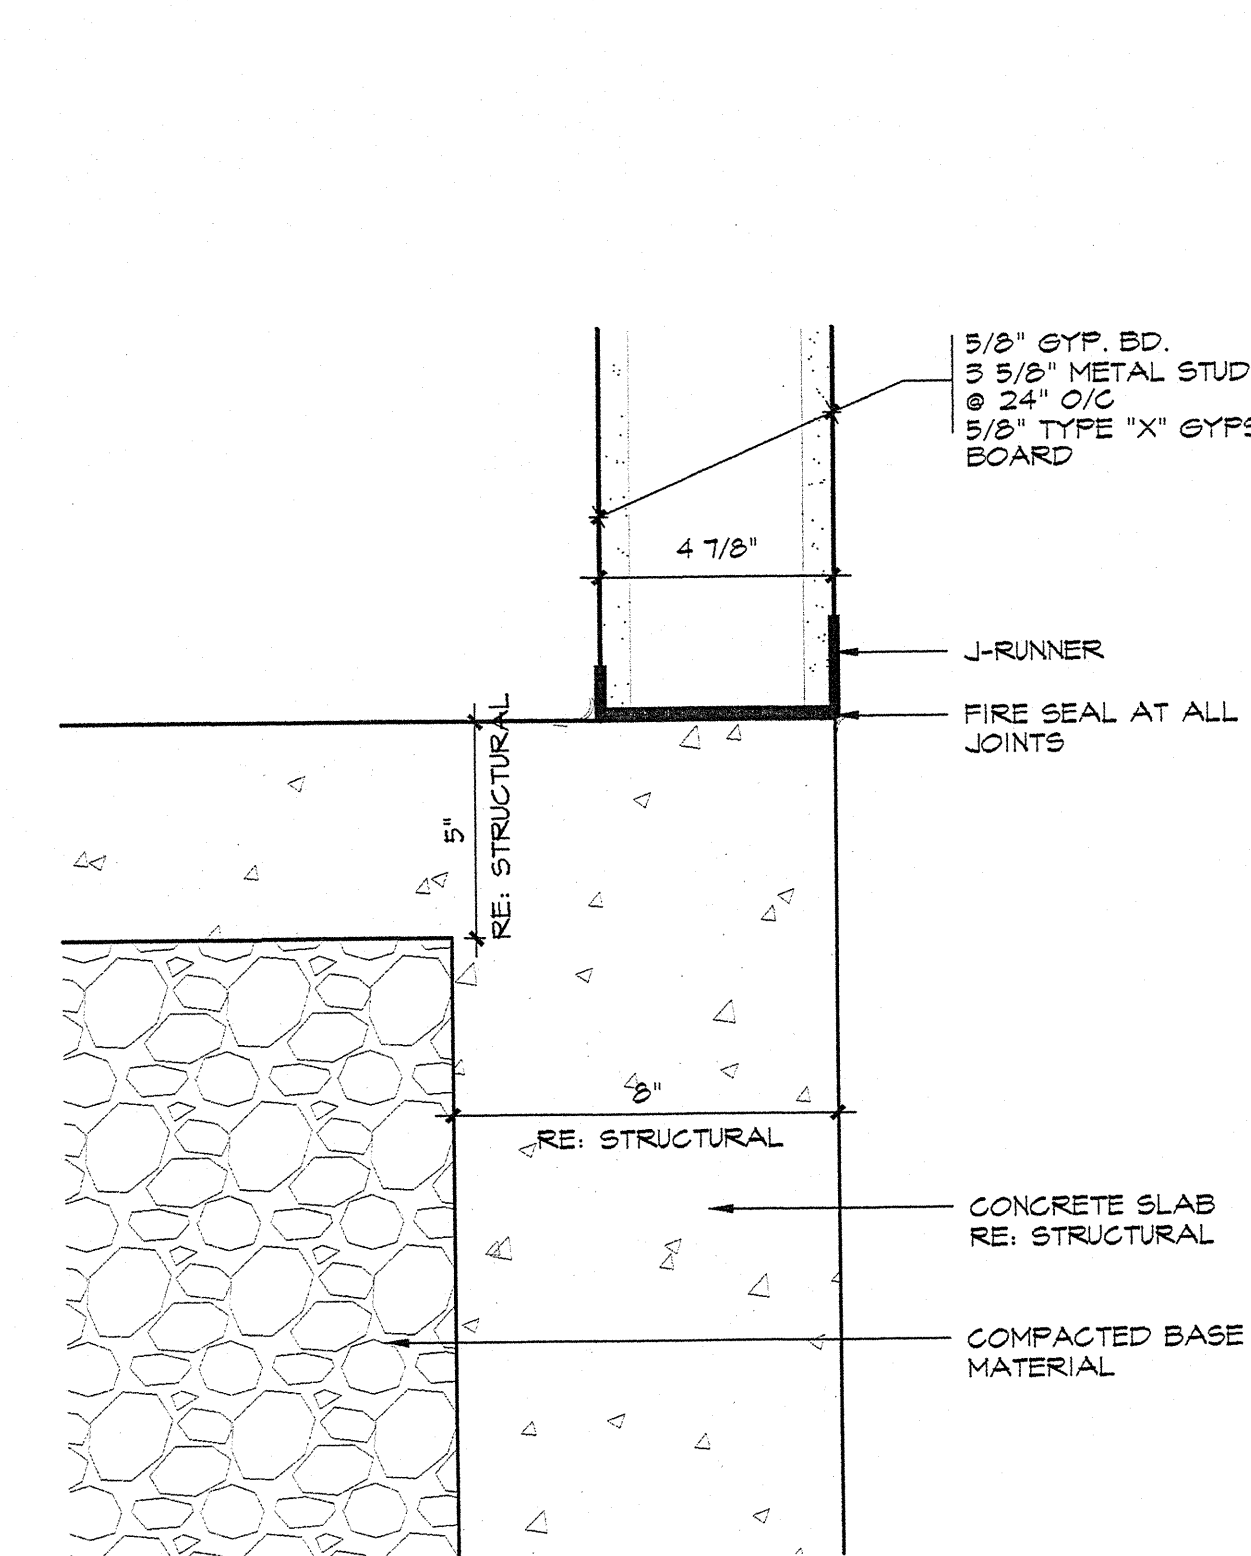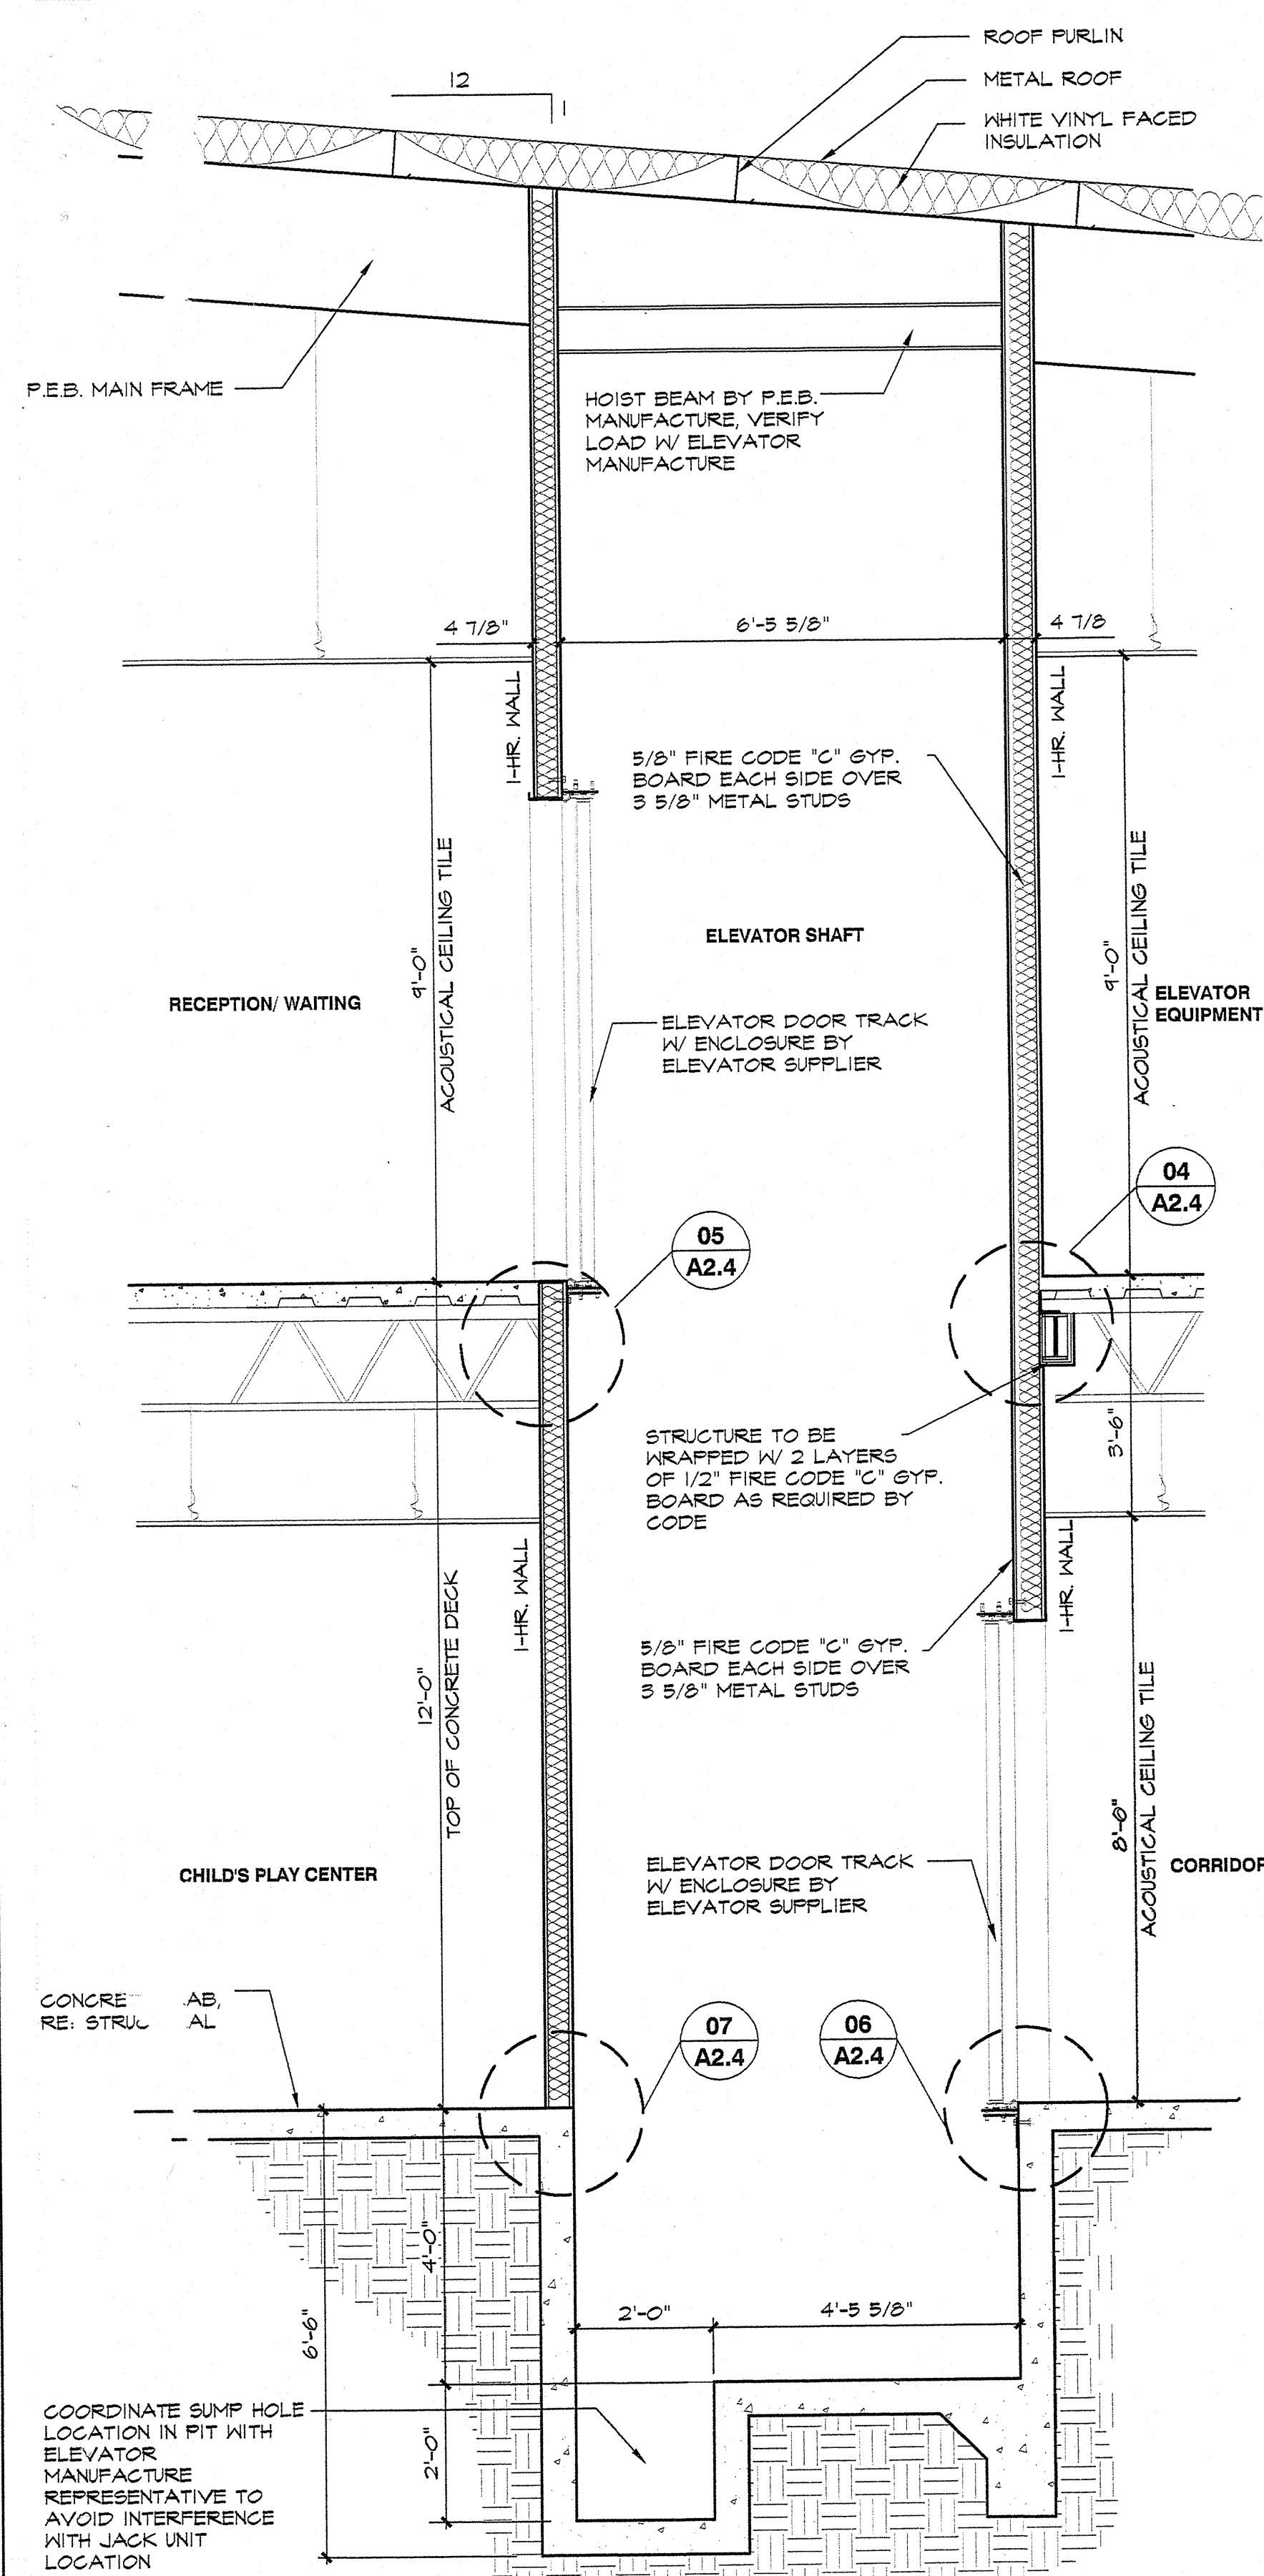


07 SILL @ ELEVATOR SHAFT
SCALE: 5" = 1'-0"

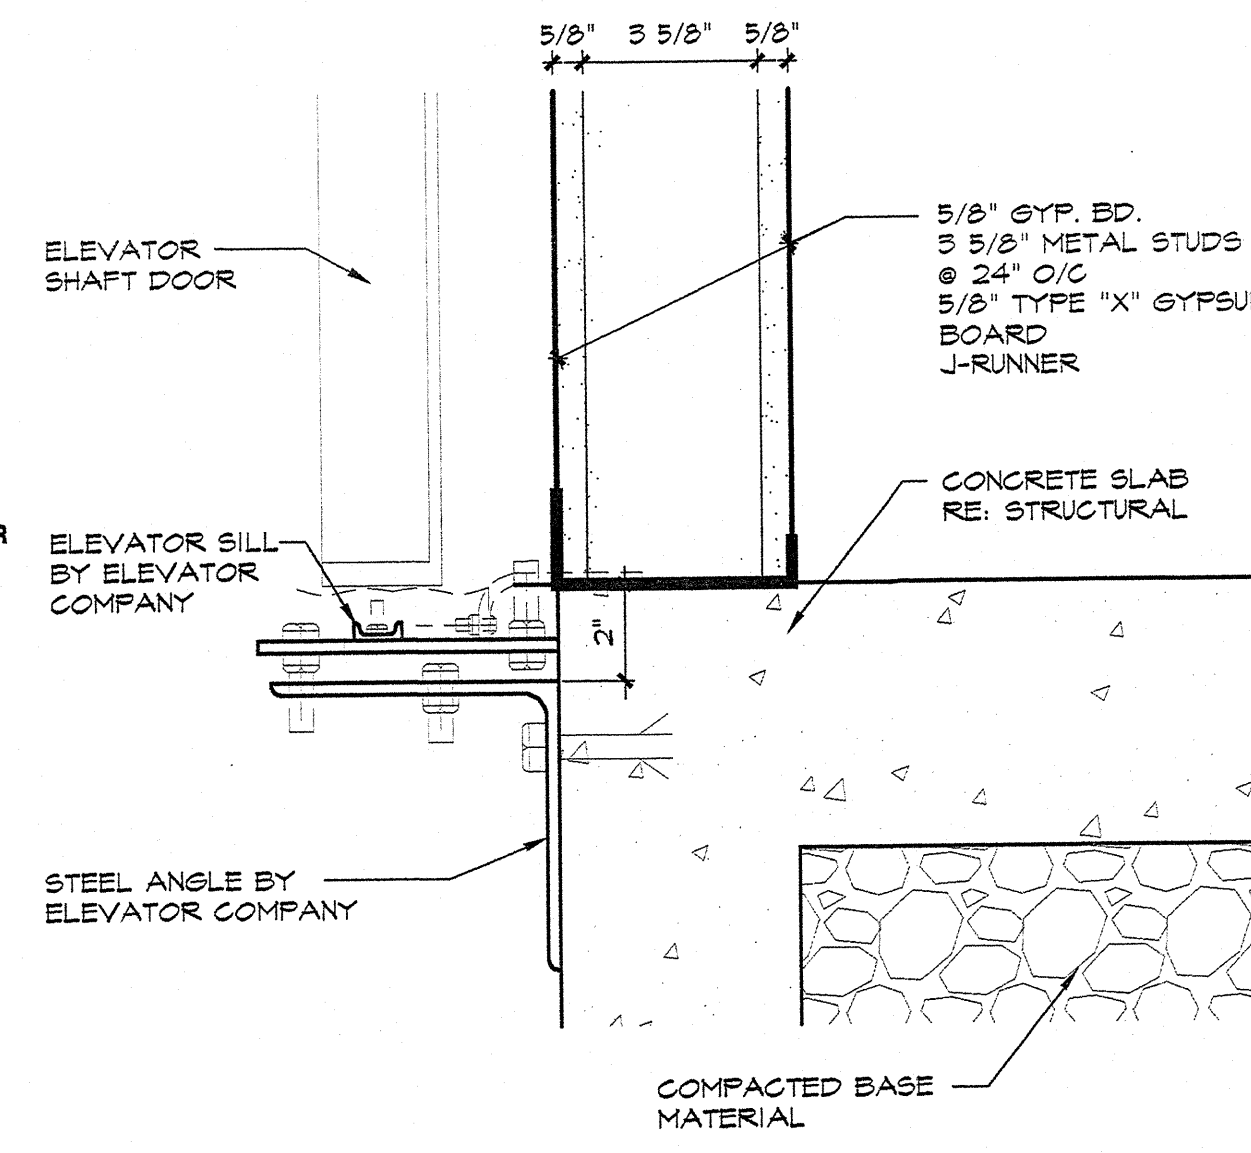


06 SILL @ ELEVATOR SHAFT
SCALE: 5" = 1'-0"

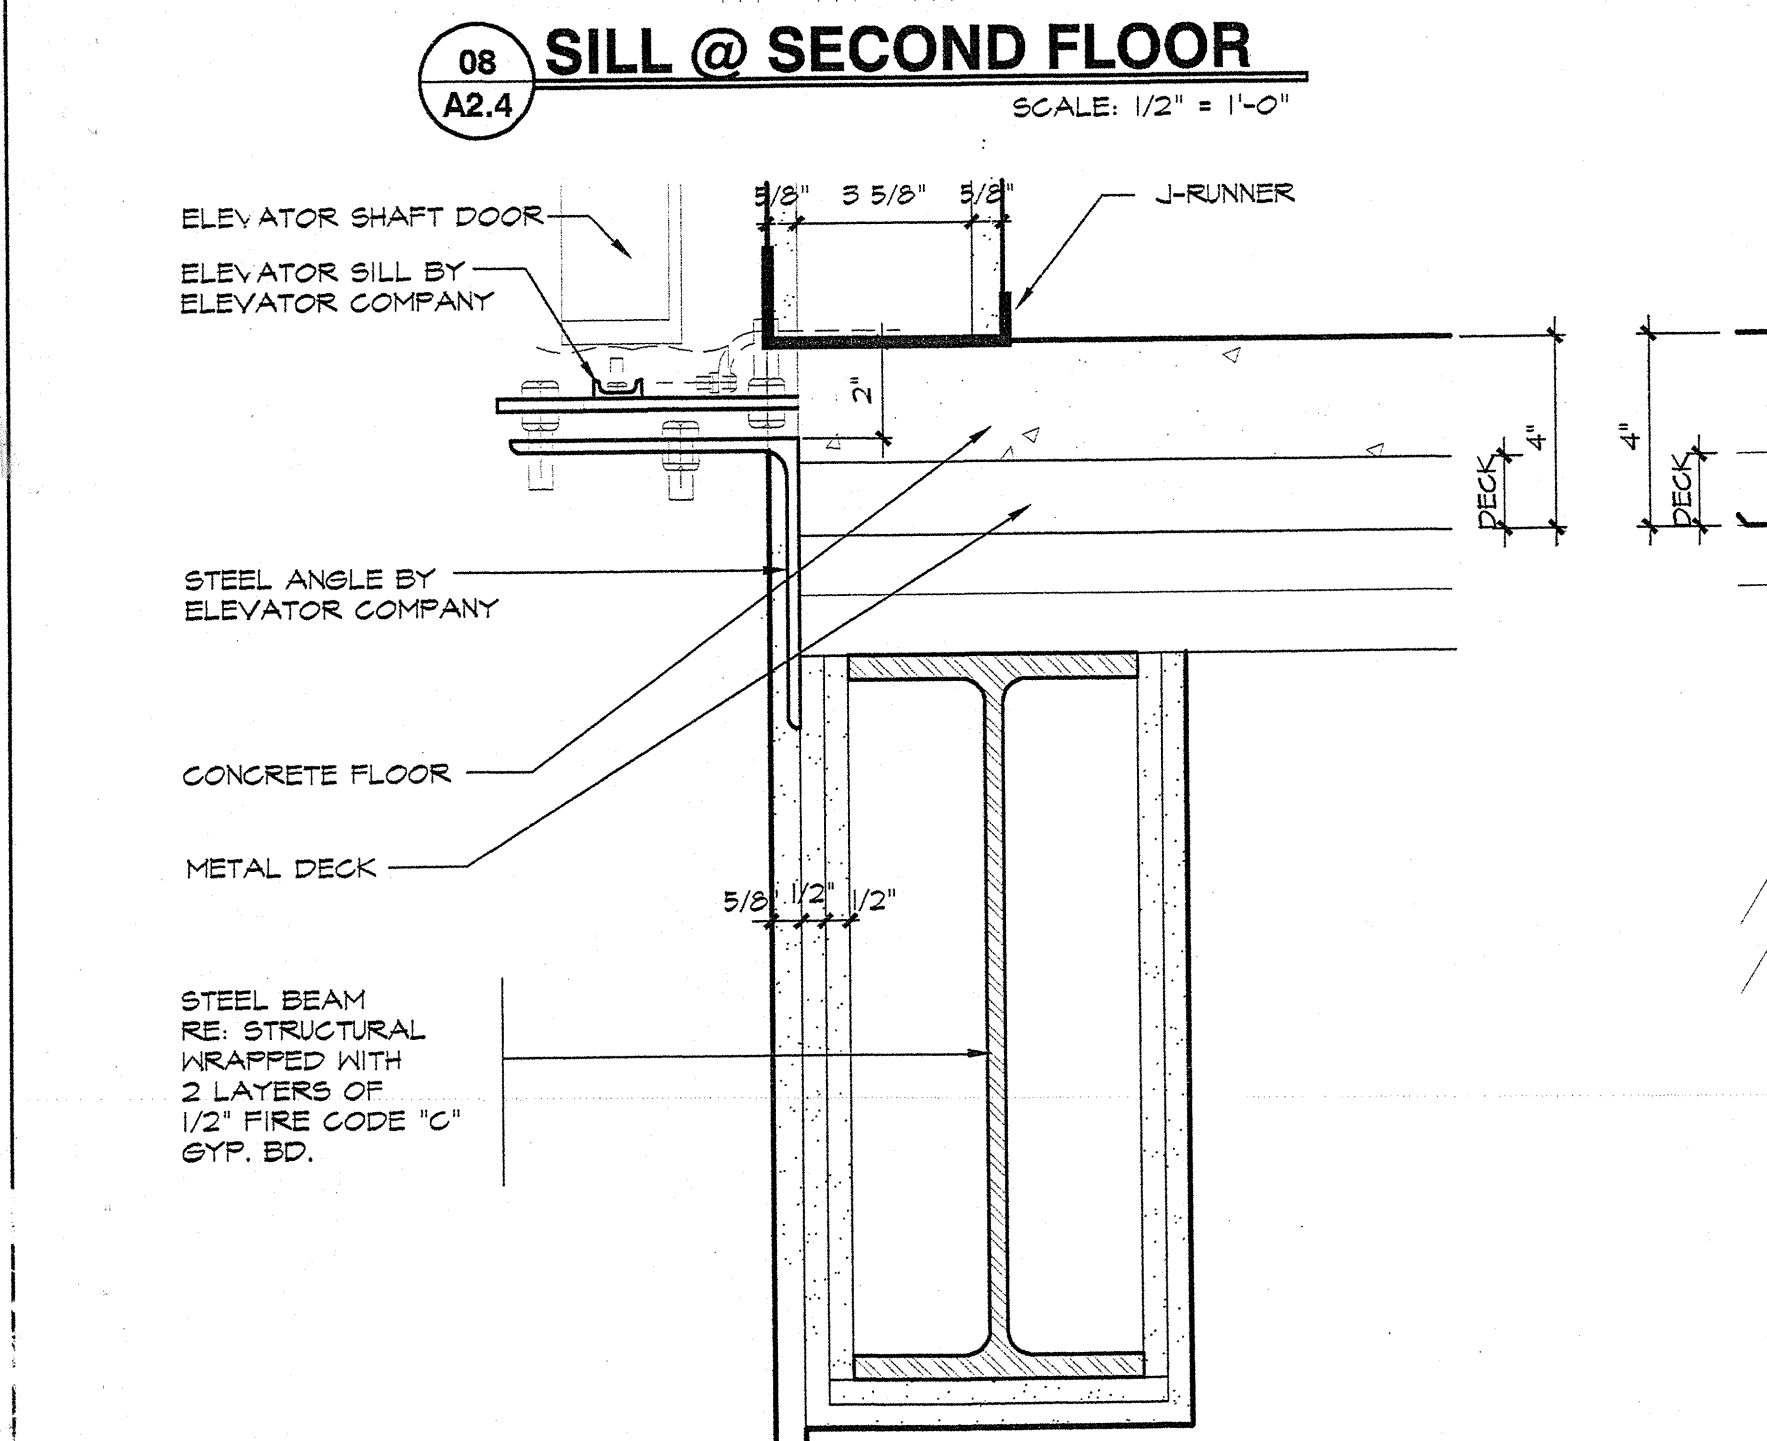

05 SILL @ SECOND FLOOR
SCALE: 5" = 1'-0"

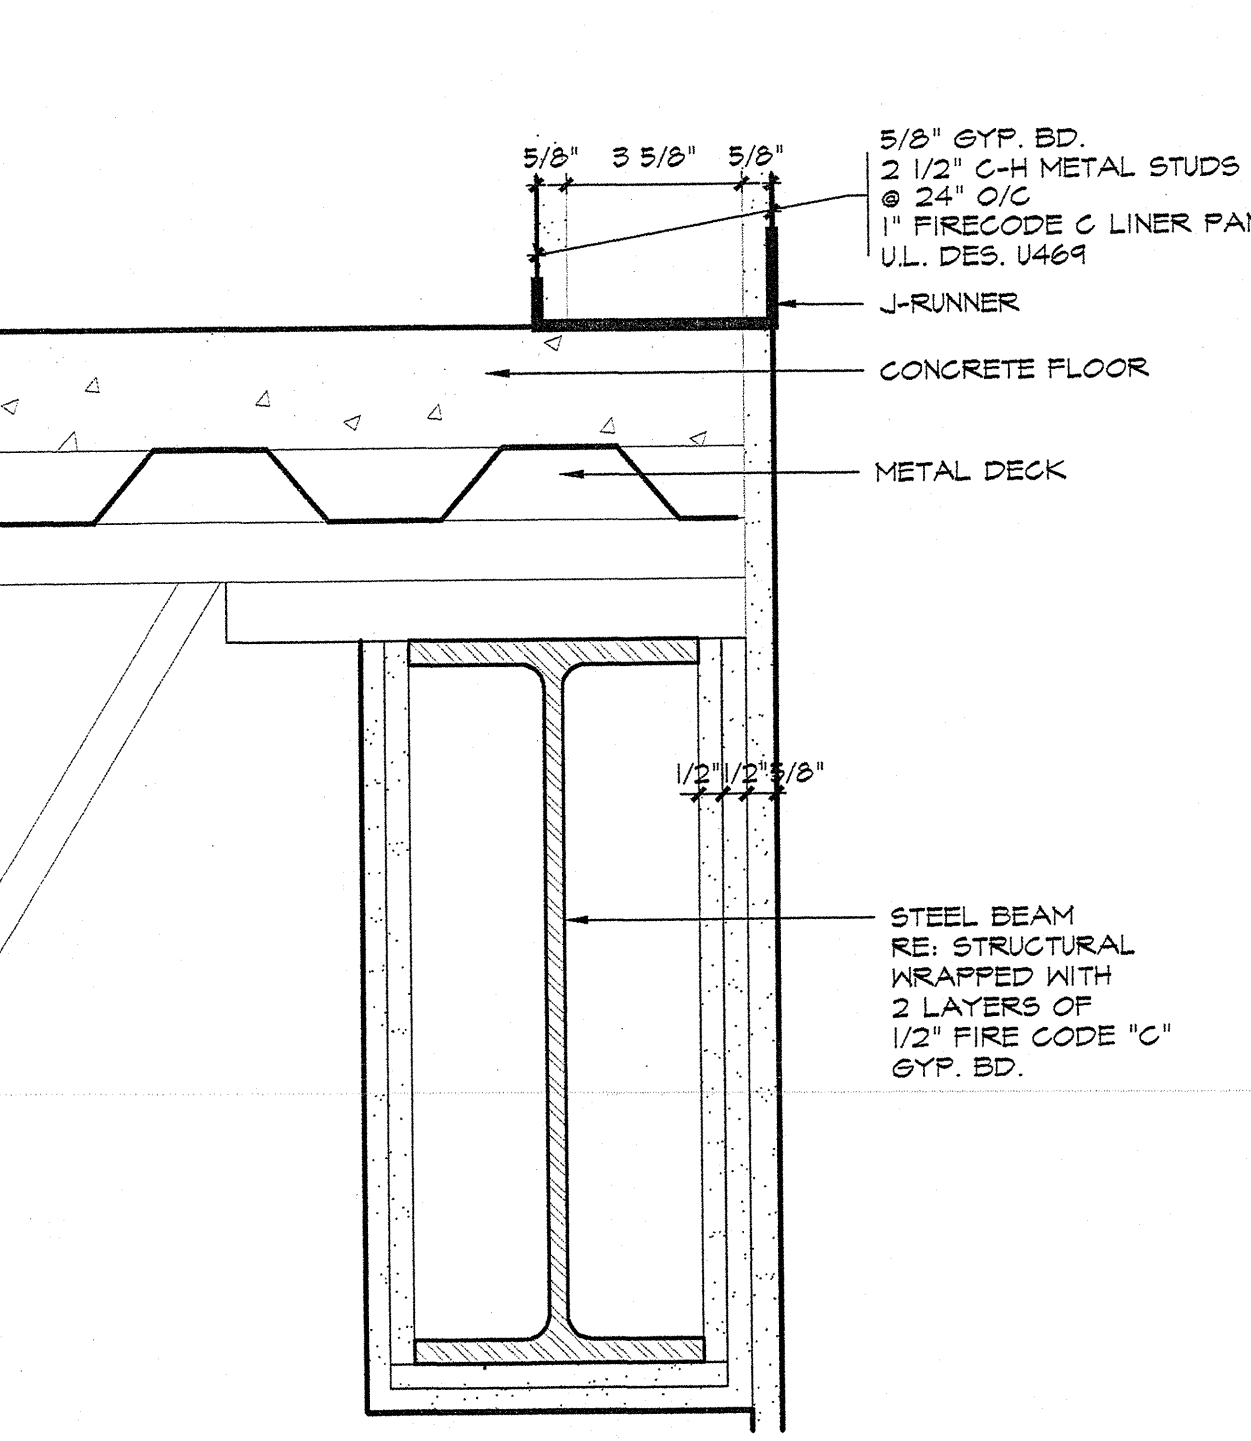


04 FLOOR @ ELEVATOR SHAFT
SCALE: 5" = 1'-0"

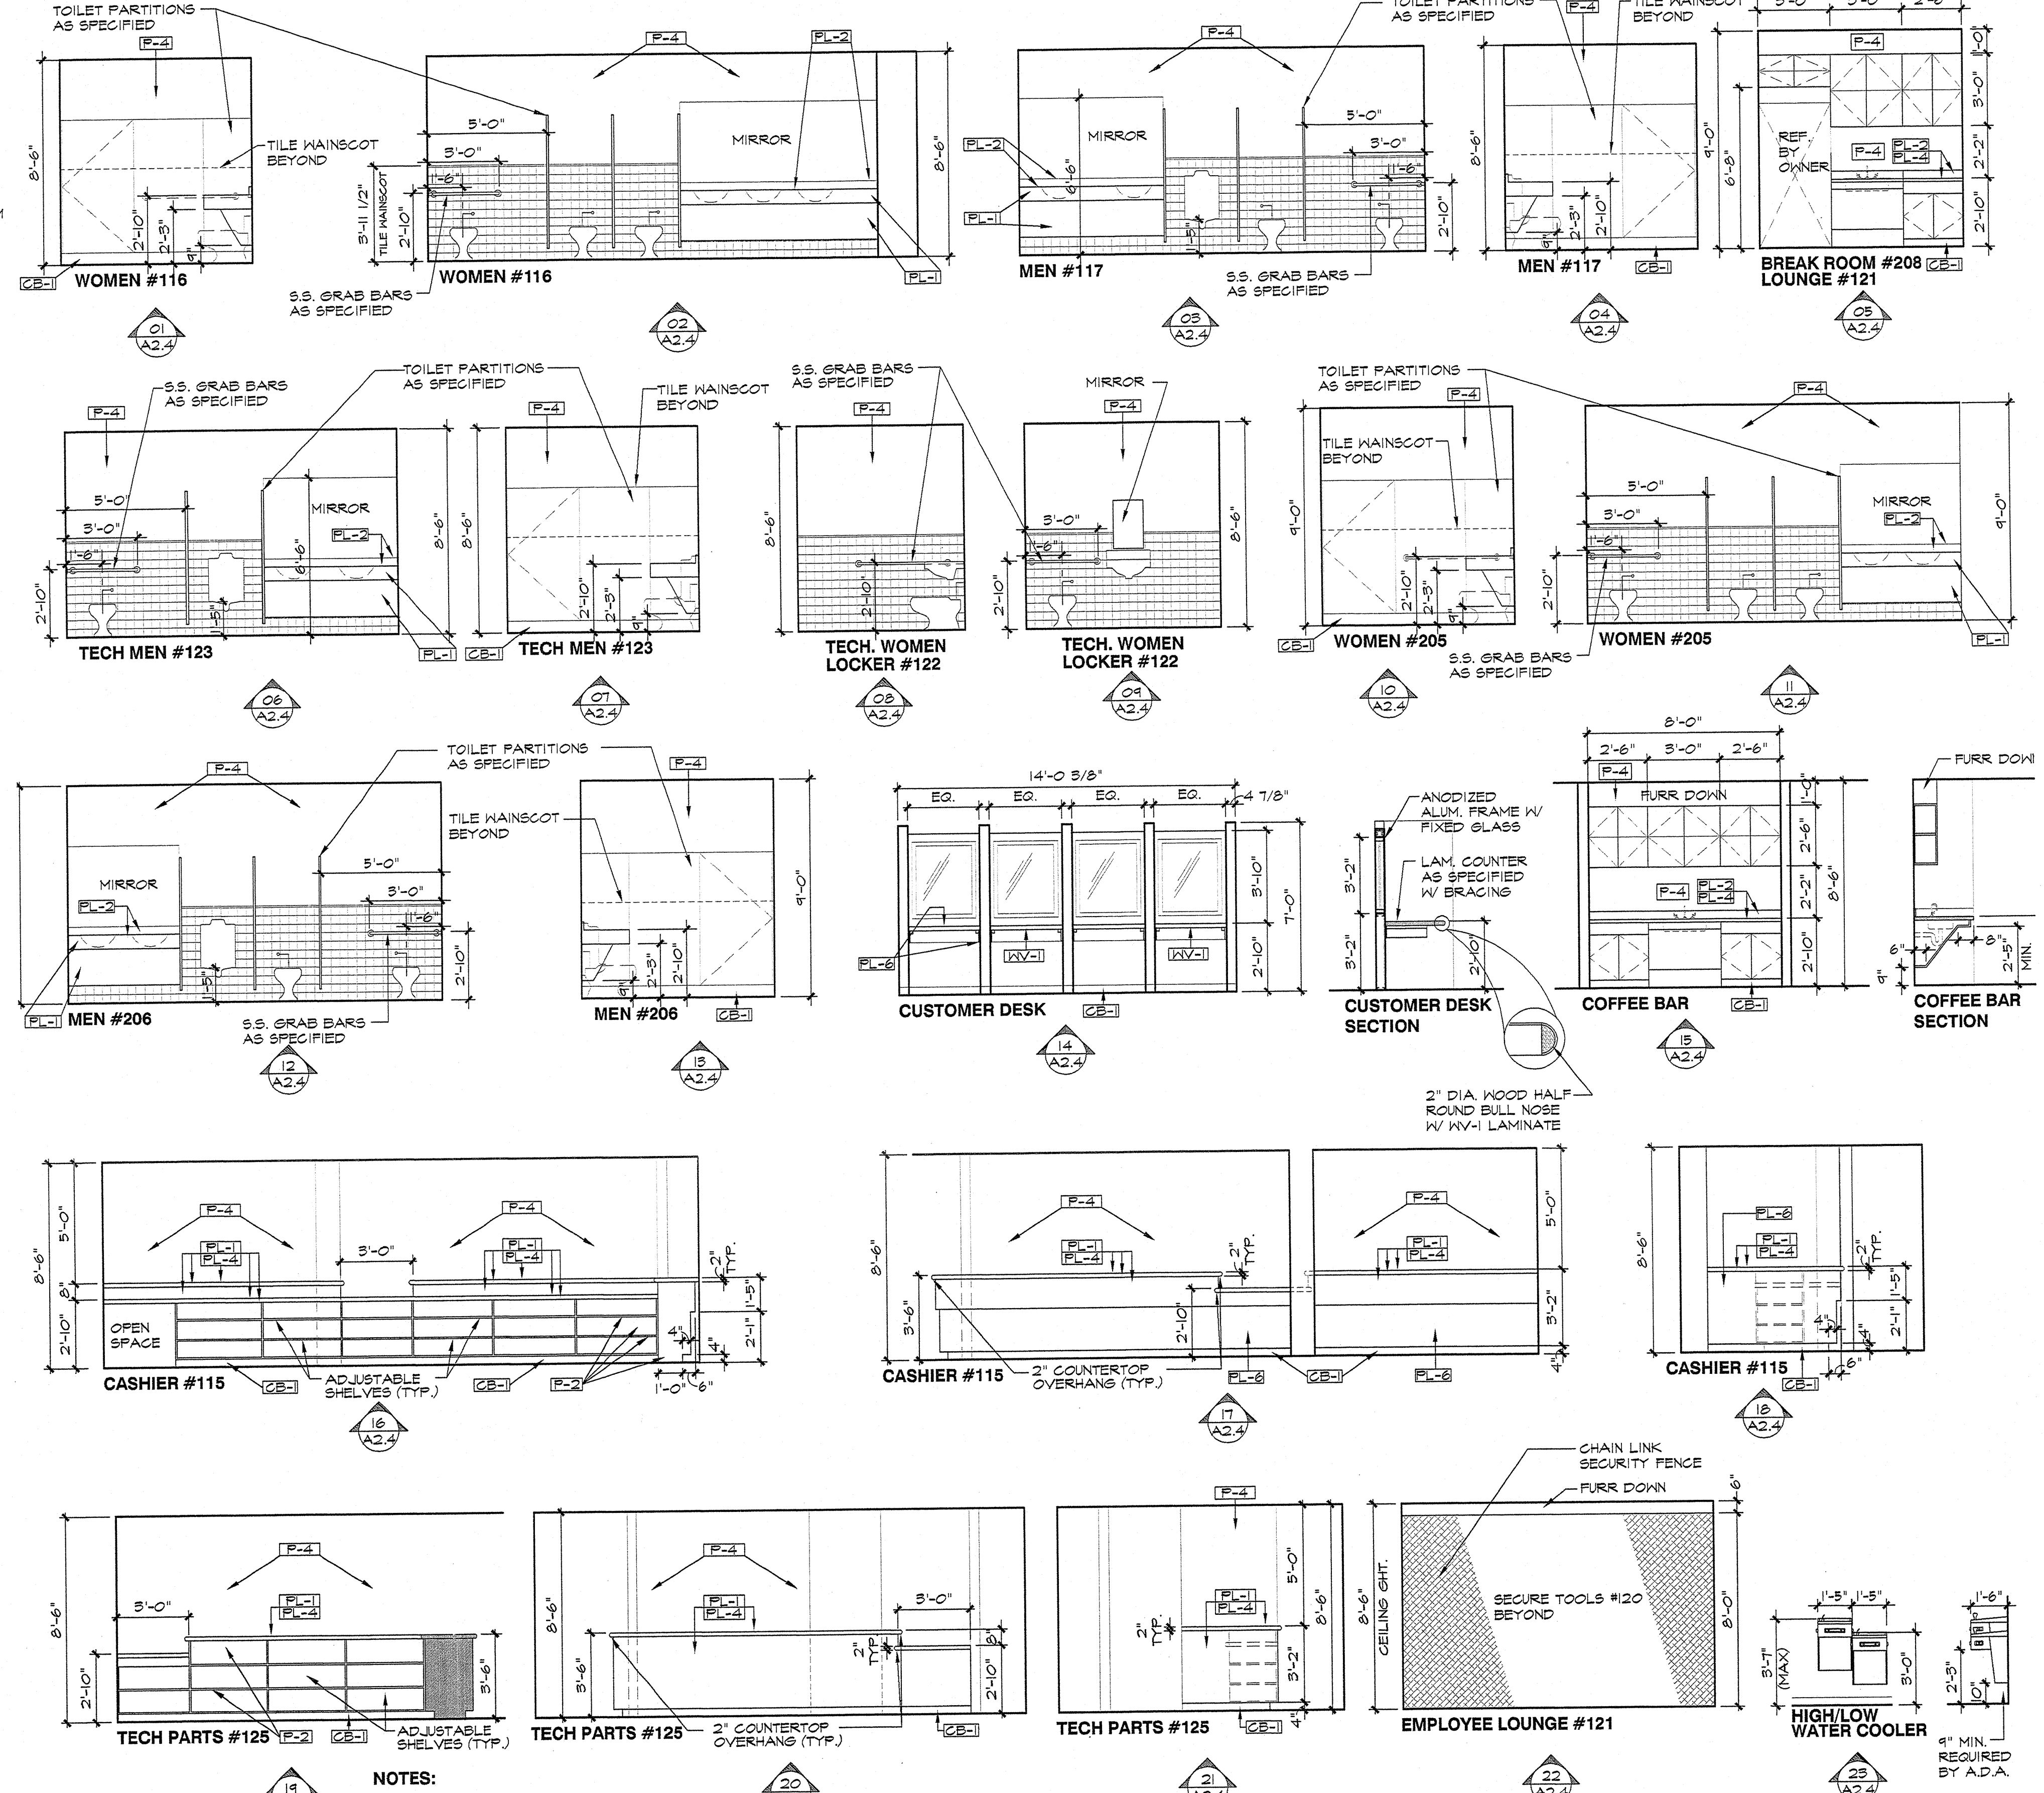


NOTES:
1. CONTRACTOR TO VERIFY ALL FINISHES WITH OWNER PRIOR TO PURCHASE AND INSTALLATION.
2. ALL CASEWORK BY CONTRACTOR.


INTERIOR ELEVATIONS
SCALE: 1/4" = 1'-0"

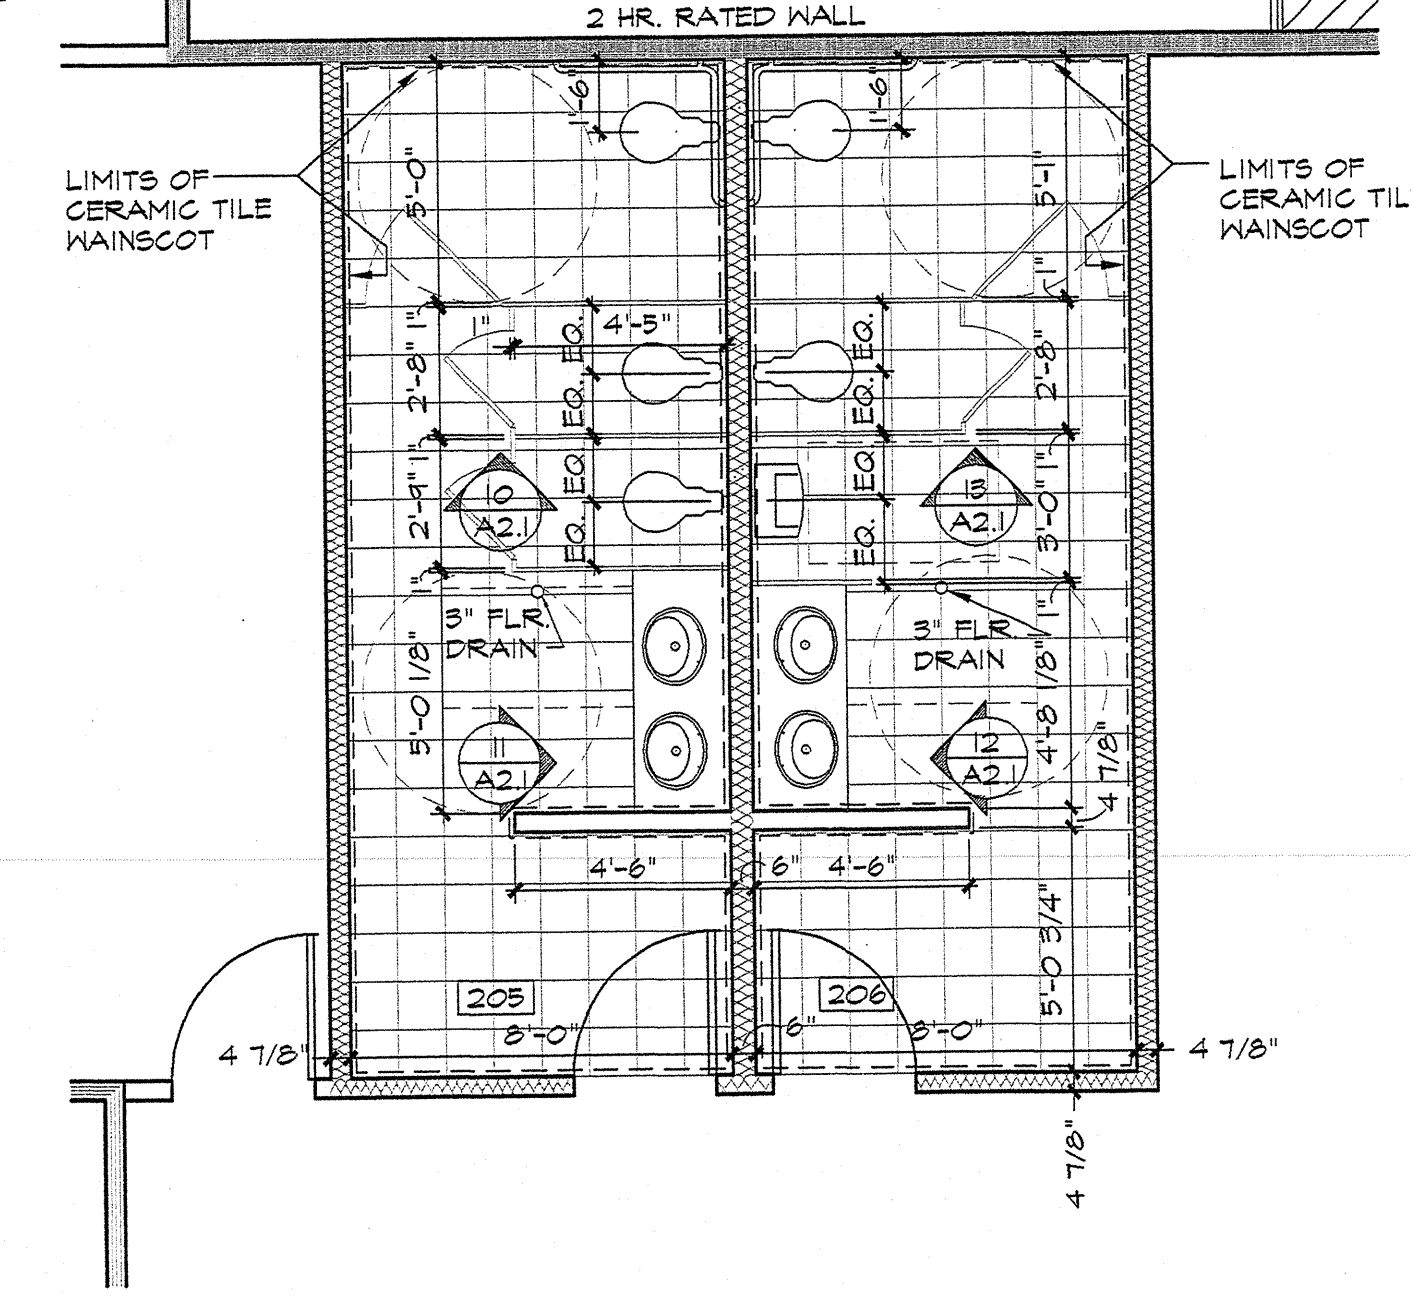

03 SECOND FLOOR RESTROOM PLAN
SCALE: 1/4" = 1'-0"

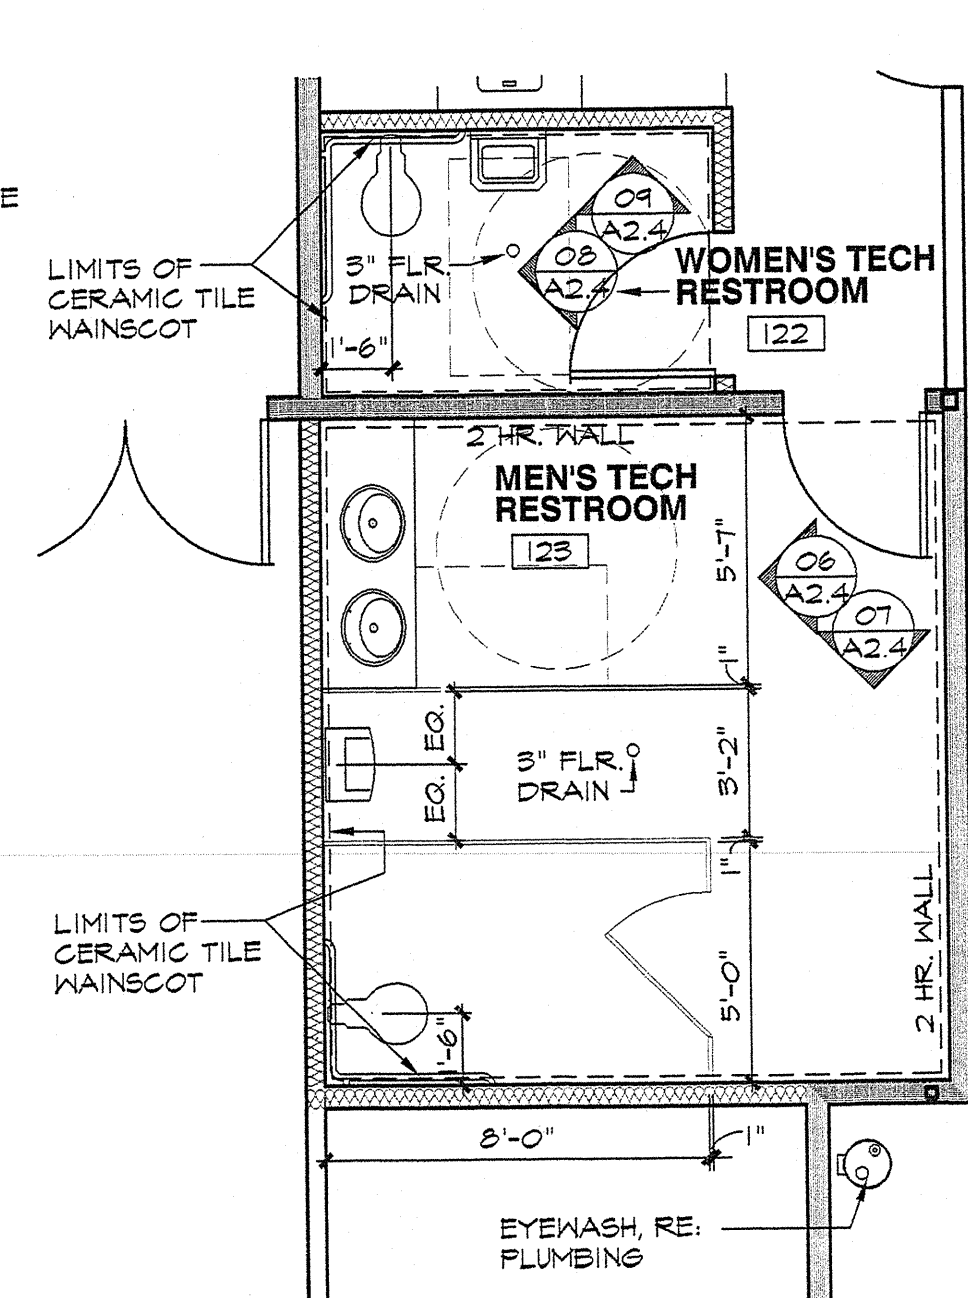

02 TECH RESTROOM PLAN
SCALE: 1/4" = 1'-0"

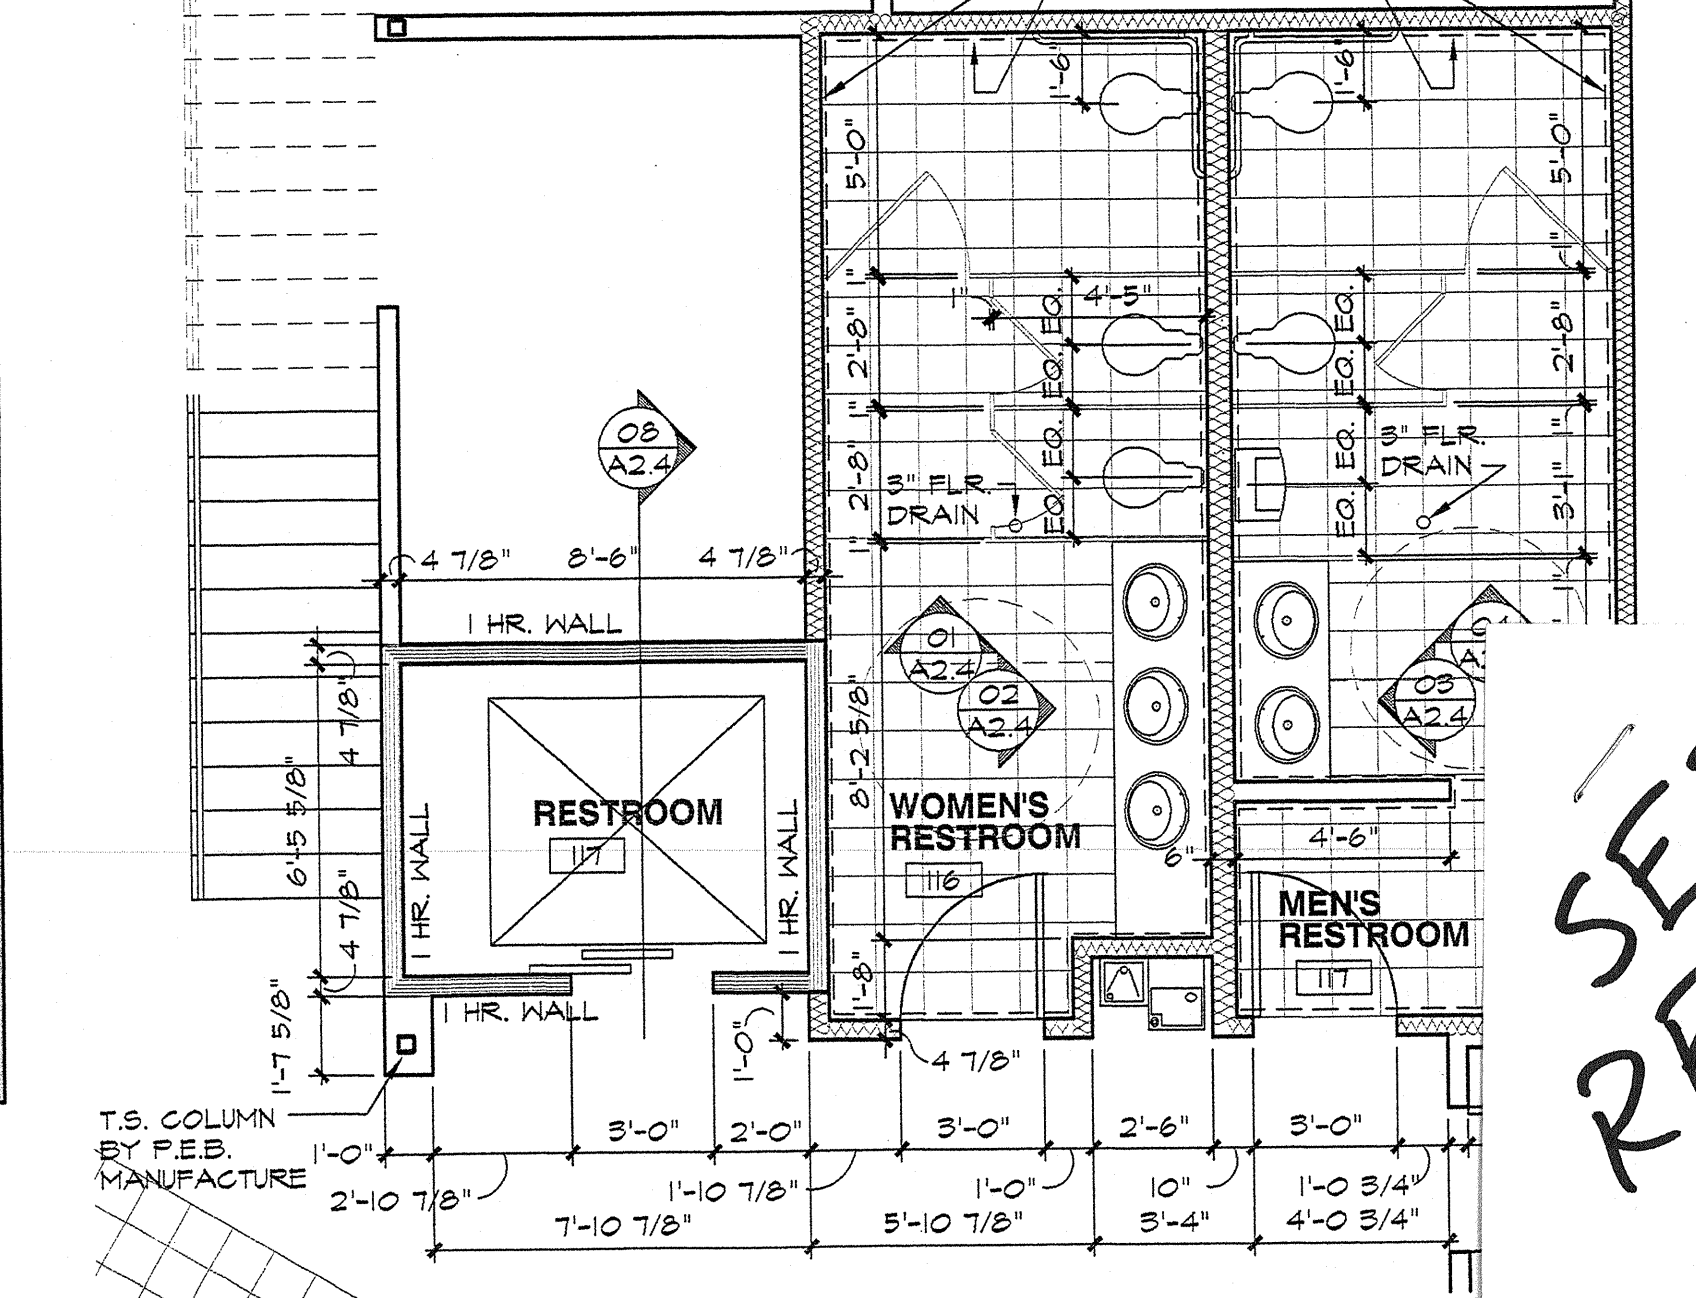

01 FIRST FLOOR RESTROOM
SCALE: 1/4" = 1'-0"

SEE REVISED


ROGER BEASLEY VOLVO


AN AUTOMOTIVE DEALERSHIP

INTERSTATE HIGHWAY 35 SOUTH
GEORGETOWN, TEXAS

ELASSER ARCHITECTURAL INC.
ARCHITECTURE AND PLANNING
P.O. BOX 488 GEORGETOWN, TX 78627
(512) 860-3555 FAX (512) 860-3515 www.ela.com

CONSULTANT INFORMATION:

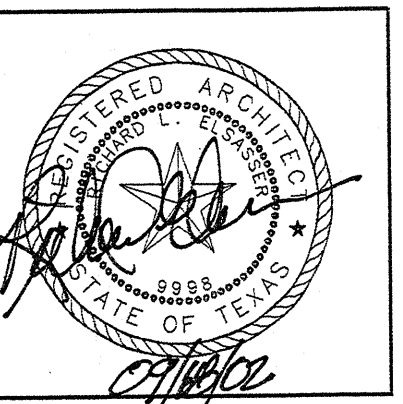

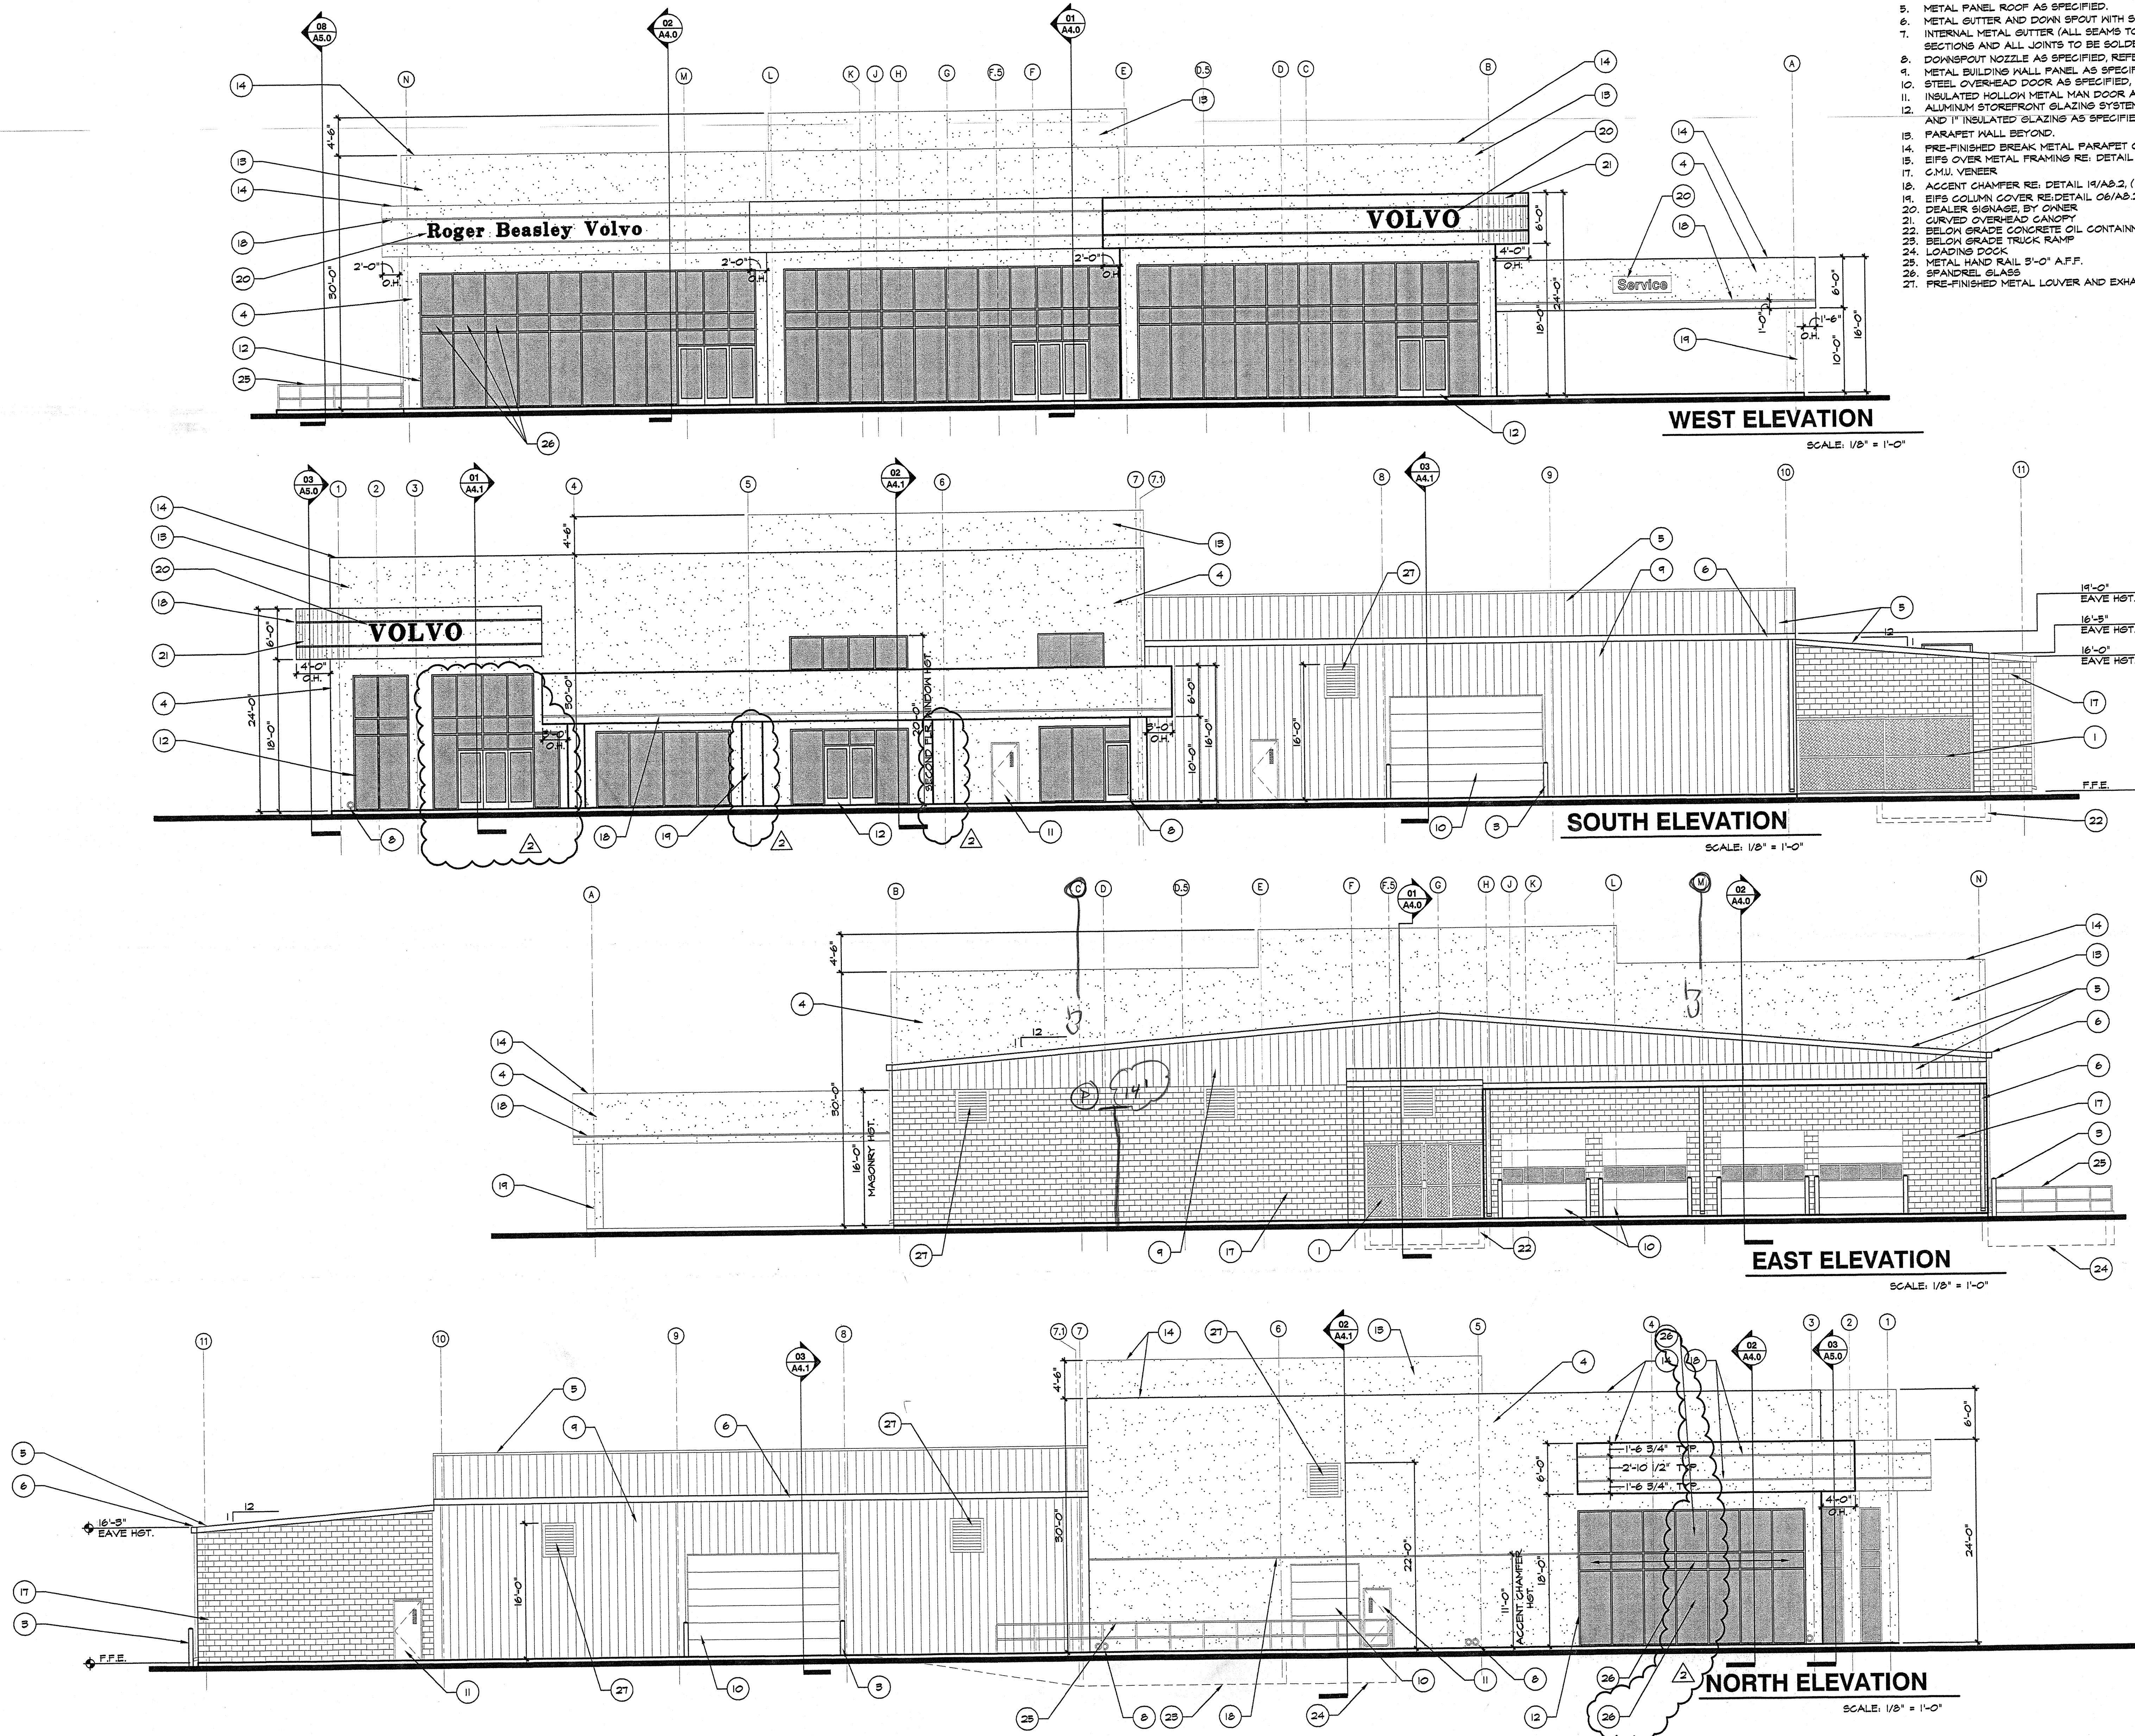

- ELEVATION NOTES (ALL NOTES MAY NOT APPLY)
- 9'-0" HIGH CHAIN LINK FENCING.
 - 4" DIA. GALV. STEEL POST SET IN CONCRETE.
 - 6" CONCRETE FILLED PIPE BOLLARD, (P-10).
 - EIFS WALL SYSTEM AS SPECIFIED.
 - METAL PANEL ROOF AS SPECIFIED.
 - METAL GUTTER AND DOWN SPOUT WITH SPLASH BLOCK BELOW.
 - INTERNAL METAL GUTTER (ALL SEAMS TO BE SOLDERED AND SEALED).
 - DOWNSPOUT NOZZLE AS SPECIFIED, REFER TO FLOOR PLANS FOR LOCATIONS.
 - METAL BUILDING WALL PANEL AS SPECIFIED.
 - STEEL OVERHEAD DOOR AS SPECIFIED, (P-10).
 - INSULATED HOLLOW METAL MAN DOOR AS SCHEDULED, (P-10).
 - ALUMINUM STOREFRONT GLAZING SYSTEM W/ CLEAR ANODIZED FRAMES AND 1" INSULATED GLAZING AS SPECIFIED, SEE SHEET A3.0.
 - PARAFET WALL BEYOND.
 - PRE-FINISHED BREAK METAL PARAFET CAP W/ DRIP EDGE BOTH SIDES, (P-1).
 - EIFS OVER METAL FRAMING RE: DETAIL 07/A3.2.
 - C.M.U. VENEER.
 - ACCENT CHAMFER RE: DETAIL 19/A3.2, (P-1).
 - EIFS COLUMN COVER RE: DETAIL 06/A3.2.
 - DEALER SIGNAGE BY OWNER.
 - CURVED OVERHEAD CANOPY.
 - BELOW GRADE CONCRETE OIL CONTAINMENT.
 - BELOW GRADE TRUCK RAMP.
 - LOADING DOCK.
 - METAL HAND RAIL 3'-0" A.F.F.
 - SPANDREL GLASS.
 - PRE-FINISHED METAL LOUVER AND EXHAUST FAN, RE: MECHANICAL.

AN AUTOMOTIVE DEALERSHIP


ROGER BEASLEY VOLVO

INTERSTATE HIGHWAY 35 SOUTH
GEORGETOWN, TEXAS

EL SASSER
ARCHITECTURAL
INC.,
ARCHITECTURE AND PLANNING

P.O. BOX 650 GEORGETOWN, TX 78627
(512) 980-5551 FAX (512) 980-2618 www.elsasser.com

REV. #	DESCRIPTION	DATE
1	REVISED WINDOW AND COLUMN SIZES TO ACCOMMODATE PEB STEEL STRUCTURE	04/16/03
2		
3		
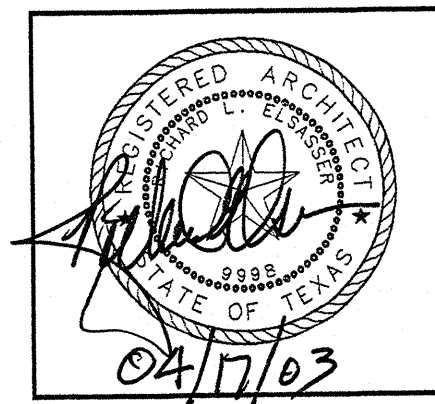

DATE:
09/18/02


PROJECT NO.
02008

SHEET NO.

A3.0


NOTES (ALL NOTES MAY NOT APPLY)

1. CONCRETE FOUNDATION SLAB, RE: STRUCTURAL.
2. CONCRETE FILLED PIPE BOLLARD.
3. CONCRETE FLOOR DECK ON METAL DECKING, RE: STRUCTURAL.
4. CONCRETE RETAINING WALL AT LOADING DOCK.
5. CONCRETE LOADING DOCK.
6. EIFS WALL SYSTEM AS SPECIFIED.
7. EIFS COLUMNS.
8. METAL PANEL, ROOF AS SPECIFIED.
9. METAL BUILDING PANEL.
10. METAL U PANEL.
11. METAL GUTTER AND DOWN SPOUT WITH SPLASH BLOCK BELOW.
12. INTERNAL METAL GUTTER (ALL SEAMS TO BE SOLDERED AT 30'-0").
13. F.E.B. FRAME BY METAL BUILDING MANUFACTURER.
14. WHITE VINYL-FACED R19 BATT INSULATION BETWEEN ROOF PERLIN AND F.E.B. FRAME.
15. STEEL BEAM, PROVIDED BY METAL BUILDING MANUFACTURER.
16. STRUCTURAL STEEL COLUMN, PROVIDED BY METAL BUILDING MANUFACTURER.
17. SUSPENDED CEILING AS SPECIFIED.
18. INSULATED STEEL OVERHEAD DOOR W/ INSULATED GLAZING PANEL, WHERE INDICATED AND AS SPECIFIED.
19. INSULATED HOLLOW METAL HAN DOOR PAINTED AS SCHEDULED.
20. ALUMINUM STOREFRONT GLAZING SYSTEM W/ CLEAR ANODIZED FRAMES AND 1" INSULATED GLAZING AS SPECIFIED.
21. PARAPET WALL BEYOND.
22. INTERNAL DOWNSPOUT.
23. C.M.U.
24. METAL HAND RAIL.
25. ROLL DOWN FIRE SHUTTER AS SPECIFIED.
26. OIL CONTAINMENT, RE: STRUCTURAL.
27. SATELLITE SUPPORT DECK, RE: A.T.O. FOR LOCATION 4 AND FOR DETAILS.
28. STOREFRONT FRAME WINDOW BEYOND.
29. METAL MAINSCOT PANEL ON NORTH AND SOUTH WALLS OF SERVICE DEPART. RE: DETAIL 06/A4.2, CONTINUE PAINTED STRIPE FROM ADJACENT C.M.U. WALL.
30. 8" PAINTED ACCENT STRIPE 4'-0" A.F.F., P-1.

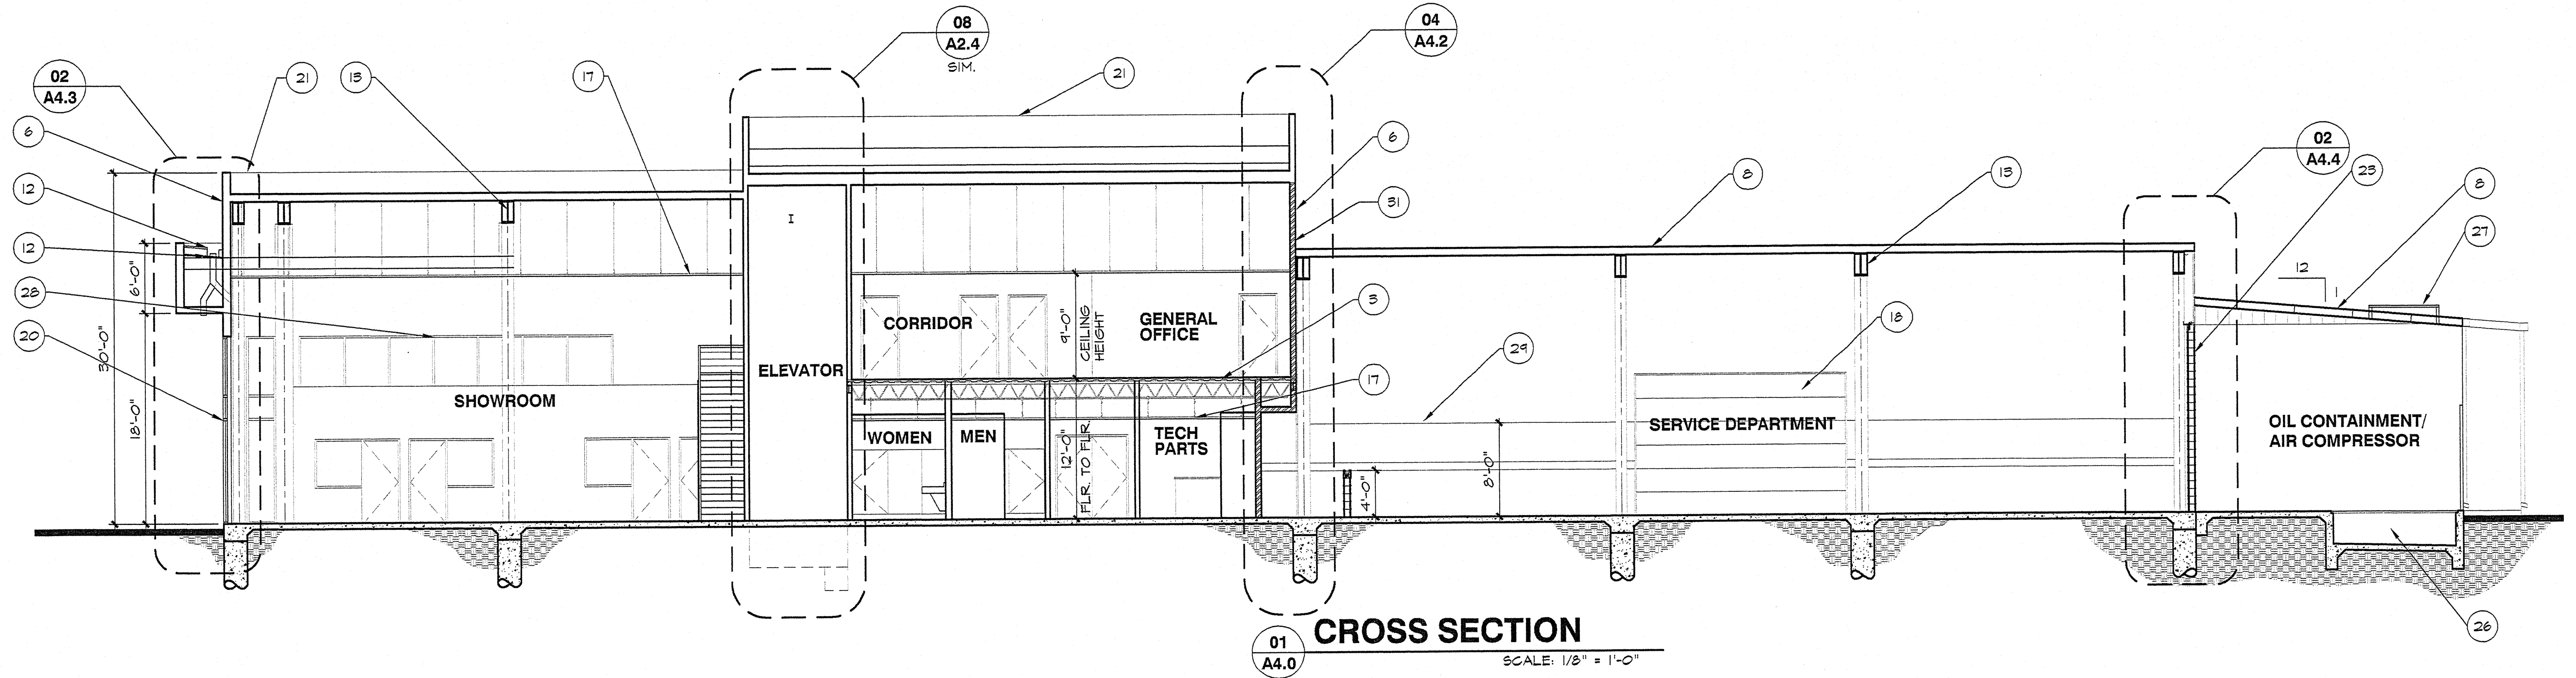


CROSS SECTION

SCALE: 1/8" = 1'-0"

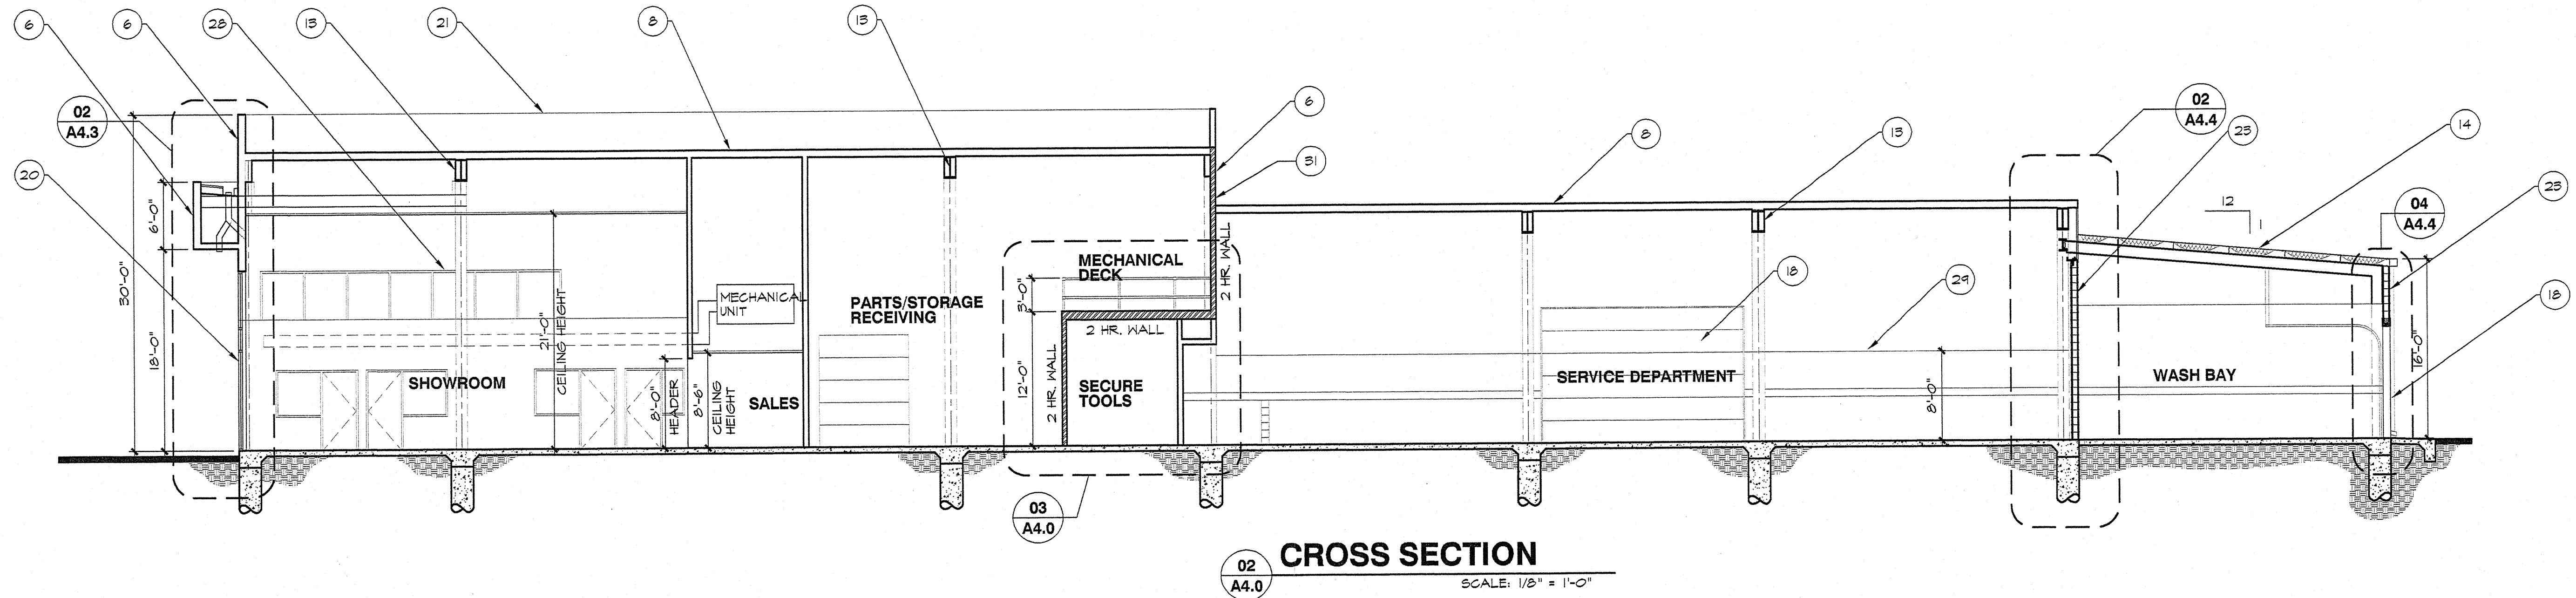

CROSS SECTION

SCALE: 1/8" = 1'-0"

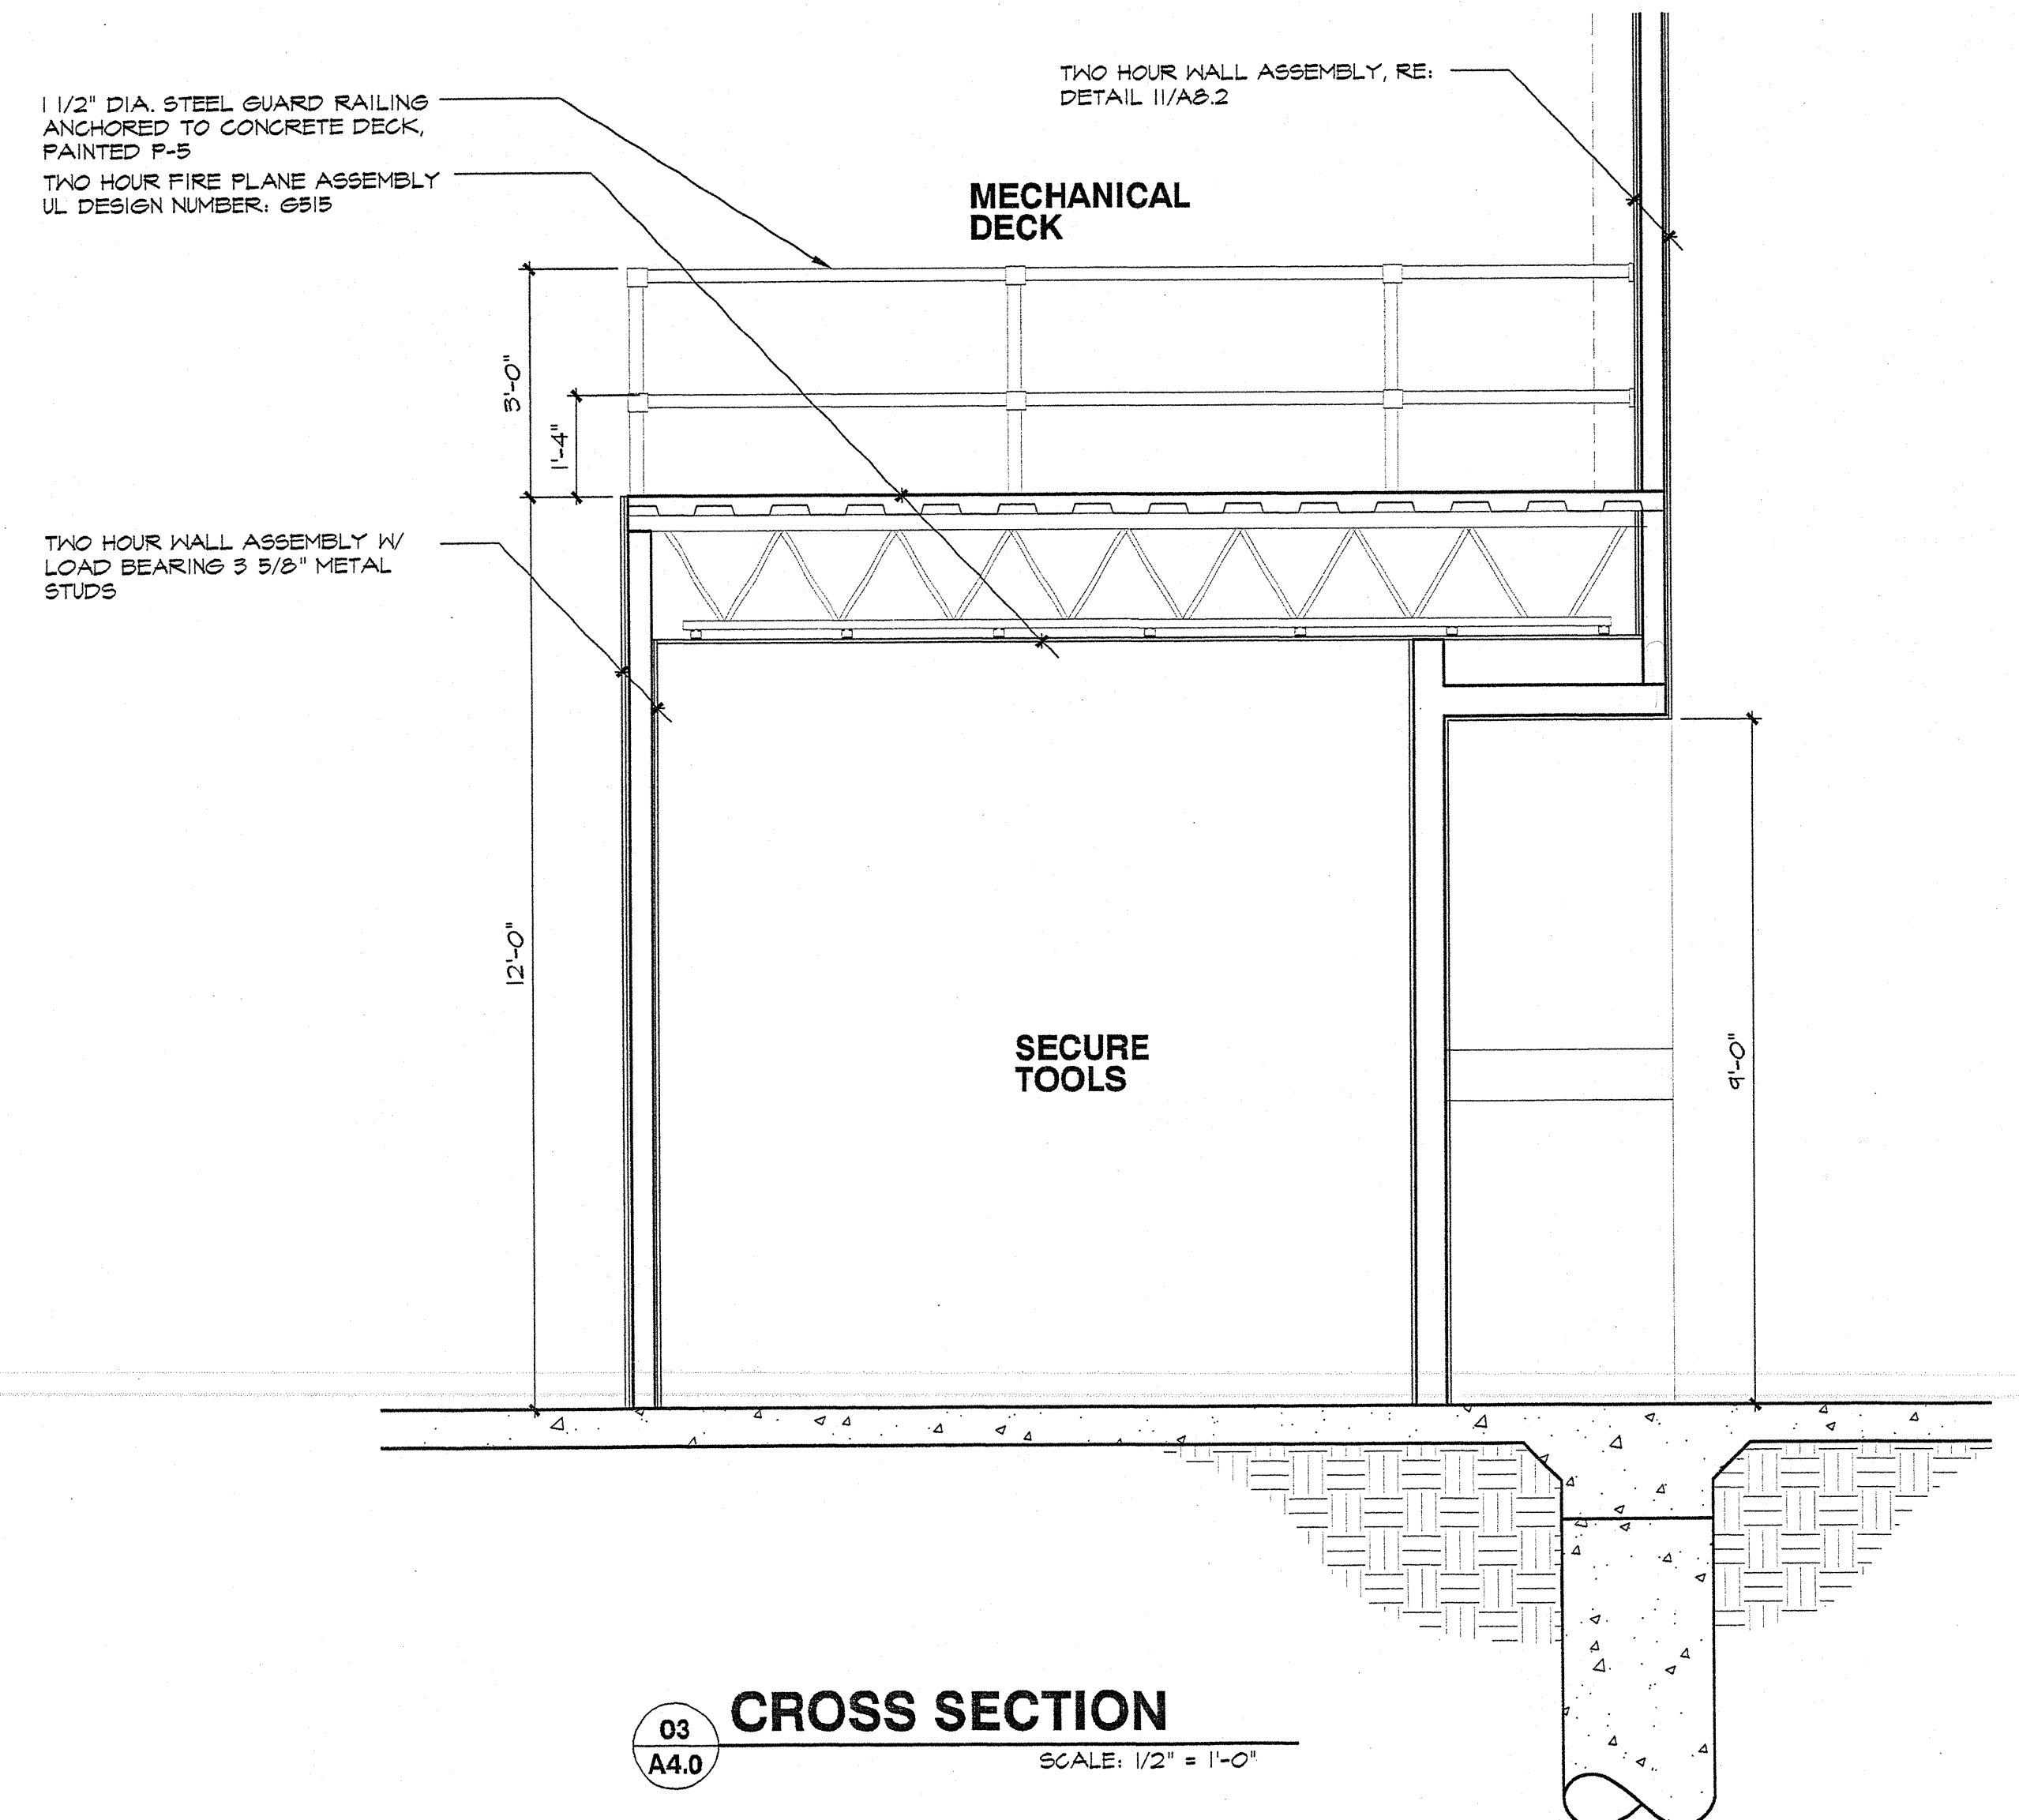

CROSS SECTION

SCALE: 1/2" = 1'-0"


AN AUTOMOTIVE DEALERSHIP

ROGER BEASLEY VOLVO

INTERSTATE HIGHWAY 35 SOUTH
GEORGETOWN, TEXAS

ELSASSER
ARCHITECTURAL
INC.
ARCHITECTURE AND PLANNING
P.O. BOX 853 GEORGETOWN, TX 78627
(512) 895-5553 FAX (512) 928-2818 www.elsa-h.com

CONSULTANT
INFORMATION:

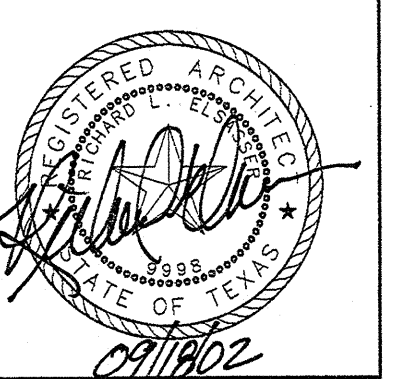

DATE:
09/18/02
REVISION DATE:




PROJECT NO.
02008
SHEET NO.

A4.0


NOTES (ALL NOTES MAY NOT APPLY)

1. CONCRETE FOUNDATION SLAB, RE: STR
2. CONCRETE FILLED PIPE BOLLARD
3. CONCRETE FLOOR DECK ON METAL DE
4. CONCRETE RETAINING WALL AT LOADI
5. CONCRETE LOADING DOCK
6. EIFS WALL SYSTEM AS SPECIFIED
7. EIFS COLUMNS
8. METAL PANEL, ROOF AS SPECIFIED
9. METAL BUILDING PANEL
10. METAL U PANEL
11. METAL GUTTER AND DOWN SPOUT KIT
12. INTERNAL METAL GUTTER (ALL SEAM
13. P.E.B. FRAME BY METAL BUILDING
14. WHITE VINYL-FACED R-4 BATT INSU
15. AND P.E.B. FRAME
16. STEEL BEAM, PROVIDED BY METAL
17. STRUCTURAL STEEL COLUMN, PRG
18. SUSPENDED CEILING AS SPECIFI
19. INSULATED STEEL OVERHEAD D
20. WHERE INDICATED, AND AS SPE
21. INSULATED HOLLOW METAL MA
22. ALUMINUM STOREFRONT GLAZI
23. AND 1" INSULATED GLAZING
24. PARAPET WALL BEYOND
25. INTERNAL DOWNSPOUT
26. C.M.U.
27. METAL HAND RAIL
28. ROLL DOWN FIRE SHUTTER
29. OIL CONTAINMENT, RE: ST
30. SATELLITE SUPPORT DECK
31. STOREFRONT FRAME KIT
32. METAL MAINSCOT PANE
33. SOUTH WALLS OF SERV
34. DETAIL 06/AB.2, CONT
35. STRIPE FROM ADJAC
36. 8" PAINTED ACCENT
37. 2-HOUR RATED WALL
38. MECHANICAL ACCE


KEYS NOT #32 IN SHEET 5/10/03

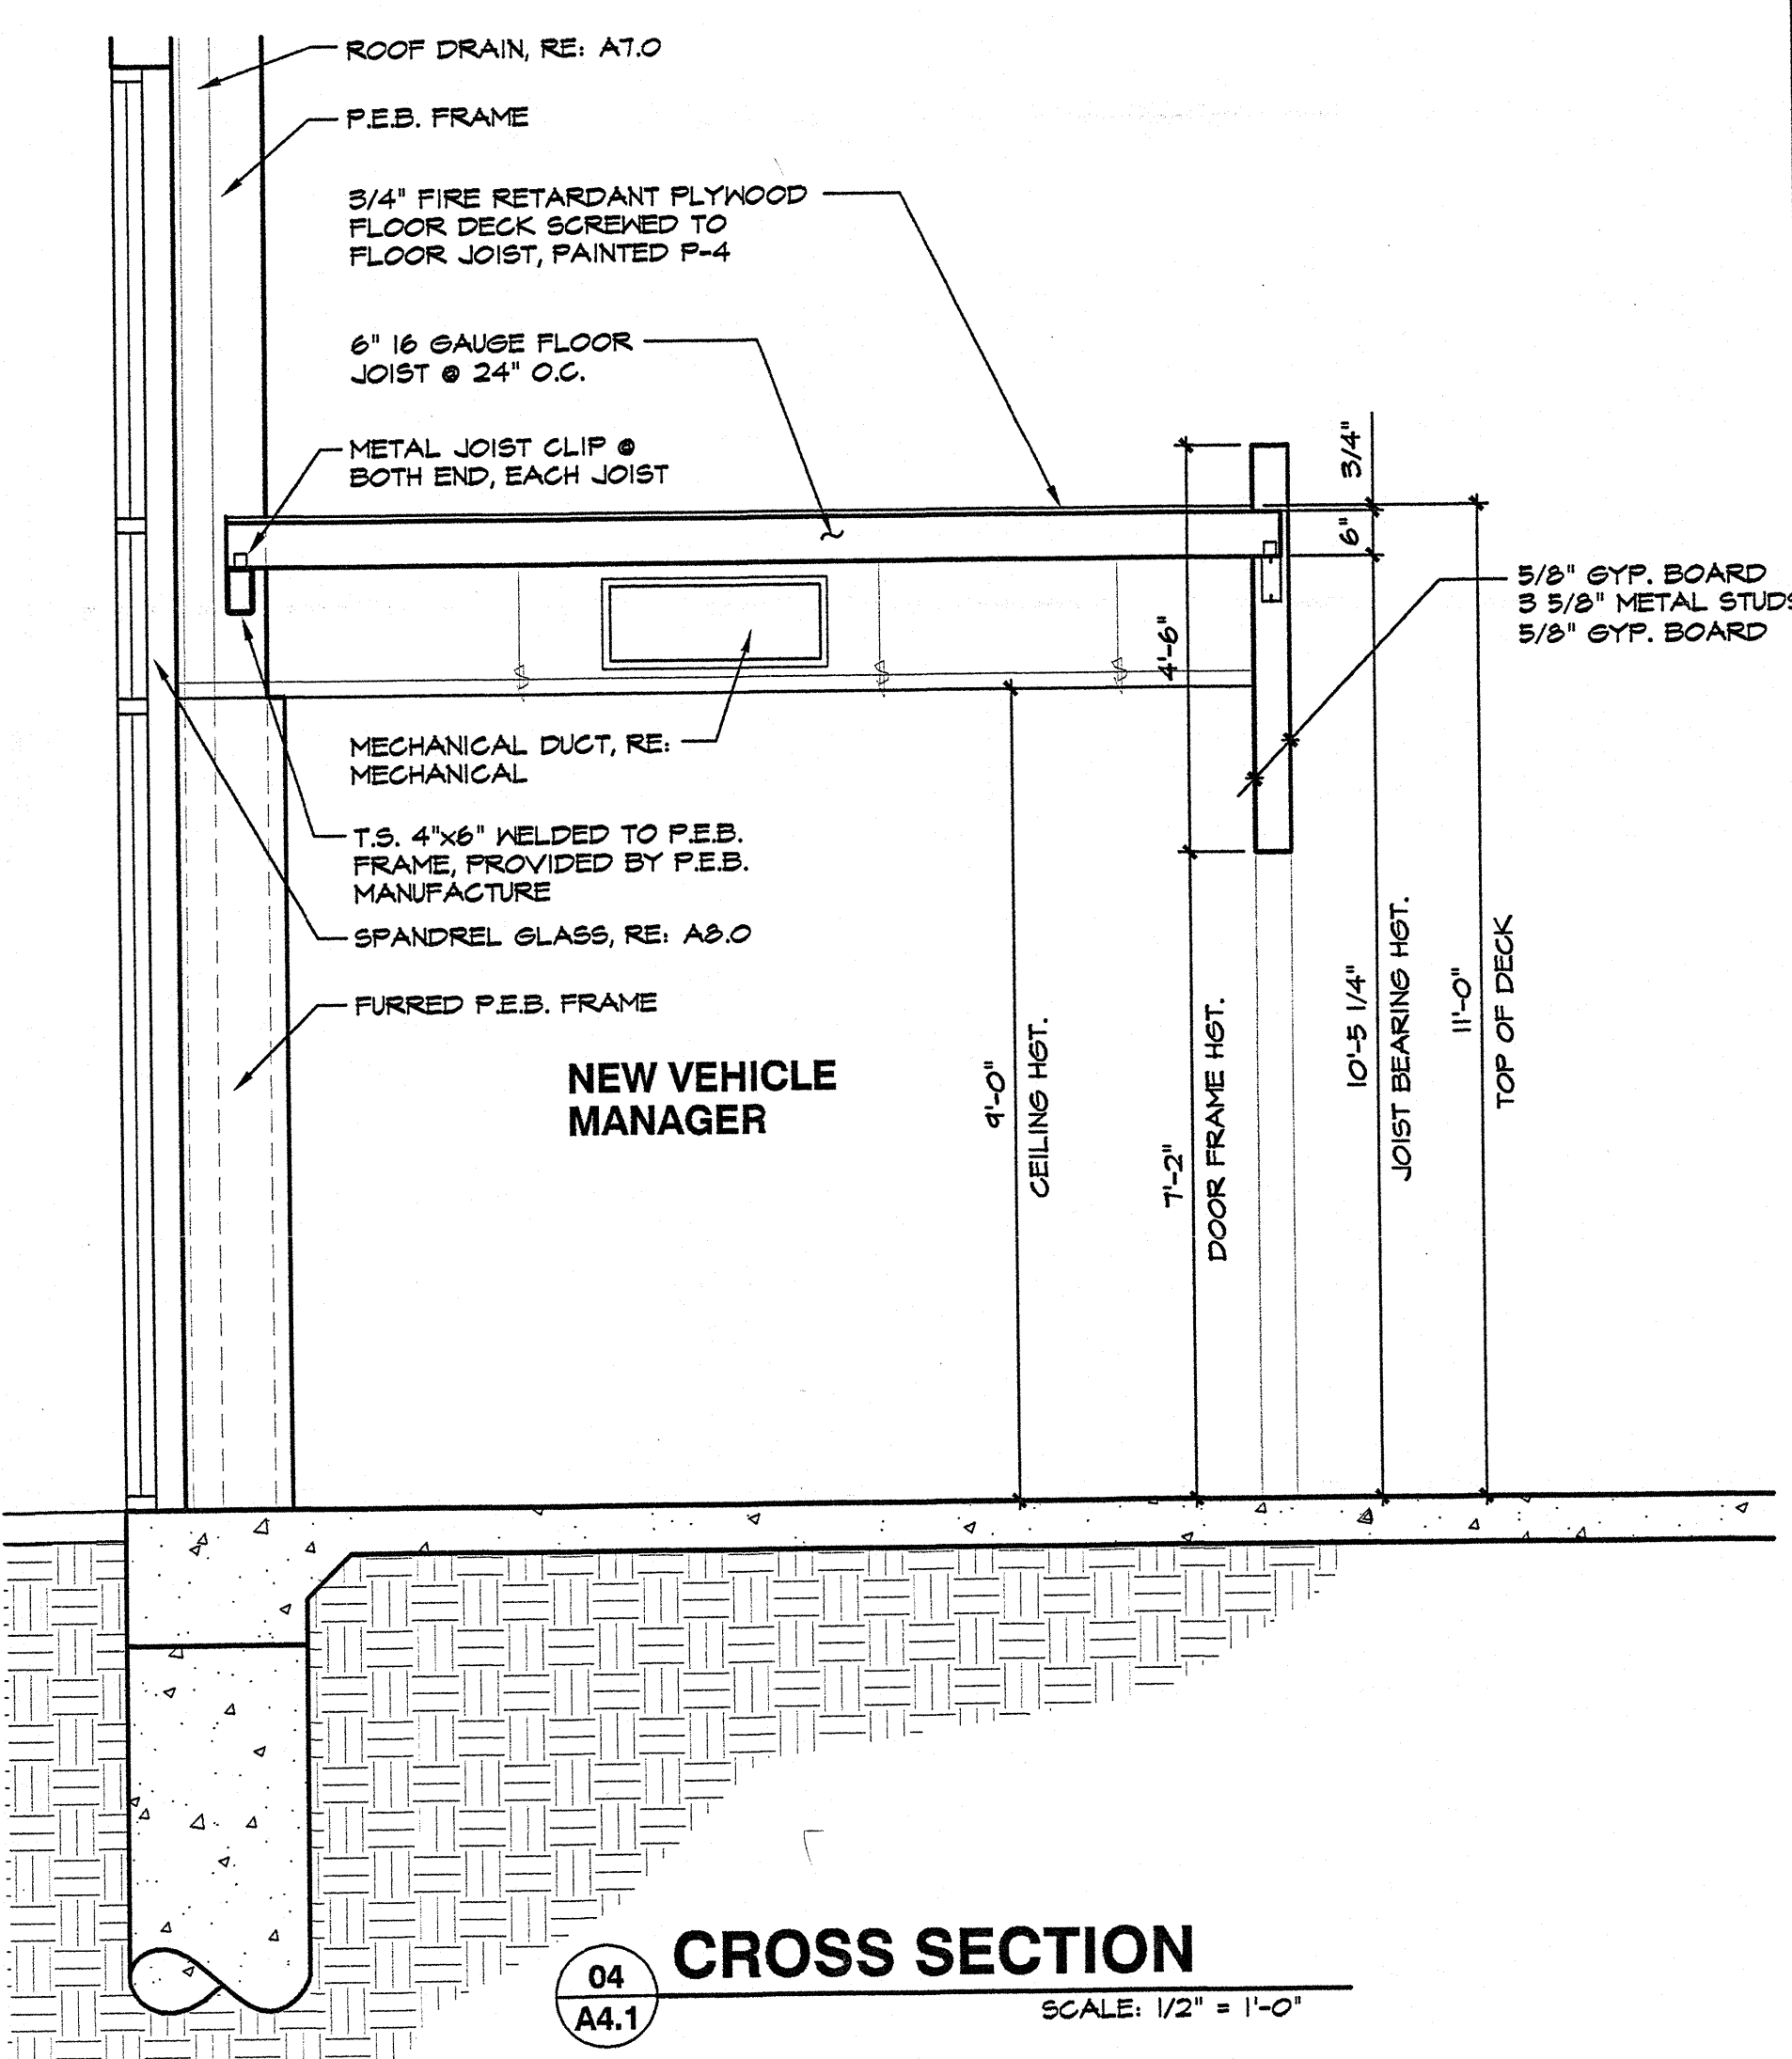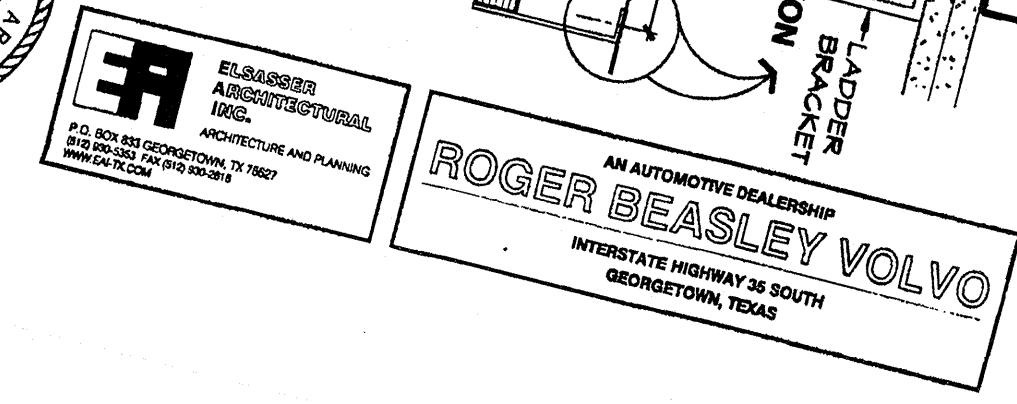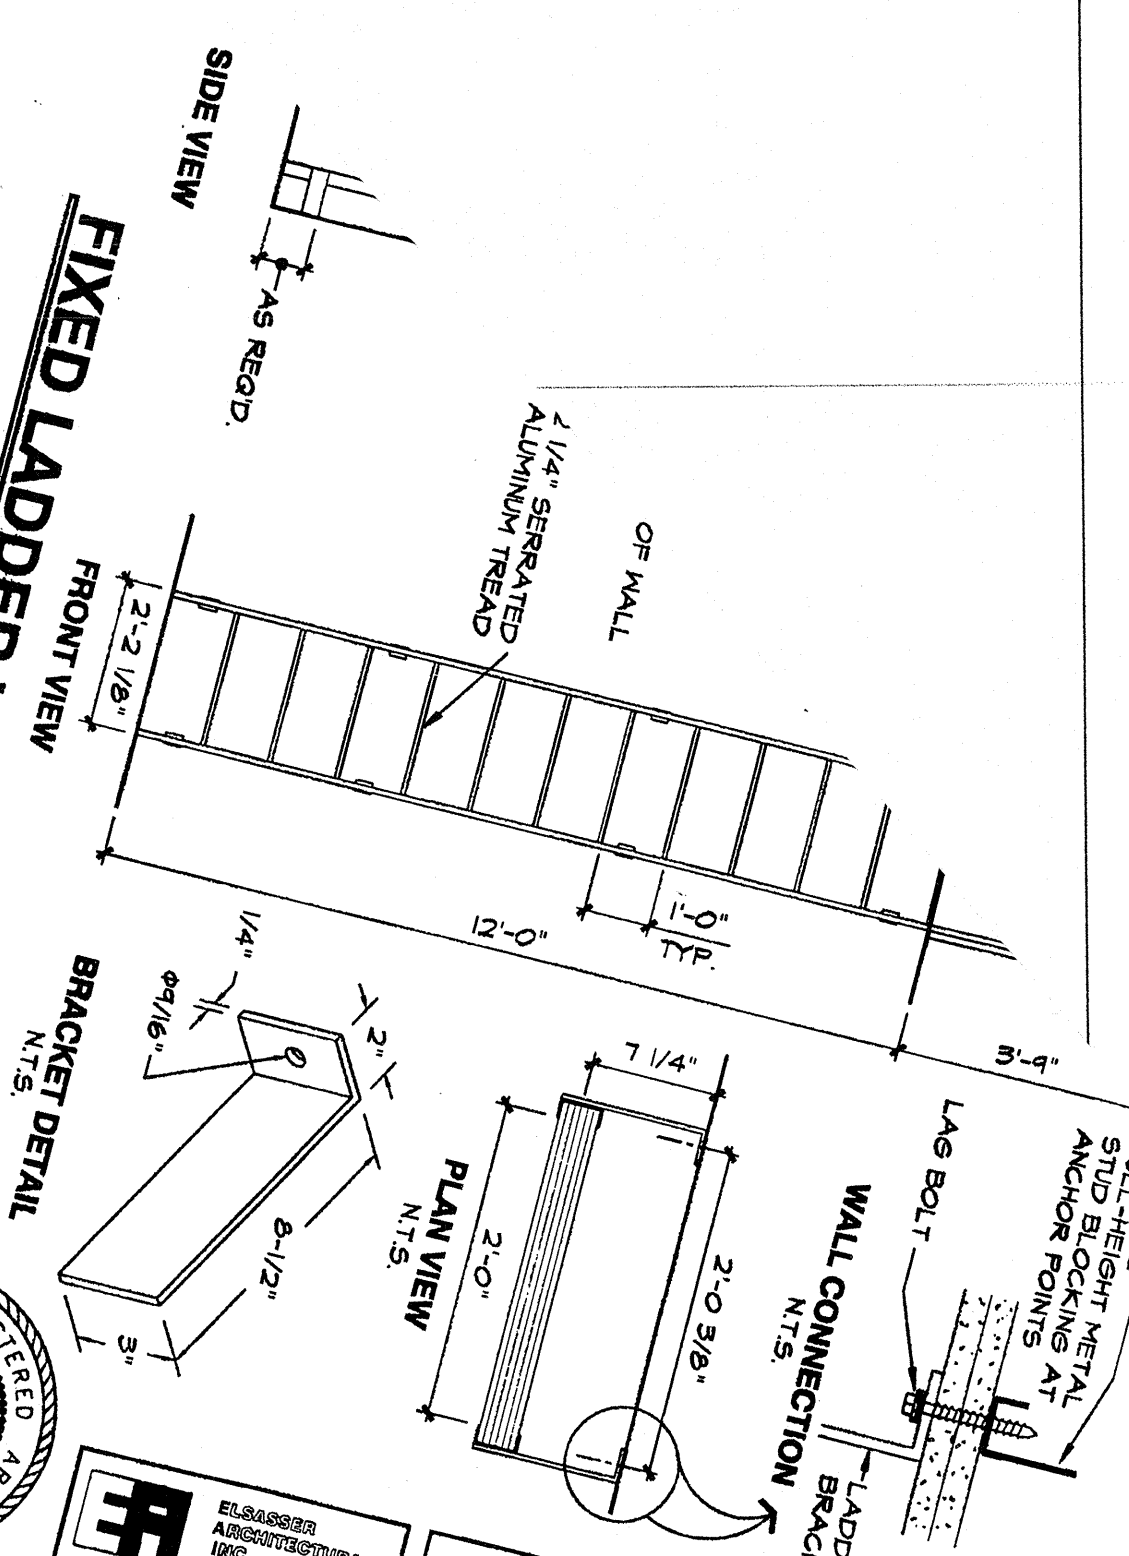


CROSS SECTION
SCALE: 1/2" = 1'-0"

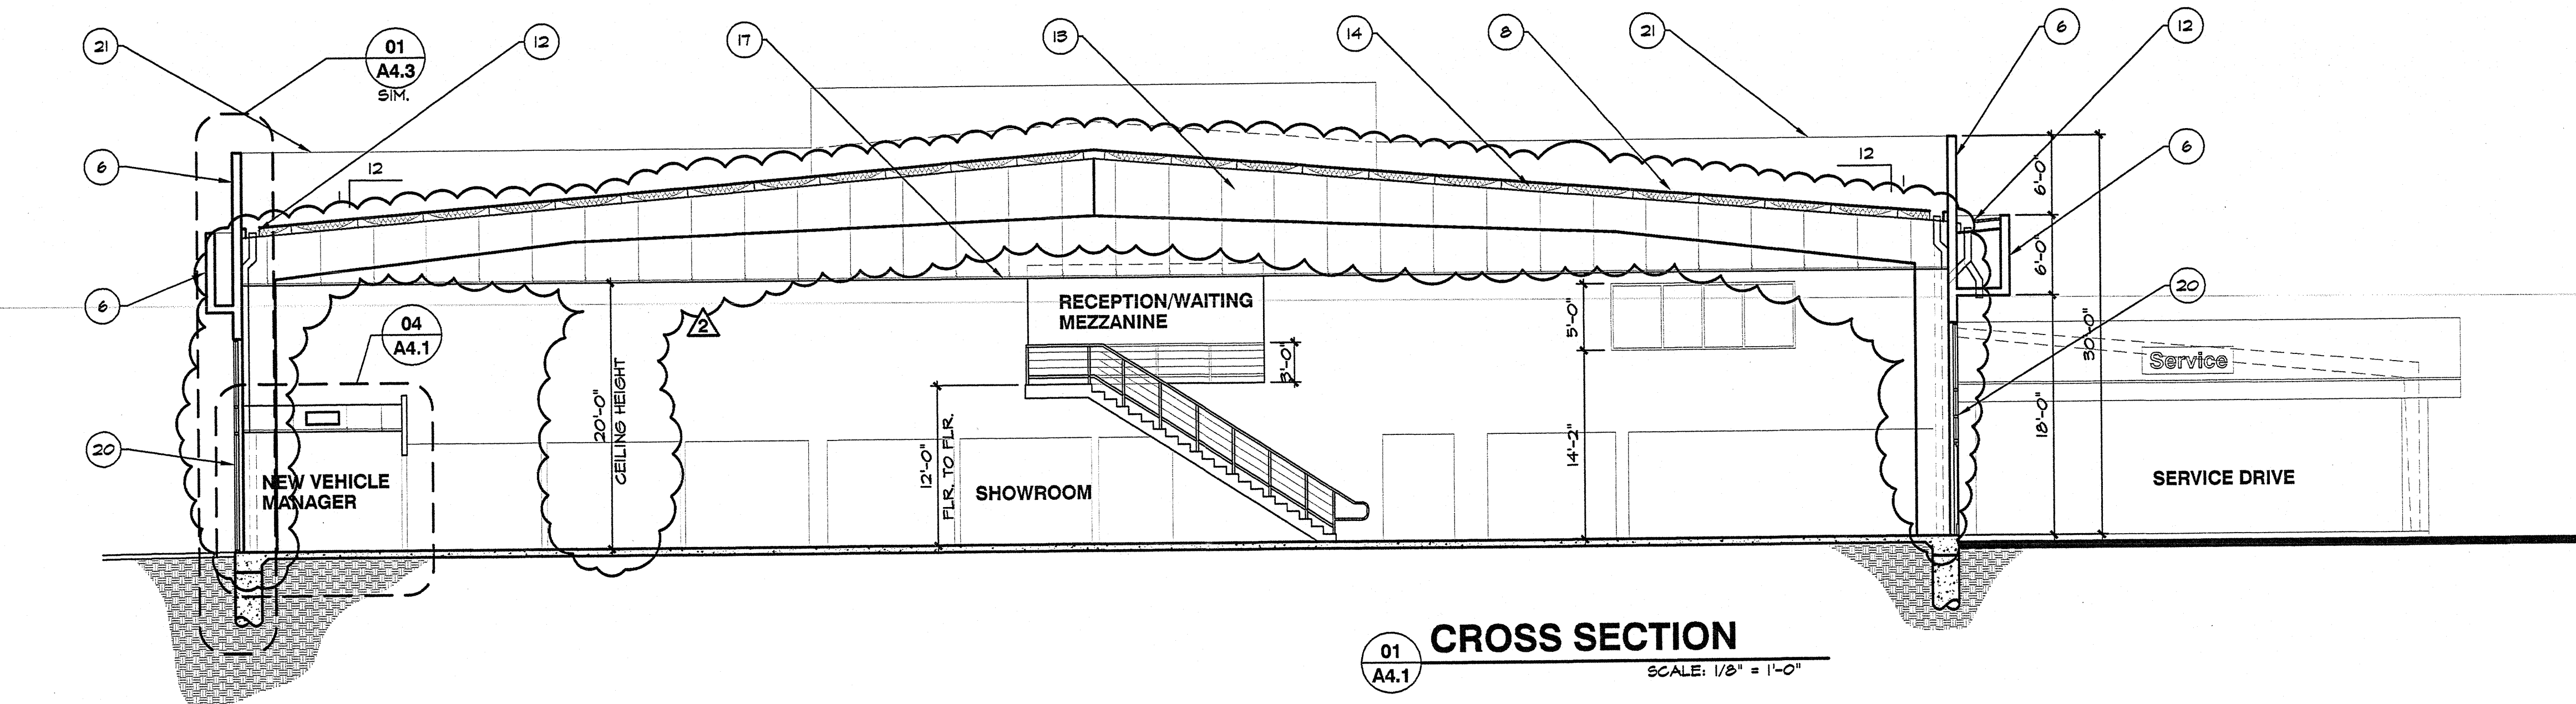


CROSS SECTION
SCALE: 1/8" = 1'-0"

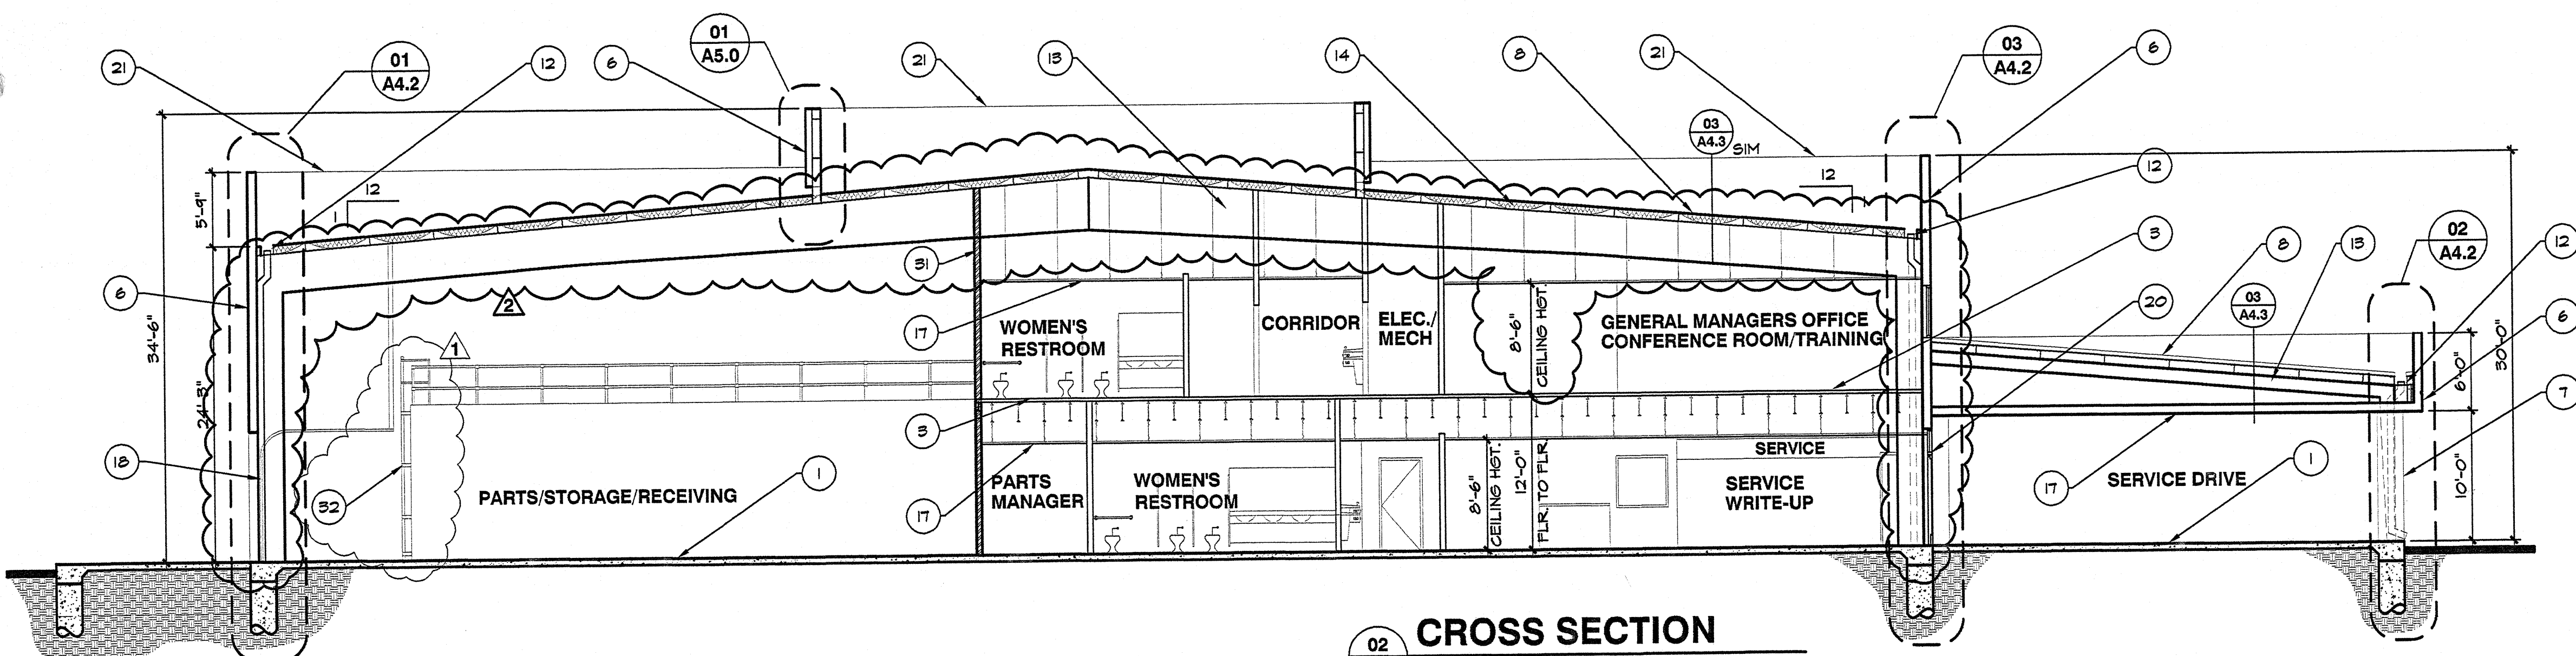

CROSS SECTION
SCALE: 1/8" = 1'-0"

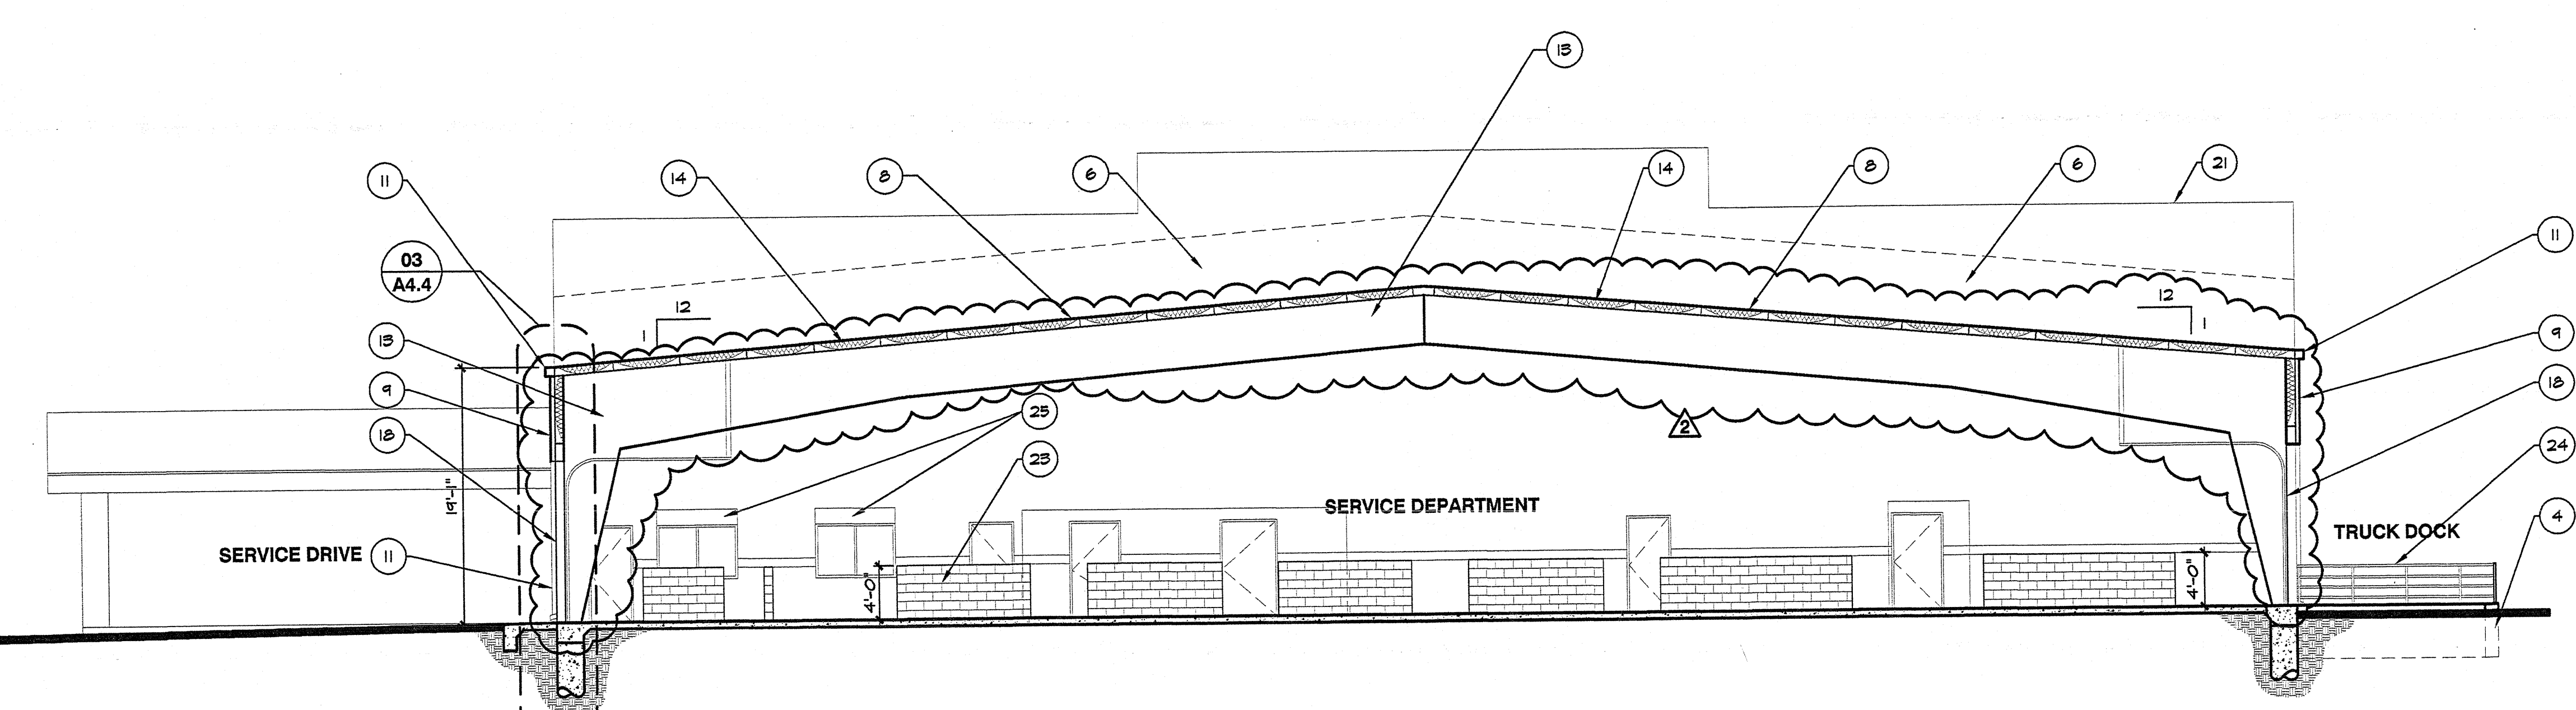

CROSS SECTION
SCALE: 1/8" = 1'-0"

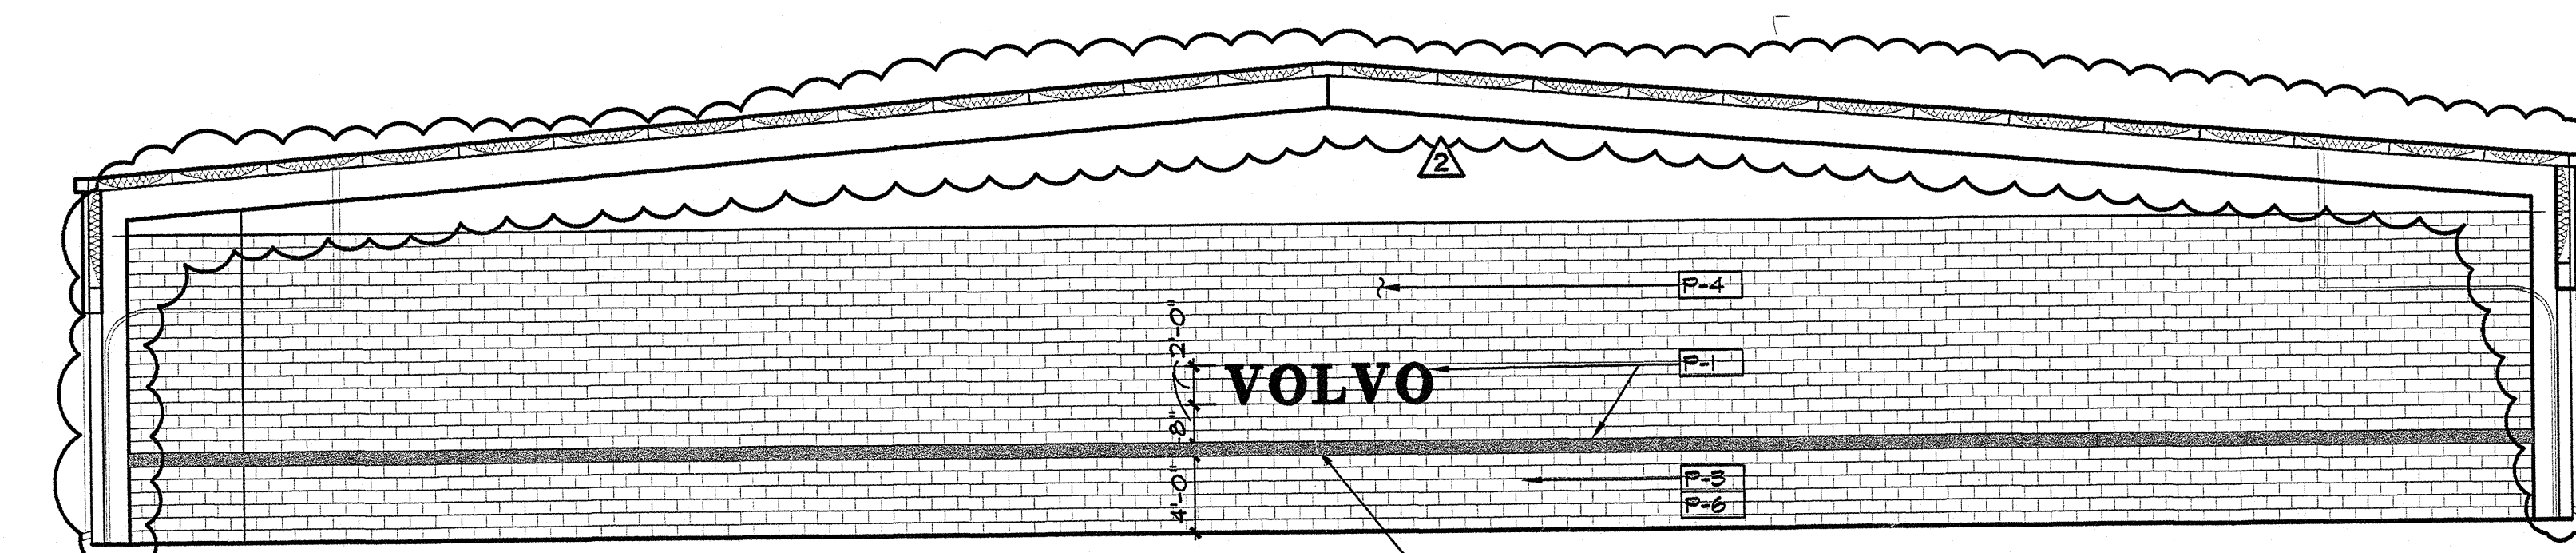

INTERIOR ELEVATION
SCALE: 1/8" = 1'-0"

LEGEND:
P-6 FINISH KEY, RE: A8.3 FOR SPECIFICATIONS

- NOTES:
1. SERVICE REPAIR AREA AND WASH BAY AREA WALL GRAPHICS TO CONSIST OF LOGO AND COLOR BAND PAINTED DIRECTLY ON WALL SURFACE.
 2. POSITION LOGO CENTERED LEFT TO RIGHT ON WALL SURFACE


AN AUTOMOTIVE DEALERSHIP
ROGER BEASLEY VOLVO

INTERSTATE HIGHWAY 35 SOUTH
GEORGETOWN, TEXAS

ELISSER ARCHITECTURAL INC.
ARCHITECTURE AND PLANNING

P.O. BOX 833 GEORGETOWN, TX 78627
(512) 850-5553 FAX (512) 850-5818 www.eai-h.com

REV. #	DESCRIPTION	DATE
1	ADDED MECHANICAL DECK ACCESS LADDER	1/19/02
2	REVISED COLUMN SIZES AND CEILING HEIGHTS	4/18/03





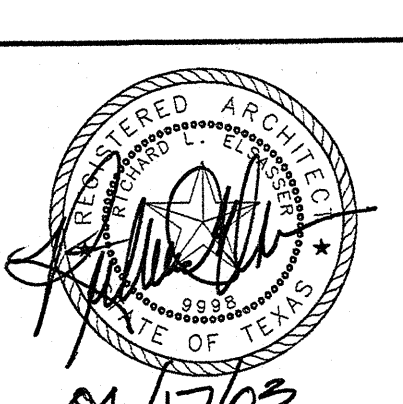


DATE: 09/18/02
PROJECT NO. 02008
SHEET NO.

A4.1

NOTES (ALL NOTES MAY NOT APPLY)

1. CONCRETE FOUNDATION SLAB; RE: STRUCTURAL.
2. CONCRETE FILLED PIPE BOLLARD.
3. CONCRETE FLOOR DECK ON METAL DECKING; RE: STRUCTURAL.
4. CONCRETE RETAINING WALL AT LOADING DOCK.
5. CONCRETE LOADING DOCK.
6. EIFS WALL SYSTEM AS SPECIFIED.
7. EIFS COLUMNS.
8. METAL PANEL ROOF AS SPECIFIED.
9. METAL BUILDING PANEL.
10. METAL U PANEL.
11. METAL GUTTER AND DOWN SPOUT WITH SPLASH BLOCK BELOW.
12. INTERNAL METAL GUTTER (ALL SEAMS TO BE SOLDERED AT 30'-0").
13. P.E.B. FRAME BY METAL BUILDING MANUFACTURER.
14. WHITE VINYL-FACED R19 BATT INSULATION BETWEEN ROOF FERLIN AND P.E.B. FRAME.
15. STEEL BEAM PROVIDED BY METAL BUILDING MANUFACTURER.
16. STRUCTURAL STEEL COLUMN PROVIDED BY METAL BUILDING MANUFACTURER.
17. SUSPENDED CEILING AS SPECIFIED.
18. INSULATED STEEL OVERHEAD DOOR W/ INSULATED GLAZING PANEL WHERE INDICATED AND AS SPECIFIED.
19. INSULATED HOLLOW METAL W/ DOOR PAINTED AS SCHEDULED.
20. ALUMINUM STOREFRONT GLAZING SYSTEM W/ CLEAR ANODIZED FRAMES AND 1" INSULATED GLAZING AS SPECIFIED, SEE SHEET A8.0.
21. PARAPET WALL BEYOND.
22. INTERNAL DOWNSPOUT.
23. C.M.U.
24. METAL HAND RAIL.
25. ROLL DOWN FIRE SHUTTER AS SPECIFIED.
26. OIL CONTAINMENT, RE: STRUCTURAL.
27. SATELLITE SUPPORT DECK, RE: A7.0 FOR LOCATION & A8.0 FOR DETAILS.
28. STOREFRONT FRAME WINDOW BEYOND.
29. METAL MAINSCOT PANEL ON NORTH AND SOUTH WALLS OF SERVICE DEPART. RE: DETAIL 06/A8.2. CONTINUE PAINTED STRIPE FROM ADJACENT CMU WALL.
30. 8" PAINTED ACCENT STRIPE 4'-0" A.F.F., P.
31. 24" RATED WALL RE: A2.0.
32. MECHANICAL ACCESS LADDER.

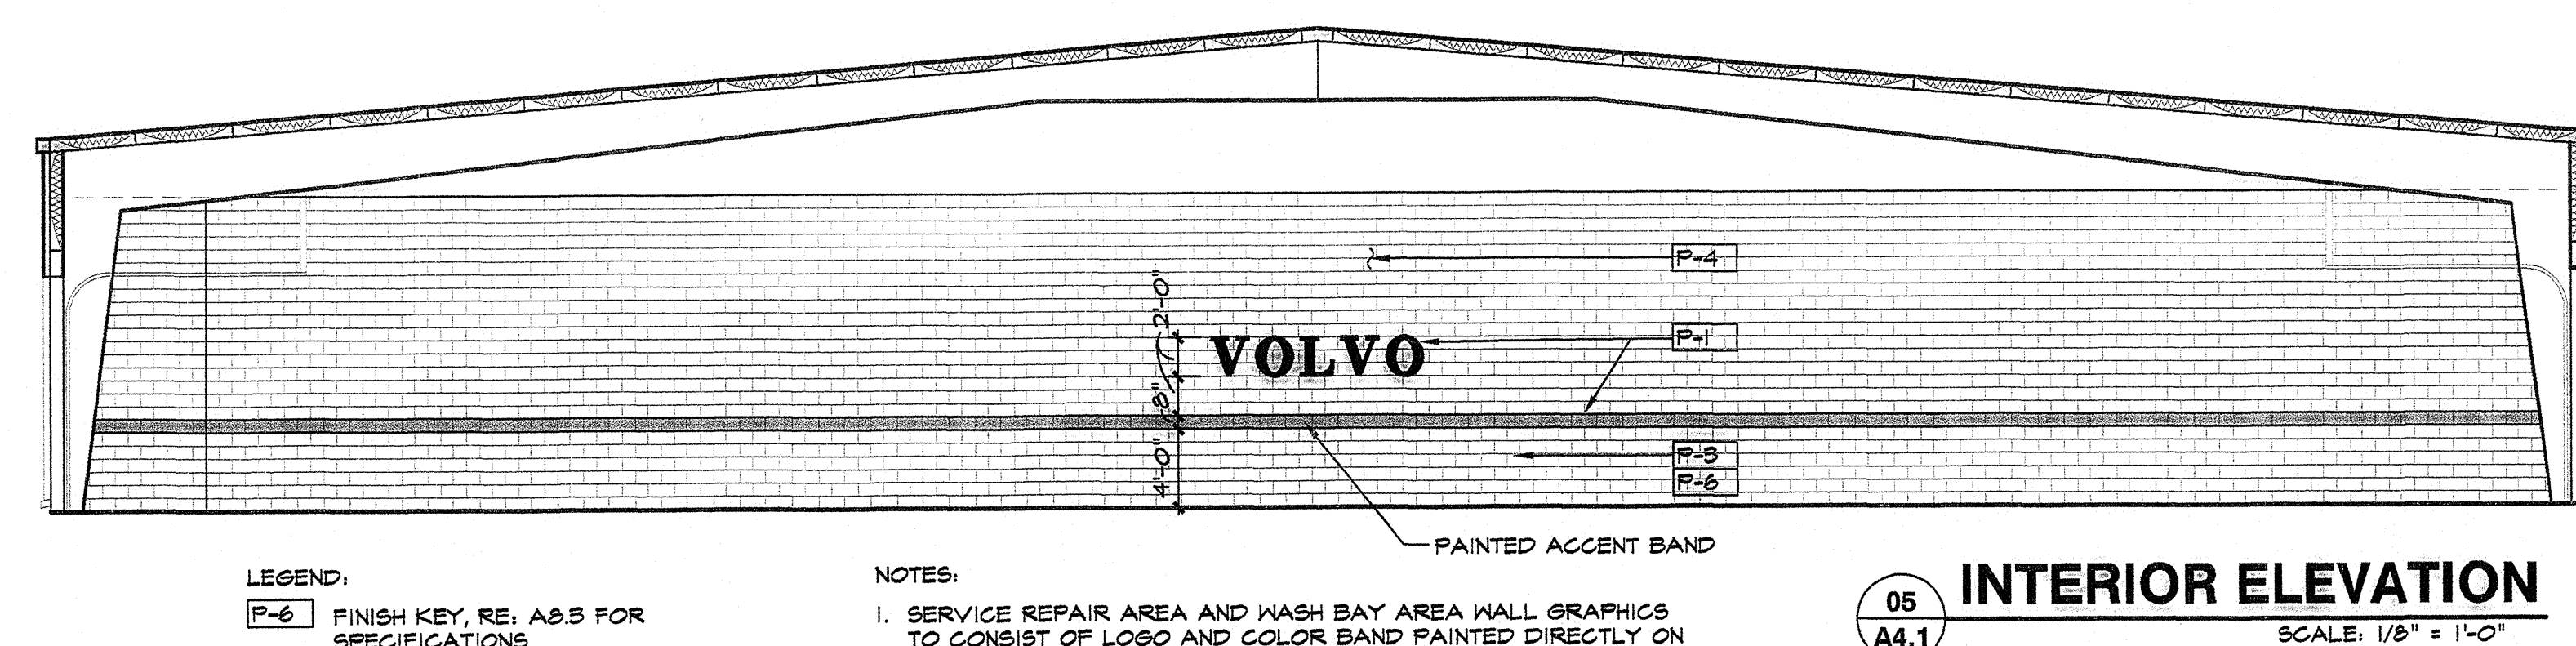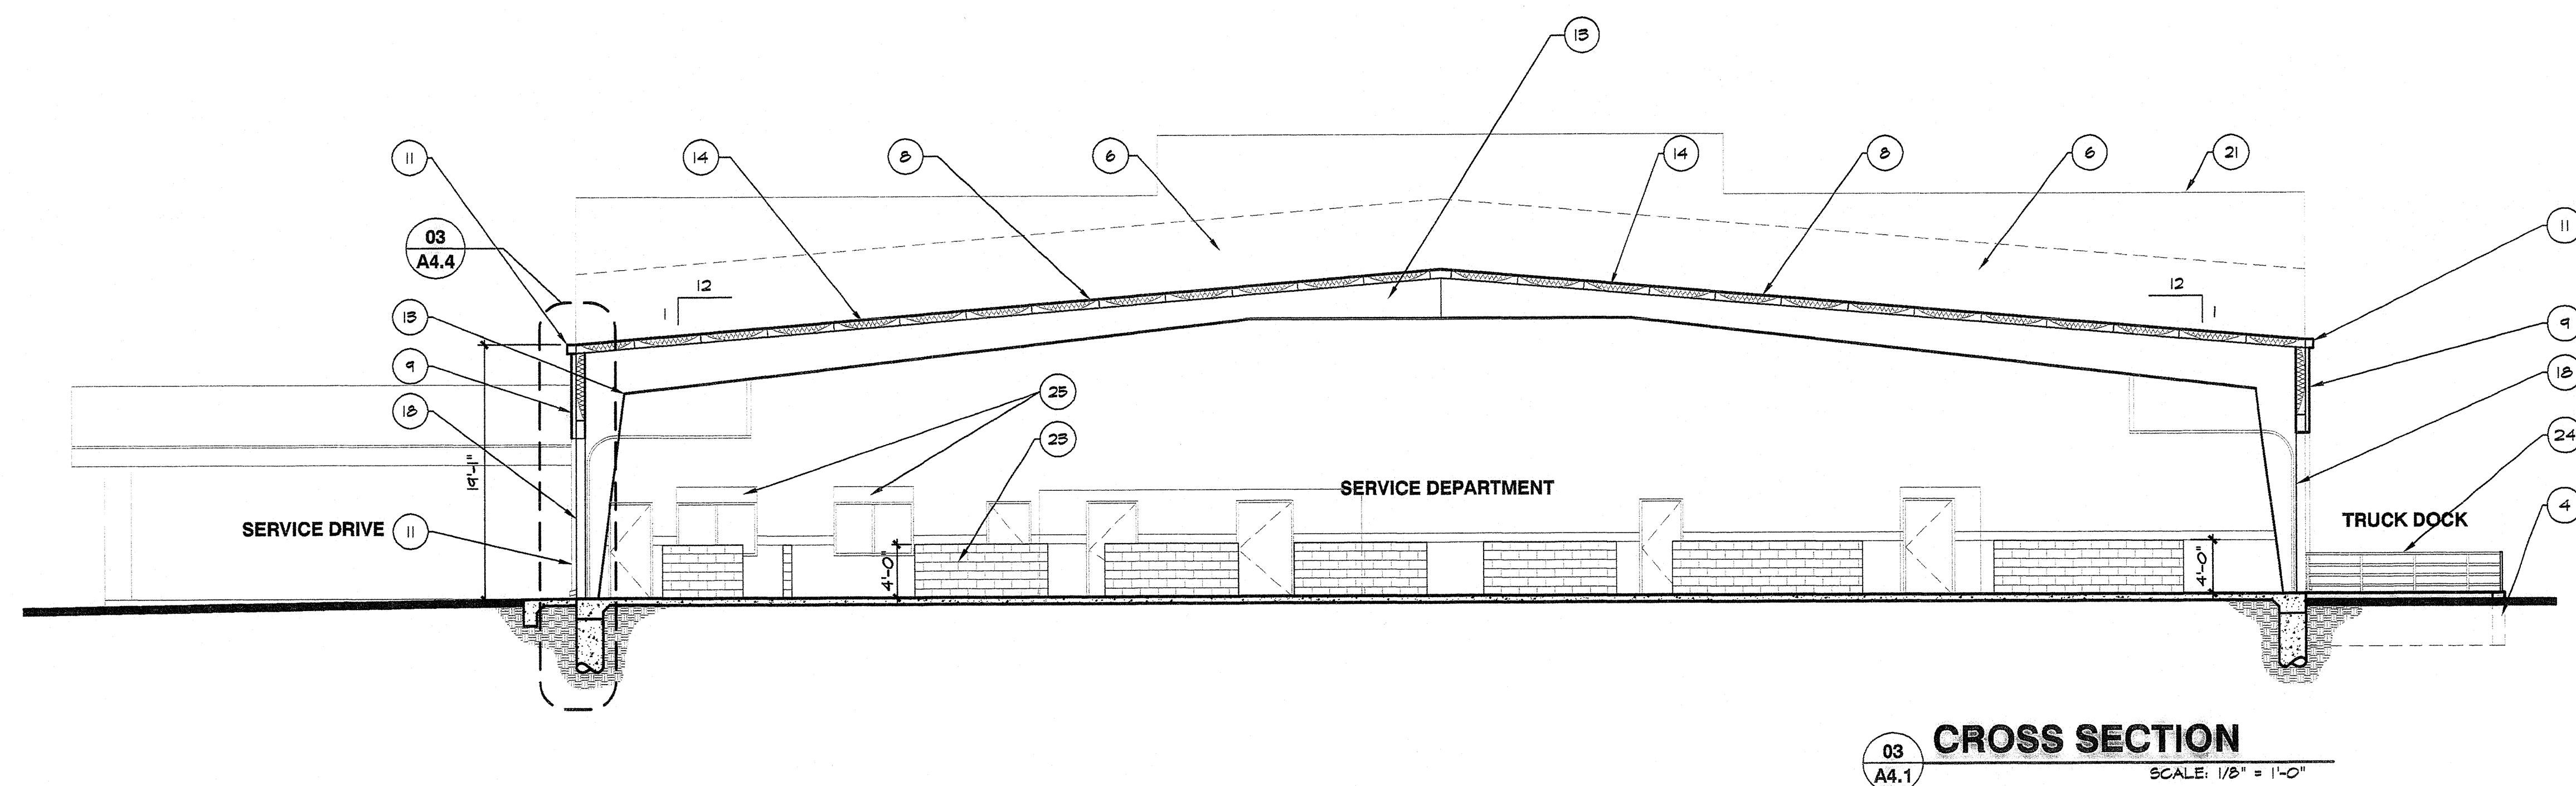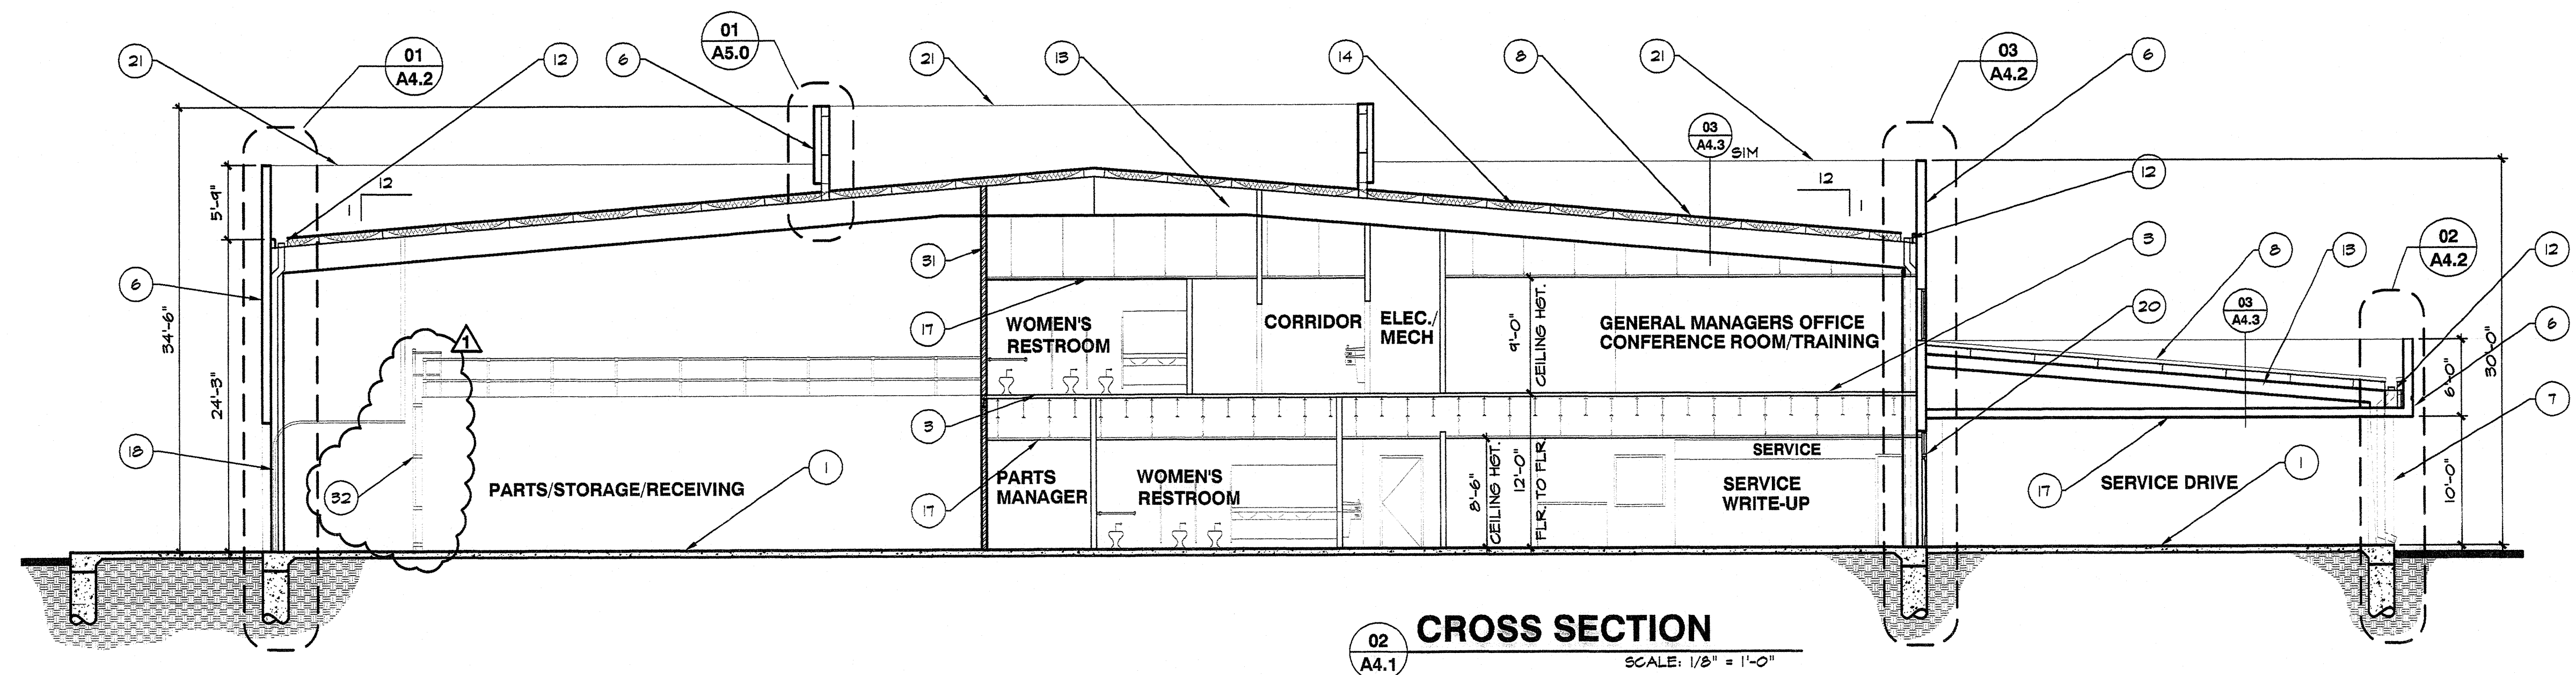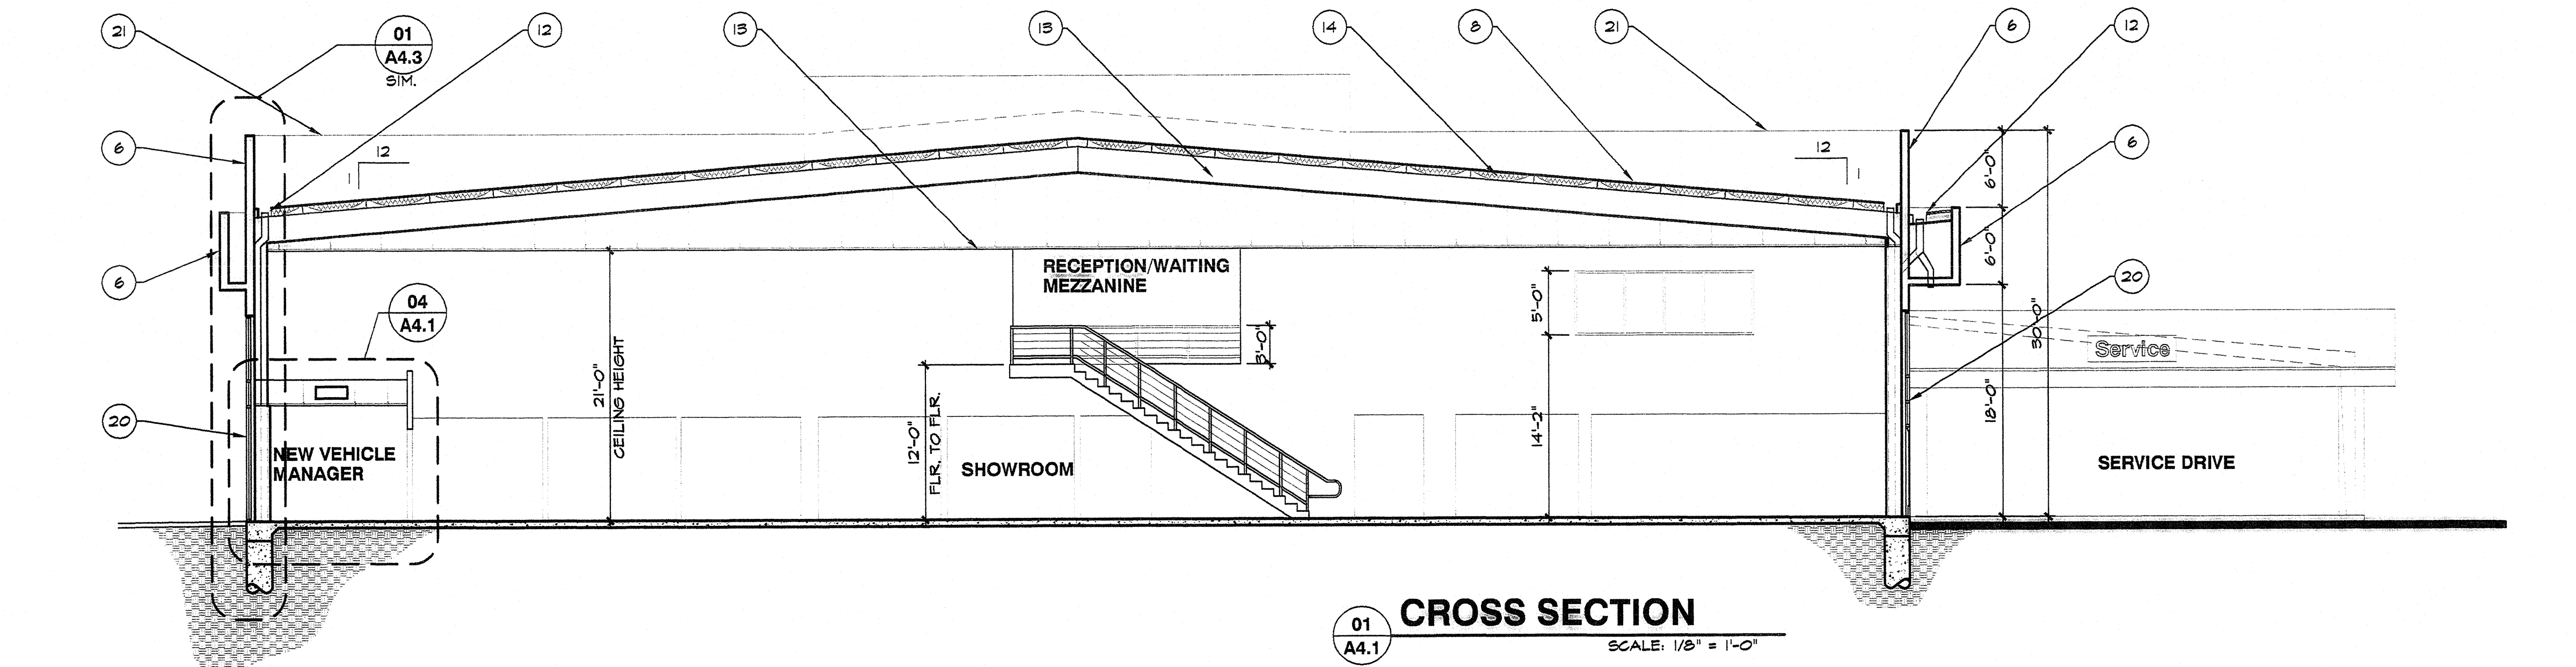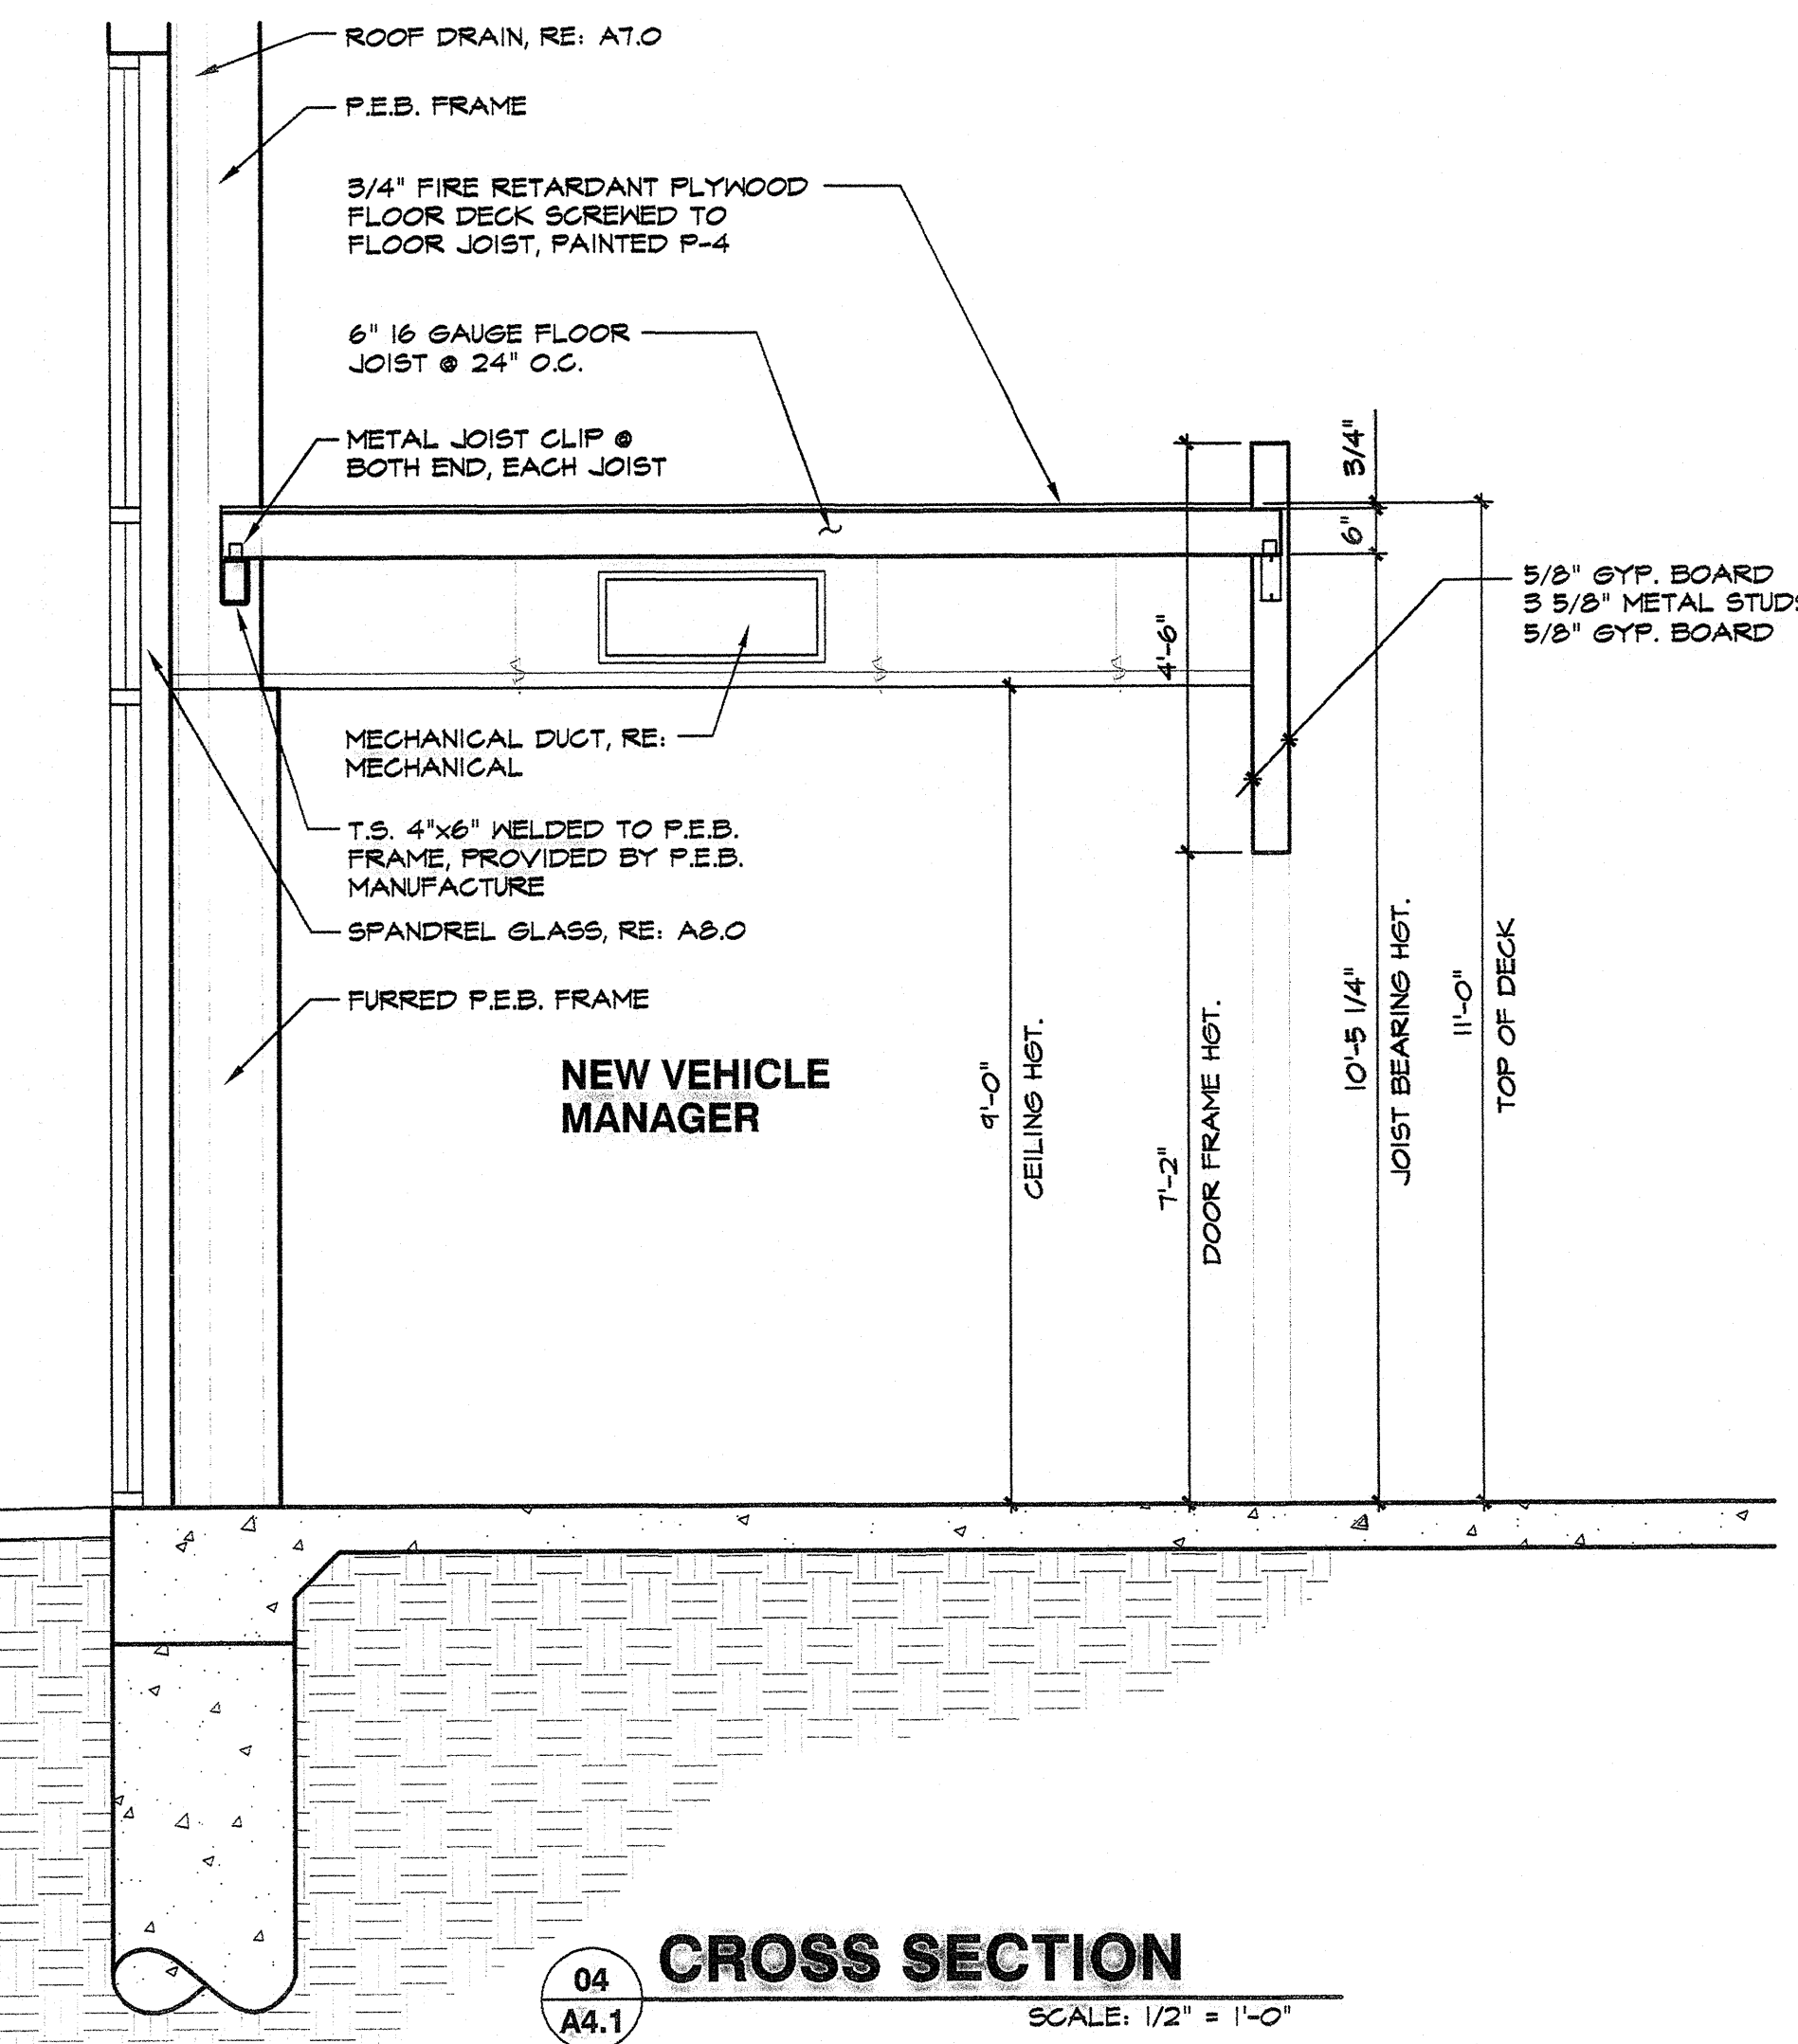

LEGEND:
P-6 FINISH KEY, RE: A8.3 FOR SPECIFICATIONS


- NOTES:
1. SERVICE REPAIR AREA AND WASH BAY AREA WALL GRAPHICS TO CONSIST OF LOGO AND COLOR BAND PAINTED DIRECTLY ON WALL SURFACE.
 2. POSITION LOGO CENTERED LEFT TO RIGHT ON WALL SURFACE

AN AUTOMOTIVE DEALERSHIP
ROGER BEASLEY VOLVO

INTERSTATE HIGHWAY 35 SOUTH
GEORGETOWN, TEXAS

ELIASER
ARCHITECTURAL
INC.
P.O. BOX 833 GEORGETOWN TX 78627
(512) 580-5553 FAX (512) 580-5518 www.eah-inc.com






REV #	DESCRIPTION	DATE
1	ADDED MECHANICAL DECK ACCESS LADDER	1/19/02

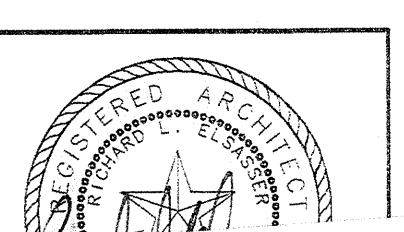

SEE
REVISED

NOTES (ALL NOTES MAY NOT APPLY)

1. CONCRETE FOUNDATION SLAB, RE: STRUCTURAL.
2. CONCRETE FILLED PIPE BOLLARD.
3. CONCRETE FLOOR DECK ON METAL DECKING, RE: STRUCTURAL.
4. CONCRETE RETAINING WALL AT LOADING DOCK.
5. CONCRETE LOADING DOCK.
6. EIFS WALL SYSTEM AS SPECIFIED.
7. EIFS COLUMNS.
8. METAL PANEL ROOF AS SPECIFIED.
9. METAL BUILDING PANEL.
10. METAL U PANEL.
11. METAL GUTTER AND DOWN SPOUT WITH SPLASH BLOCK BELOW.
12. INTERNAL METAL GUTTER (ALL SEAMS TO BE SOLDERED AT 20'-0").
13. P.E.B. FRAME BY METAL BUILDING MANUFACTURER.
14. WHITE VINYL-FACED R19 BATT INSULATION BETWEEN ROOF PERLIN AND P.E.B. FRAME.
15. STEEL BEAM, PROVIDED BY METAL BUILDING MANUFACTURER.
16. STRUCTURAL STEEL COLUMN, PROVIDED BY METAL BUILDING MANUFACTURER.
17. SUSPENDED CEILING AS SPECIFIED.
18. INSULATED STEEL OVERHEAD DOOR W/ INSULATED GLAZING PANEL WHERE INDICATED AND AS SPECIFIED.
19. INSULATED HOLLOW METAL MAIN DOOR PAINTED AS SCHEDULED.
20. ALUMINUM STOREFRONT GLAZING SYSTEM W/ CLEAR ANODIZED FRAMES AND 1" INSULATED GLAZING AS SPECIFIED, SEE SHEET A5.0.
21. PARAPET WALL BEYOND.
22. INTERNAL DOWNSPOUT.
23. C.M.U.
24. METAL HAND RAIL.
25. ROLL DOWN FIRE SHUTTER AS SPECIFIED.
26. OIL CONTAINMENT, RE: STRUCTURAL.
27. SATELLITE SUPPORT DECK, RE: A7.0 FOR LOCATION & A5.0 FOR DETAILS.
28. STOREFRONT FRAME WINDOW BEYOND.
29. METAL KAINSCOT PANEL ON NORTH AND SOUTH WALLS OF SERVICE DEPART. RE: DETAIL 06/A5.2, CONTINUE PAINTED STRIPE FROM ADJACENT CMU WALL.
30. 8" PAINTED ACCENT STRIPE 4'-0" A.F.F., P-1.
31. 2 HOUR RATED WALL RE: A2.0.

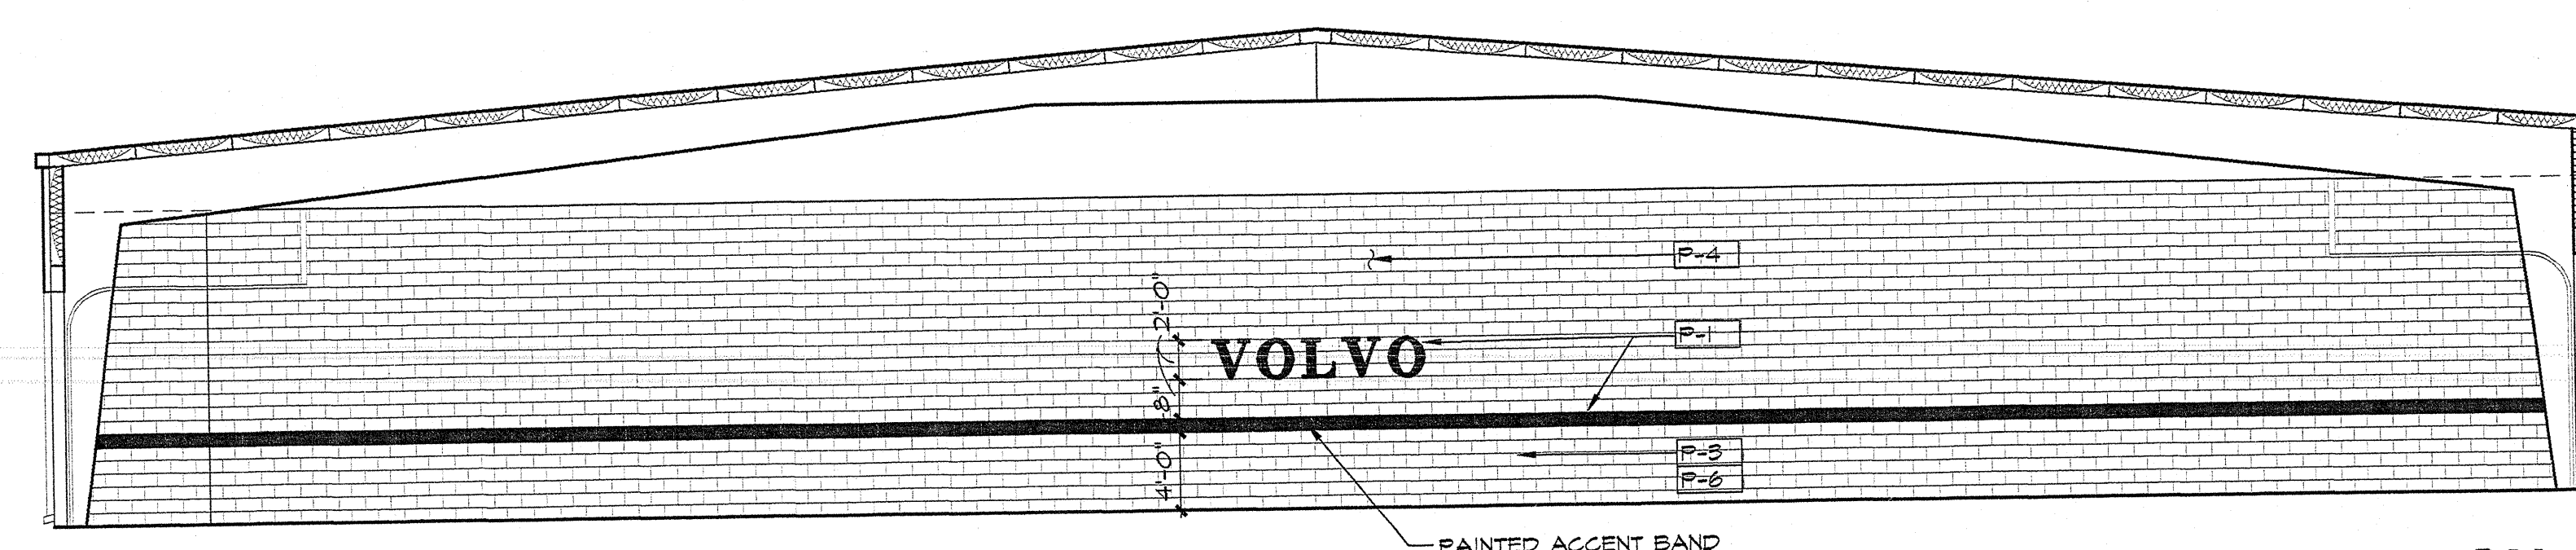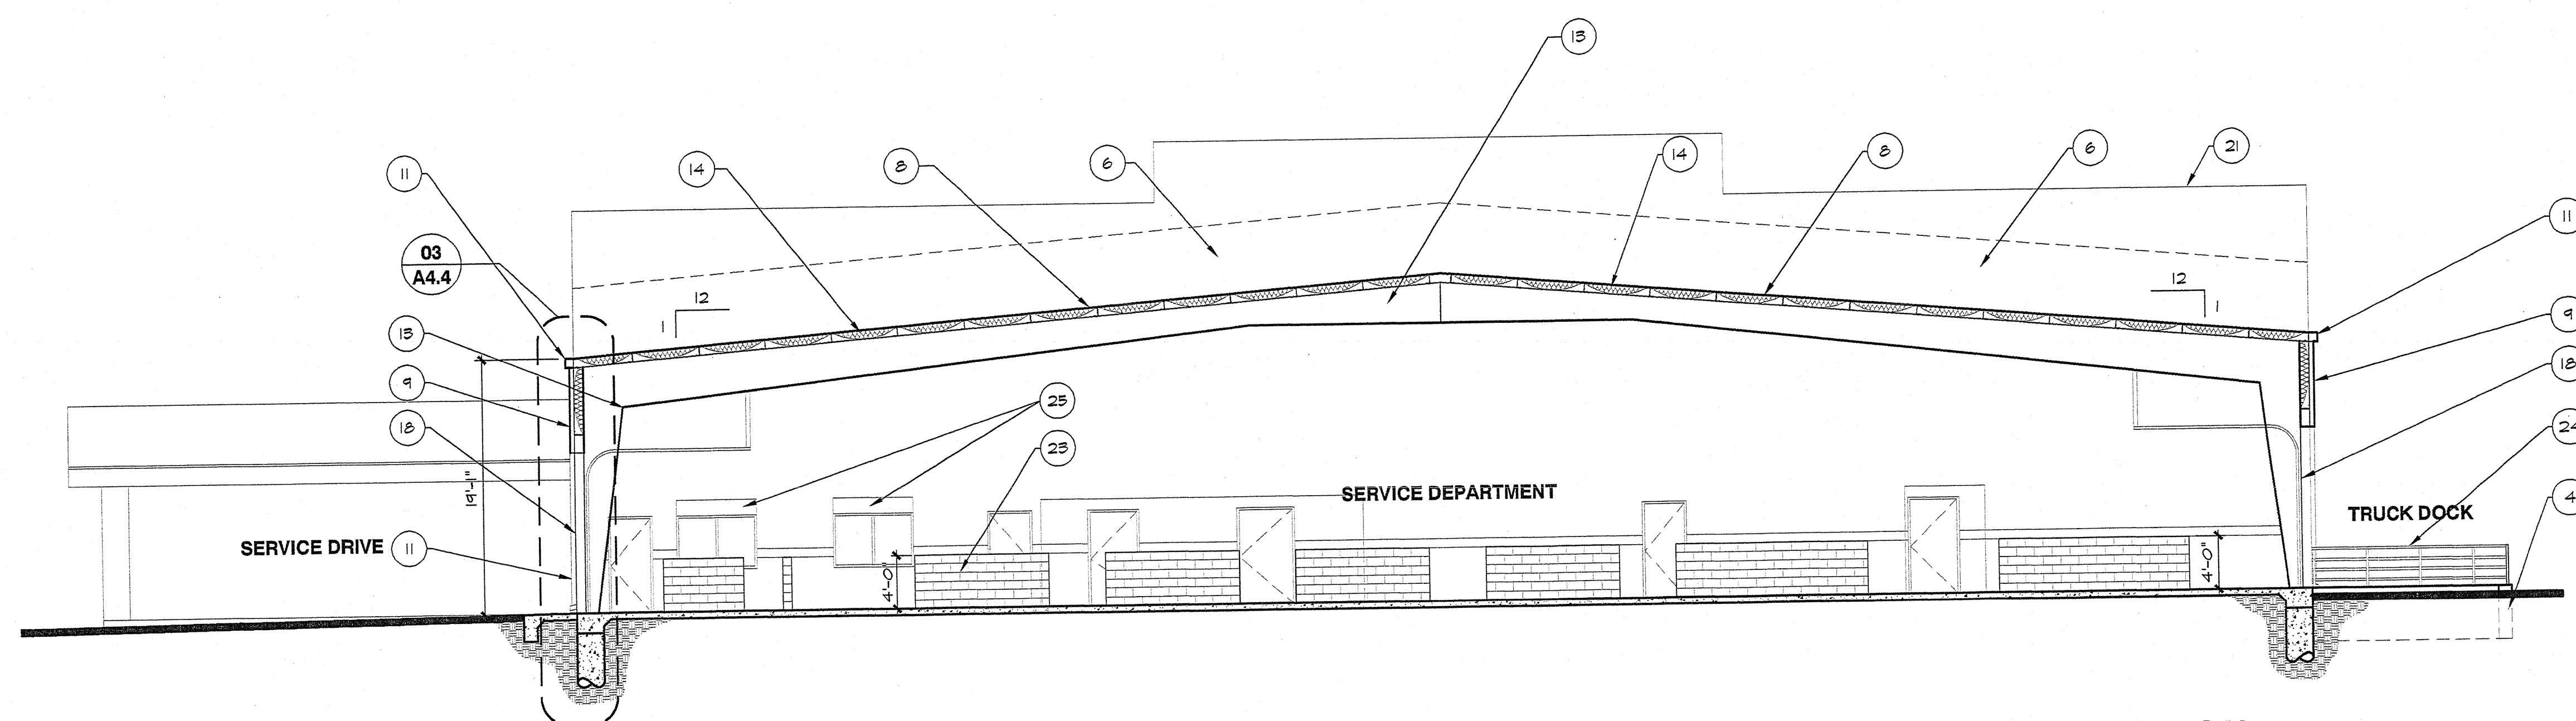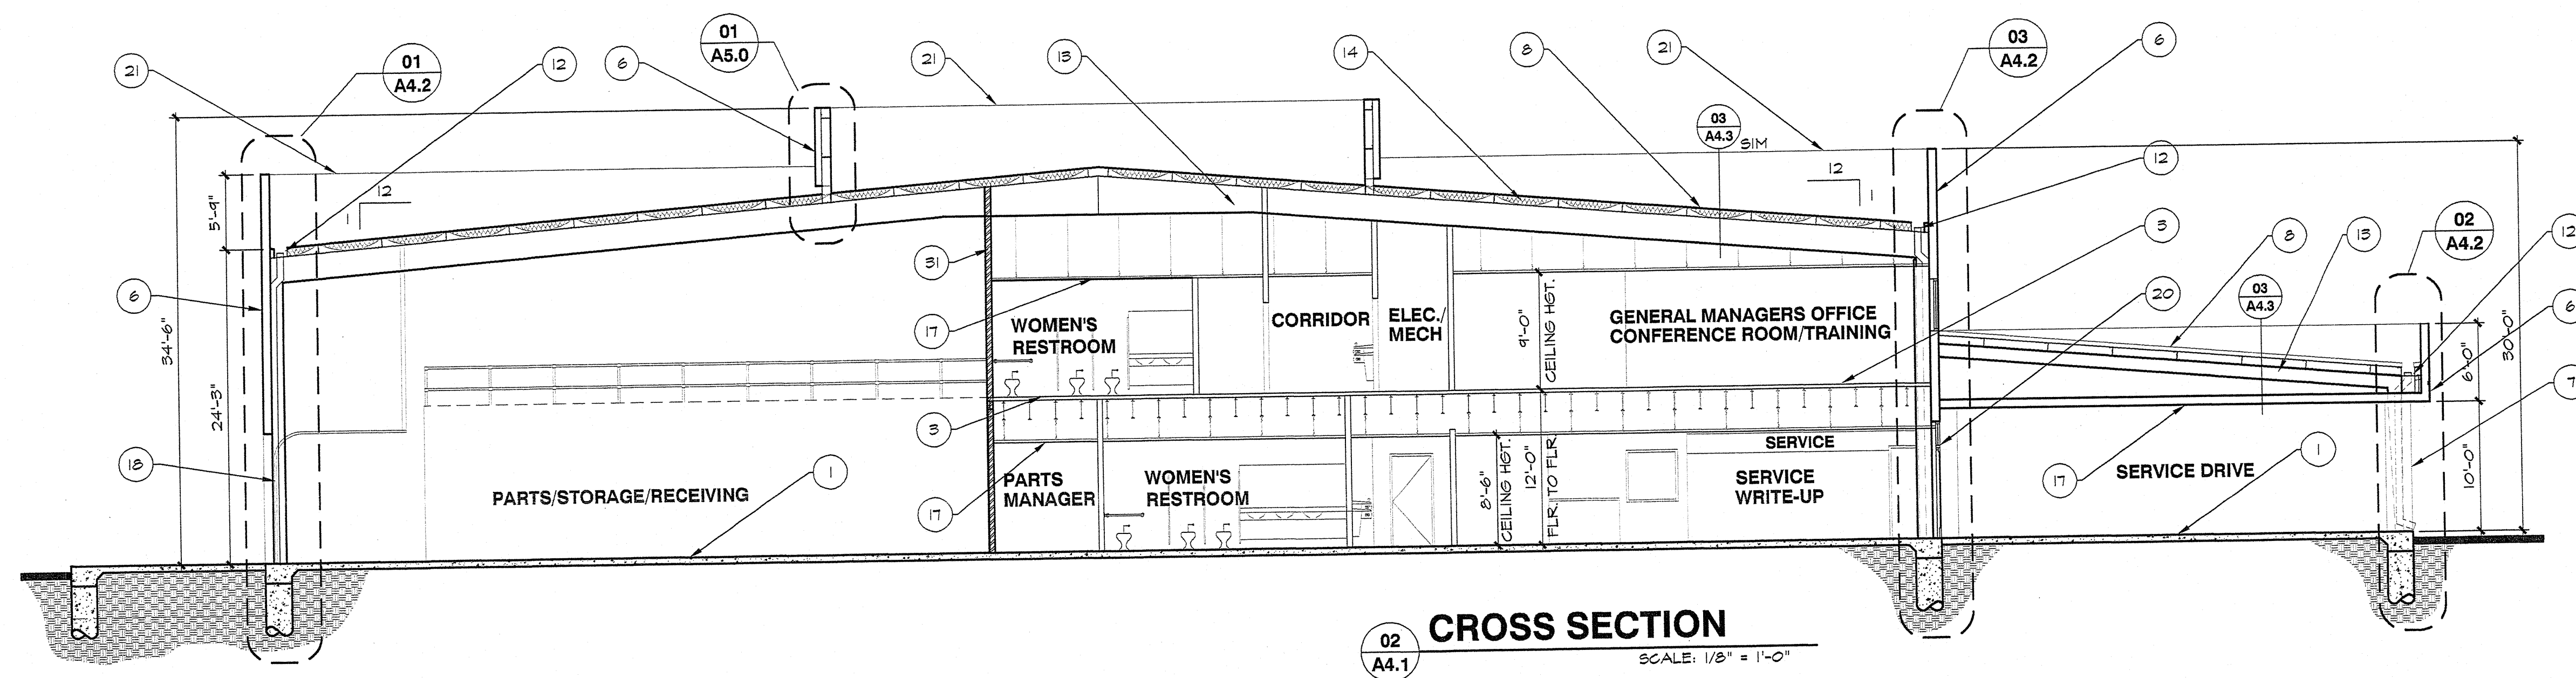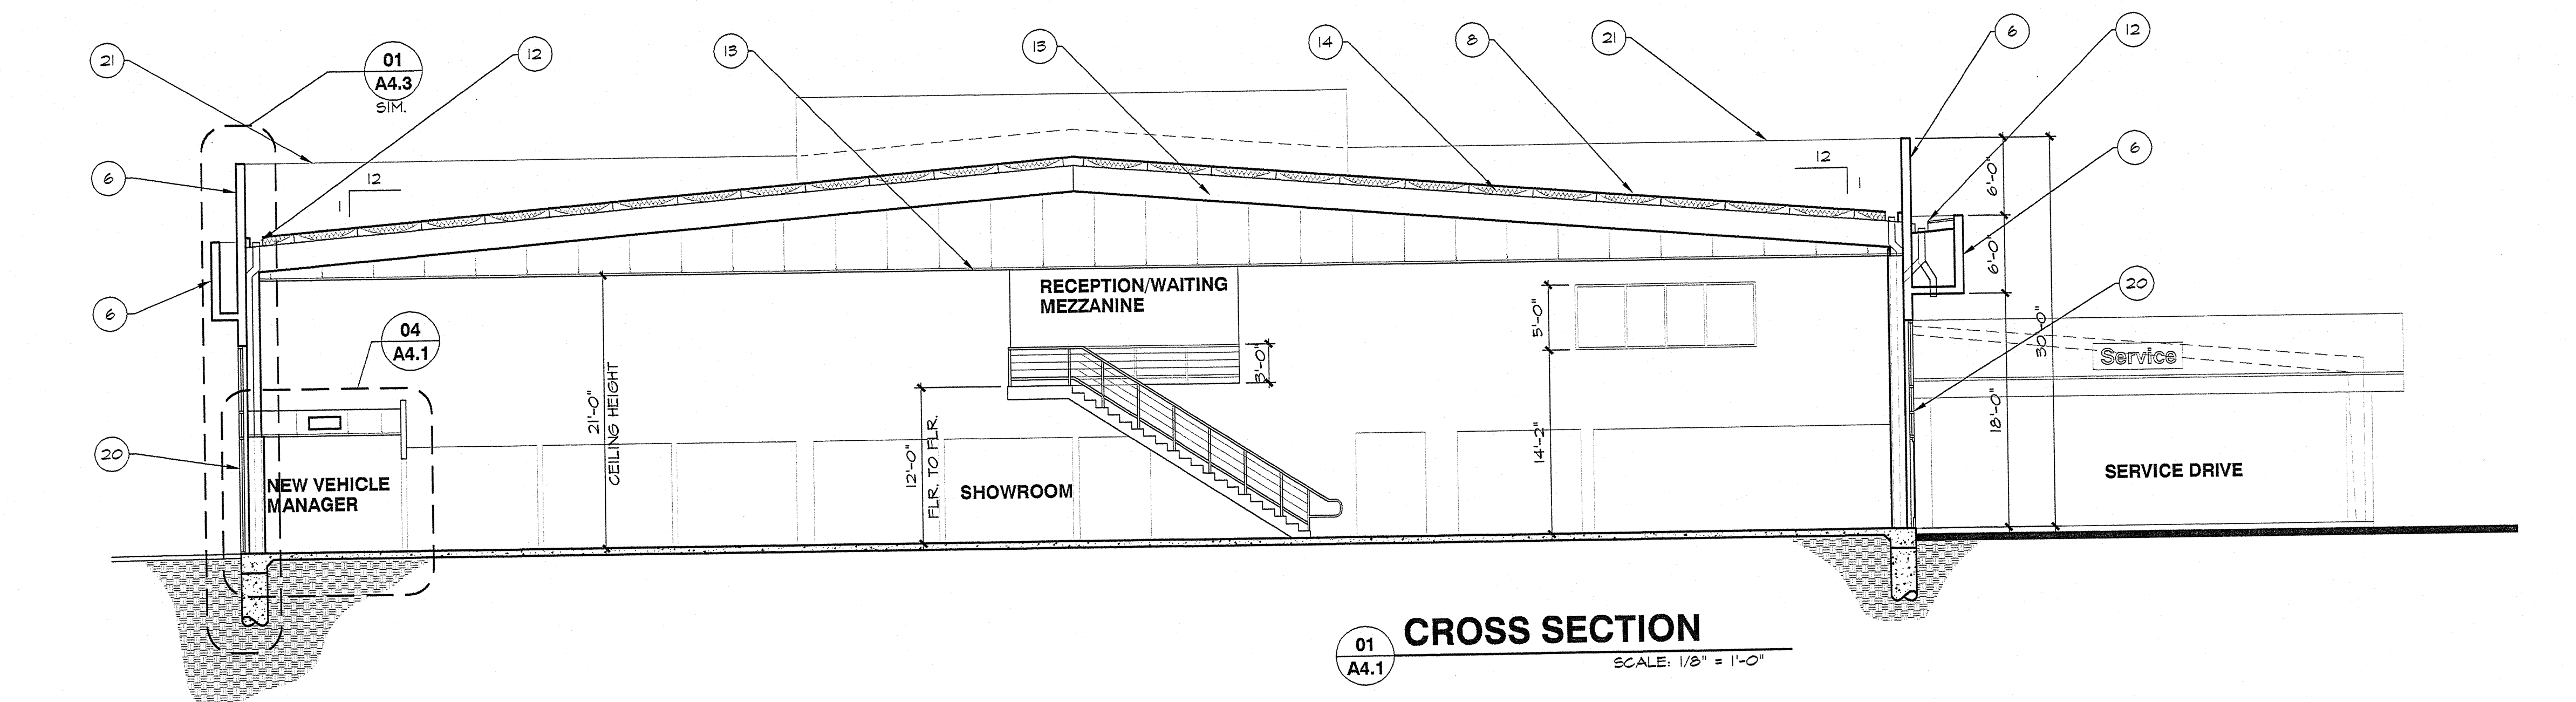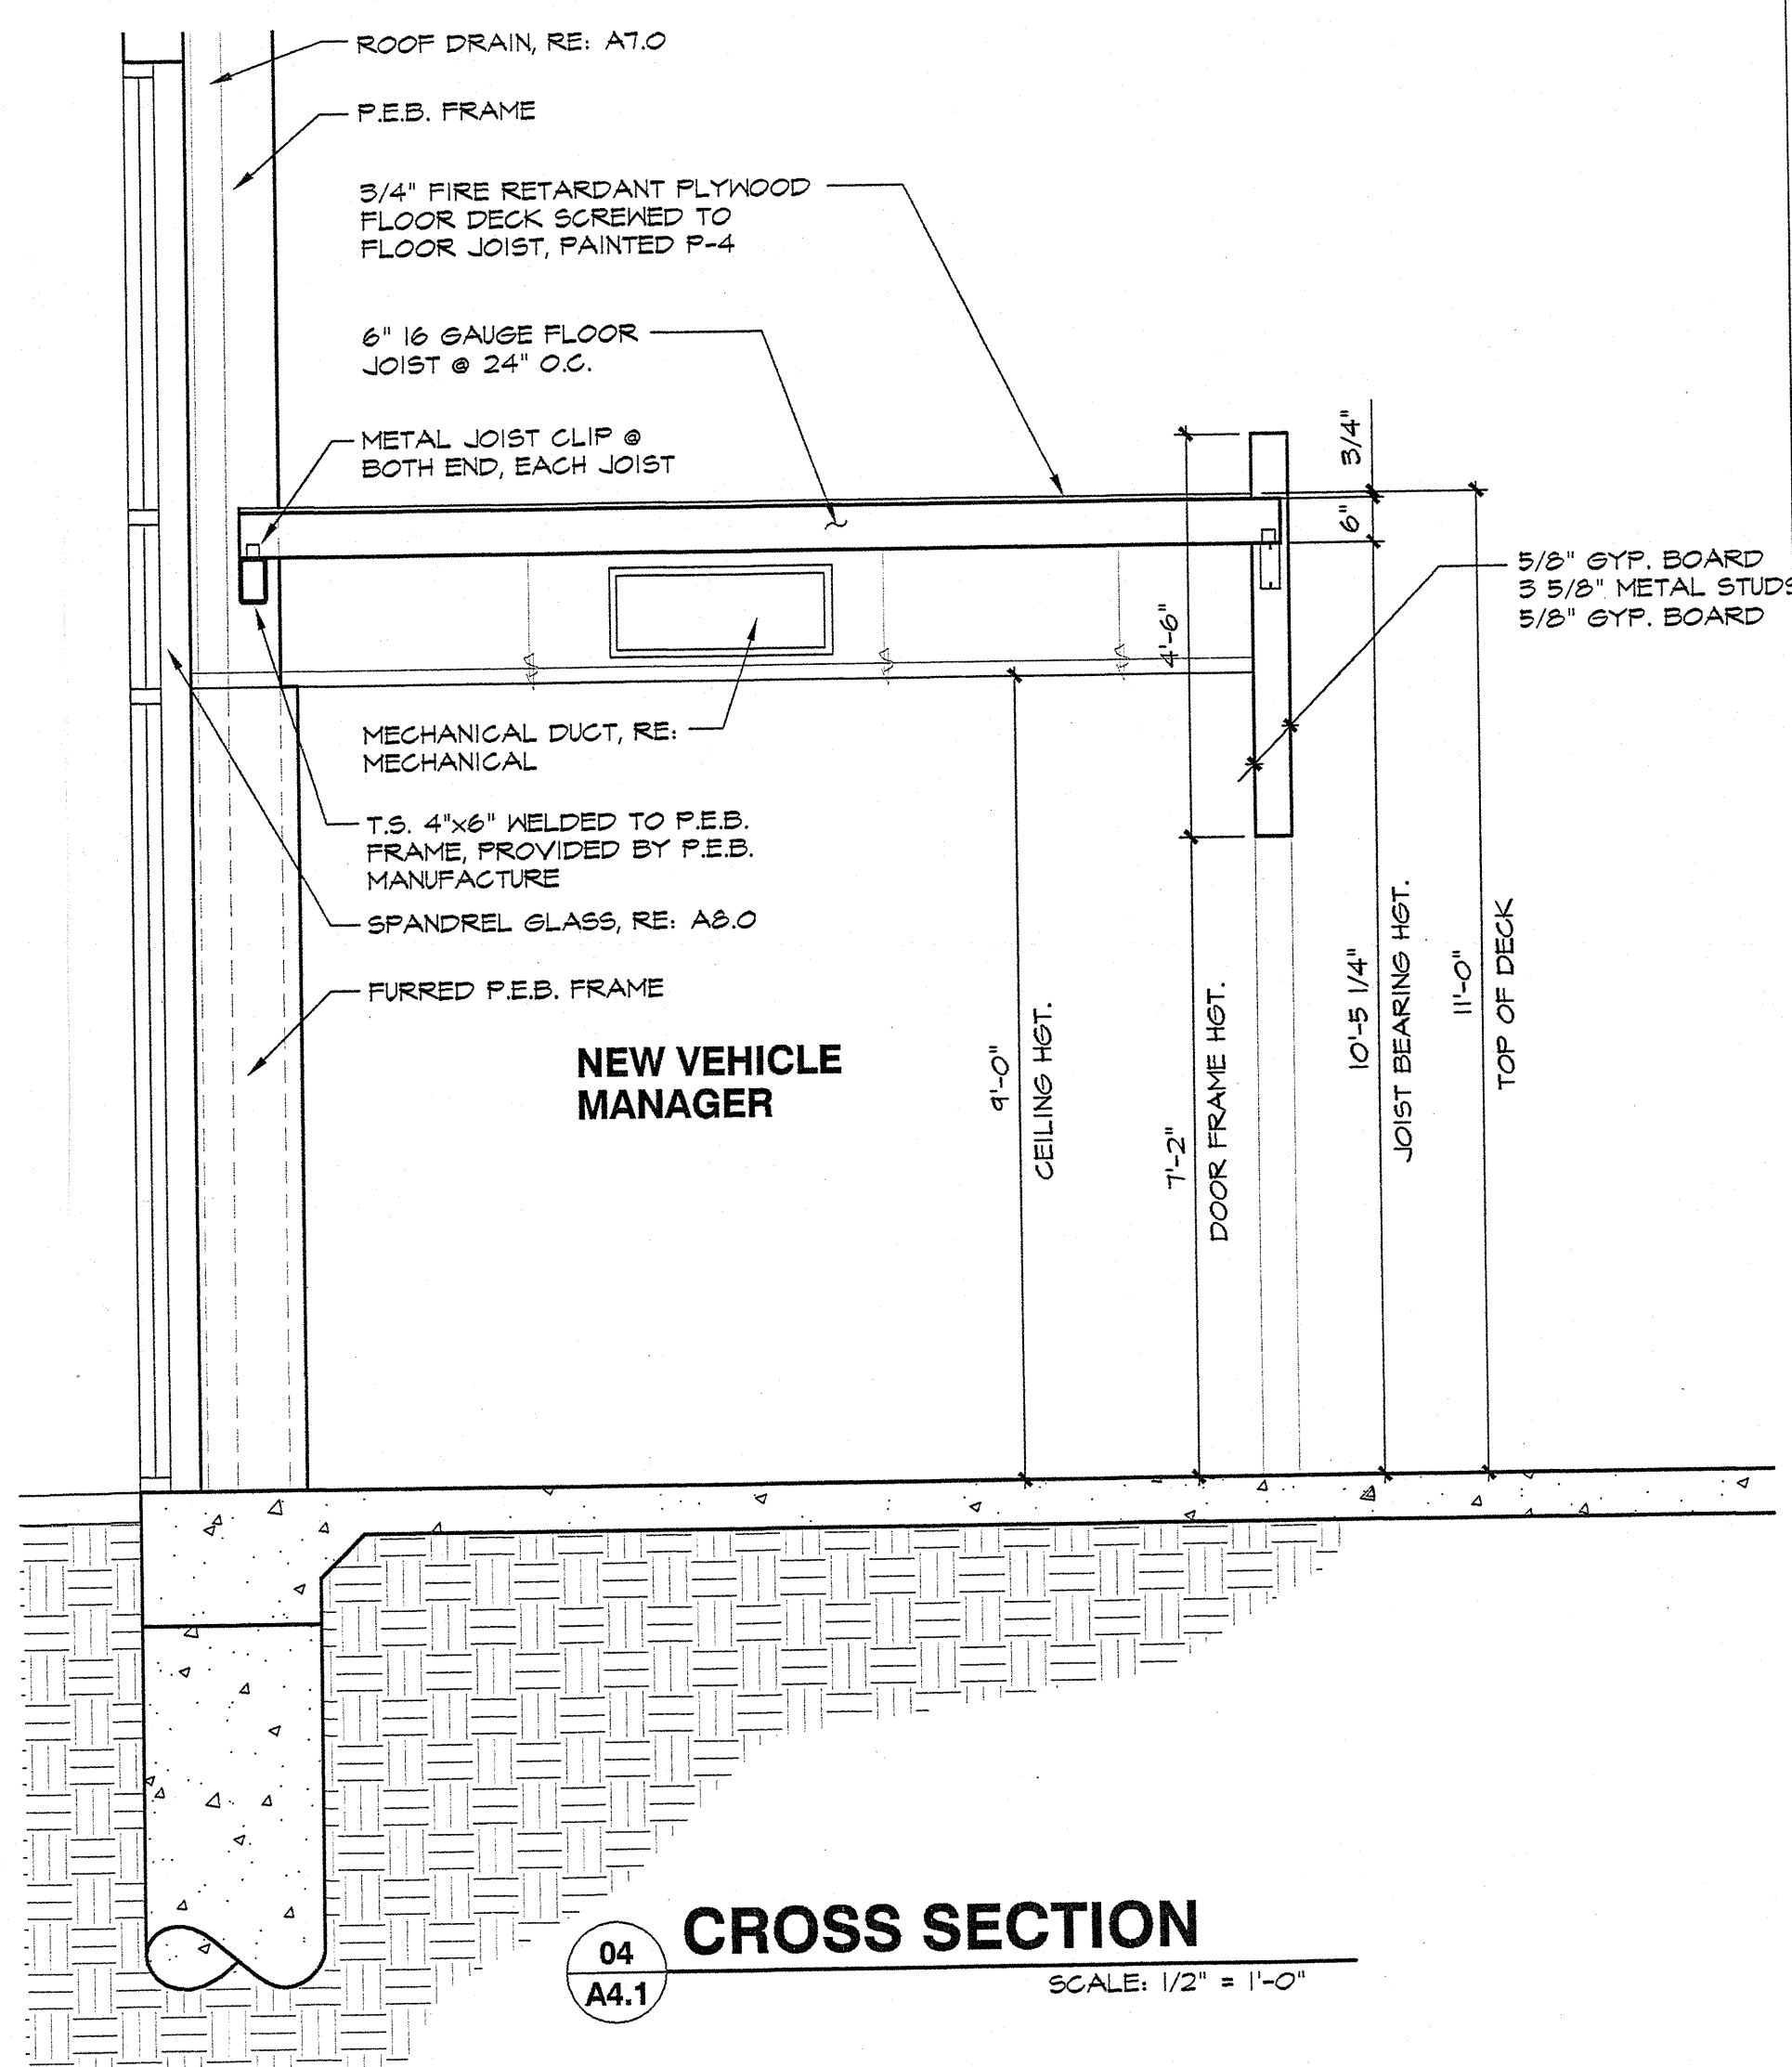

LEGEND:
P-6 FINISH KEY, RE: A5.3 FOR SPECIFICATIONS


- NOTES:
1. SERVICE REPAIR AREA AND WASH BAY AREA WALL GRAPHICS TO CONSIST OF LOGO AND COLOR BAND PAINTED DIRECTLY ON WALL SURFACE.
 2. POSITION LOGO CENTERED LEFT TO RIGHT ON WALL SURFACE

AN AUTOMOTIVE DEALERSHIP
ROGER BEASLEY VOLVO


INTERSTATE HIGHWAY 35 SOUTH
GEORGETOWN, TEXAS

ELSASSER ARCHITECTURAL INC.
ARCHITECTURE AND PLANNING
P.O. BOX 833 GEORGETOWN, TX 78627
(512) 930-5553 FAX (512) 930-2618 www.eai-h.com

CONSULTANT INFORMATION:


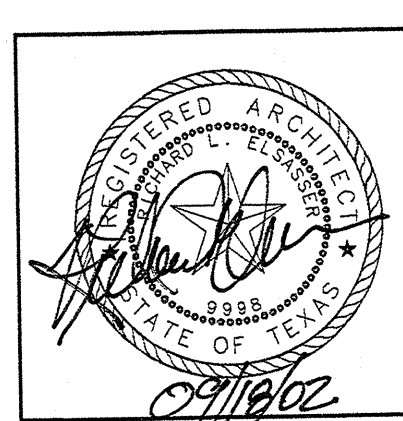


SEE REVISIONS

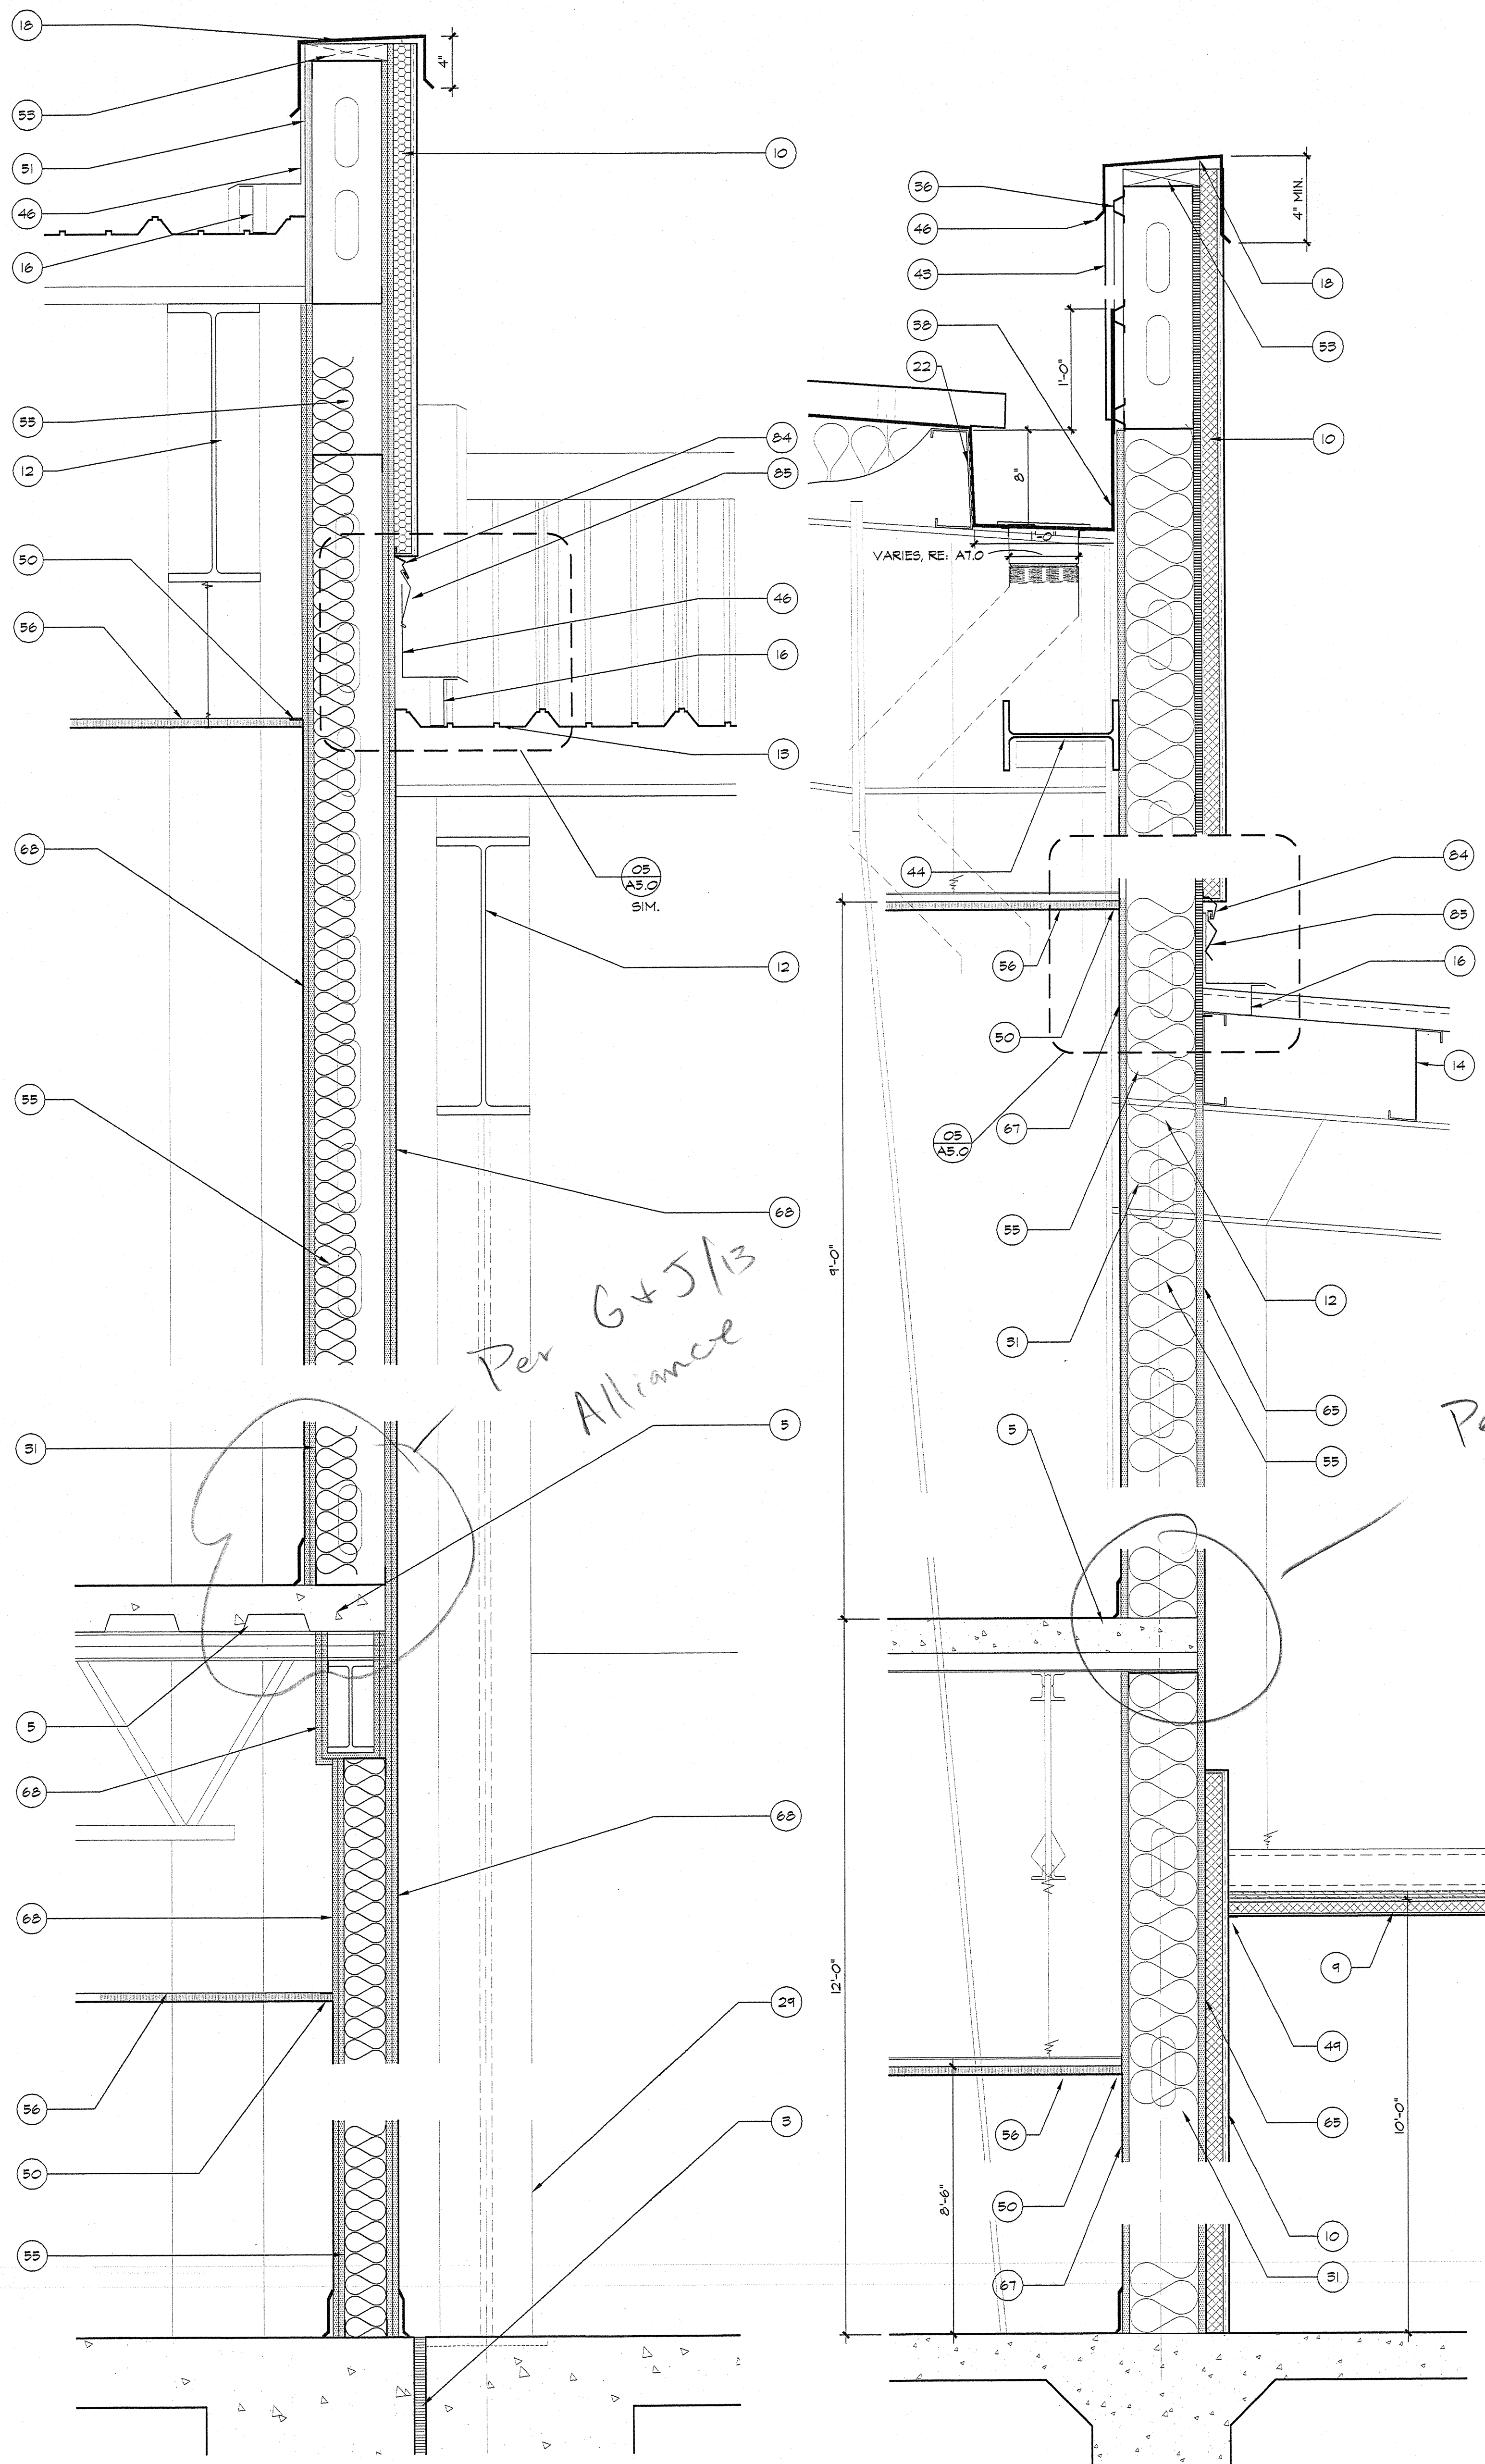

NOTES (ALL NOTES MAY NOT APPLY)

1. CONCRETE FOUNDATION SLAB, RE: STRUCTURAL.
2. CONCRETE FILLED PIPE COLLARD.
3. EXPANSION JOINT FILLER AS SPECIFIED.
4. FLUSH SIDEWALK AT DOOR THRESHOLD ONLY W/ 1/8\" PER FOOT SLOPED AWAY FROM BUILDING IN ALL DIR.
5. CONCRETE FLOOR DECK ON METAL DECKING, RE: STRUCTURAL.
6. CONCRETE FILLED TREAD.
7. CONCRETE RETAINING WALL AT LOADING DOCK.
8. CONCRETE LOADING DOCK.
9. EIFS SOFFIT AS SPECIFIED.
10. EIFS WALL SYSTEM AS SPECIFIED.
11. EIFS COLUMNS.
12. P.E.B. FRAME BY METAL BUILDING MANUFACTURER.
13. METAL PANEL ROOF AS SPECIFIED.
14. 1/2\" PERLIN BY METAL BUILDING MANUFACTURER.
15. WHITE VINYL-FACED R14 BATT INSULATION BETWEEN ROOF PERLIN AND P.E.B. FRAME.
16. PRE-FINISHED METAL CLOSURE.
17. PRE-FINISHED METAL EAVE CLOSURE TRIM.
18. PRE-FINISHED BREAK METAL PARAPET CAP W/ DRIP EDGE BOTH SIDES.
19. NOT USED.
20. PRE-FINISHED METAL BASE TRIM.
21. PRE-FINISHED METAL HEADER TRIM.
22. COLD ROLLED CHANNEL BY METAL BUILDING MANUFACTURER.
23. COLD-FORMED TOP TRACK TO MATCH STUDS.
24. COLD-FORMED BOTTOM RUNNER TO MATCH STUDS.
25. STEEL BEAM, PROVIDED BY METAL BUILDING MANUFACTURER.
26. STEEL ANGLE, PROVIDED BY METAL BUILDING MANUFACTURER.
27. STEEL CHANNEL STRINGER (BY P.E.B.).
28. STEEL PLATE TREAD FANS AND RISERS.
29. STRUCTURAL STEEL COLUMN PROVIDED BY METAL BUILDING MANUFACTURER.
30. 18 GA. 6\" COLD ROLLED METAL JOISTS @ 16\" O/C.
31. 6\" METAL STUD @ 24\" O/C (18 GA. MIN.).
32. 3 5/8\" METAL STUD @ 24\" O/C (18 GA. MIN.).
33. 1/2\" COLD-FORMED METAL CHANNEL MIN. 24\" O/C.
34. 1 1/4\" DIA. STEEL STAIR RAILING.
35. METAL COUNTER FLASH TO RUN OVER ROOF BASE FLASHING.
36. HAT CHANNELS.
37. METAL GUTTER AND DOWN SPOUT WITH SPLASH BLOCK BELOW.
38. INTERNAL METAL GUTTER (ALL SEAMS TO BE SOLDERED AT 50\"-0\" SECTIONS AND ALL JOINTS TO BE SOLDERED AND SEALED).
39. FASTENER.
40. RAKE TRIM.
41. CABLE ANGLE.
42. DRIP MOULD.
43. METAL BUILDING PANEL (BY P.E.B.).
44. GIRT PROVIDED BY METAL BUILDING MANUFACTURER.
45. EAVE STRUT.
46. METAL FLASHING AS SPECIFIED.
47. METAL U PANEL.
48. METAL GLAD BRANDED ELEMENT BY SIGN MANUFACTURER.
49. U-MOULD TRIM AS SPECIFIED.
50. CEILING ANGLE TRIM AT WALL.
51. 5/8\" EXT. GRADE FIRE RETARDANT FLYWOOD.
52. RUBBER TREAD AND LANDING COVERS.
53. 2x BLOCKING (FIRE RETARDANT).
54. FLEXIBLE FLASHING AS SPECIFIED.
55. FIBERGLASS BATT INSULATION (R11) IN 5 5/8\" WALLS AND R19 IN 6\" WALLS, W/ 4 MIL POLYETHYLENE VAPOR BARRIER BENEATH INTERIOR GYPSUM BOARD.
56. NOT USED.
57. SUSPENDED GYPSUM BOARD CEILING AS SCHEDULED.
58. SUSPENDED ACOUSTICAL CEILING AS SCHEDULED.
59. SEALANT AS SPECIFIED.
60. CAULK AS SPECIFIED.
61. INSULATED STEEL OVERHEAD DOOR W/ INSULATED GLAZING PANEL WHERE INDICATED AND AS SPECIFIED.
62. INSULATED HOLLOW METAL MAN DOOR PAINTED AS SCHEDULED.
63. DOOR TRACK BY OVERHEAD DOOR INSTALLER TO MATCH APPLICATION.
64. ALUMINUM STOREFRONT GLAZING SYSTEM W/ CLEAR ANODIZED FRAMES AND 1\" INSULATED GLAZING AS SPECIFIED.
65. 5/8\" EXTERIOR GYPSUM BOARD SHEATHING.
66. 5/8\" EXTERIOR GYPSUM SHEATHING W/ JOINTS TAPED.
67. 5/8\" INTERIOR GYPSUM BOARD W/ JOINT TREATMENT AND FINISH AS SCHEDULED.
68. DOUBLE LAYER OF 1/2\" FIRE CODE \"C\" GYPSUM BOARD W/ FIRE TAPE AND CAULK.
69. ACCENT CHAMFER, RE DETAIL 19/A&2.
70. 5/8\" FIRE CODE \"C\" GYPSUM BOARD W/ FIRE TAPE AND CAULK.
71. VINYL FACED R-11 INSULATION BETWEEN GIRTS.
72. FIBERGLASS BATT ACOUSTICAL INSULATION AT RESTROOM, CONFERENCE ROOM WALLS AND WHERE SPECIFIED.
73. PARAPET WALL BEYOND.
74. INTERNAL DOWNSPOUT.
75. STEEL BEAM WELDED TO EACH VERTICAL TS.
76. 8\" COLD ROLLED METAL STUDS @ 24\" O/C, INFILLED BETWEEN T.S. BY P.E.B.
77. CMU WALL WITH INSULATION FILL AS INDICATED.
78. GROUT FILLED BOND BEAM WITH REINFORCING, RE:STRUCTURAL.
79. 1 1/2\" MASONRY LUIS IN FOUNDATION, RE:STRUCTURAL.
80. CMU KNEE WALL WITH SOLID CAP.
81. KNEE HOLES AT 2'-0\" O/C.
82. MASONRY CAVITY VENT AS SPECIFIED.
83. MASTIC.
84. METAL REGLET.
85. SPRINGLOK FLASHING.
86. SATELLITE SUPPORT DECK, RE: DETAILS ON SHEET A4.5.
87. P.E.B. MANUFACTURER TO PROVIDE T.S. 8x4x1/4 @ 48\" O/C FOR LIGHT GAUGE STEEL STUD SUPPORT.

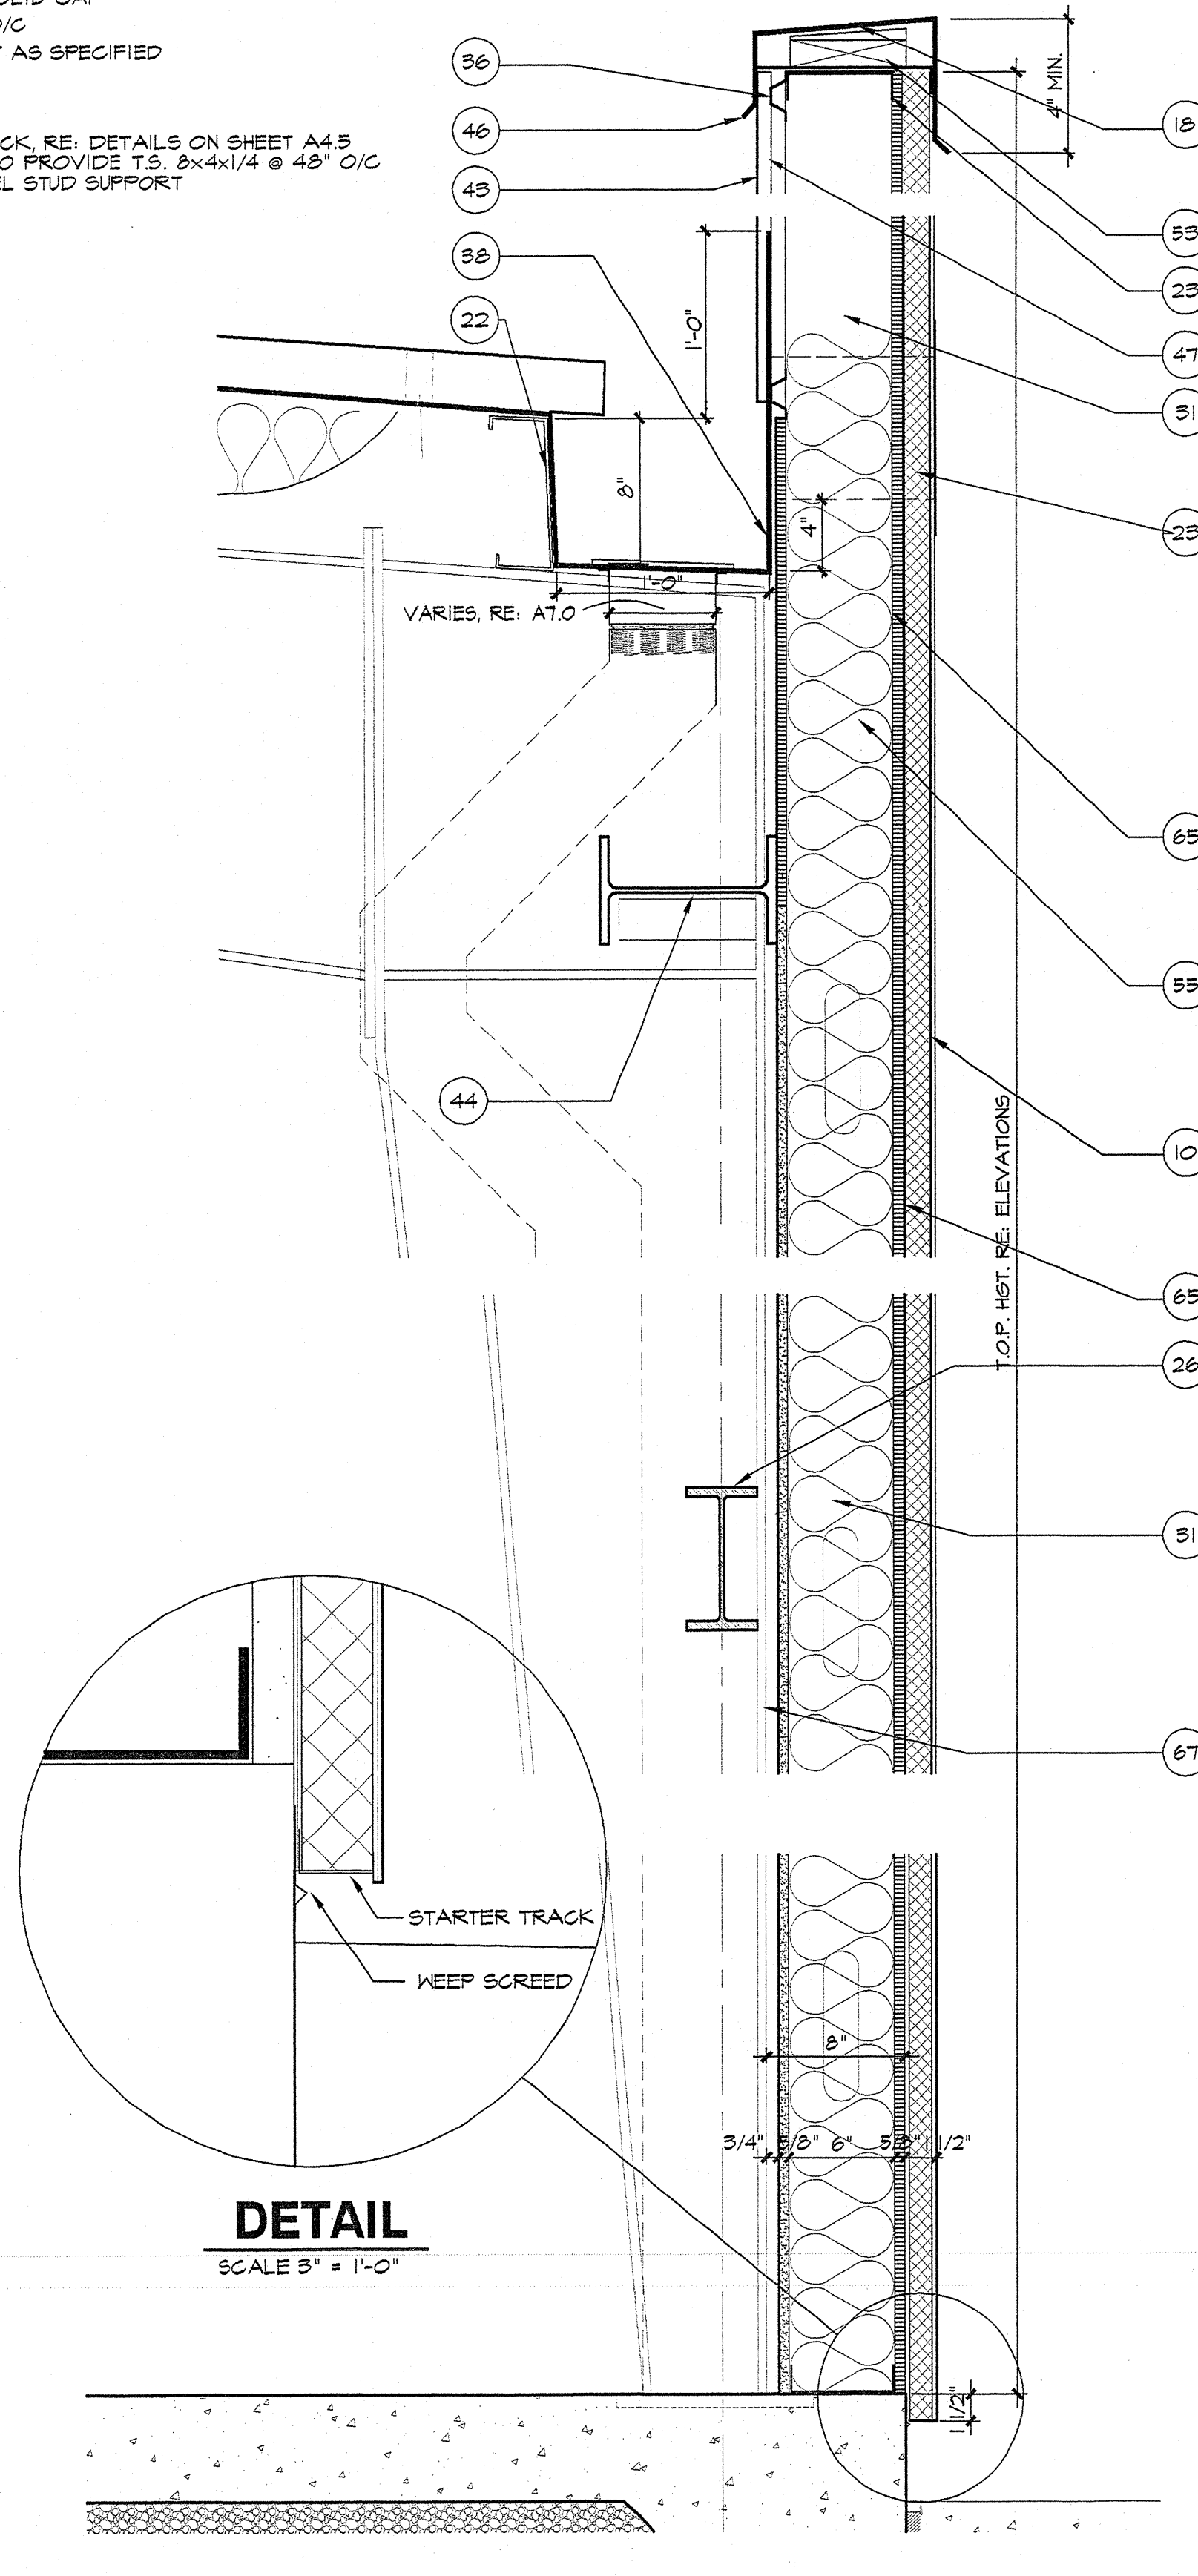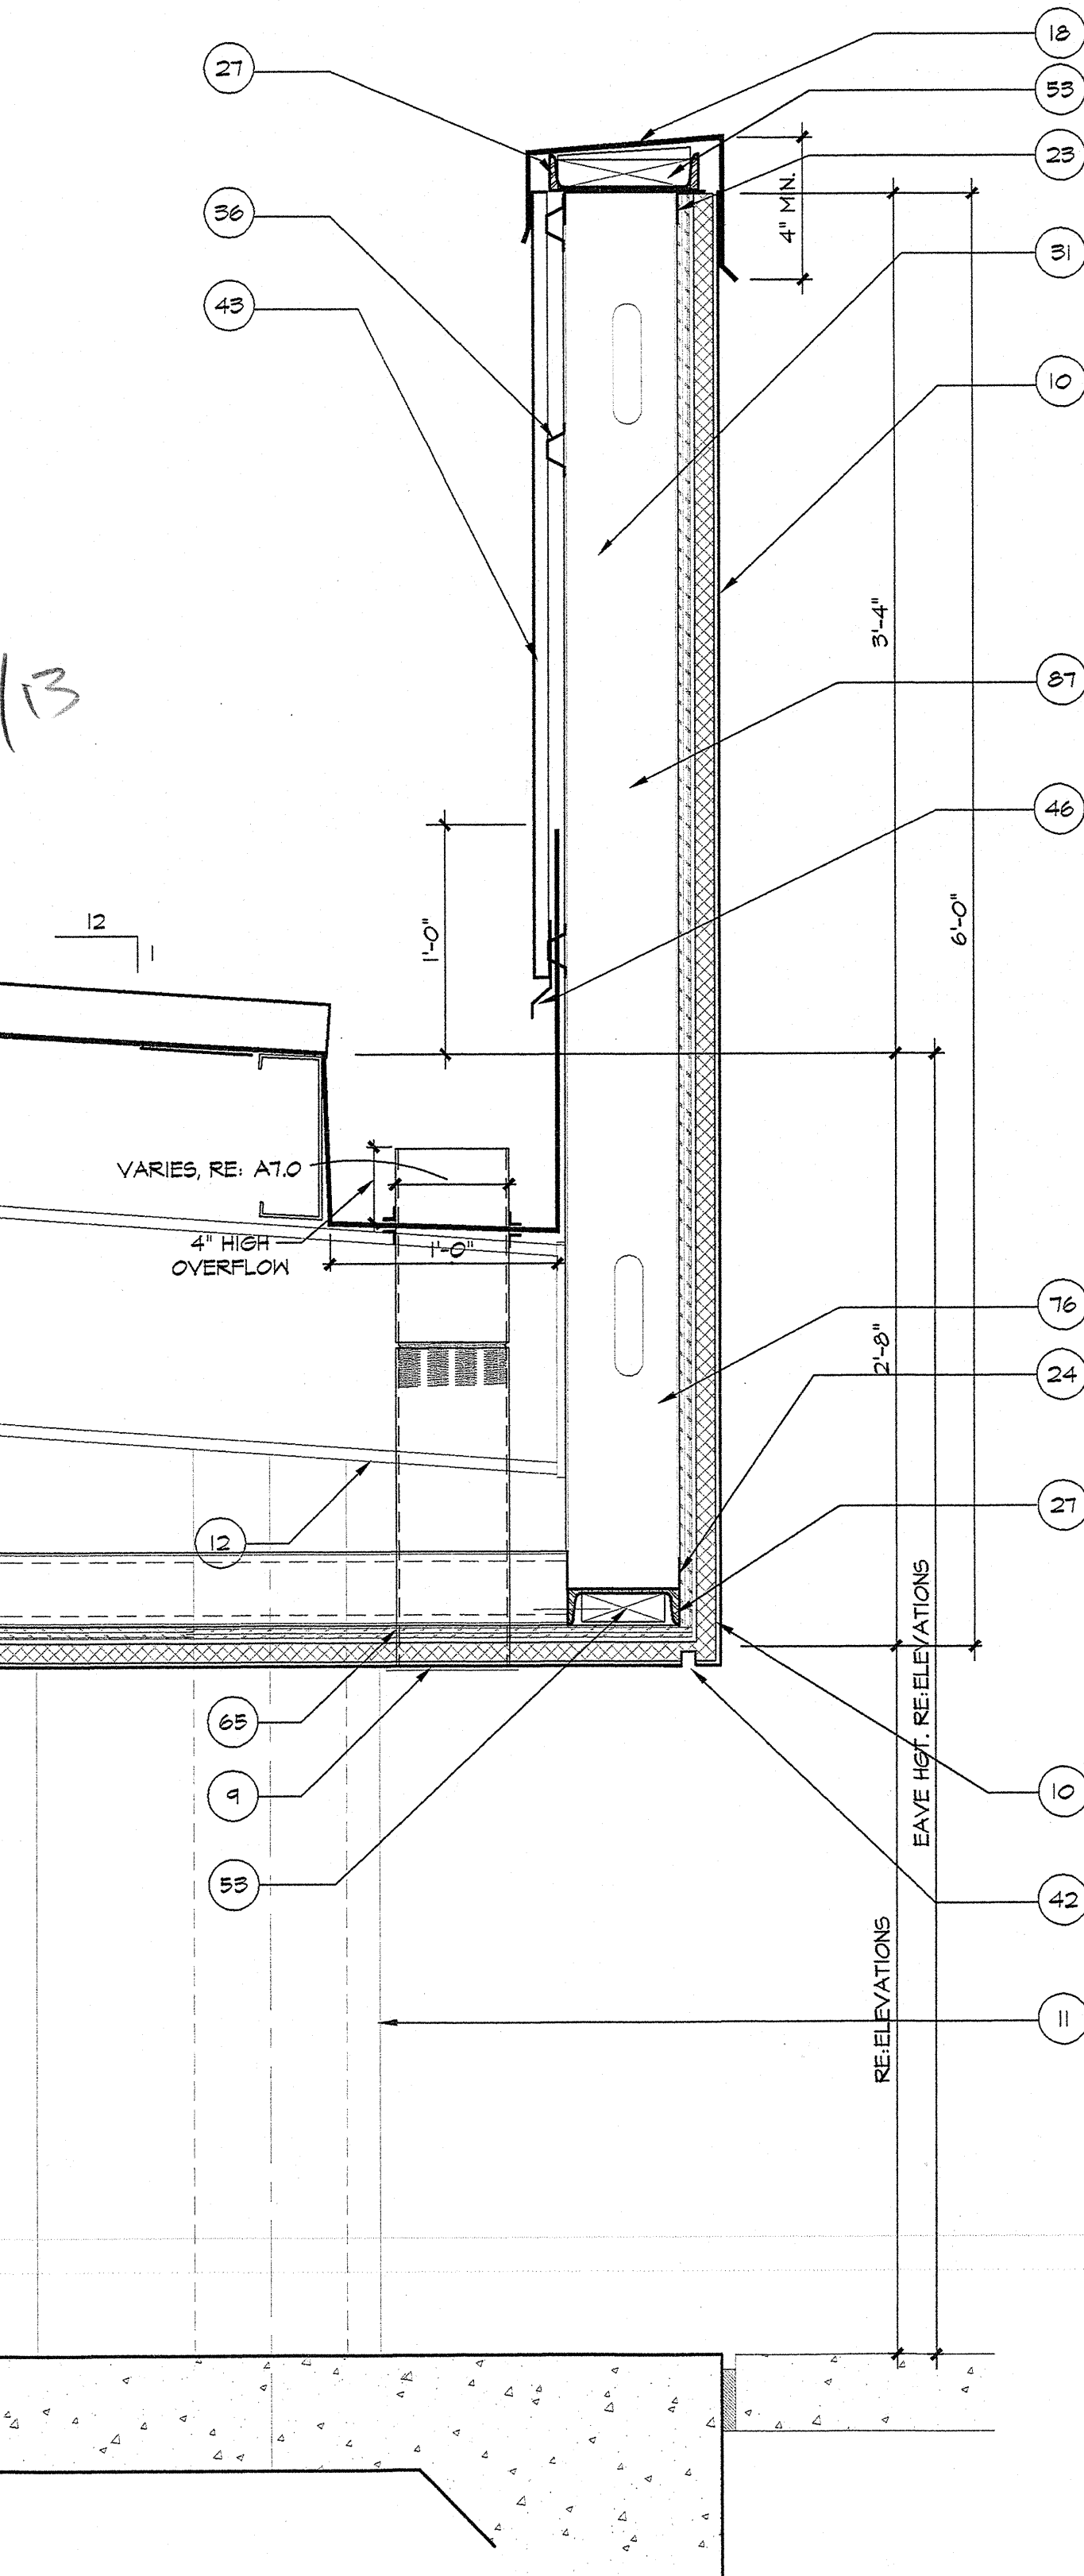


AN AUTOMOTIVE DEALERSHIP

ROGER BEASLEY VOLVO

INTERSTATE HIGHWAY 35 SOUTH
GEORGETOWN, TEXAS

EL SASSER
ARCHITECTURAL
INC.
ARCHITECTURE AND PLANNING
P.O. BOX 833 GEORGETOWN, TX 78627
(612) 850-5553 FAX (512) 580-5816 www.esh-inc.com

CONSULTANT
INFORMATION:

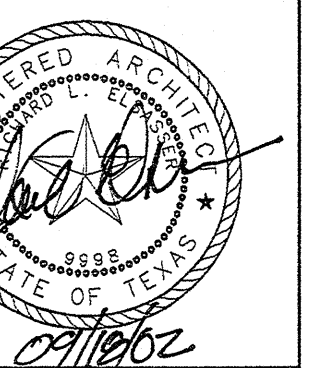


DATE:
09/18/02
REVISION DATE:

PROJECT NO.
02008

SHEET NO.

A4.2

GENERAL NOTES
T.O.P. - TOP OF PARAPET HEIGHT
THIS DIMENSION IS TO THE TOP
OF STUD, BLOCKING AND PRE-
FINISHED METAL PARAPET CAP
ARE NOT INCLUDED IN THIS
DIMENSION.

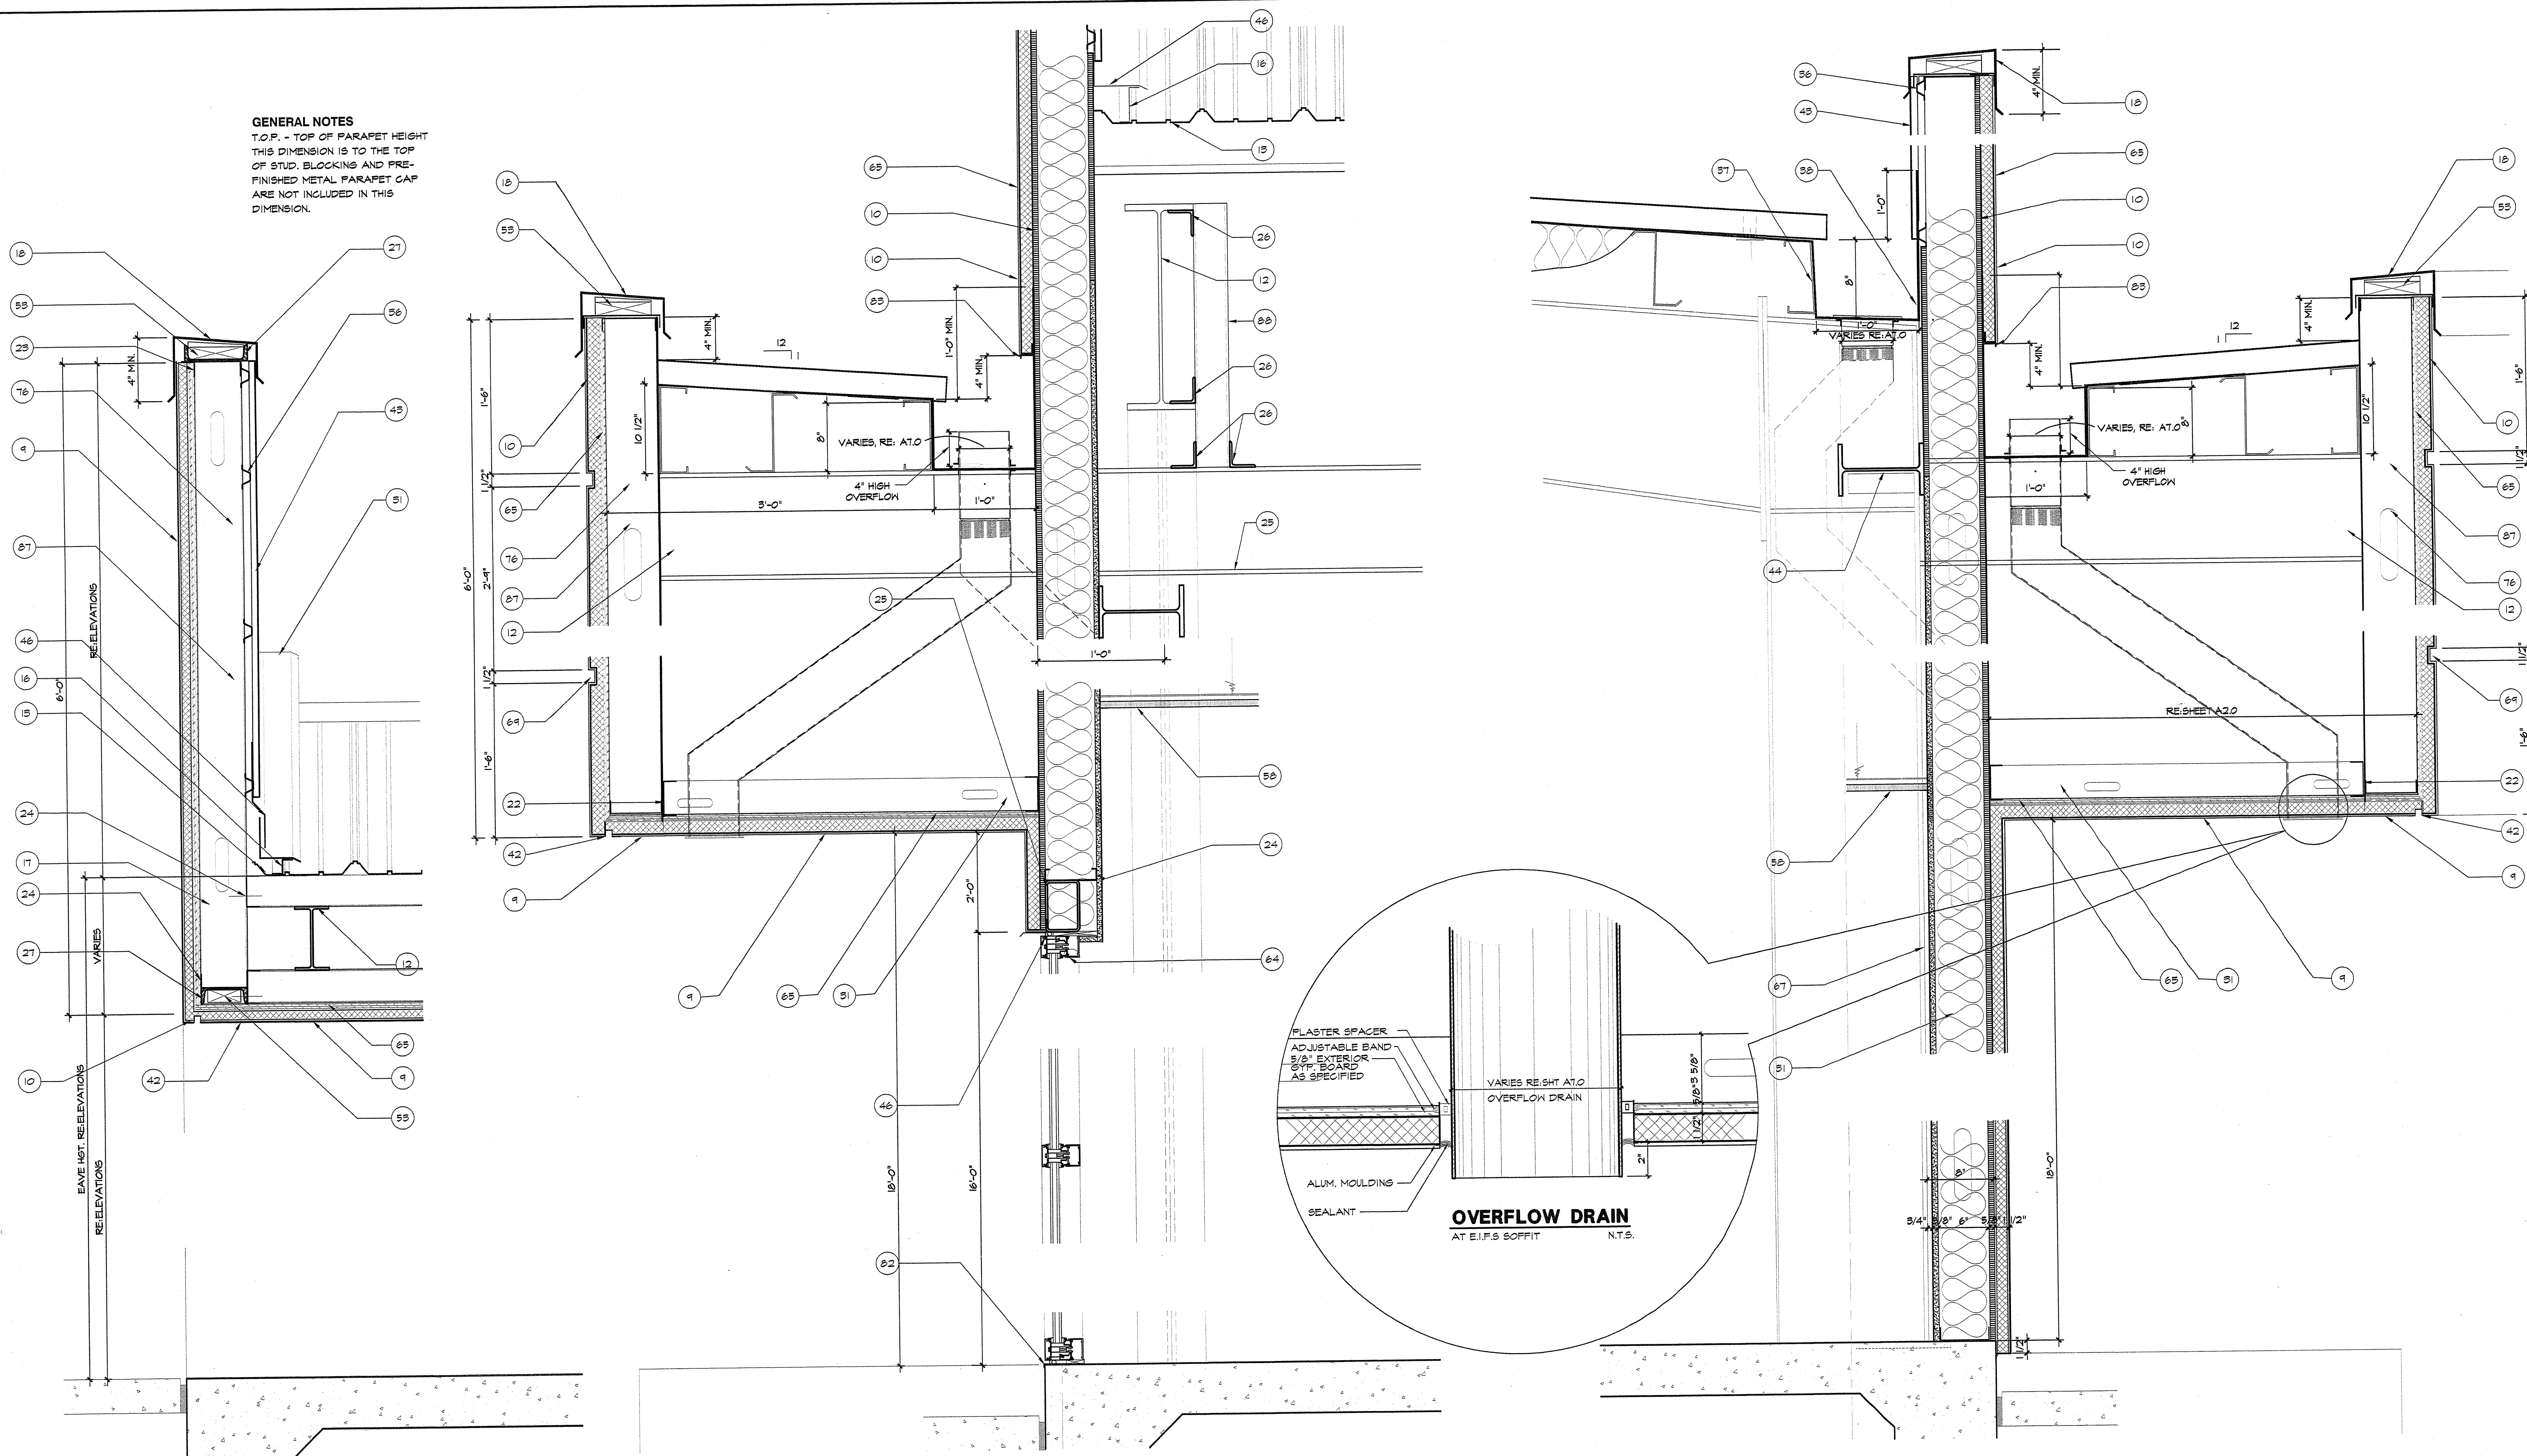

03 WALL SECTION @ SHOWROOM CANOPY
SCALE 1 1/2" = 1'-0"

02 WALL SECTION @ SHOWROOM CANOPY
SCALE 1 1/2" = 1'-0"

01 WALL SECTION @ SHOWROOM CANOPY
SCALE 1 1/2" = 1'-0"

NOTES (ALL NOTES MAY NOT APPLY)

1. CONCRETE FOUNDATION SLAB, RE: STRUCTURAL.
2. CONCRETE FILLED PIPE BOLLARD.
3. EXPANSION JOINT FILLER AS SPECIFIED
4. FLUSH SIDEWALK AT DOOR THRESHOLD ONLY 1/4" 1/8"
5. PER FOOT SLOPED AWAY FROM BUILDING IN ALL DIR.
6. CONCRETE FLOOR DECK ON METAL DECKING, RE: STRUCTURAL.
7. CONCRETE FILLED TREAD
8. CONCRETE RETAINING WALL AT LOADING DOCK
9. CONCRETE LOADING DOCK
10. E.I.F.S. SOFFIT AS SPECIFIED
11. E.I.F.S. WALL SYSTEM AS SPECIFIED
12. E.I.F.S. COLUMNS
13. F.E.B. FRAME BY METAL BUILDING MANUFACTURER.
14. METAL PANEL ROOF AS SPECIFIED.
15. 1/2" PERLIN BY METAL BUILDING MANUFACTURER.
16. WHITE VINYL-FACED R19 BATT INSULATION BETWEEN ROOF PERLIN AND F.E.B. FRAME.
17. PRE-FINISHED METAL CLOSURE.
18. PRE-FINISHED METAL EAVE CLOSURE TRIM.
19. PRE-FINISHED BREAK METAL PARAPET CAP W/ DRIP EDGE BOTH SIDES.
20. NOT USED
21. PRE-FINISHED METAL BASE TRIM
22. PRE-FINISHED METAL HEADER TRIM

23. COLD-ROLLED CHANNEL BY METAL BUILDING MANUFACTURER
24. COLD-FORMED TOP TRACK TO MATCH STUDS.
25. COLD-FORMED BOTTOM RUNNER TO MATCH STUDS.
26. STEEL BEAM, PROVIDED BY METAL BUILDING MANUFACTURER
27. STEEL ANGLE, PROVIDED BY METAL BUILDING MANUFACTURER
28. STEEL CHANNEL STRINGER (BY F.E.B.)
29. STEEL PLATE TREAD PANS AND RISERS
30. STRUCTURAL STEEL COLUMN, PROVIDED BY METAL BUILDING MANUFACTURER
31. 18 GA. 6" COLD ROLLED METAL JOISTS @ 16" O/C
32. 6" METAL STUD @ 24" O/C (18 GA. MIN.)
33. 5 5/8" METAL STUD @ 24" O/C (18 GA. MIN.)
34. 1 1/2" COLD-FORMED METAL CHANNEL MIN. 24" O/C.
35. 1 1/4" DIA. STEEL STAIR RAILING
36. METAL COUNTER FLASH TO RUN OVER ROOF BASE FLASHING.
37. HAT CHANNELS
38. METAL GUTTER AND DOWN SPOUT WITH SPLASH BLOCK BELOW
39. INTERNAL METAL GUTTER (ALL SEAMS TO BE SOLDERED AT 30'-0" SECTIONS AND ALL JOINTS TO BE SOLDERED AND SEALED)
40. FASTENER
41. RAKE TRIM
42. GABLE ANGLE
43. DRIP MOULD

44. METAL BUILDING PANEL (BY F.E.B.)
45. GIRT PROVIDED BY METAL BUILDING MANUFACTURER
46. EAVE BRUT
47. METAL FLASHING AS SPECIFIED.
48. METAL U PANEL
49. METAL CLAD BRANDED ELEMENT BY SIGN MANUFACTURER
50. J-MOULD TRIM AS SPECIFIED.
51. CEILING ANGLE TRIM AT WALL
52. 5/8" EXT. GRADE FIRE RETARDANT FLYWOOD
53. RUBBER TREAD AND LANDING COVERS
54. 2X BLOCKING (FIRE RETARDANT)
55. FLEXIBLE FLASHING AS SPECIFIED.
56. FIBERGLASS BATT INSULATION (R11 IN 5 5/8" WALLS AND R19 IN 6" WALLS, W/ 4 MIL POLYETHYLENE VAPOR BARRIER BENEATH INTERIOR GYPSUM BOARD
57. NOT USED
58. SUSPENDED GYPSUM BOARD CEILING AS SCHEDULED.
59. SUSPENDED ACOUSTICAL CEILING AS SCHEDULED
60. SEALANT AS SPECIFIED
61. CALK AS SPECIFIED.
62. INSULATED STEEL OVERHEAD DOOR W/ INSULATED GLAZING PANEL WHERE INDICATED AND AS SPECIFIED.
63. INSULATED HOLLOW METAL MAN DOOR PAINTED AS SCHEDULED.
64. DOOR TRACK BY OVERHEAD DOOR INSTALLER TO MATCH APPLICATION.
65. ALUMINUM STOREFRONT GLAZING SYSTEM W/ CLEAR ANODIZED FRAMES AND 1" INSULATED GLAZING AS SPECIFIED.
66. 5/8" EXTERIOR GYPSUM BOARD SHEATHING


67. 5/8" EXTERIOR GYPSUM SHEATHING W/ JOINTS TAPED.
68. 5/8" INTERIOR GYPSUM BOARD W/ JOINT TREATMENT AND FINISH AS SCHEDULED.
69. DOUBLE LAYER OF 1/2" FIRE CODE 'C' GYPSUM BOARD W/ FIRE TAPE AND CAULK
70. ACCENT CHAIRFER, RE DETAIL 19/A8.2
71. 5/8" FIRE CODE 'C' GYPSUM BOARD W/ FIRE TAPE AND CAULK.
72. VINYL FACED R-11 INSULATION BETWEEN GIRTS
73. FIBERGLASS BATT ACOUSTICAL INSULATION AT RESTROOM, CONFERENCE ROOM WALLS AND WHERE SPECIFIED.
74. PARAPET WALL BEYOND
75. INTERNAL DOWNSPOUT
76. STEEL BEAM WELDED TO EACH VERTICAL TS
77. 8" COLD ROLLED METAL STUDS @ 24" O/C, INFILLED BETWEEN T.S. BY F.E.B.
78. CMU WALL WITH INSULATION FILL AS INDICATED
79. GROUT FILLED BOND BEAM WITH REINFORCING, RE:STRUCTURAL
80. 1 1/2" MASONRY LUG IN FOUNDATION, RE:STRUCTURAL
81. CMU KNEE WALL WITH SOLID CAP
82. KEEP HOLES AT 2'-0" O/C
83. MASONRY CAVITY VENT AS SPECIFIED
84. MASTIC
85. METAL RESLET
86. SPRINGLOK FLASHING
87. SATELLITE SUPPORT DECK, RE: DETAILS ON SHEET A4.3
88. F.E.B. MANUFACTURER TO PROVIDE T.S. 8x4x1/4 @ 48" O/C FOR LIGHT GAUGE STEEL STUD SUPPORT
89. T.S. SUPPORTS FOR STEEL BEAM

AN AUTOMOTIVE DEALERSHIP
ROGER BEASLEY VOLVO

INTERSTATE HIGHWAY 35 SOUTH
GEORGETOWN, TEXAS

ELASSER ARCHITECTURAL INC.
ARCHITECTURE AND PLANNING
P.O. BOX 883 GEORGETOWN, TX 78627
(512) 590-5353 FAX (512) 590-5515 www.eah-inc.com

CONSULTANT
INFORMATION:

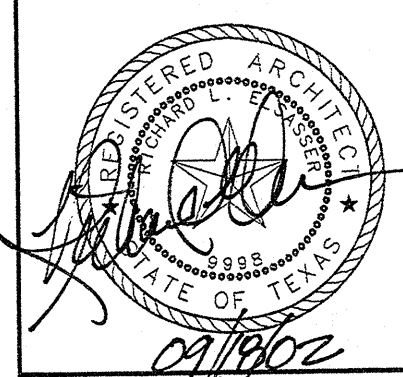

DATE:
09/18/02
REVISION DATE:

PROJECT NO.
02008


SHEET NO.

A4.3


NOTES (ALL NOTES MAY NOT APPLY)

1. CONCRETE FOUNDATION SLAB, RE: STRUCTURAL.
2. CONCRETE FILLED PIPE BOLLARD.
3. EXPANSION JOINT FILLER AS SPECIFIED.
4. FLUSH SIDEWALK AT DOOR THRESHOLD ONLY W/ 1/2" PER FOOT SLOPED AWAY FROM BUILDING IN ALL DIR.
5. CONCRETE FLOOR DECK ON METAL DECKING, RE: STRUCTURAL.
6. CONCRETE FILLER TREAD.
7. CONCRETE RETAINING WALL AT LOADING DOCK.
8. CONCRETE LOADING DOCK.
9. EIFS SOFFIT AS SPECIFIED.
10. EIFS WALL SYSTEM AS SPECIFIED.
11. EIFS COLUMNS.
12. F.E.B. FRAME BY METAL BUILDING MANUFACTURER.
13. METAL PANEL ROOF AS SPECIFIED.
14. 12" FERLIN BY METAL BUILDING MANUFACTURER.
15. WHITE VINYL-FACED R14 BATT INSULATION BETWEEN ROOF FERLIN AND F.E.B. FRAME.
16. PRE-FINISHED METAL CLOSURE.
17. PRE-FINISHED METAL EAVE CLOSURE TRIM.
18. PRE-FINISHED BREAK METAL PARAPET CAP W/ DRIP EDGE BOTH SIDES.
19. NOT USED.
20. PRE-FINISHED METAL BASE TRIM.
21. PRE-FINISHED METAL HEADER TRIM.
22. COLD ROLLED CHANNEL BY METAL BUILDING MANUFACTURER.
23. COLD-FORMED TOP TRACK TO MATCH STUDS.
24. COLD-FORMED BOTTOM RUNNER TO MATCH STUDS.
25. STEEL BEAM, PROVIDED BY METAL BUILDING MANUFACTURER.
26. STEEL ANGLE, PROVIDED BY METAL BUILDING MANUFACTURER.
27. STEEL CHANNEL STRINGER BY F.E.B.
28. STEEL PLATE TREAD FANS AND RISERS.
29. STRUCTURAL STEEL COLUMN PROVIDED BY METAL BUILDING MANUFACTURER.
30. 1/2" COLD ROLLED METAL JOISTS @ 16" O/C.
31. 6" METAL STUD @ 24" O/C (18 GA. MIN).
32. 3 5/8" METAL STUD @ 24" O/C (18 GA. MIN).
33. 1 1/2" COLD-FORMED METAL CHANNEL MIN. 24" O/C.
34. 1 1/4" DIA. STEEL STAIR RAILING.
35. METAL COUNTER FLASH TO RUN OVER ROOF BASE FLASHING.
36. HAT CHANNELS.
37. METAL GUTTER AND DOWN SPOUT WITH SPLASH BLOCK BELOW.
38. INTERNAL METAL GUTTER (ALL SEAMS TO BE SOLDERED AT 30" O/C SECTIONS AND ALL JOINTS TO BE SOLDERED AND SEALED).
39. FASTENER.
40. RAKE TRIM.
41. GABLE ANGLE.
42. DRIP MOULD.


43. METAL BUILDING PANEL (BY F.E.B.)
44. GIRT PROVIDED BY METAL BUILDING MANUFACTURER.
45. EAVE STRUT.
46. METAL FLASHING AS SPECIFIED.
47. METAL U PANEL.
48. METAL CLAD BRANDED ELEMENT BY SIGN MANUFACTURER.
49. J-MOULD TRIM AS SPECIFIED.
50. CEILING ANGLE TRIM AT WALL.
51. 5/8" EXT. GRADE FIRE RETARDANT PLYWOOD.
52. RUBBER TREAD AND LANDING COVERS.
53. 2x BLOCKING (FIRE RETARDANT).
54. FLEXIBLE FLASHING AS SPECIFIED.
55. FIBERGLASS BATT INSULATION (R11 IN 3 5/8" WALLS AND R19 IN 6" WALLS, W/ 4 MIL POLYETHYLENE VAPOR BARRIER BENEATH INTERIOR GYPSUM BOARD).
56. NOT USED.
57. SUSPENDED GYPSUM BOARD CEILING AS SCHEDULED.
58. SUSPENDED ACOUSTICAL CEILING AS SCHEDULED.
59. SEALANT AS SPECIFIED.
60. CAULK AS SPECIFIED.
61. INSULATED STEEL OVERHEAD DOOR W/ INSULATED GLAZING PANEL WHERE INDICATED AND AS SPECIFIED.
62. INSULATED HOLLOW METAL MAN DOOR PAINTED AS SCHEDULED.
63. DOOR TRACK BY OVERHEAD DOOR INSTALLER TO MATCH APPLICATION.
64. ALUMINUM STOREFRONT GLAZING SYSTEM W/ CLEAR ANODIZED FRAMES AND 1" INSULATED GLAZING AS SPECIFIED.
65. 5/8" EXTERIOR GYPSUM BOARD SHEATHING.
66. 5/8" EXTERIOR GYPSUM SHEATHING W/ JOINTS TAPED.
67. 5/8" INTERIOR GYPSUM BOARD W/ JOINT TREATMENT AND FINISH AS SCHEDULED.
68. DOUBLE LAYER OF 1/2" FIRE CODE 10' GYPSUM BOARD W/ FIRE TAPE AND CAULK.
69. ACCENT CHAMFER, RE: DETAIL 101A.2.
70. 5/8" FIRE CODE 10' GYPSUM BOARD W/ FIRE TAPE AND CAULK.
71. VINYL FACED BATT ACOUSTICAL INSULATION AT RESTROOM, CONFERENCE ROOM WALLS AND WHERE SPECIFIED.
72. PARAPET WALL BEYOND.
73. INTERNAL DOWNSPOUT.
74. STEEL BEAM HELDED TO EACH VERTICAL TS.
75. 8" COLD ROLLED METAL STUDS @ 24" O/C, INFILLED BETWEEN TS. BY F.E.B.
76. CMU WALL WITH INSULATION FILL AS INDICATED.
77. GROUT FILLED BOND BEAM WITH REINFORCING, RE: STRUCTURAL.
78. 1 1/2" MASONRY LUG IN FOUNDATION, RE: STRUCTURAL.
79. CMU KNEE WALL WITH SOLID CAP.
80. WEIR HOLES AT 2'-0" O/C.
81. MASONRY CAVITY VENT AS SPECIFIED.
82. MASTIC.
83. METAL REGLET.
84. SPRINGLOCK FLASHING.
85. EAVE STRUT.
86. SATELLITE SUPPORT DECK, RE: DETAILS ON SHEET A4.5.
87. F.E.B. MANUFACTURER TO PROVIDE TS, 6"x4 1/4" @ 48" O/C FOR LIGHT GAUGE STEEL STUD SUPPORT.

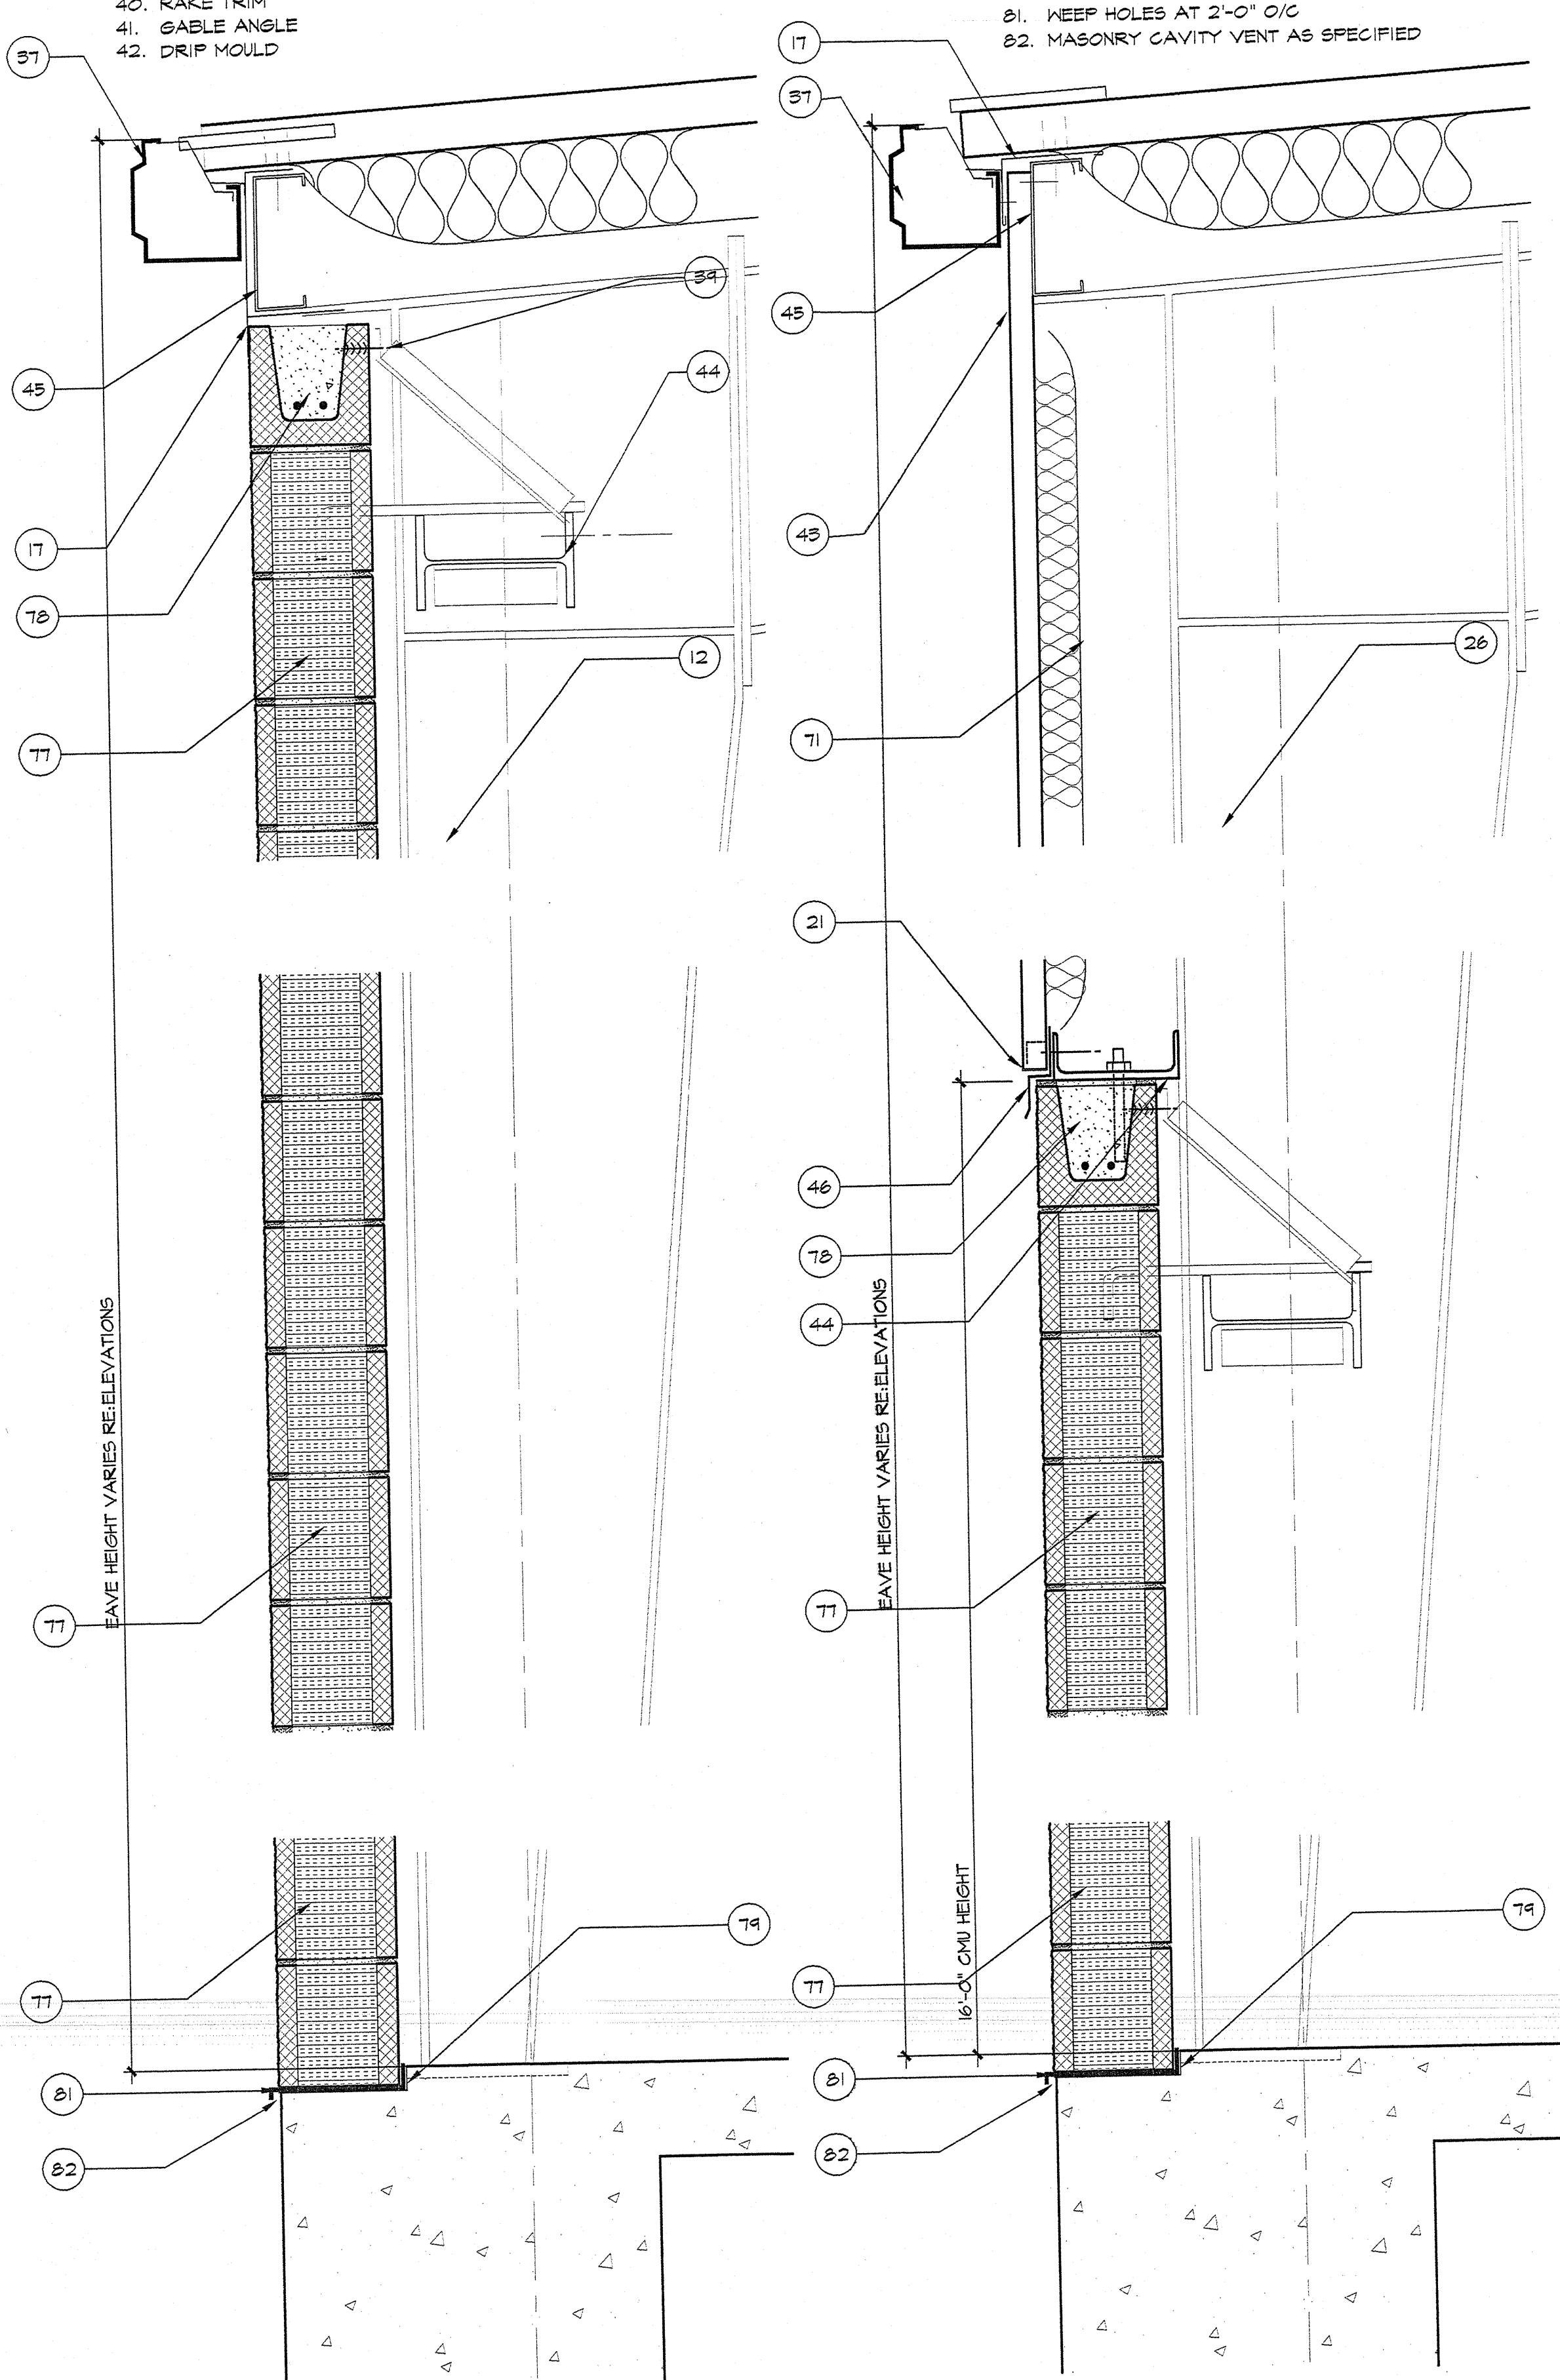


09 WALL SECTION @ WASH BAY SCALE 1 1/2" = 1'-0"

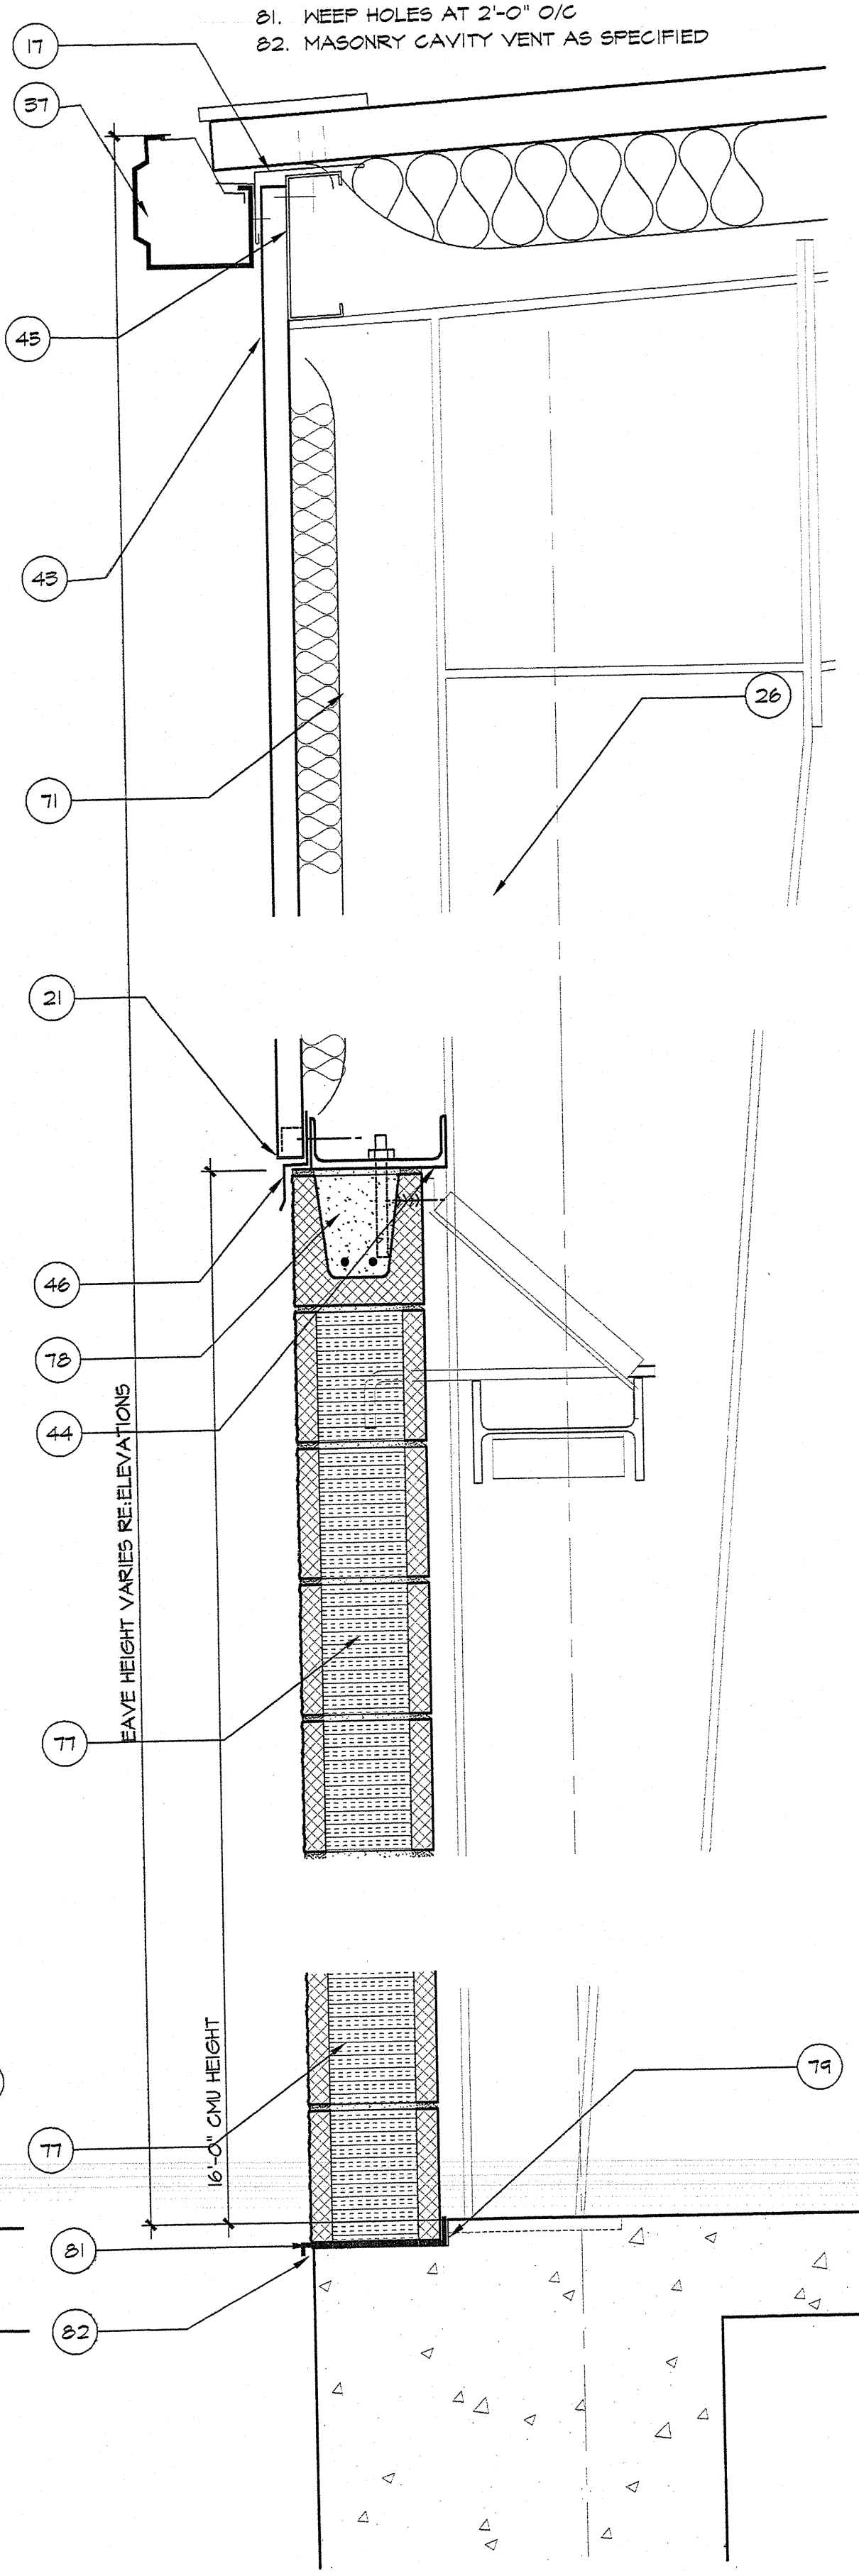


05 WALL SECTION @ WASH BAY SCALE 1 1/2" = 1'-0"

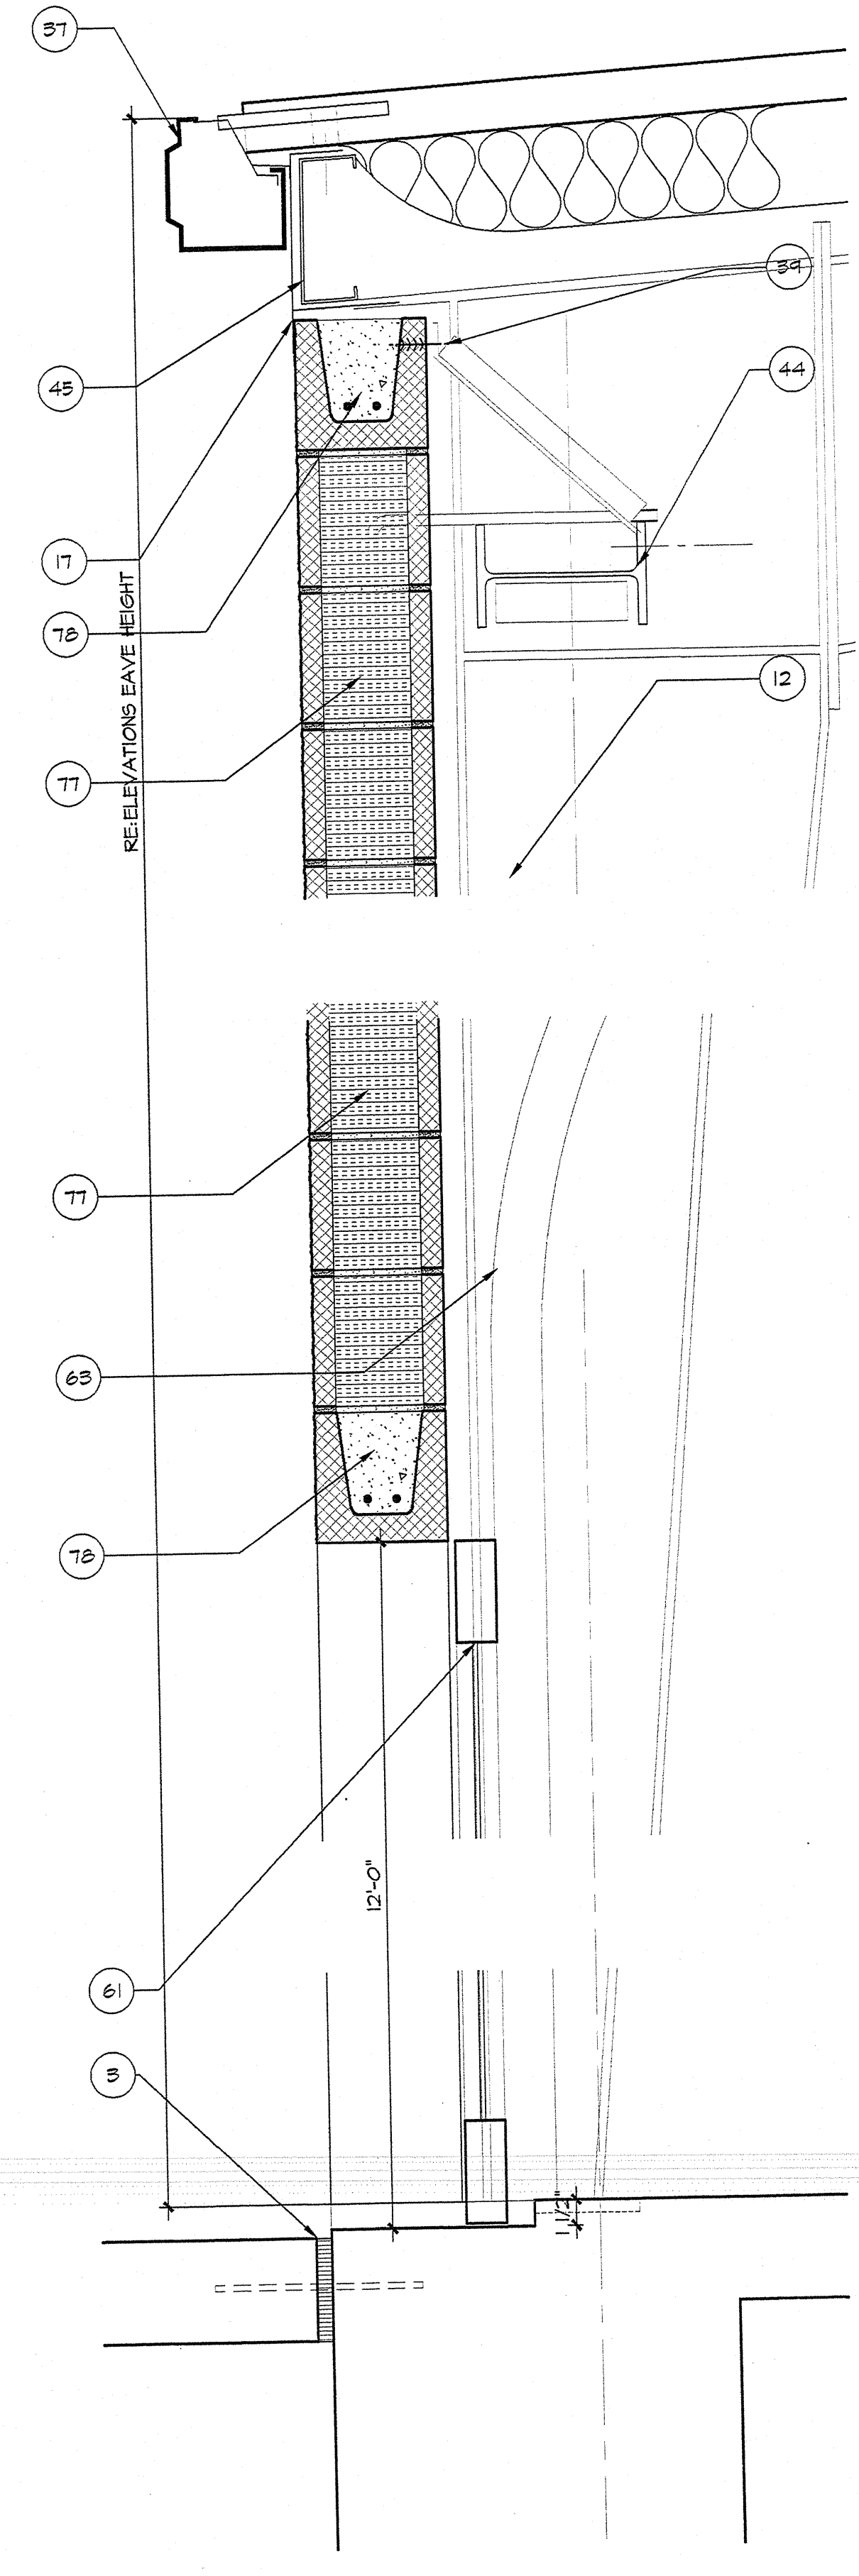


04 WALL SECTION @ SERVICE AREA SCALE 1 1/2" = 1'-0"

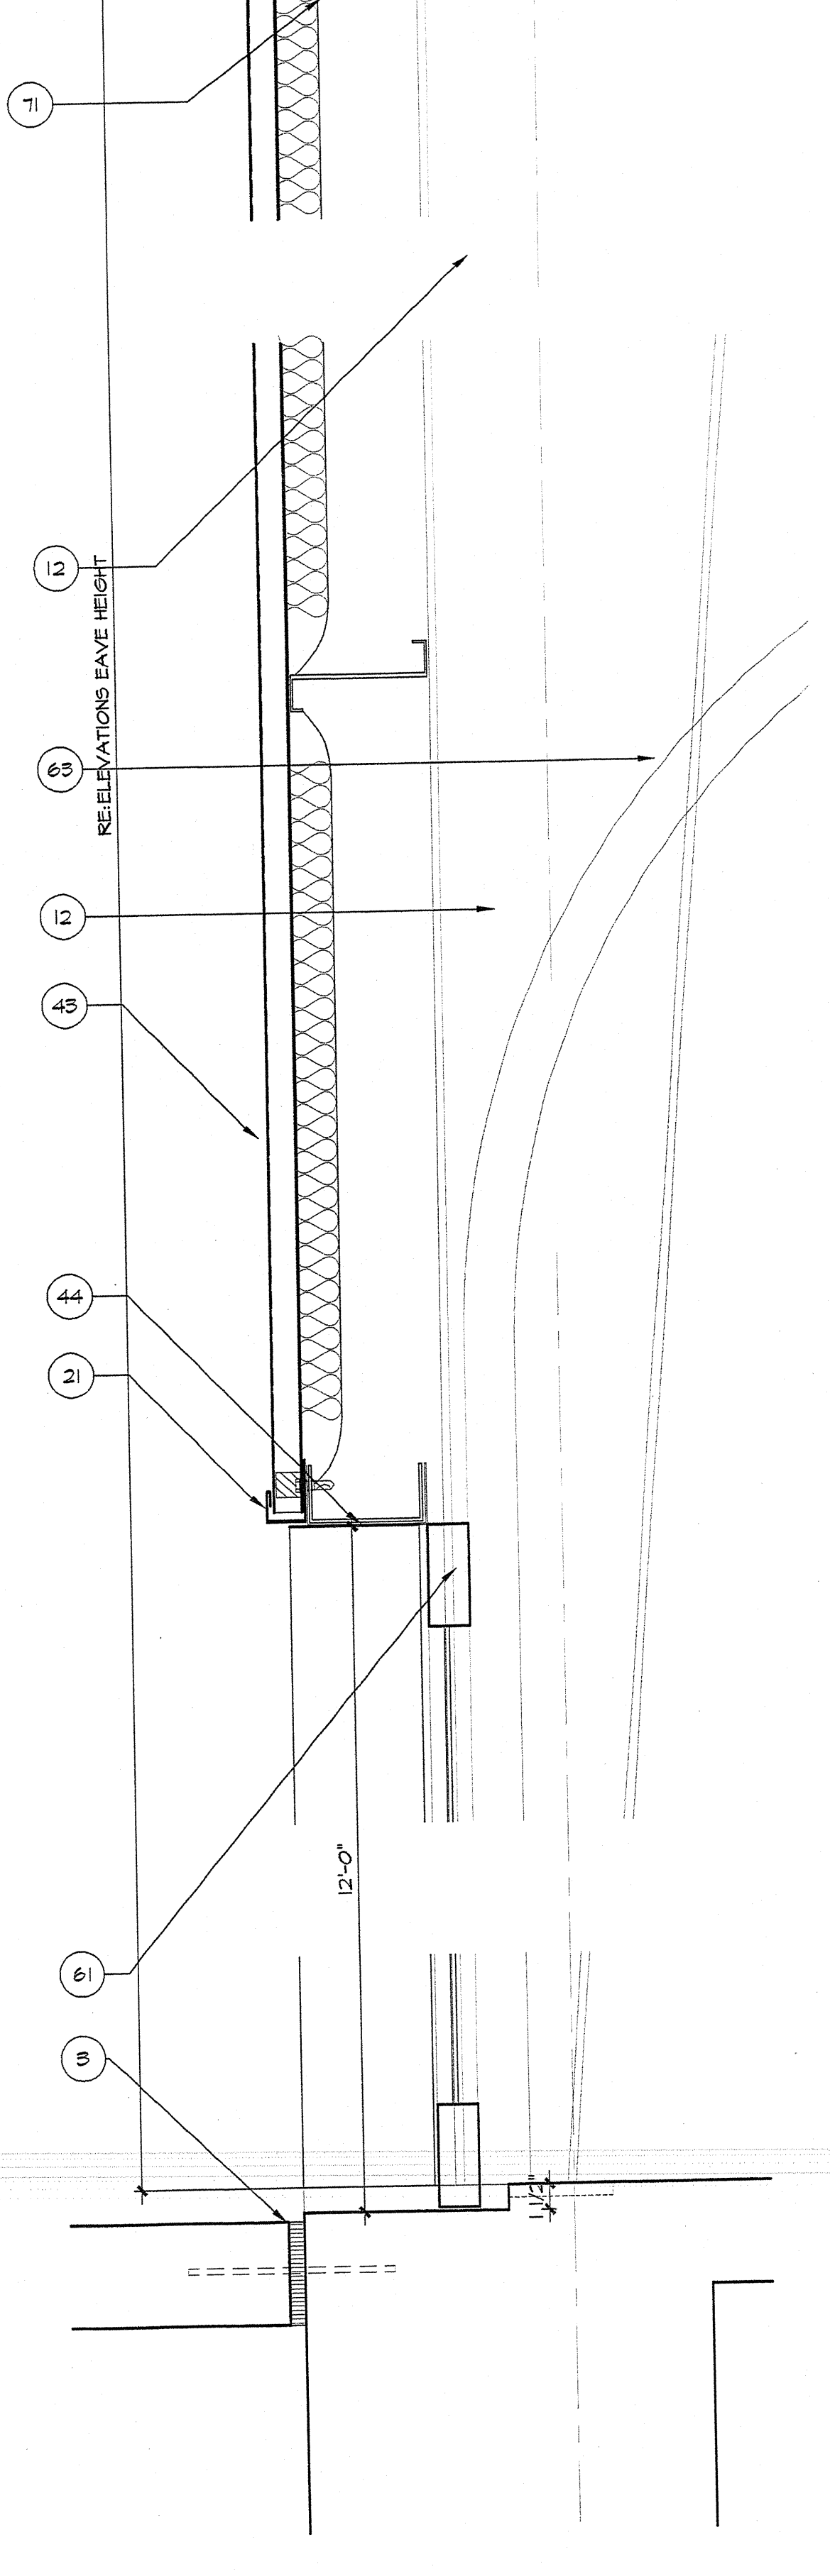

03 WALL SECTION @ SERVICE AREA SCALE 1 1/2" = 1'-0"

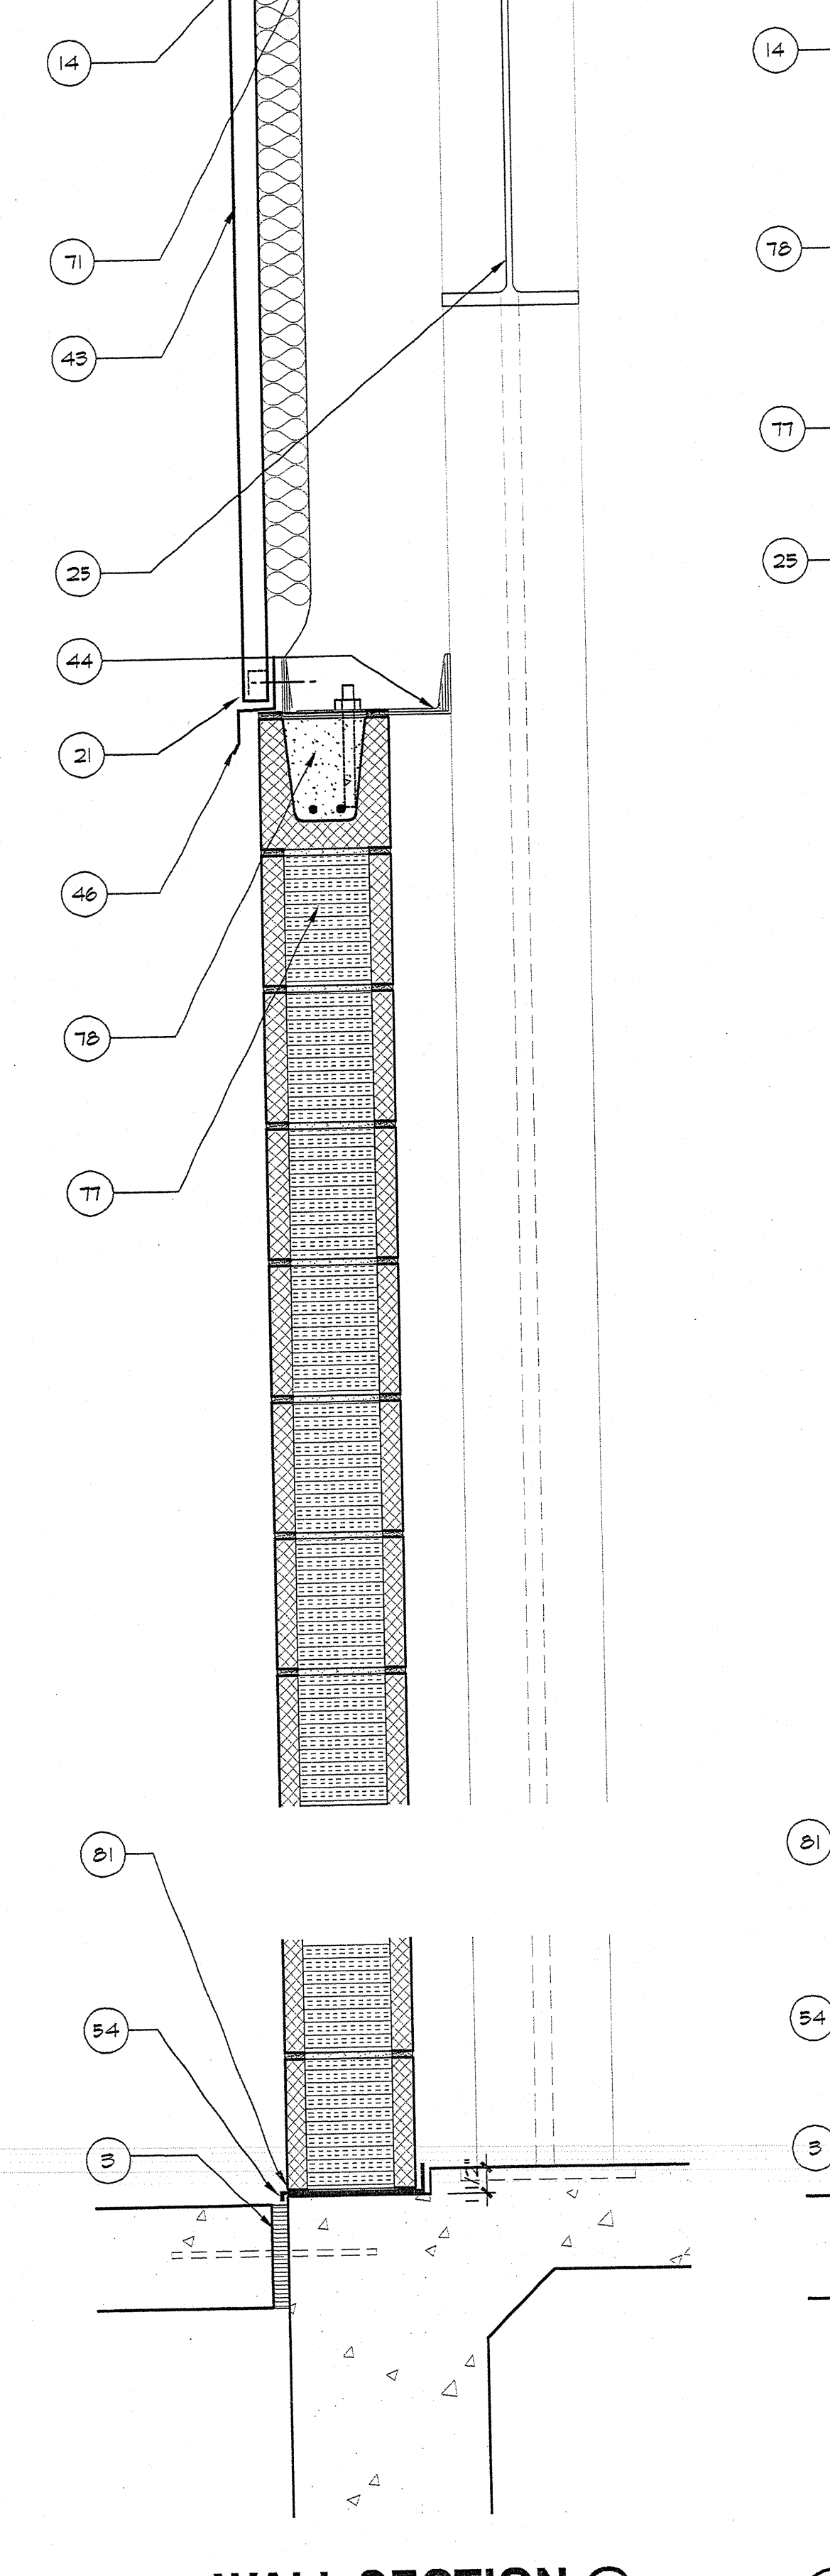

02 WALL SECTION @ SERVICE AREA SCALE 1 1/2" = 1'-0"

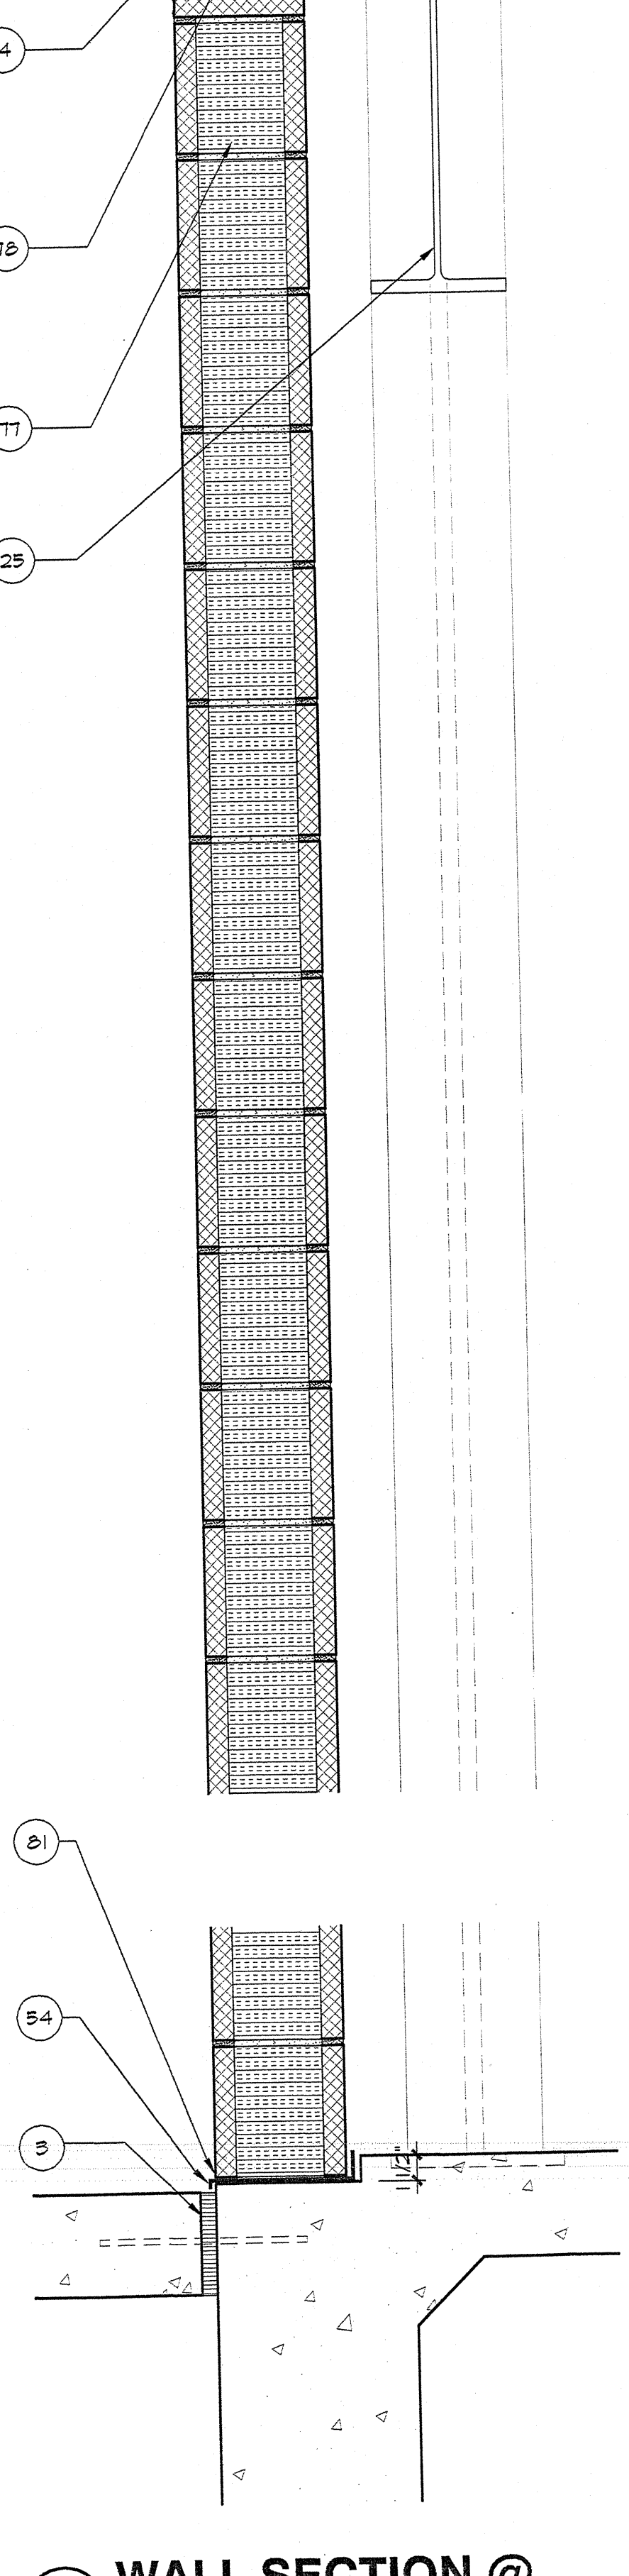

01 WALL SECTION @ SERVICE AREA SCALE 1 1/2" = 1'-0"

AN AUTOMOTIVE DEALERSHIP
ROGER BEASLEY VOLVO
INTERSTATE HIGHWAY 35 SOUTH
GEORGETOWN, TEXAS













EL SASSER ARCHITECTURAL INC.
ARCHITECTURE AND PLANNING
P.O. BOX 533 GEORGETOWN, TX 78627
(512) 553-5553 FAX (512) 553-5818 www.esai-llc.com


CONSULTANT INFORMATION:

DATE: 09/18/02
REVISION DATE:


PROJECT NO. 02008
SHEET NO.

A4.4

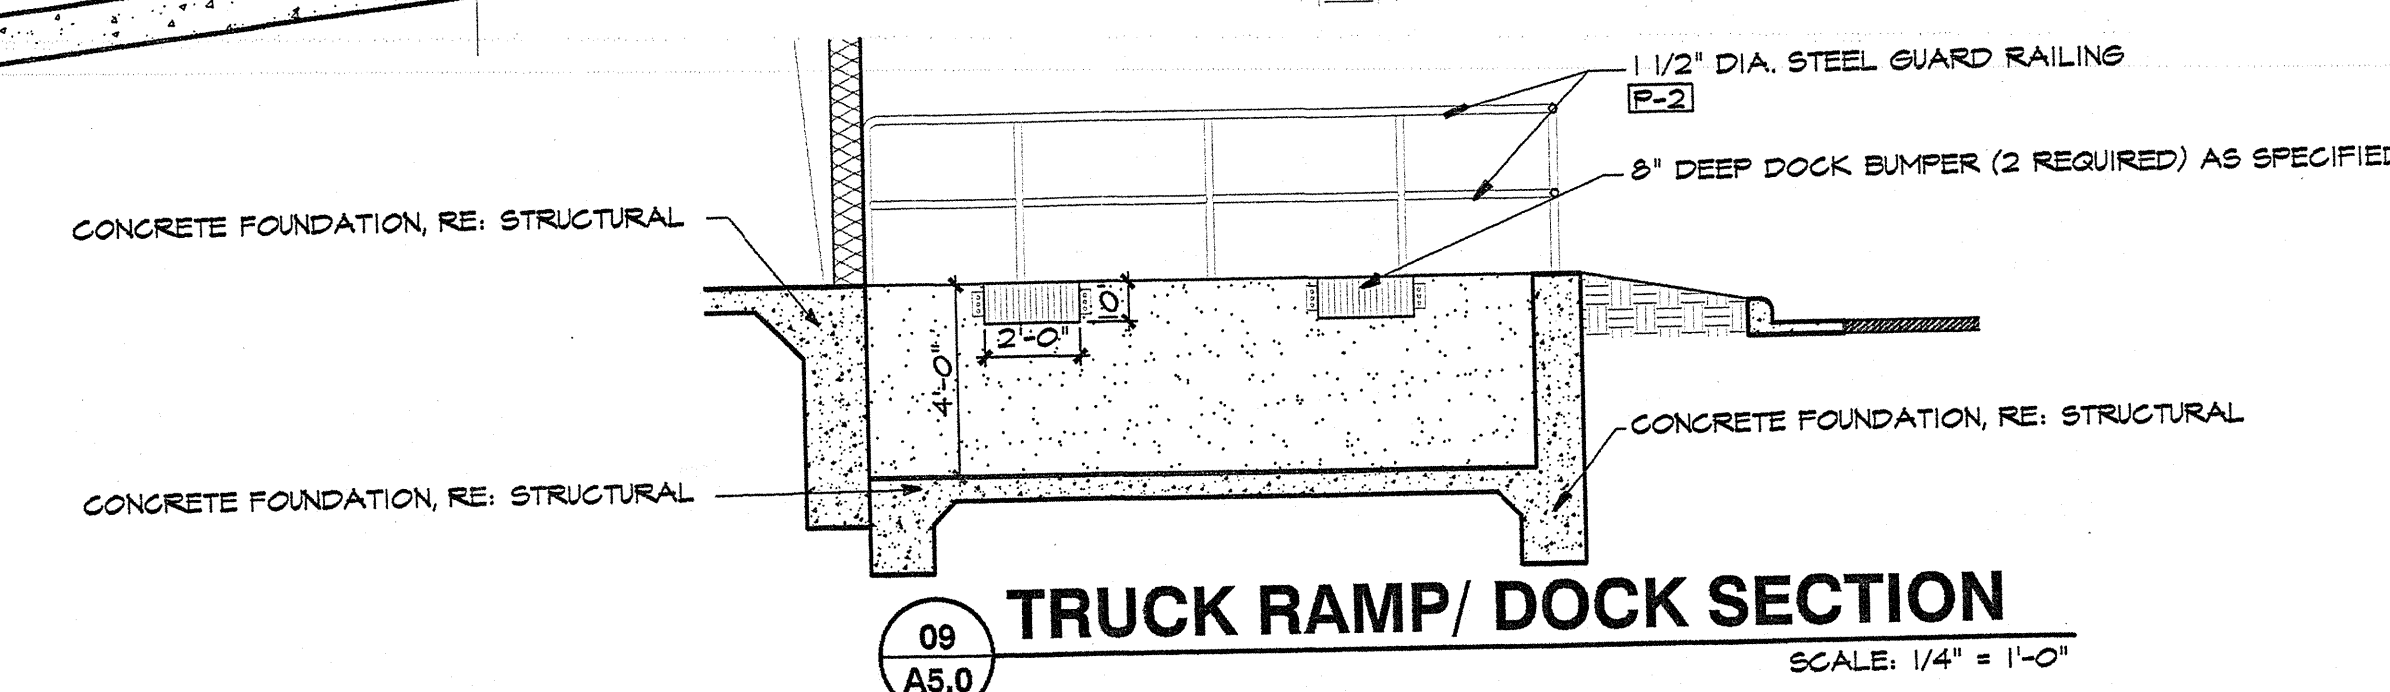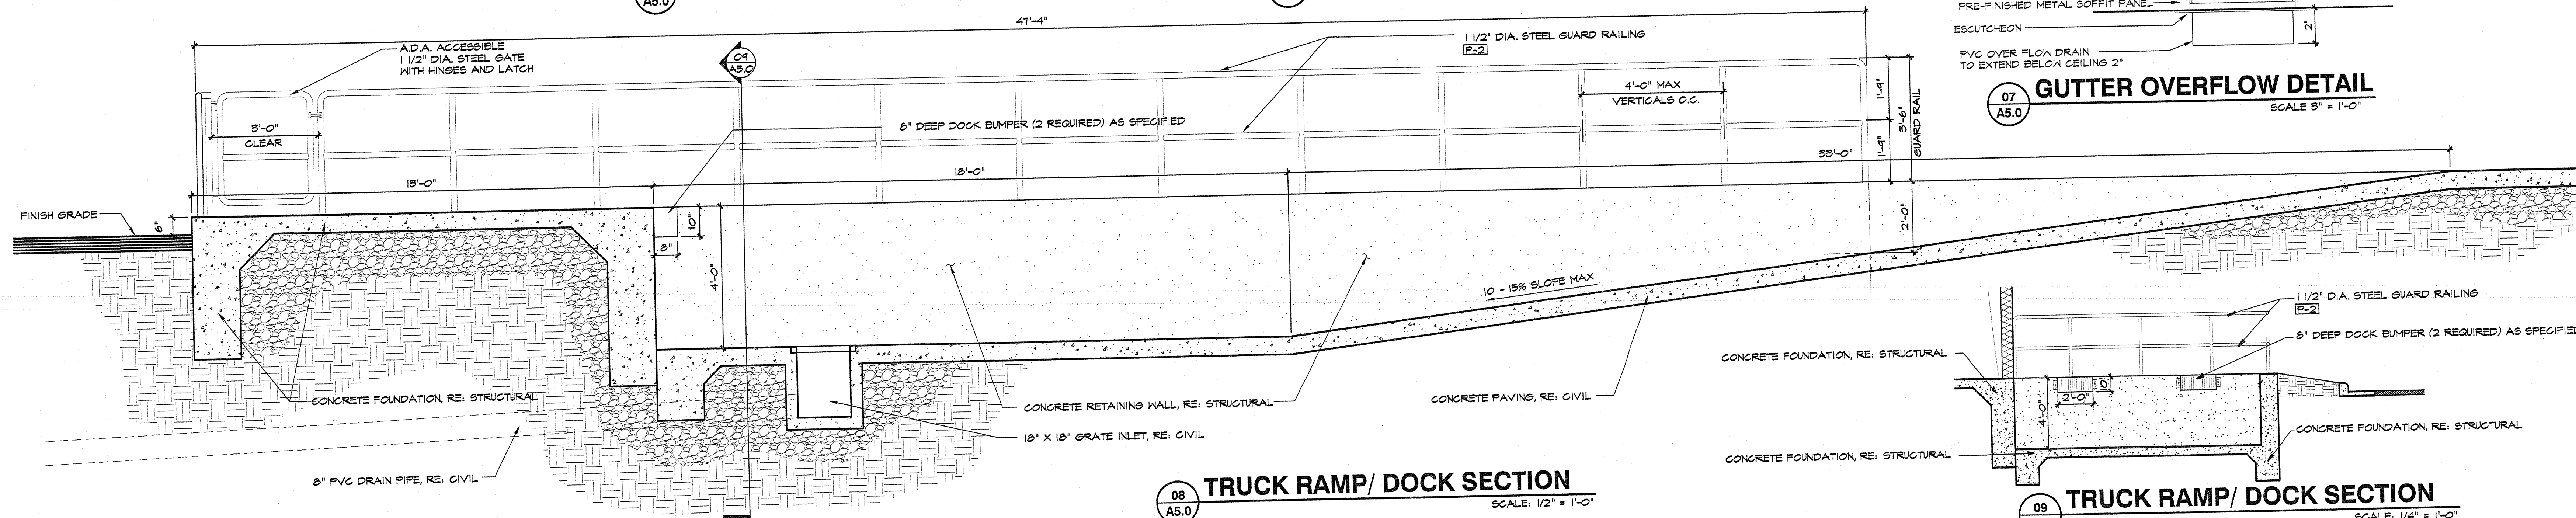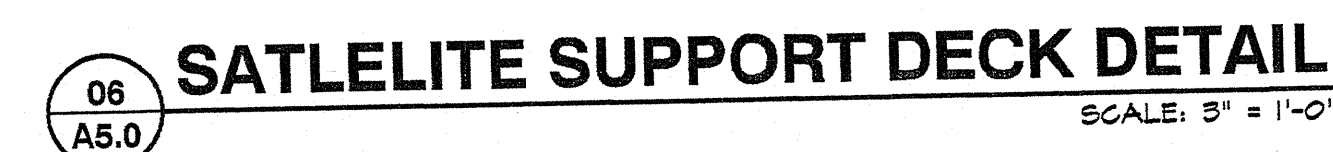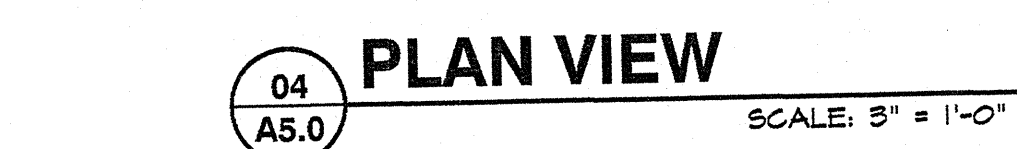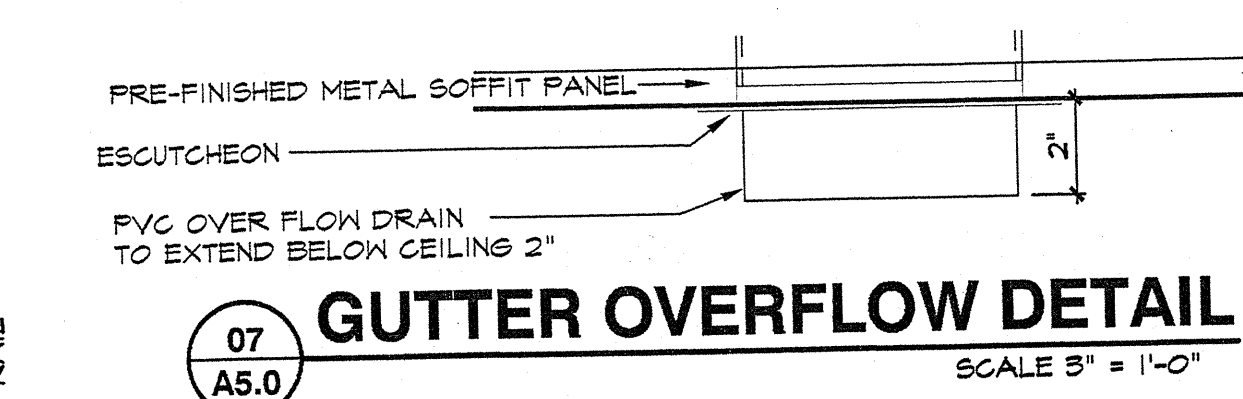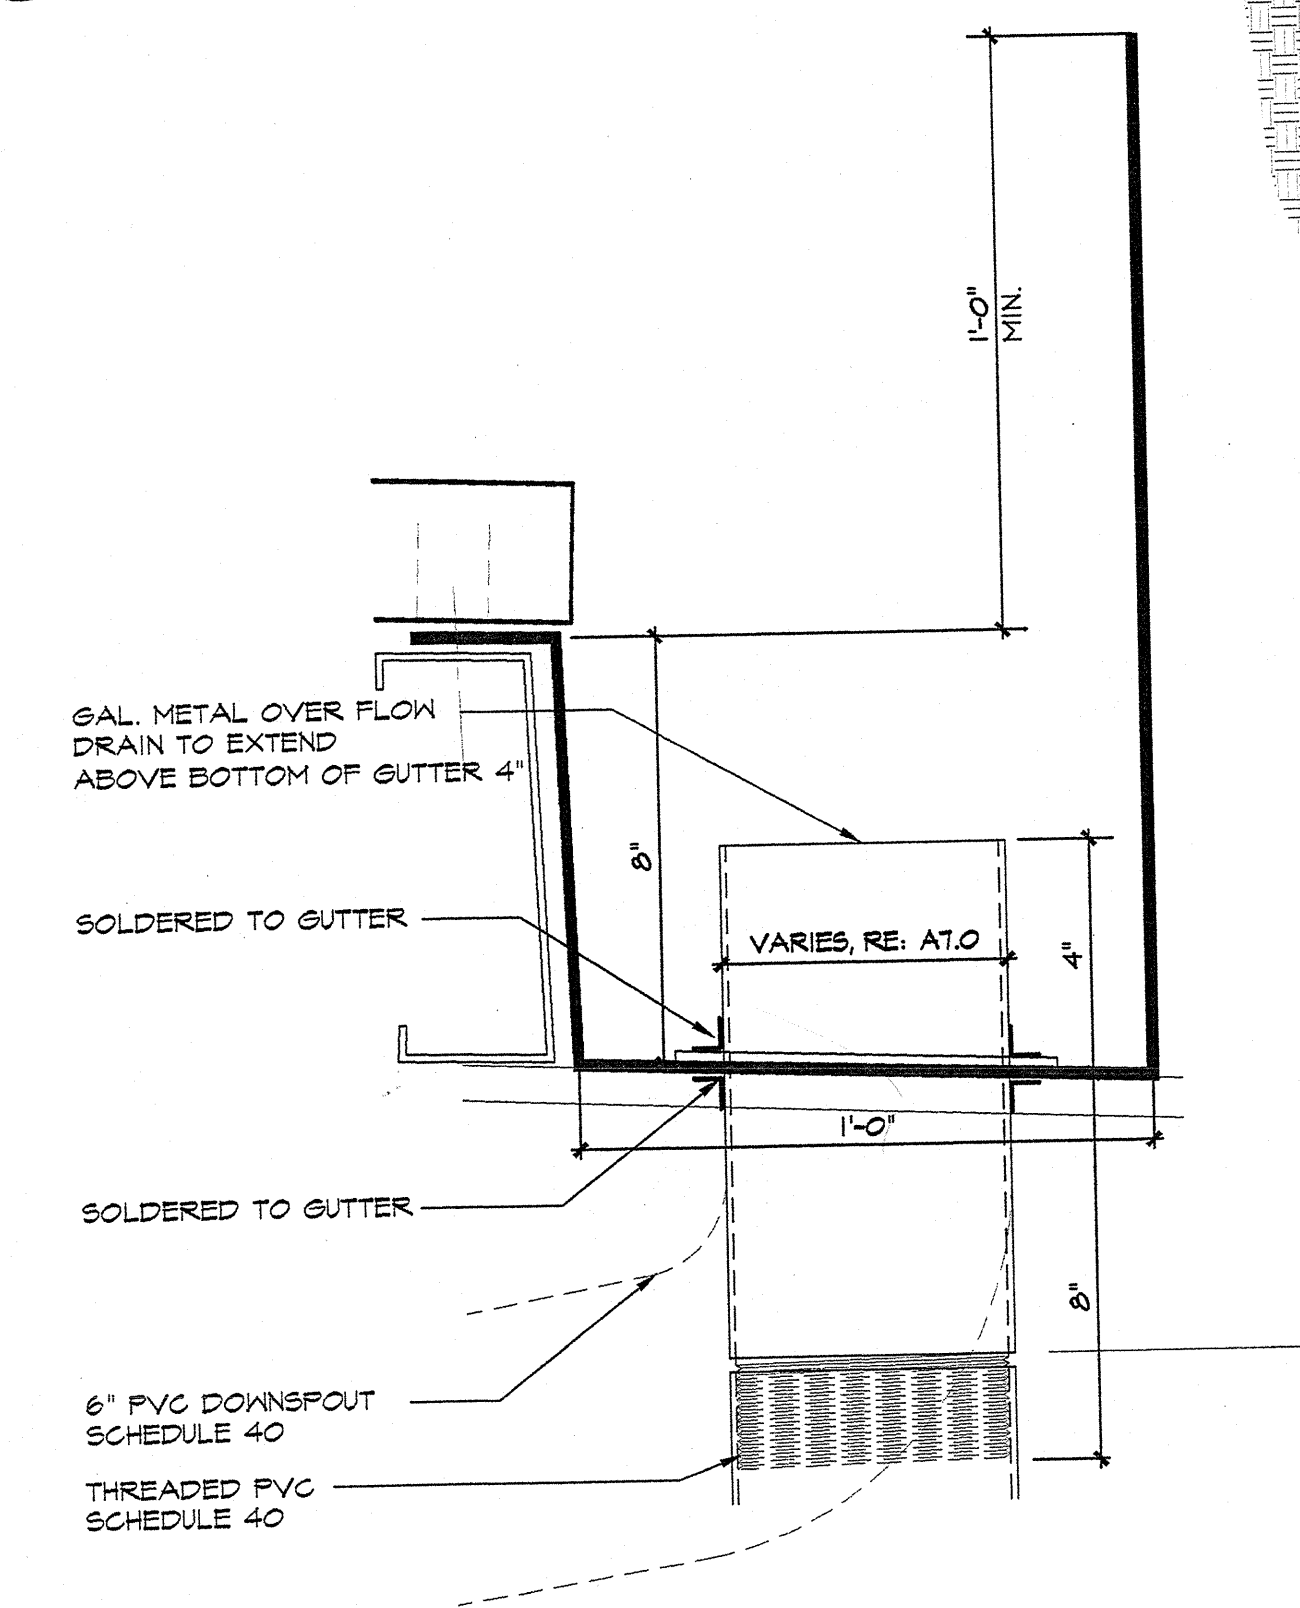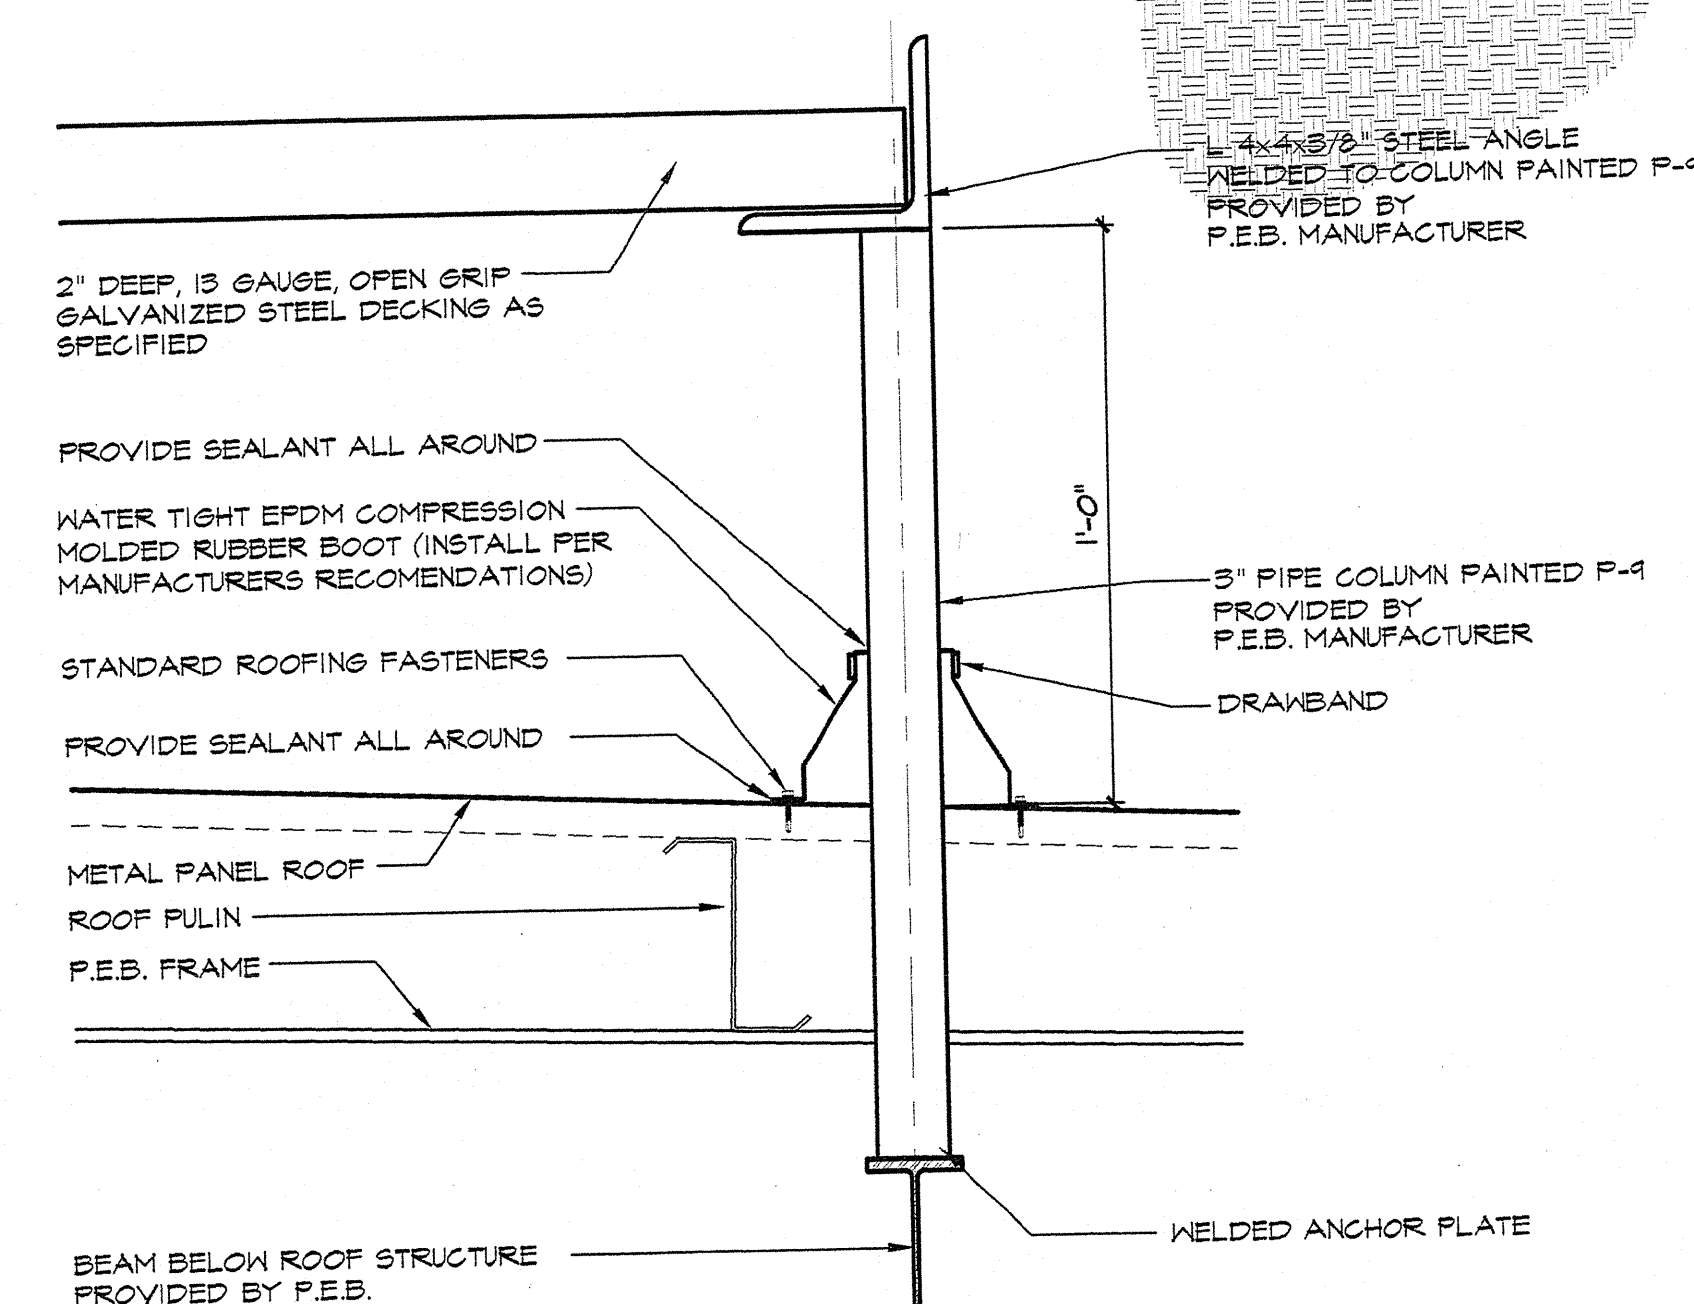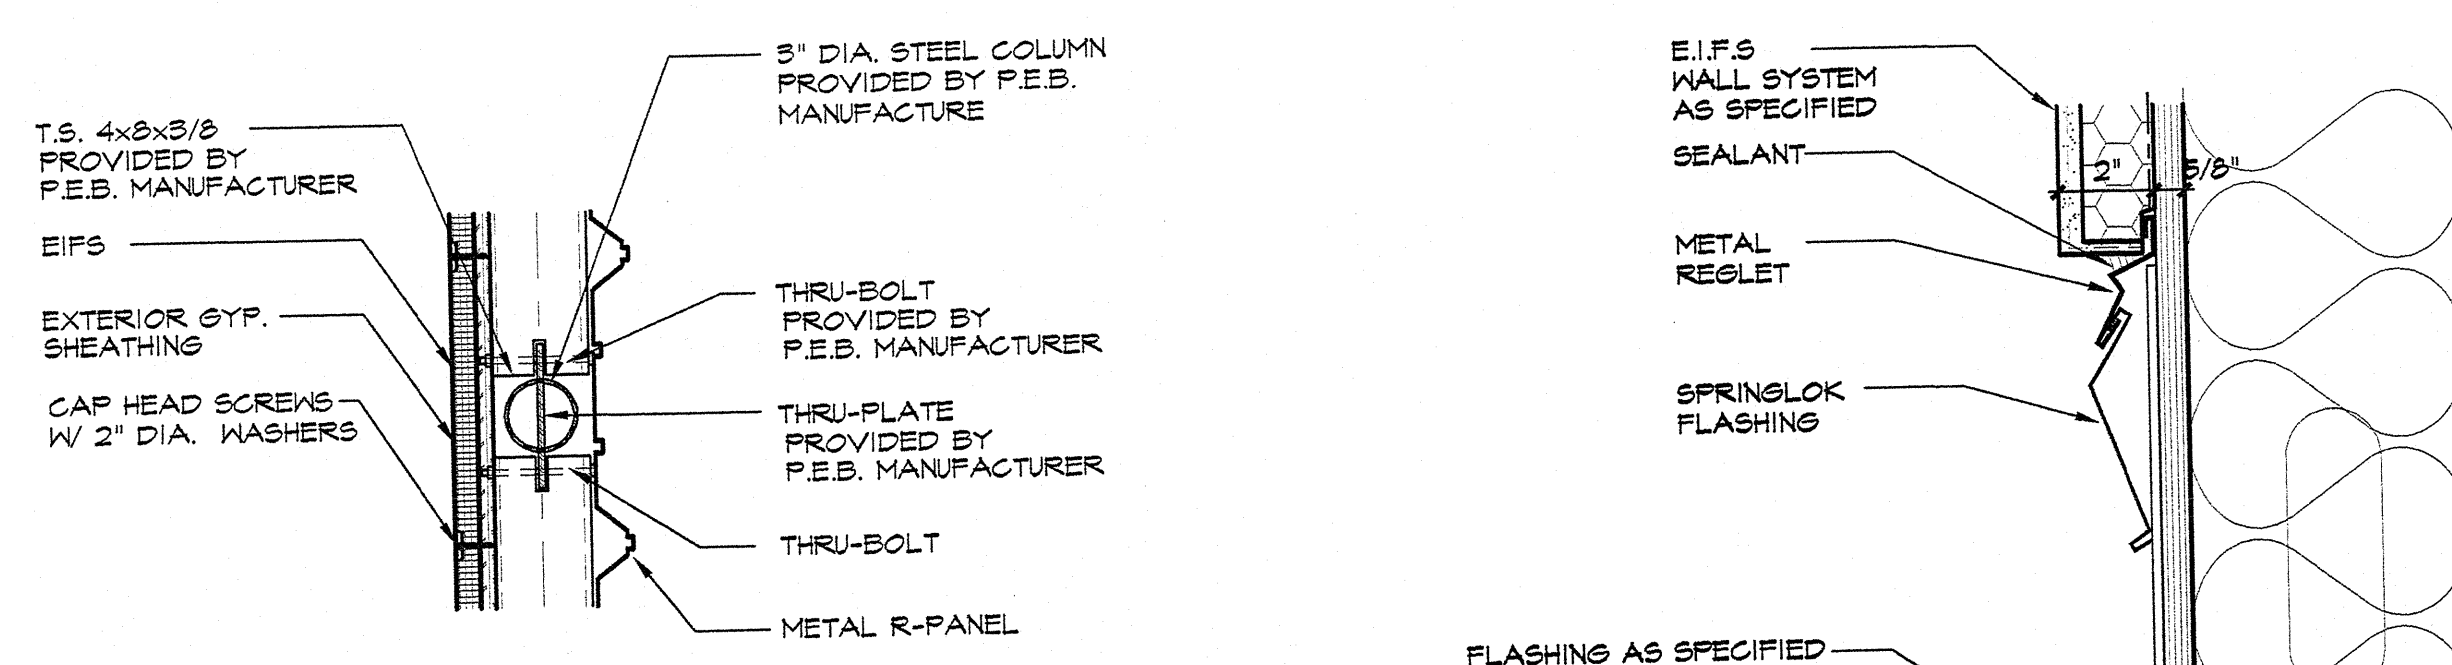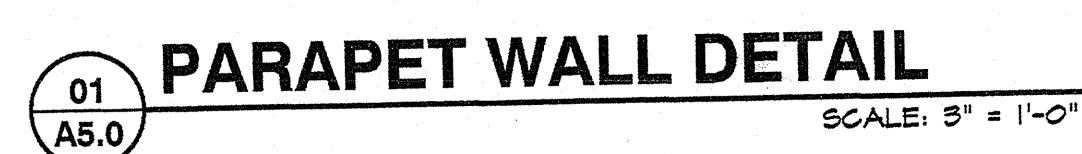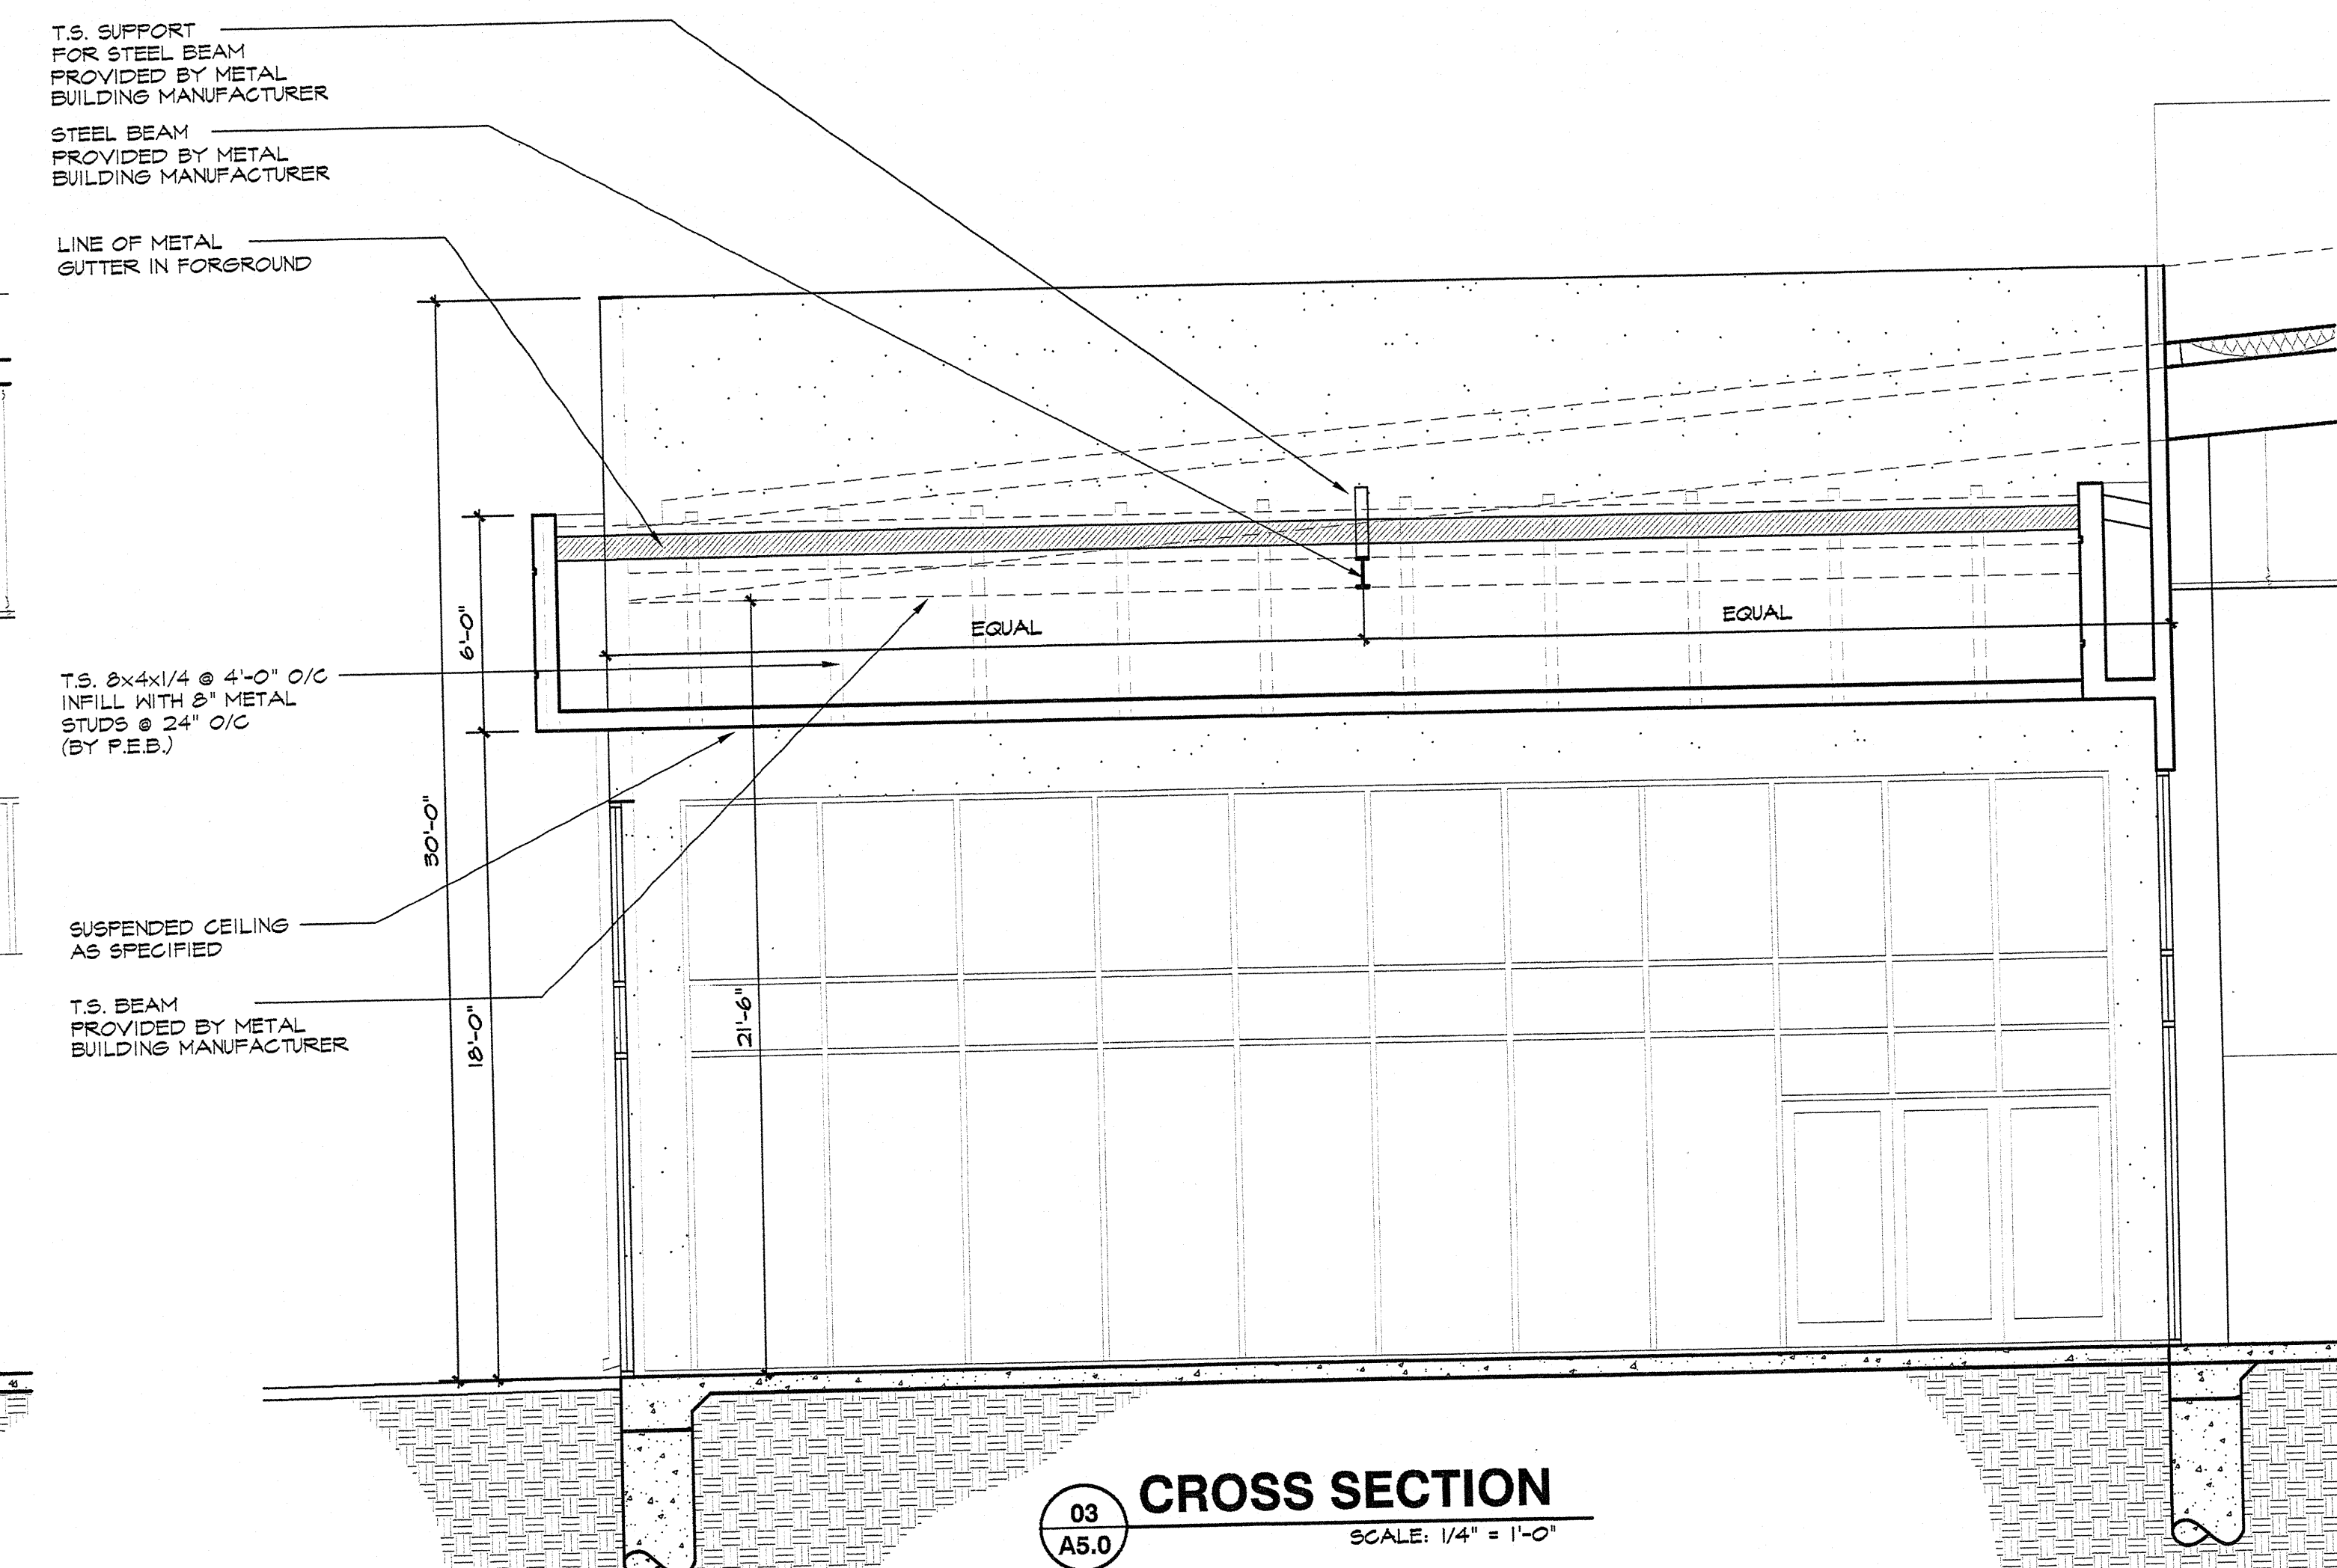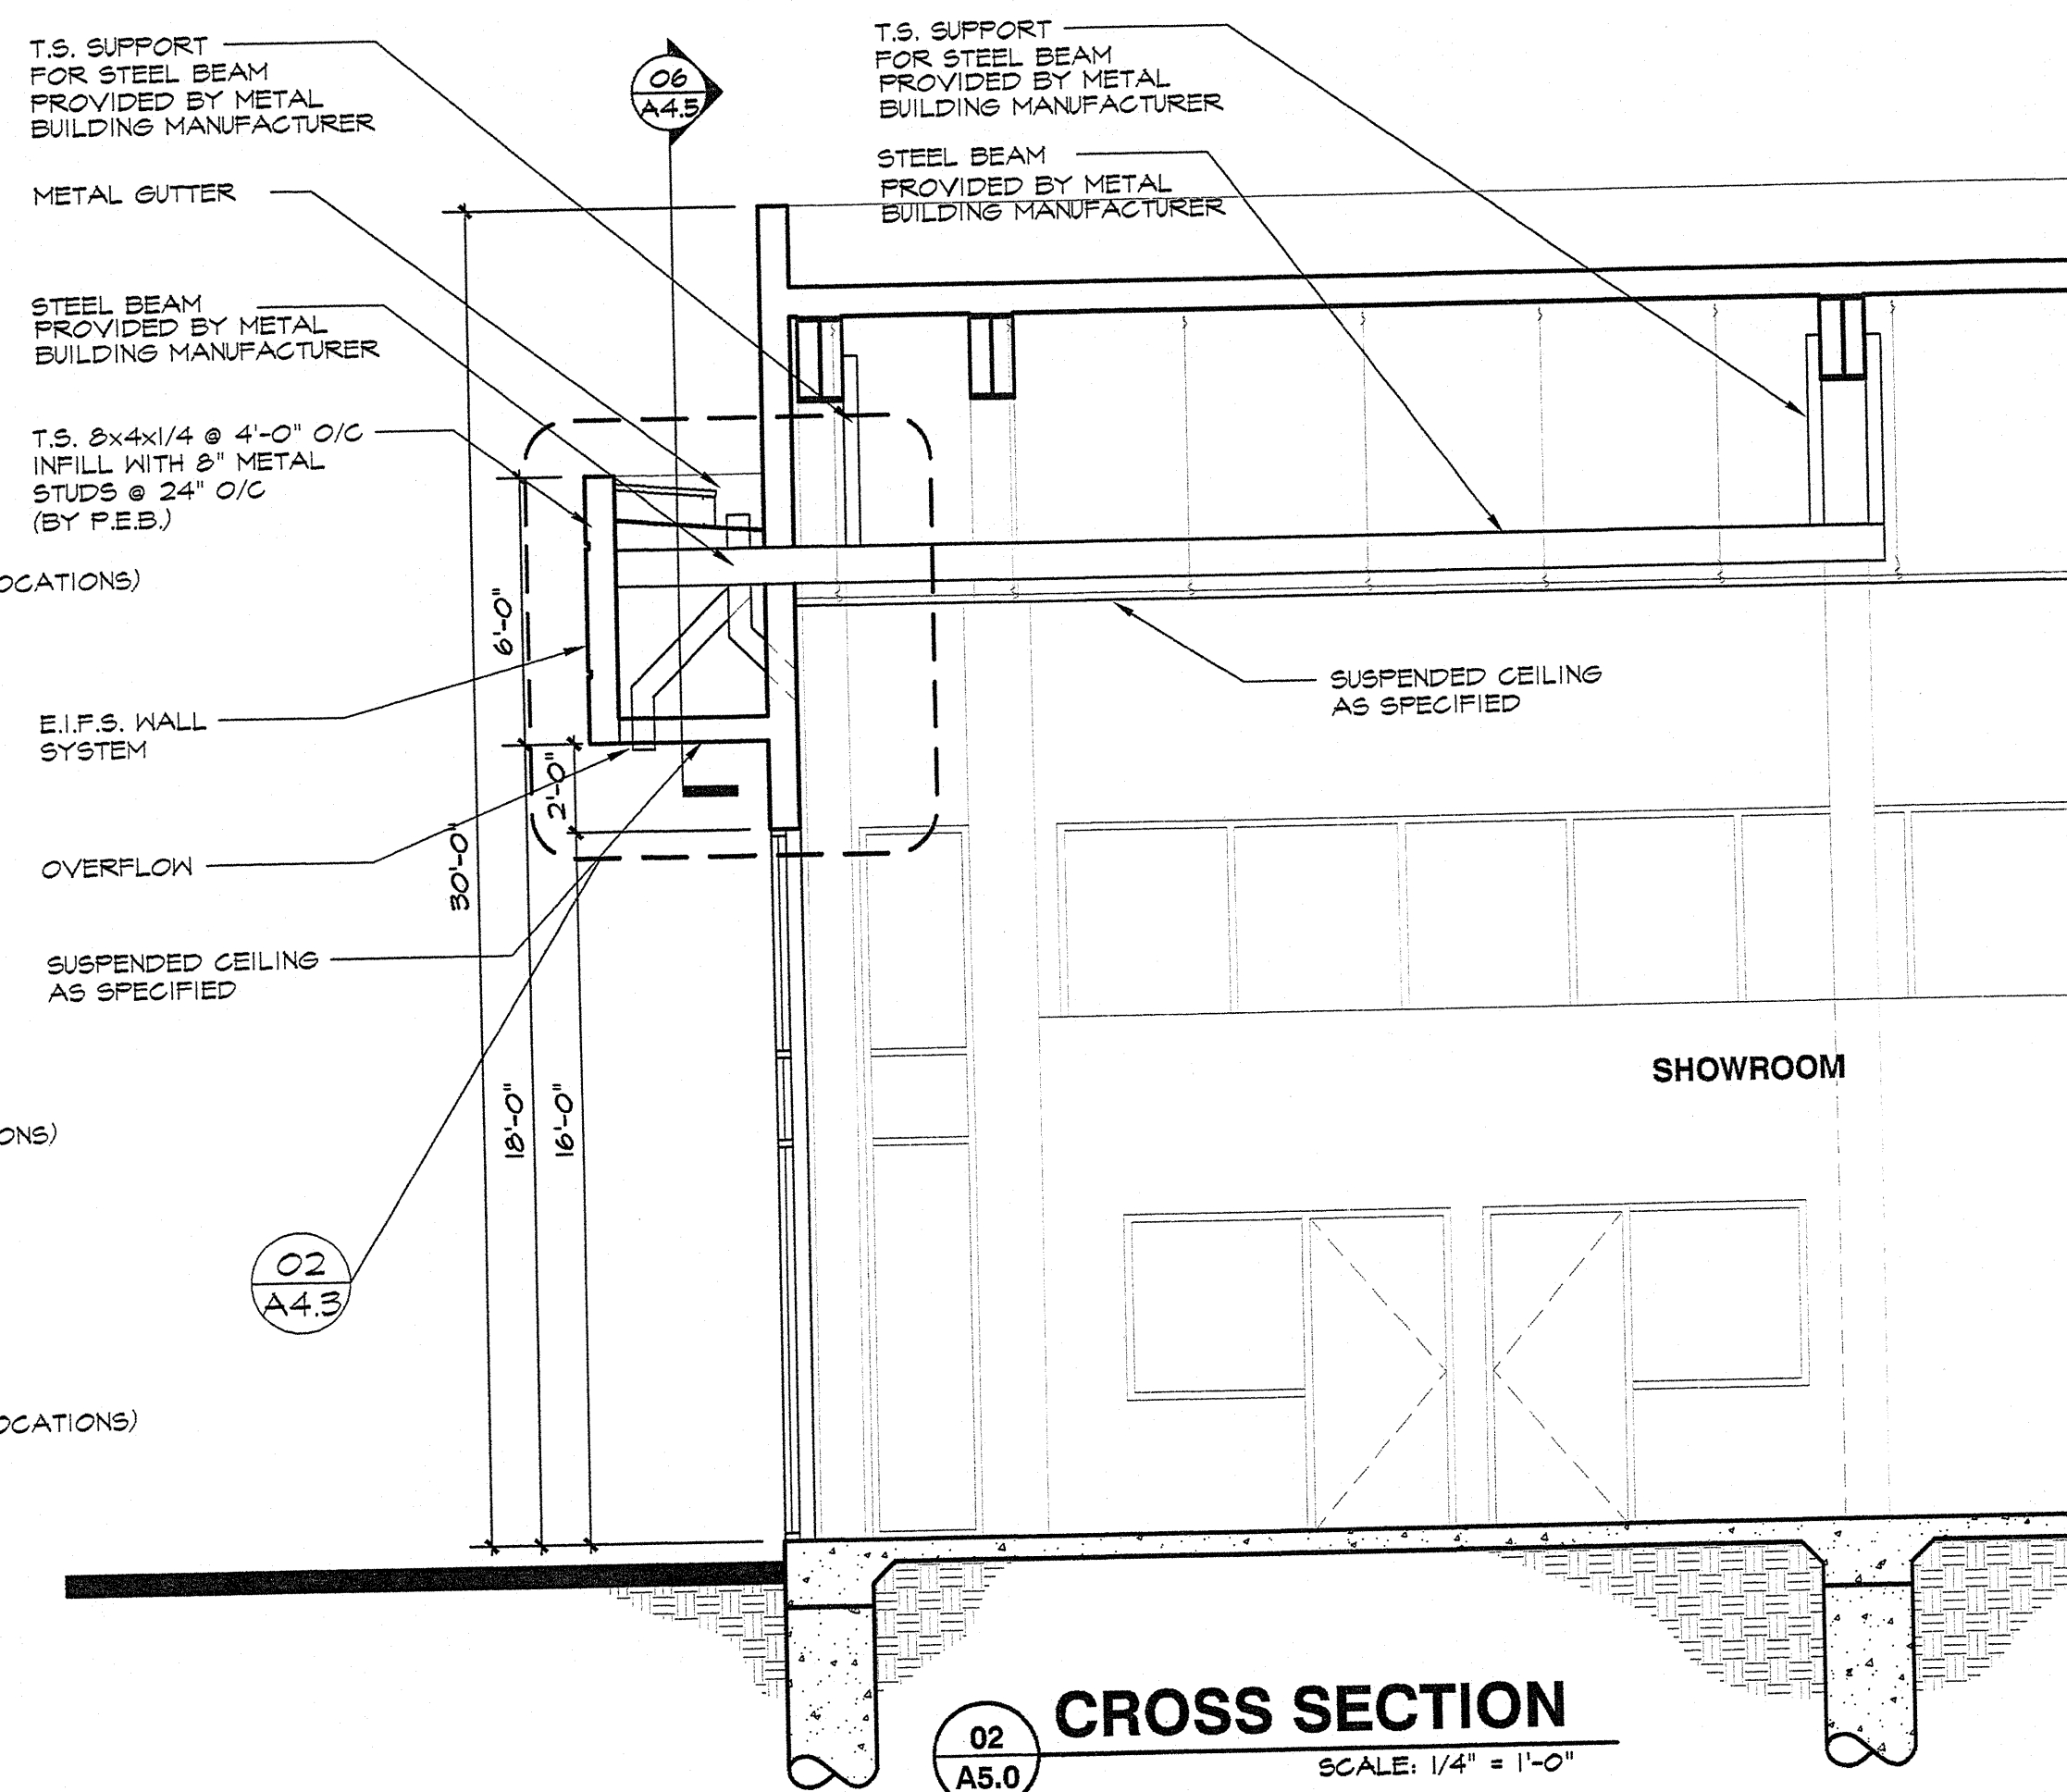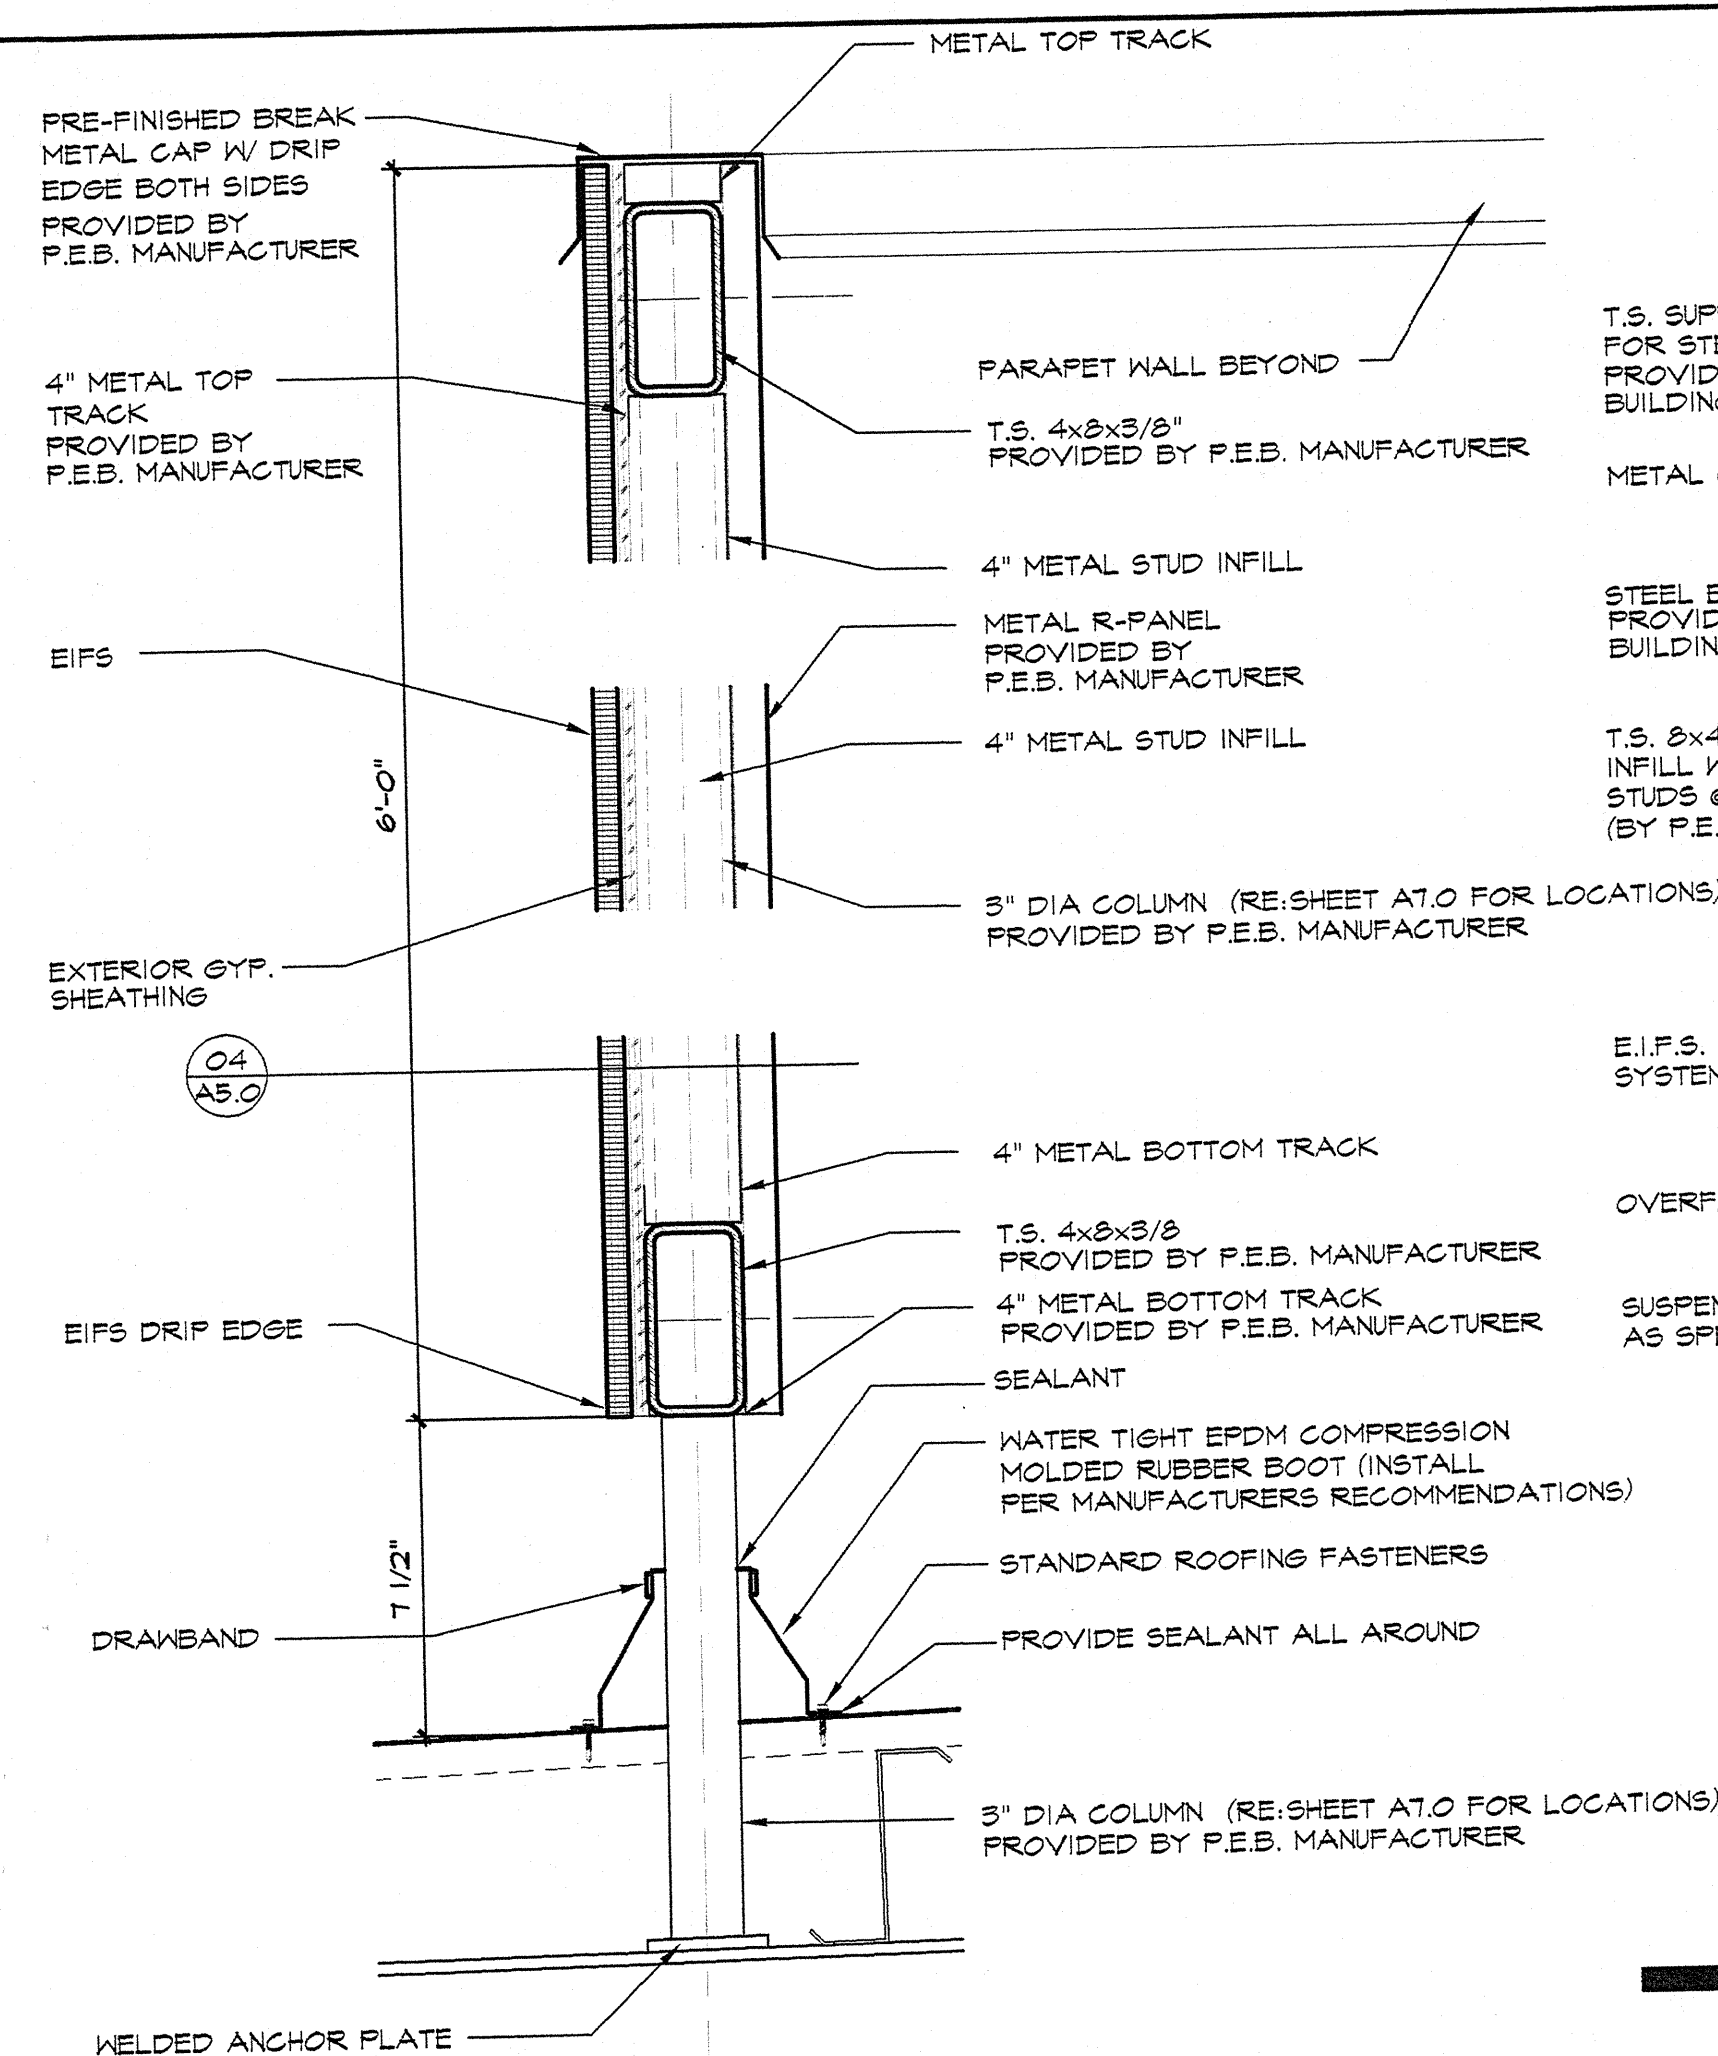


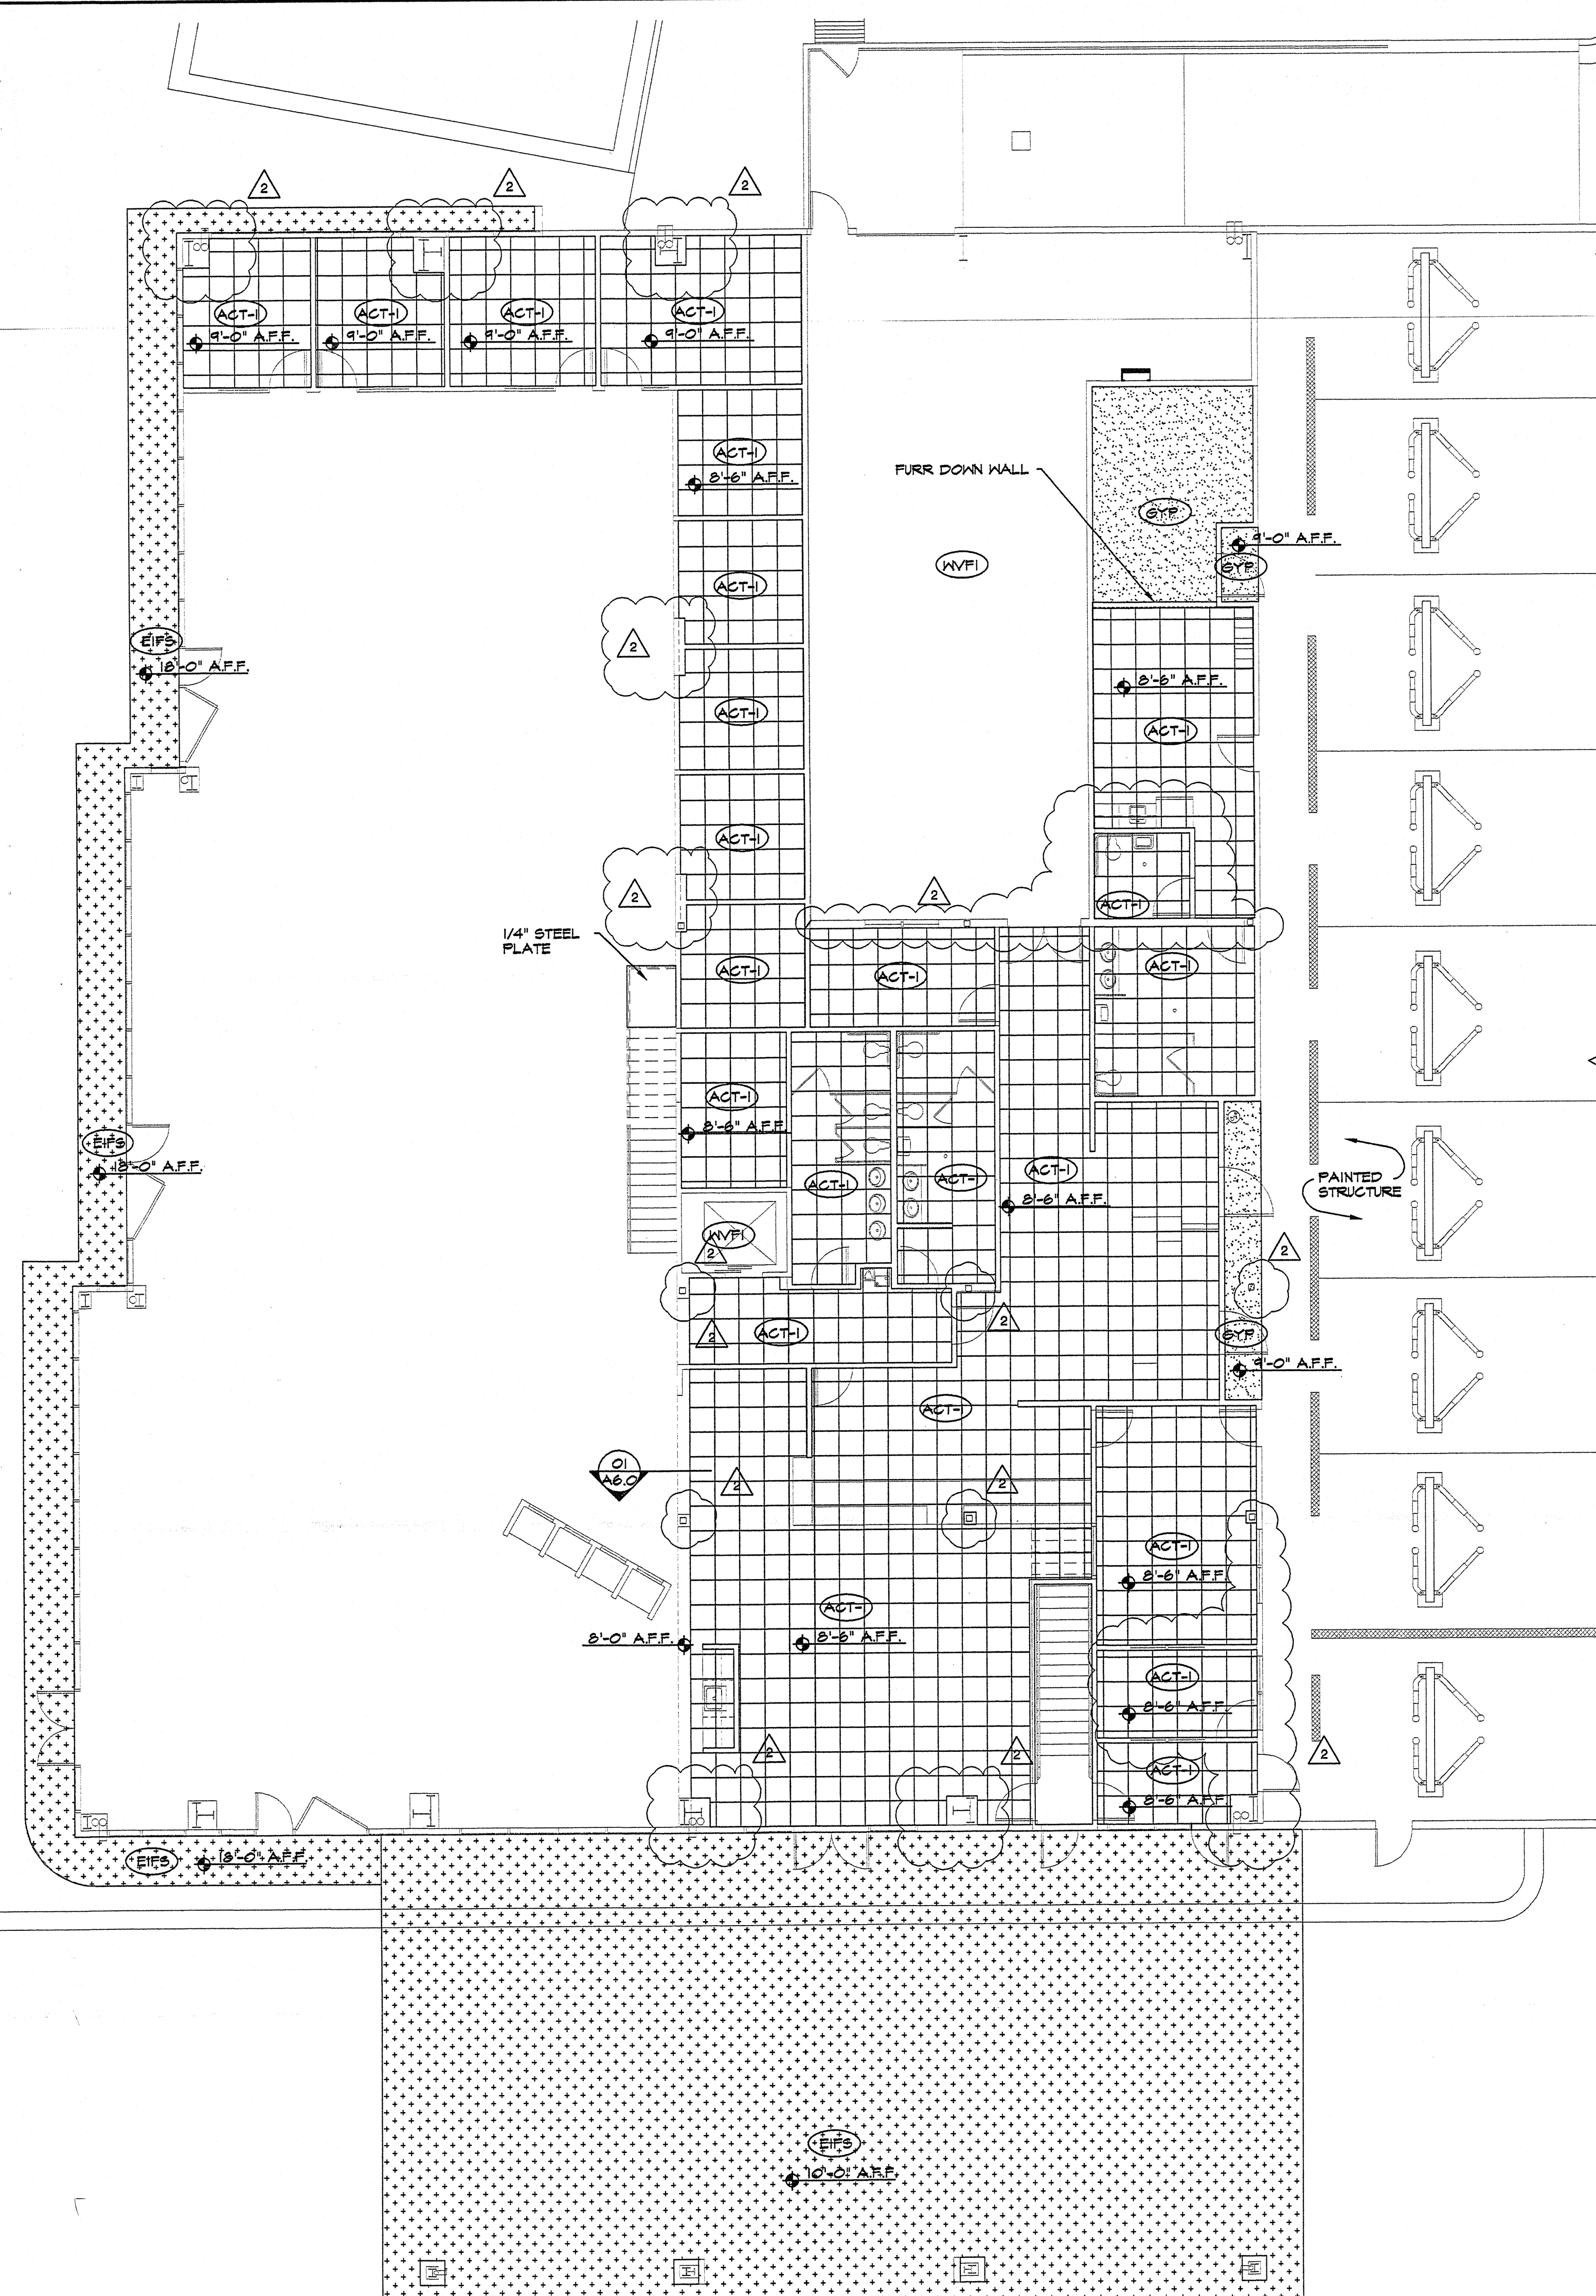

FIRST FLOOR REFLECTED CEILING PLAN
SCALE: 1/8" = 1'-0"

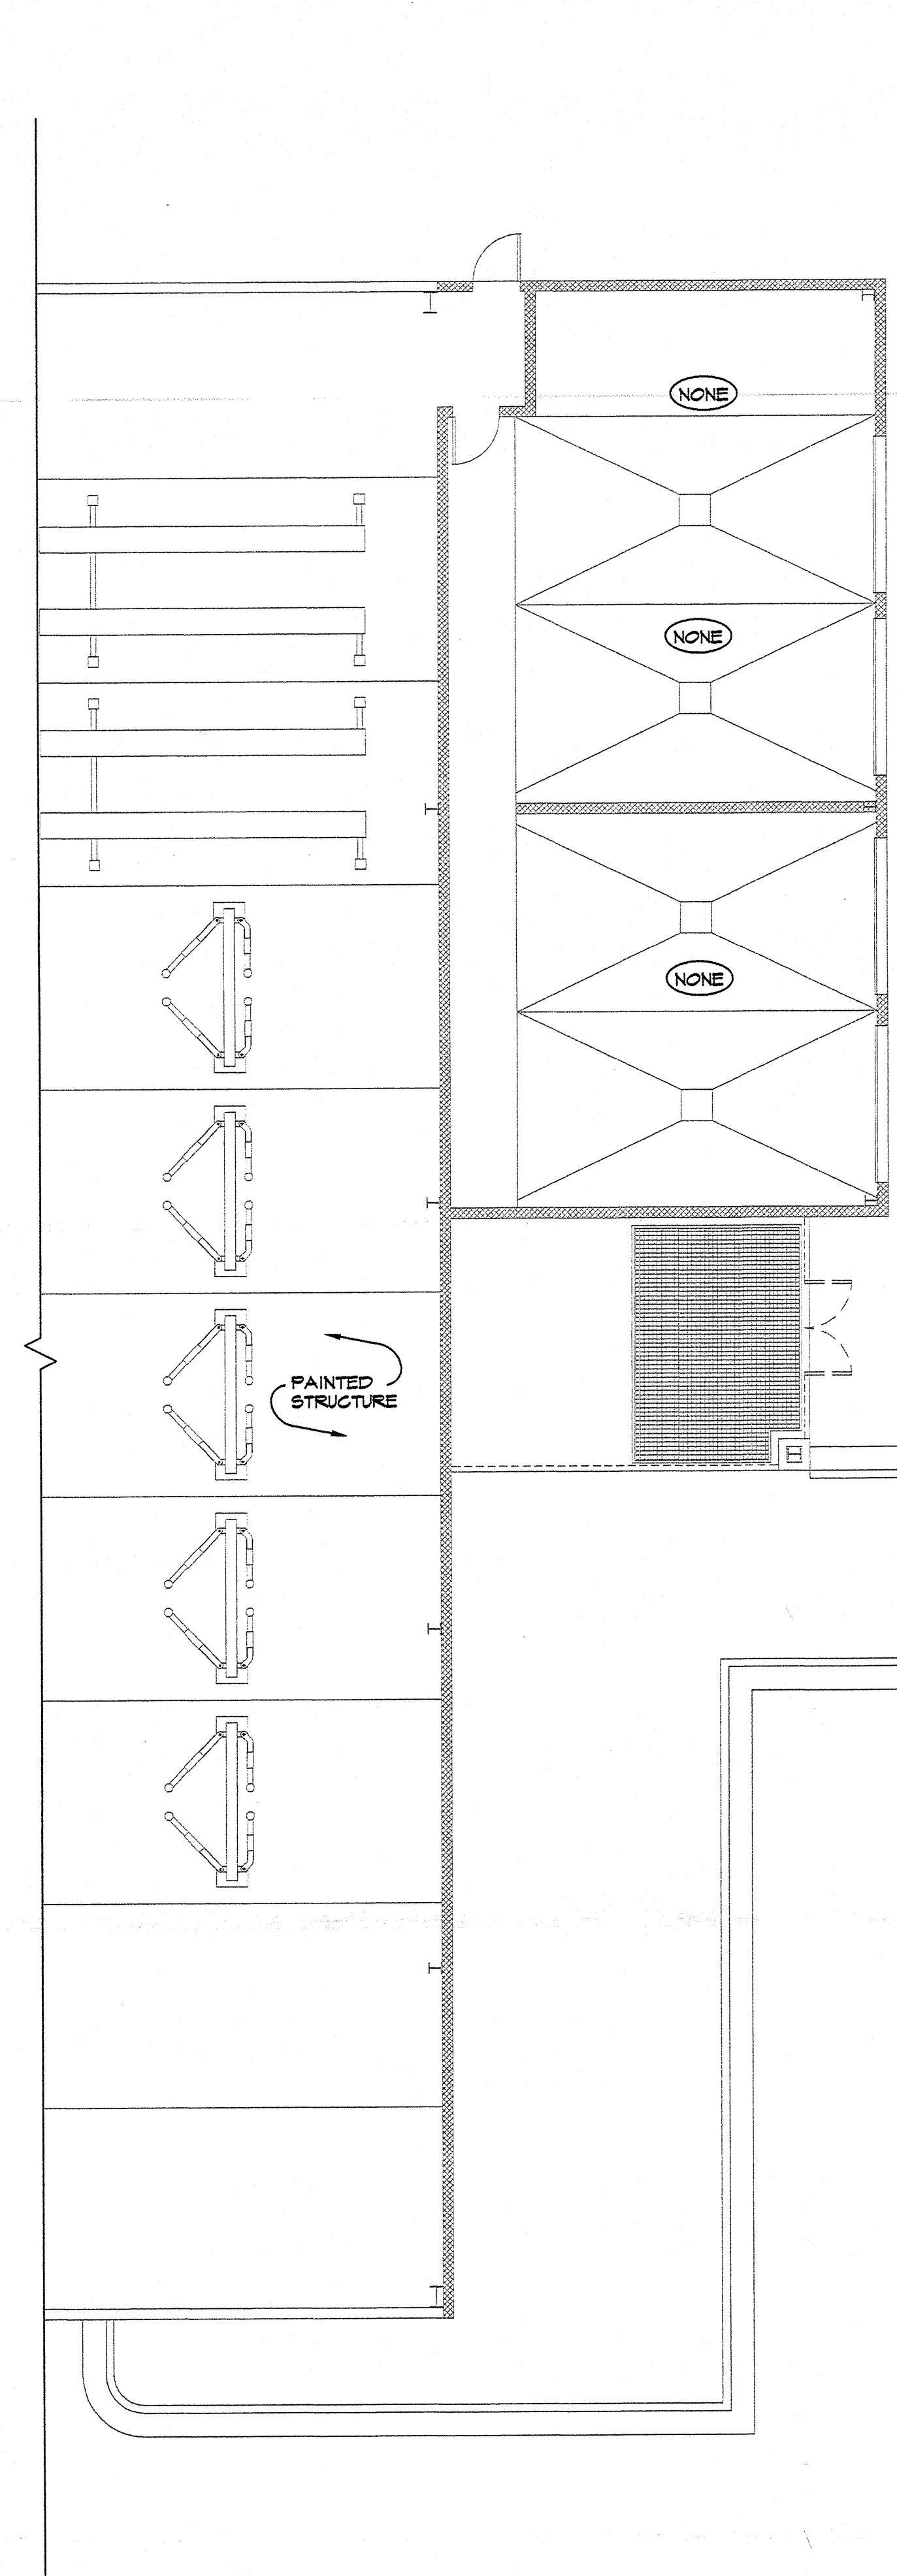

FURRDOWN SECTION
SCALE: 1" = 1'-0"

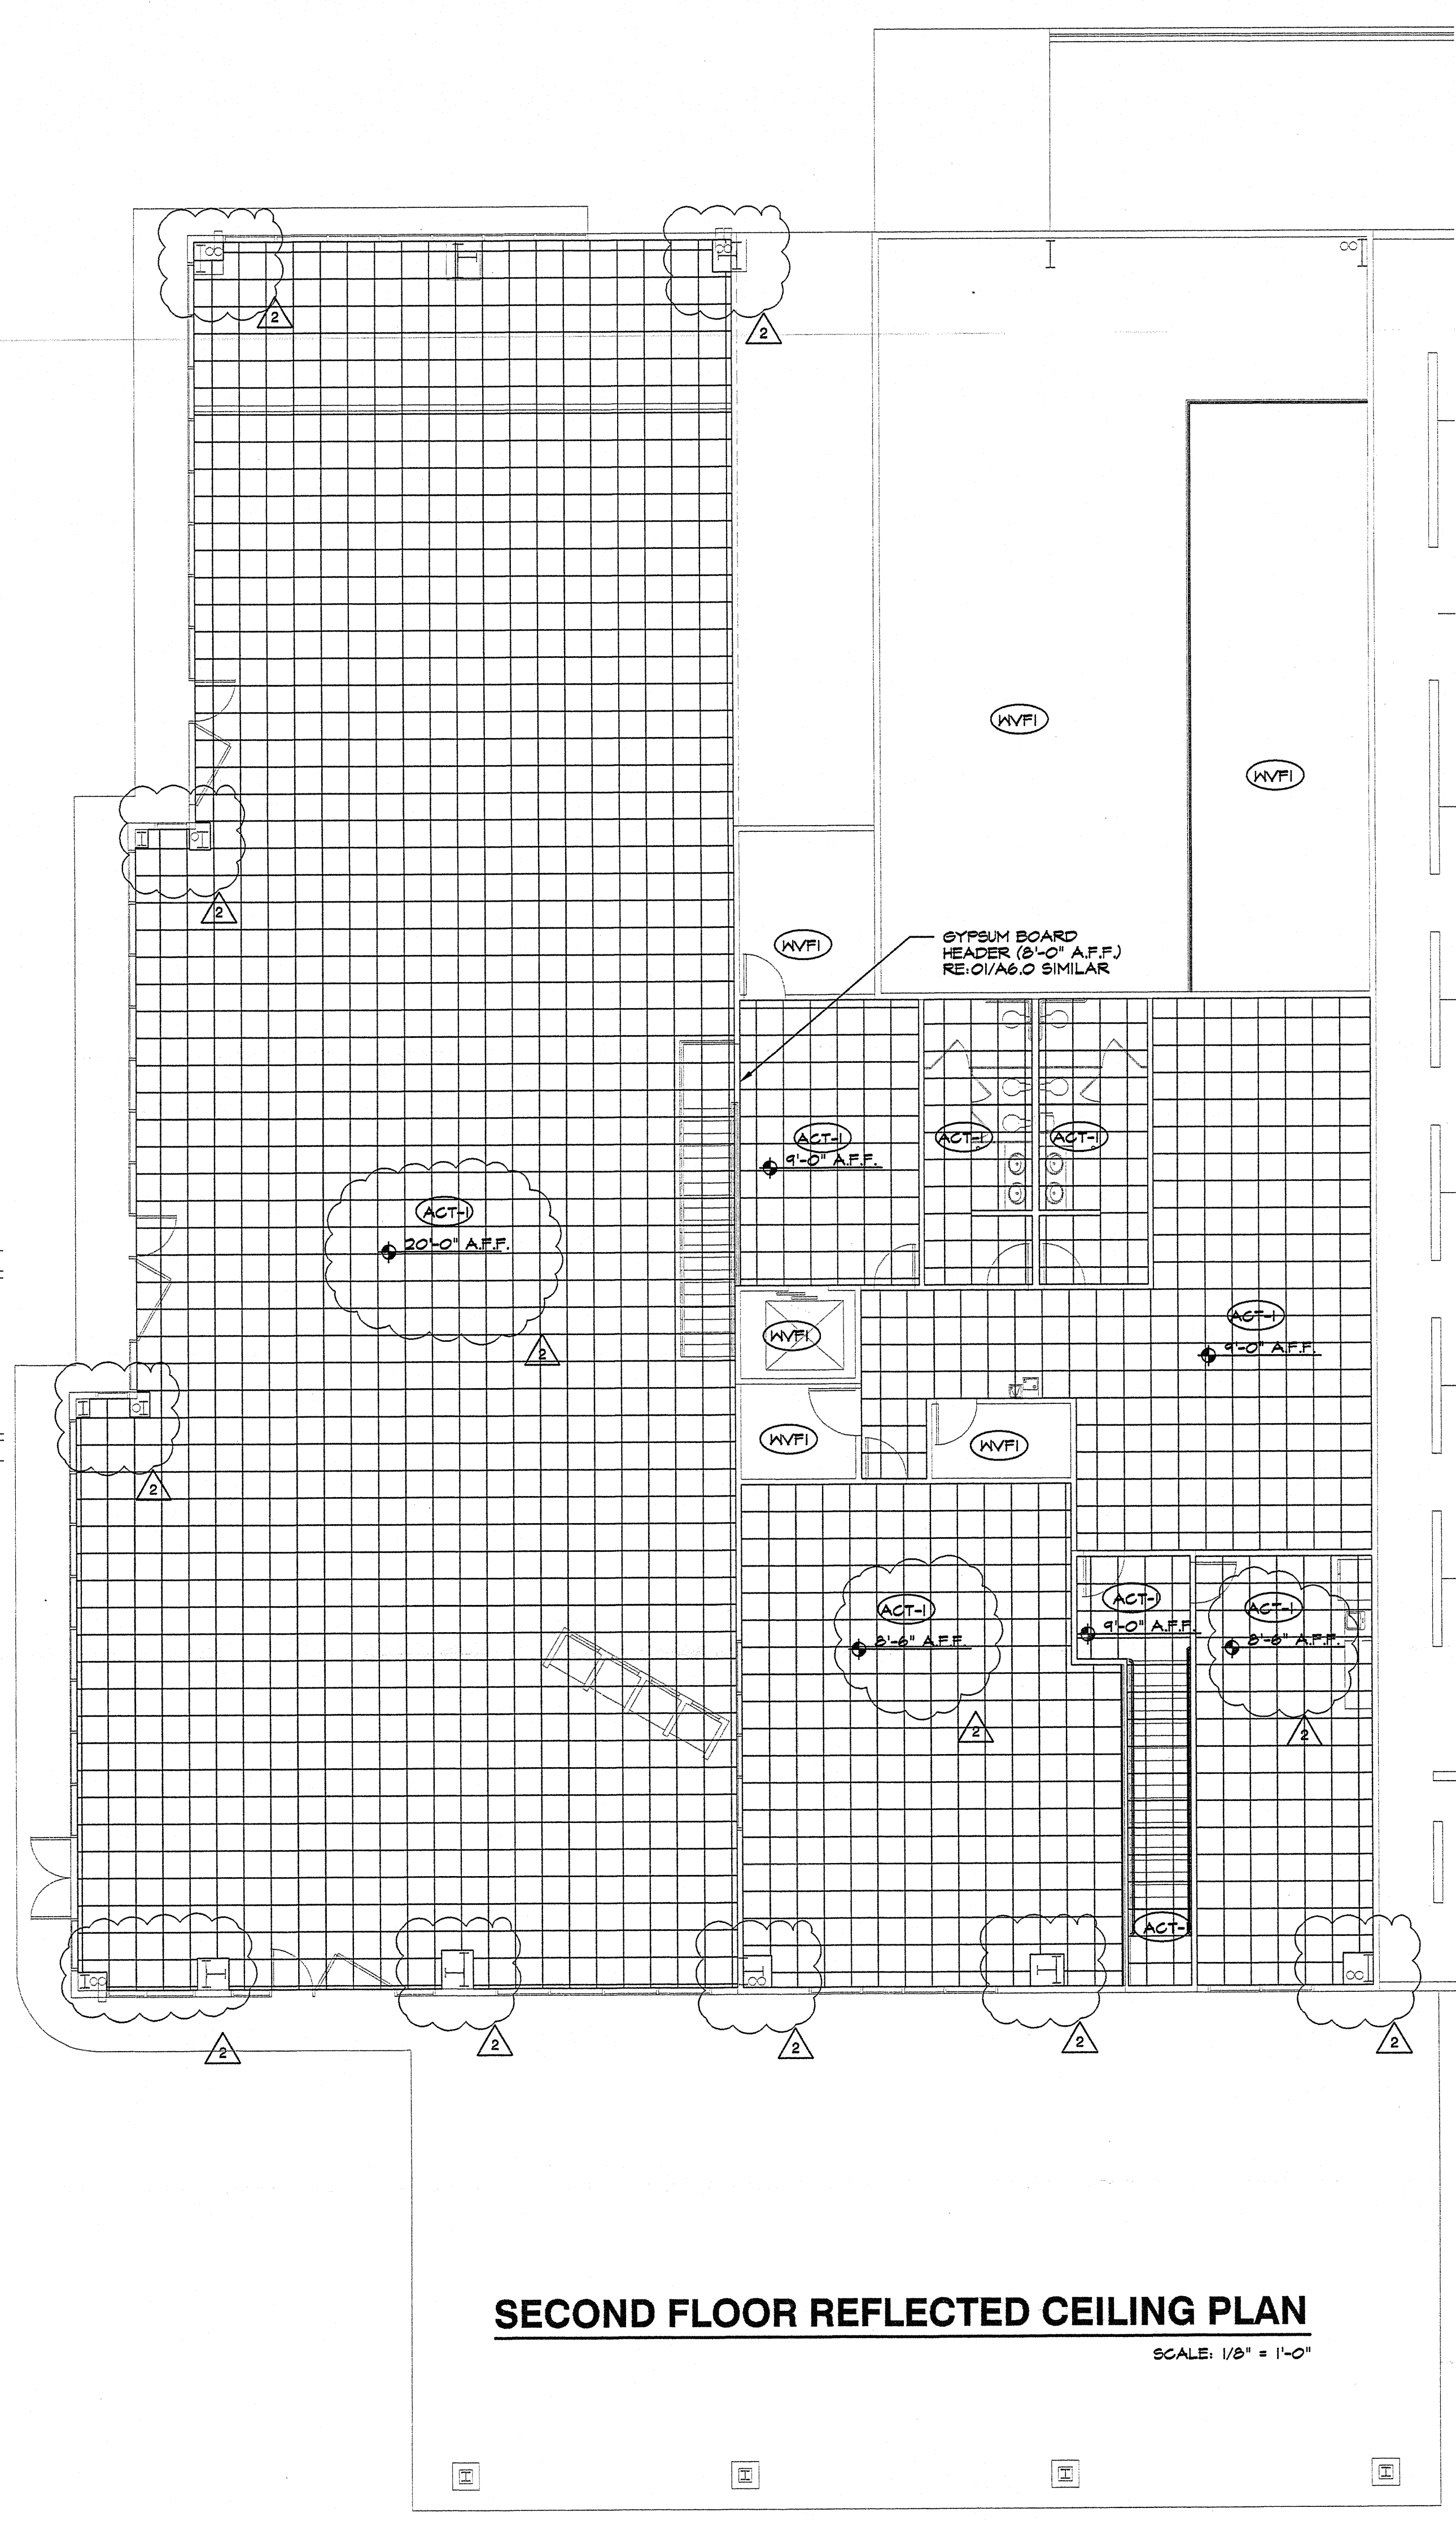

SECOND FLOOR REFLECTED CEILING PLAN
SCALE: 1/8" = 1'-0"

LEGEND		
MARK	SYMBOL	DESCRIPTION
ACT-1	[Grid Pattern]	ACT-1 ACOUSTICAL CEILING (2'X2') AS SPECIFIED
NVFI	[Blank]	WHITE VINYL FACED INSULATION (TO LAY BETWEEN '2" FURLIN AND ROOF PANEL
GYP	[Stippled Pattern]	PAINTED GYPSUM BOARD CEILING (FINISH AS SCHEDULED)
EIFS	[Dotted Pattern]	EIFS SOFFIT (FINISHED AS SPECIFIED)
NONE	[Blank]	NO CEILING (LEAVE CEILING EXPOSED TO DECK ABOVE)

AN AUTOMOTIVE DEALERSHIP

ROGER BEASLEY VOLVO

INTERSTATE HIGHWAY 35 SOUTH
GEORGETOWN, TEXAS

ELASSER
ARCHITECTURAL
INC.

ARCHITECTURE AND PLANNING

P.O. BOX 533 GEORGETOWN, TX 78627
919 550-5553 FAX 919 550-5818 www.eaah-tx.com

DATE: 04/16/02

REVISED CEILING HEIGHTS AND GRID LAYOUT TO ACCOMMODATE FIB STEEL STRUCTURE


2

DATE: 09/18/02

PROJECT NO. 02008

SHEET NO.

A6.0

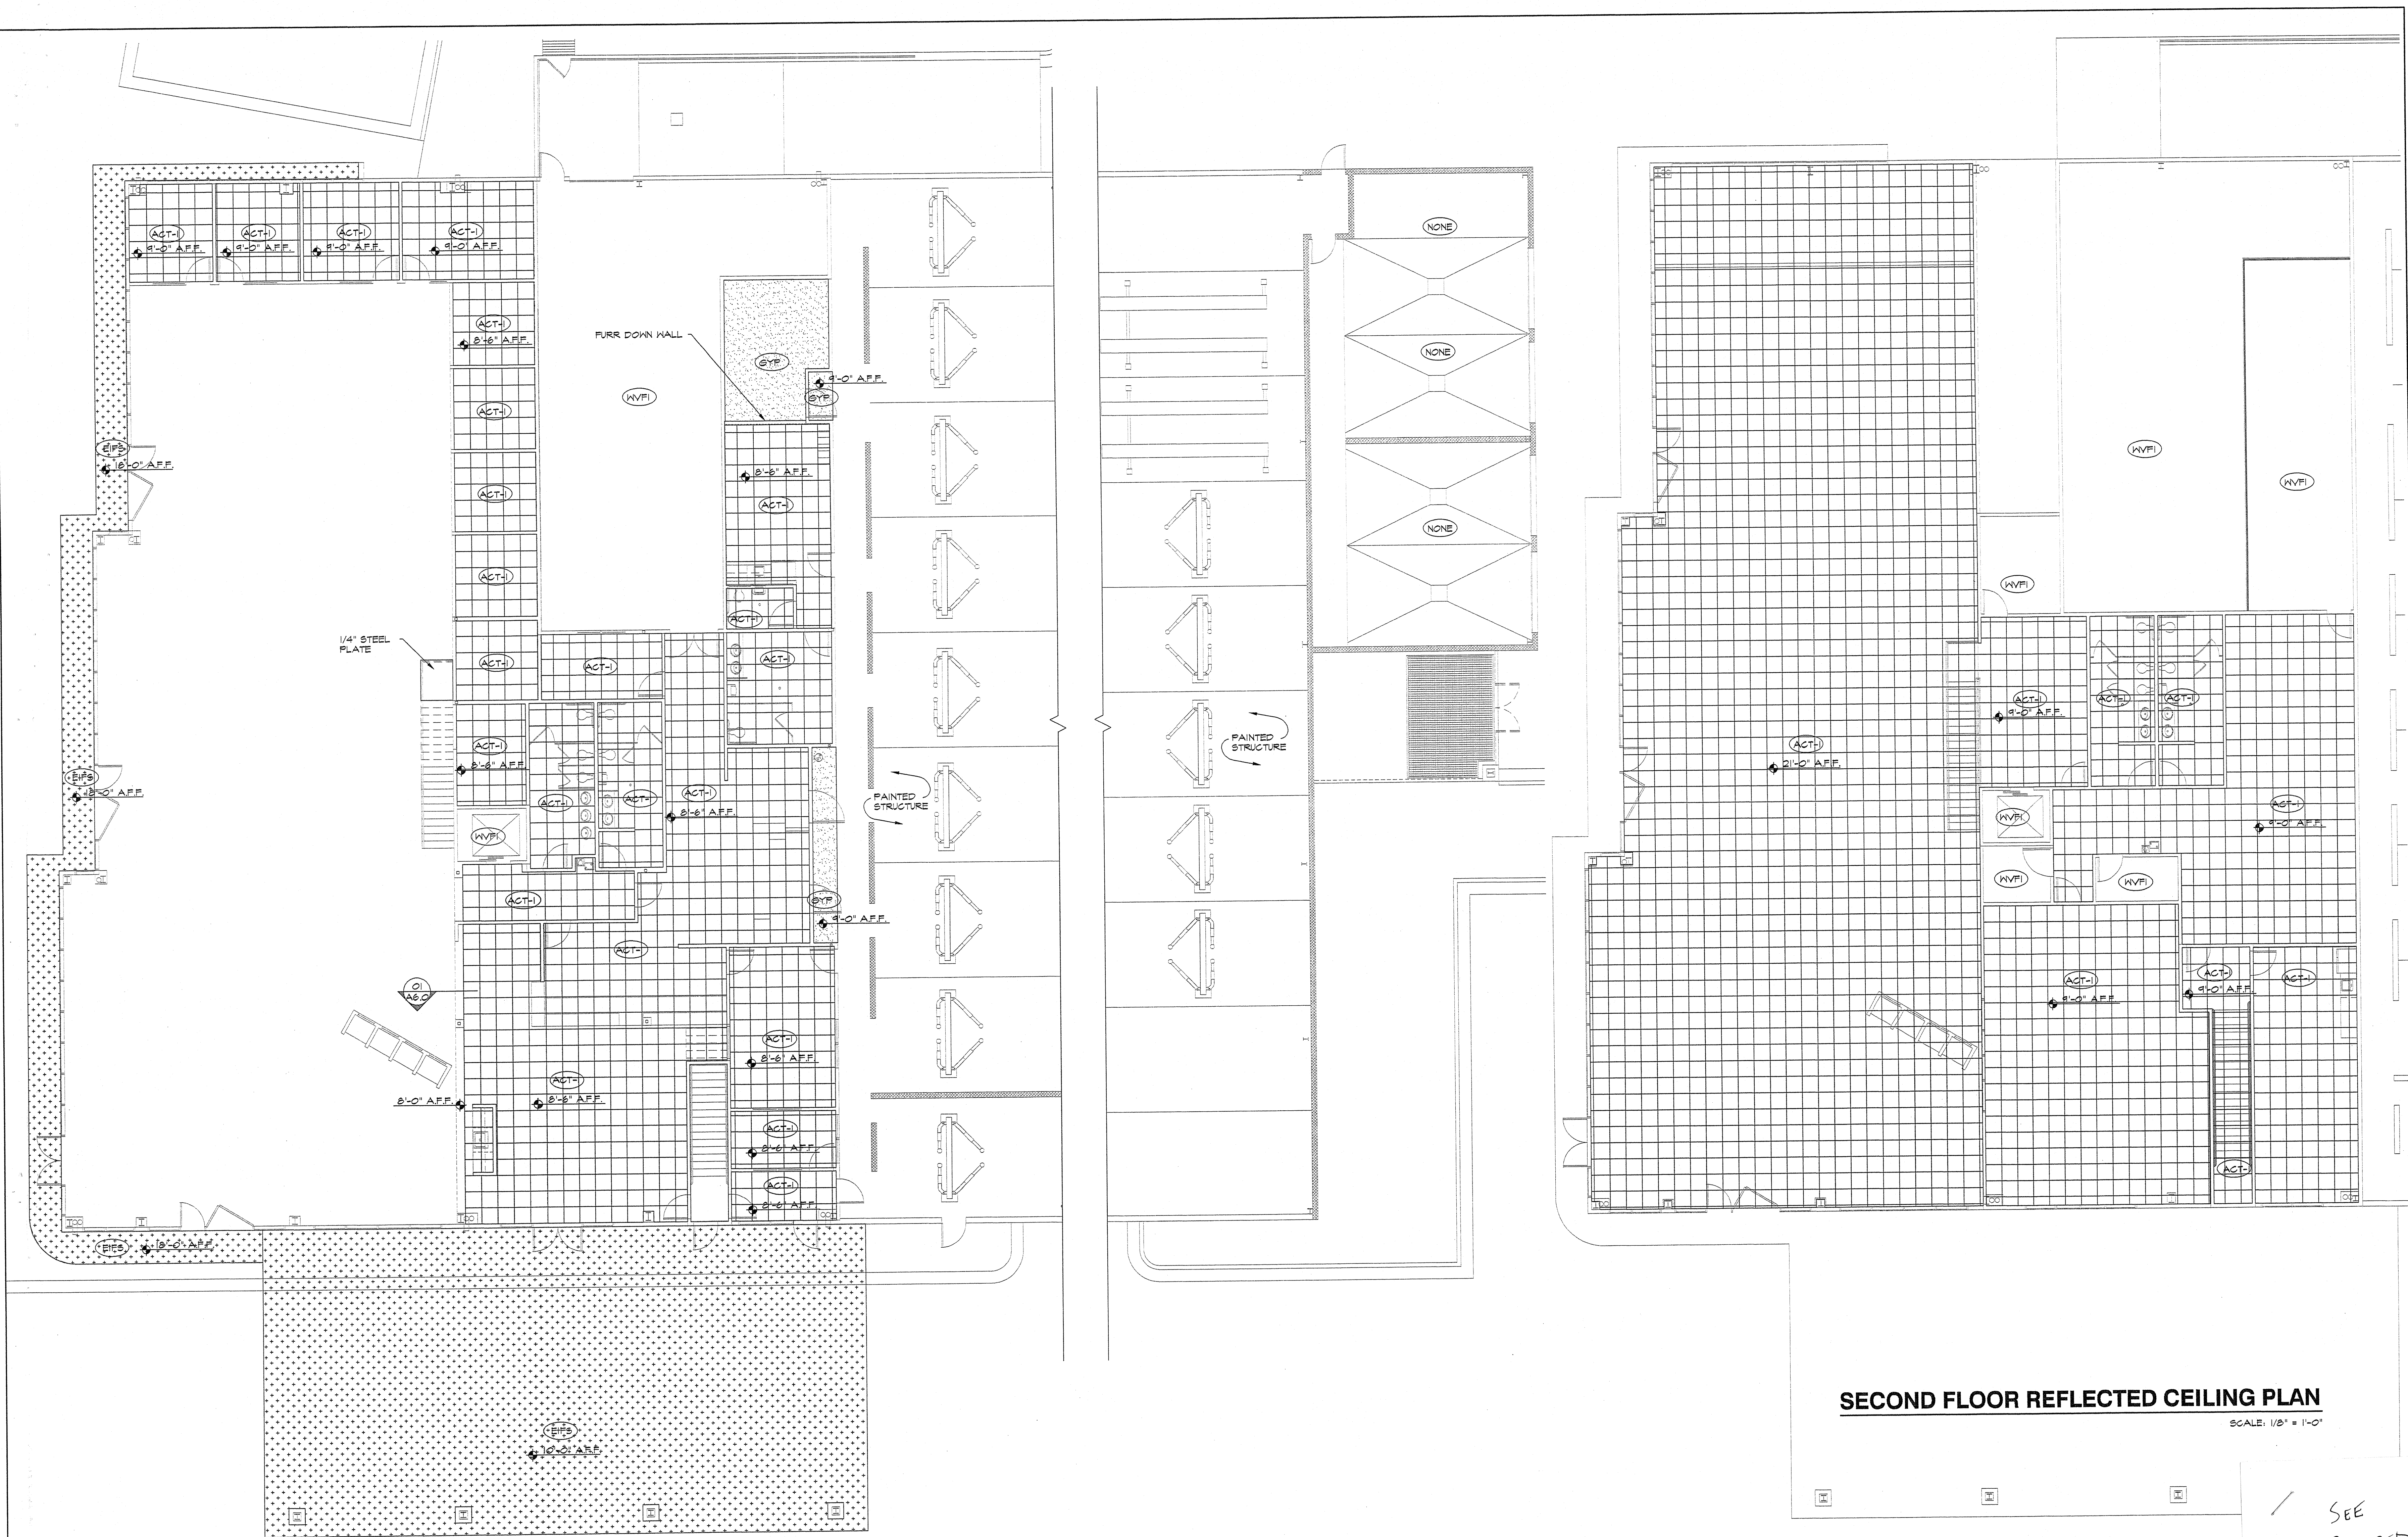


FIRST FLOOR REFLECTED CEILING PLAN

SCALE: 1/8" = 1'-0"

SECOND FLOOR REFLECTED CEILING PLAN

SCALE: 1/8" = 1'-0"

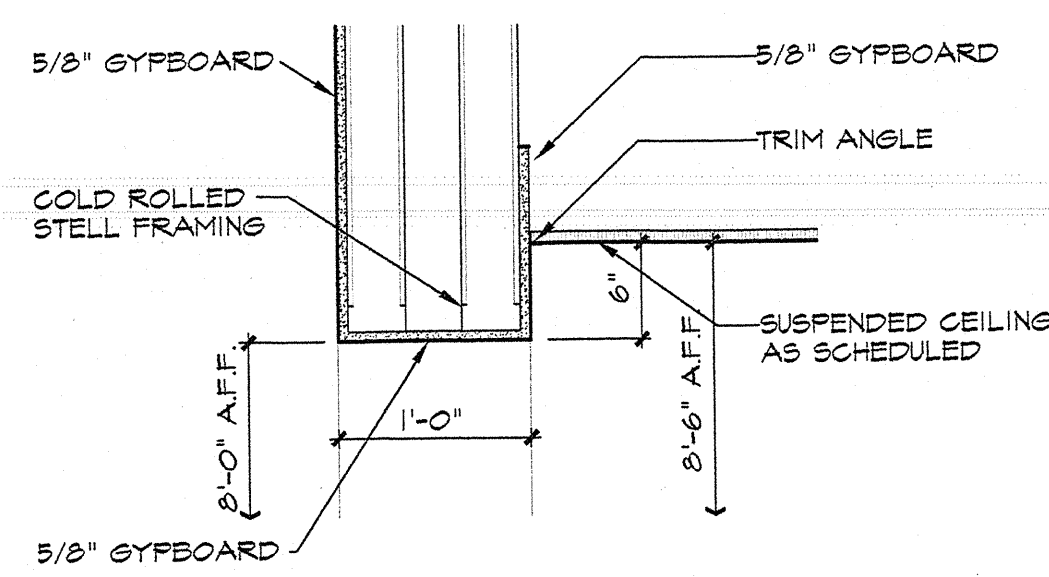


FURRDOWN SECTION

SCALE: 1" = 1'-0"


LEGEND		
MARK	SYMBOL	DESCRIPTION
(ACT-1)		ACT-1 ACOUSTICAL CEILING (2x2) AS SPECIFIED
(KVFI)		WHITE VINYL FACED INSULA (TO LAY BETWEEN 12\"/>
(GYP)		PAINTED GYPSUM BOARD G (FINISH AS SCHEDULED)
(EIFS)		EIFS SOFFIT (FINISHED AS SPECIFIED)
(NONE)		NO CEILING (LEAVE CEILING EXPOSED T

SEE
REVISED

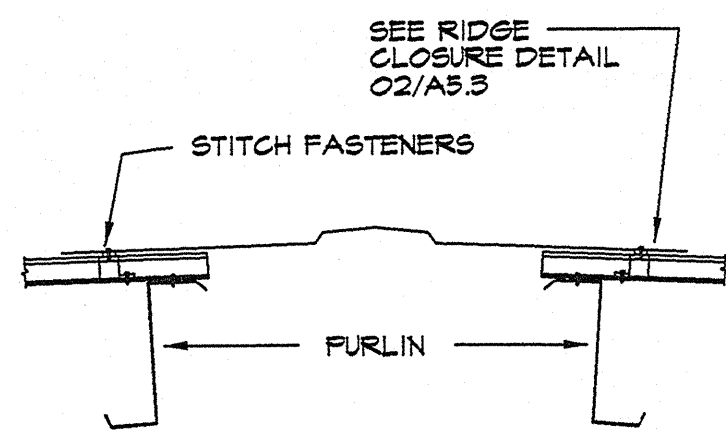


PEAK DETAIL

SCALE: N.T.S.

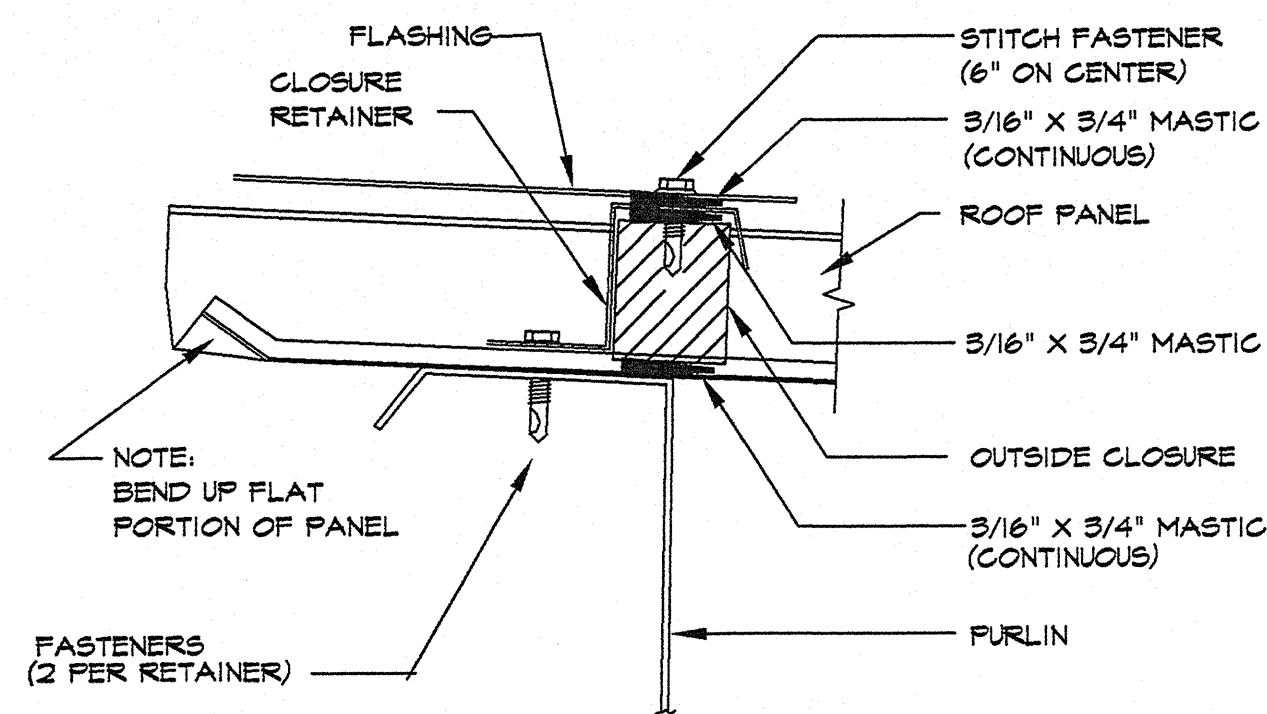


RIDGE CLOSURE DETAIL

SCALE: N.T.S.

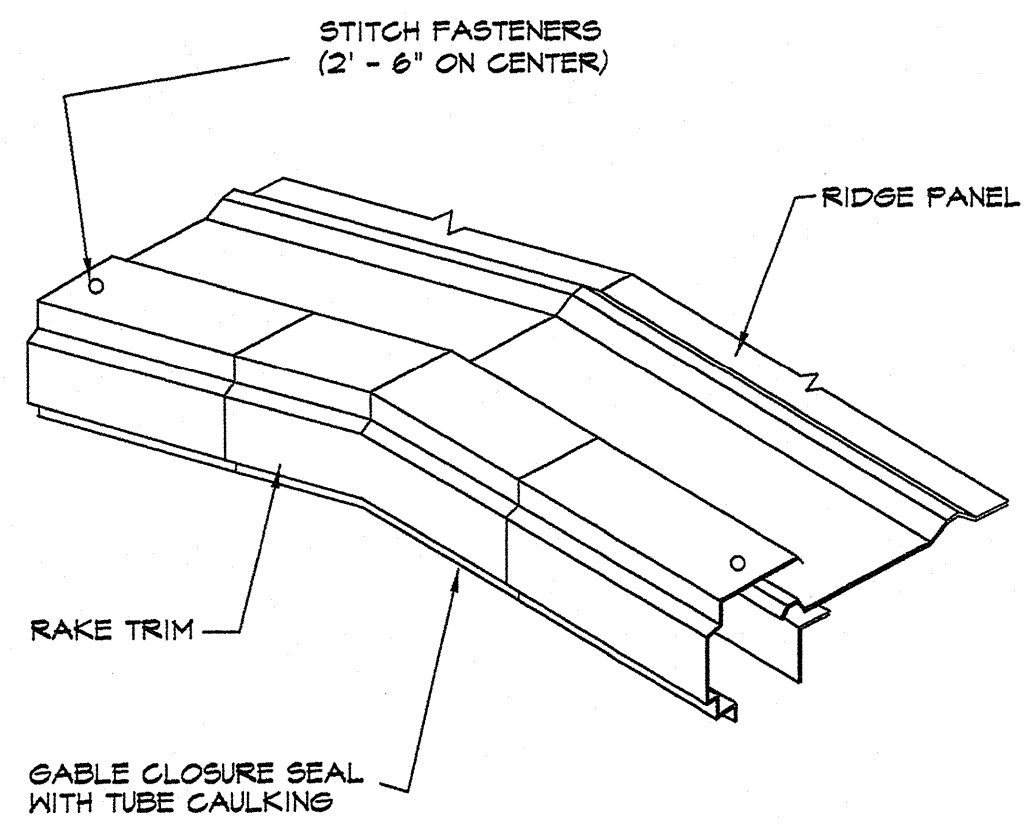


RAKE TRIM DETAIL

SCALE: N.T.S.

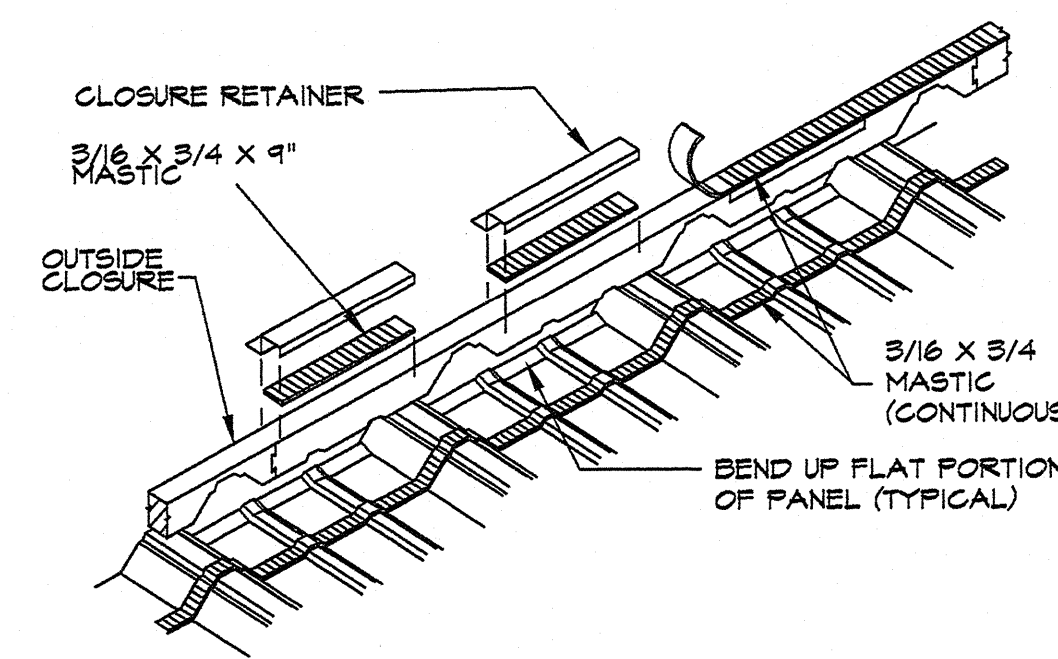


CLOSURE INSTALLATION

SCALE: N.T.S.

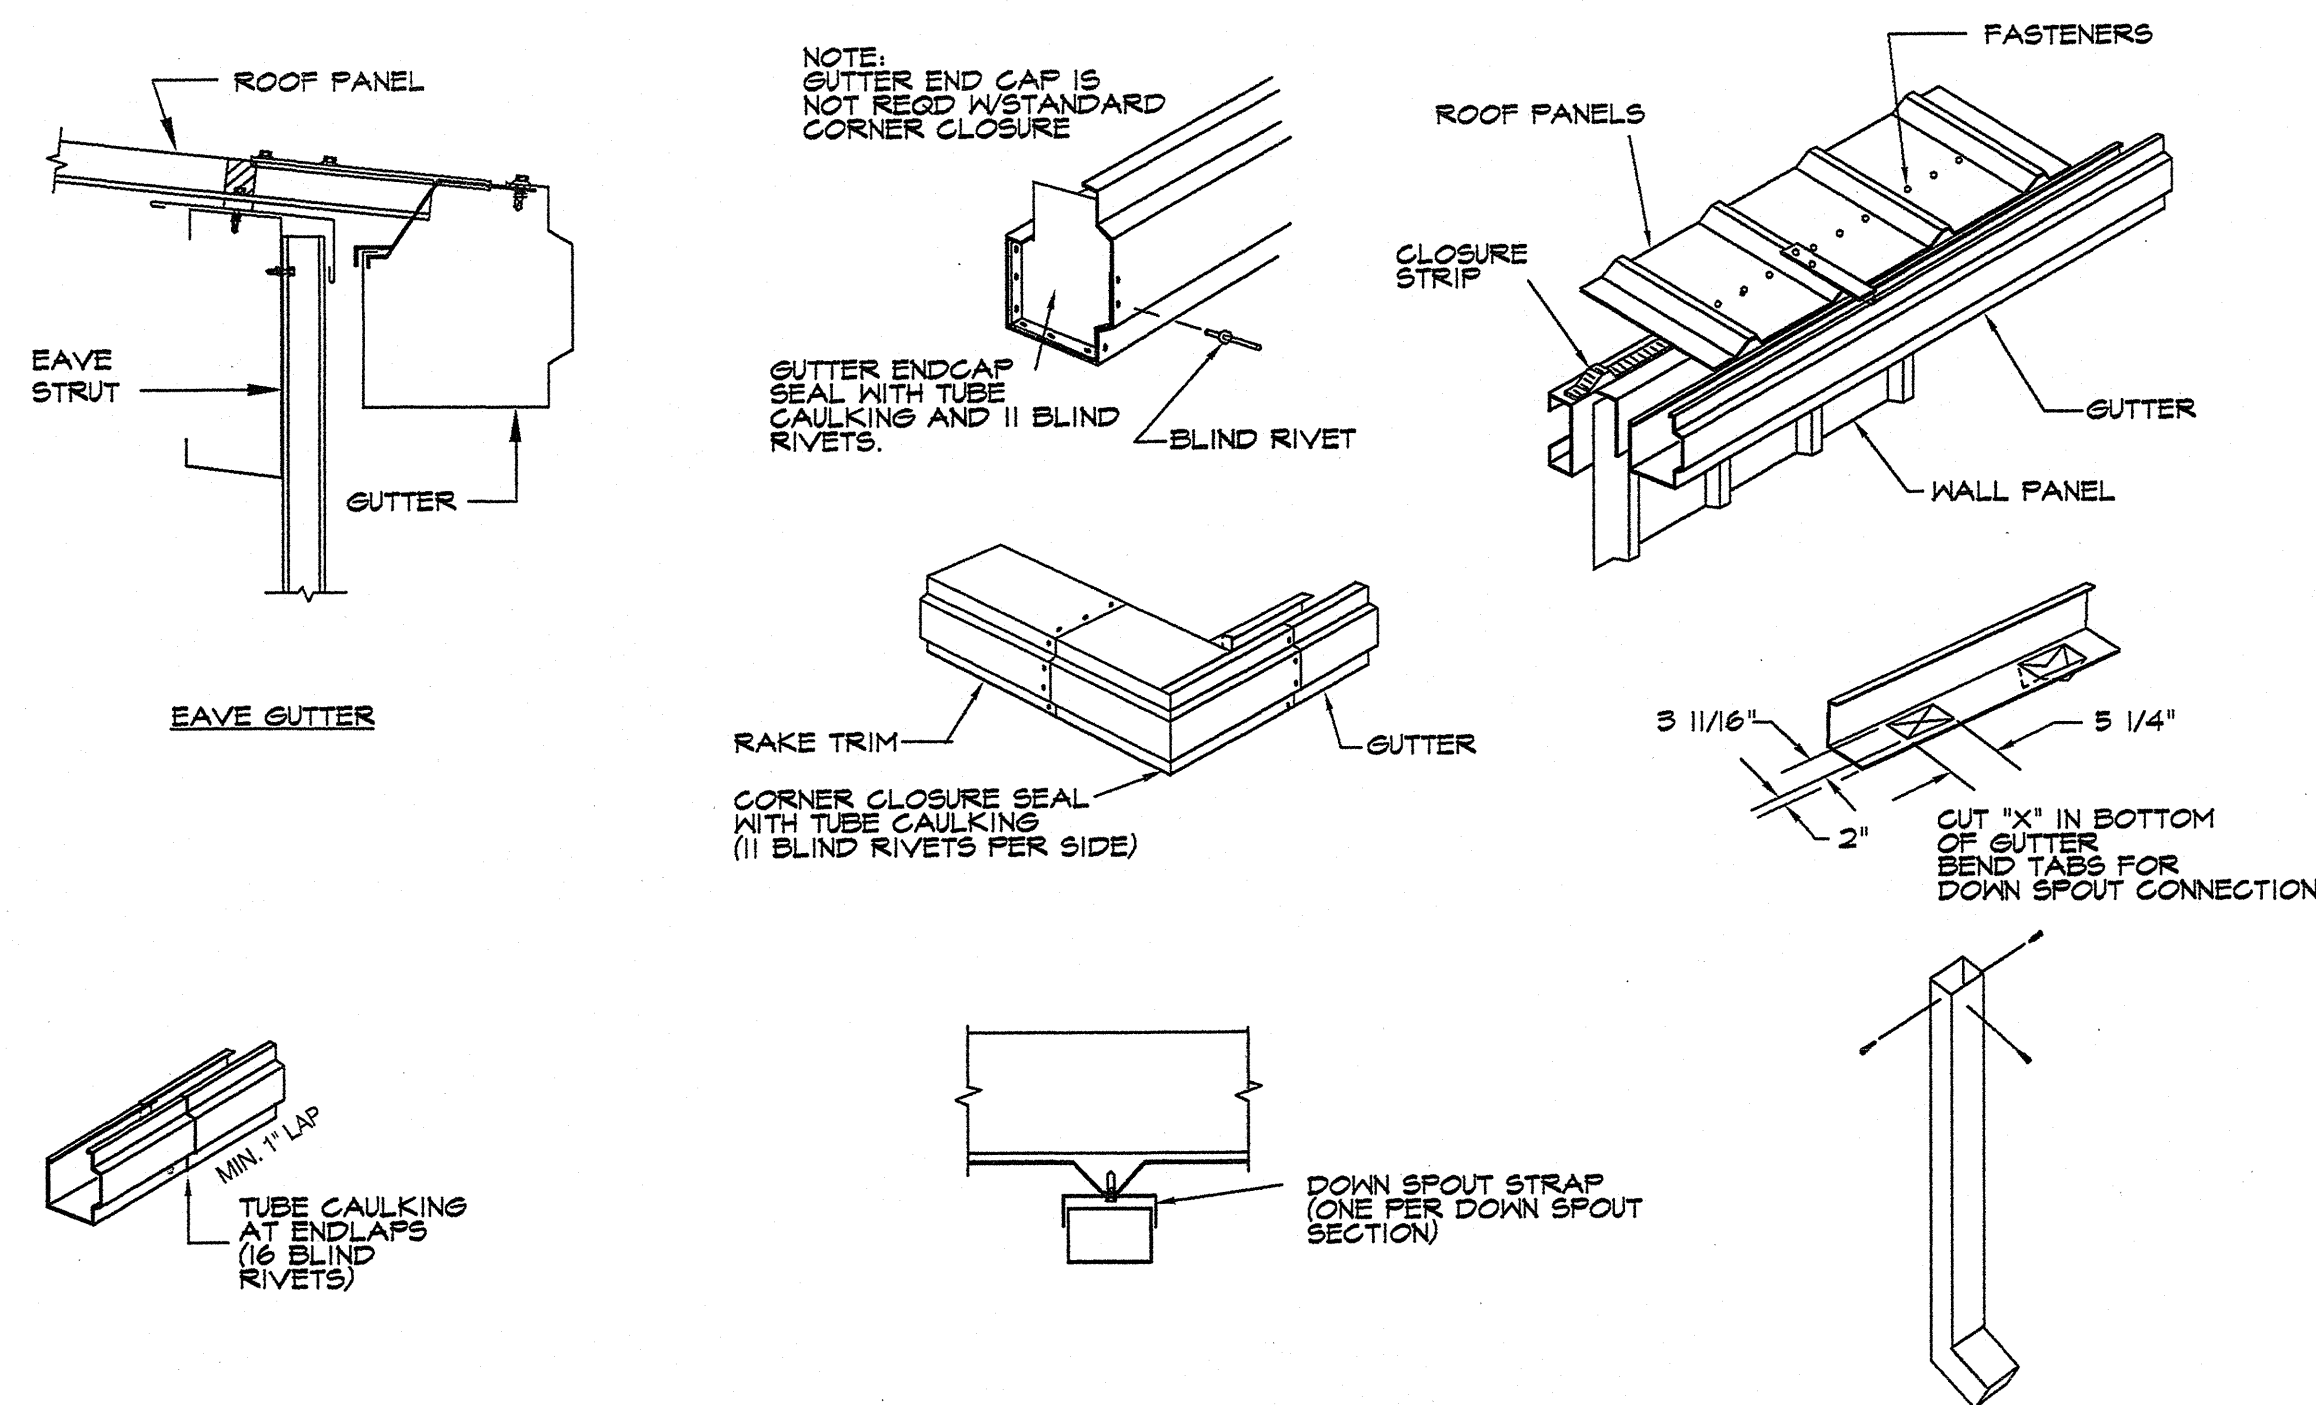

GUTTER & DOWN SPOUT INSTALLATION DETAILS


SCALE: N.T.S.

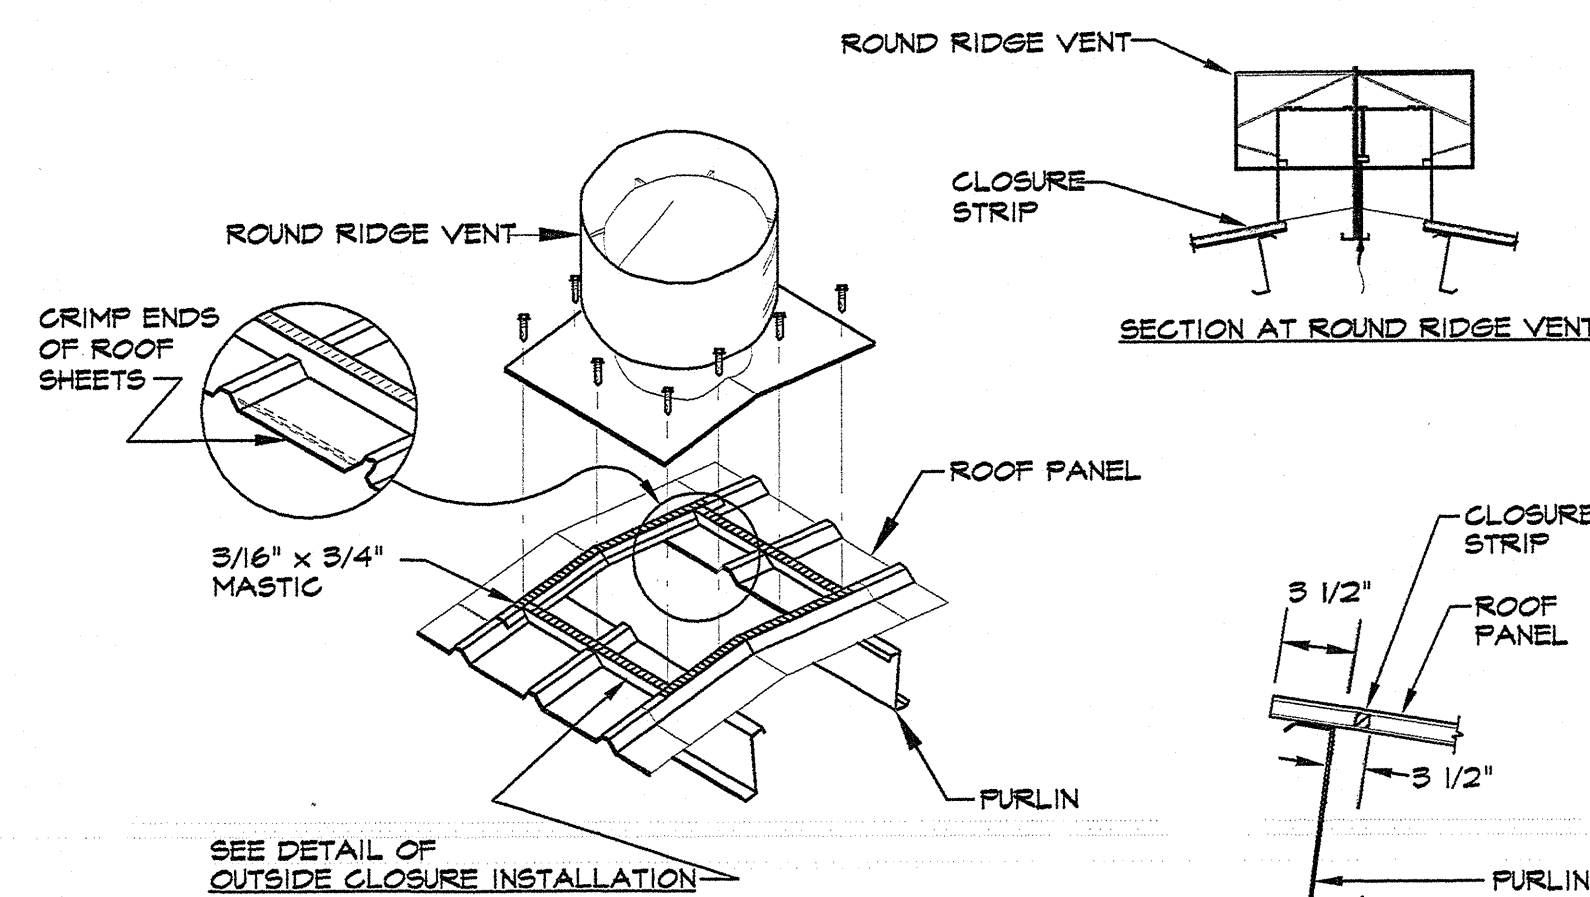

ROUND VENT INSTALLATION DETAIL


CHIMNEY PIPE VENT SIM.

SCALE: N.T.S.

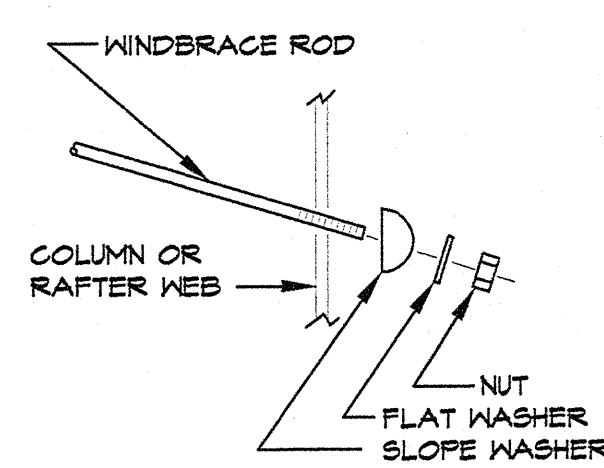

ROD BRACING


SCALE 3\"/>

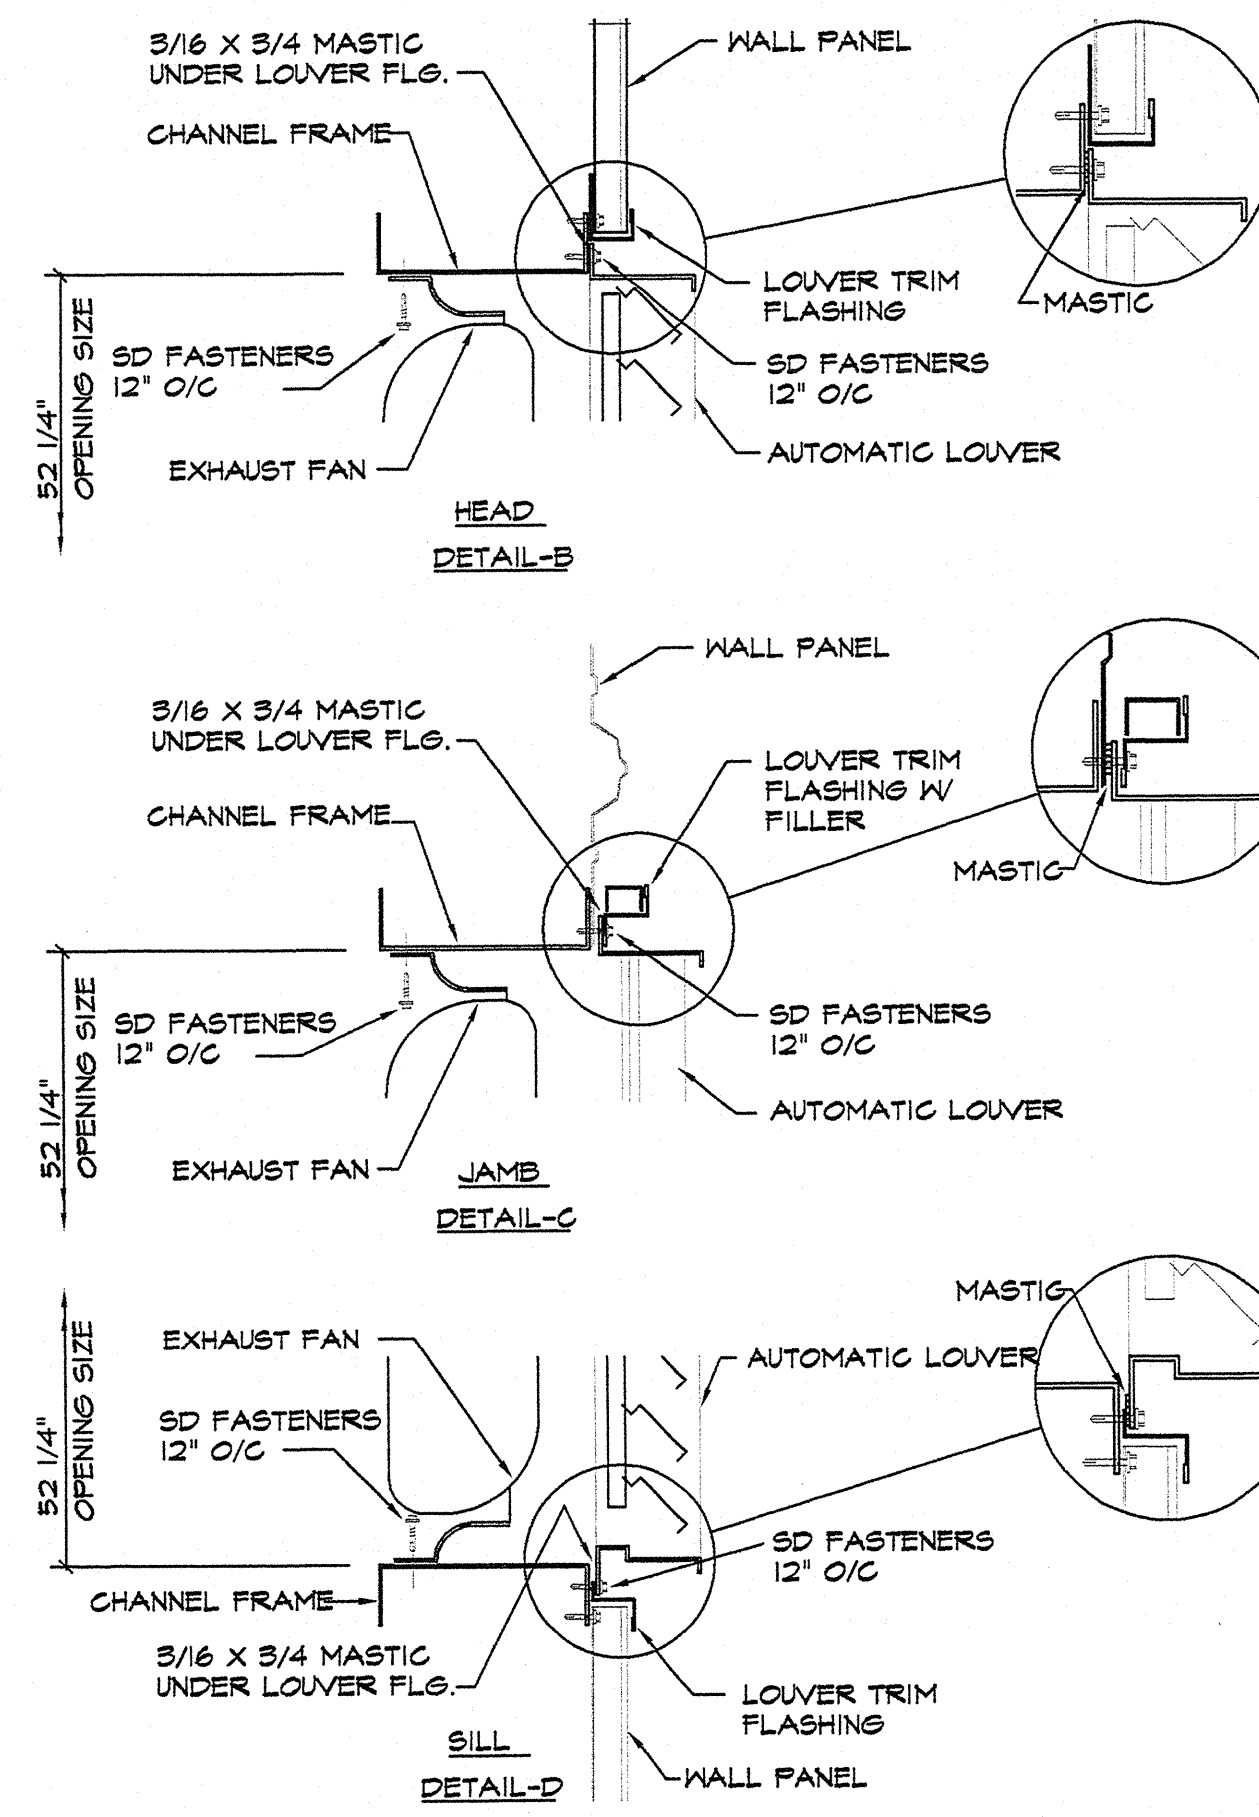

EXHAUST FAN AND AUTOMATIC LOUVER


INSTALLATION DETAILS

SCALE: N.T.S.

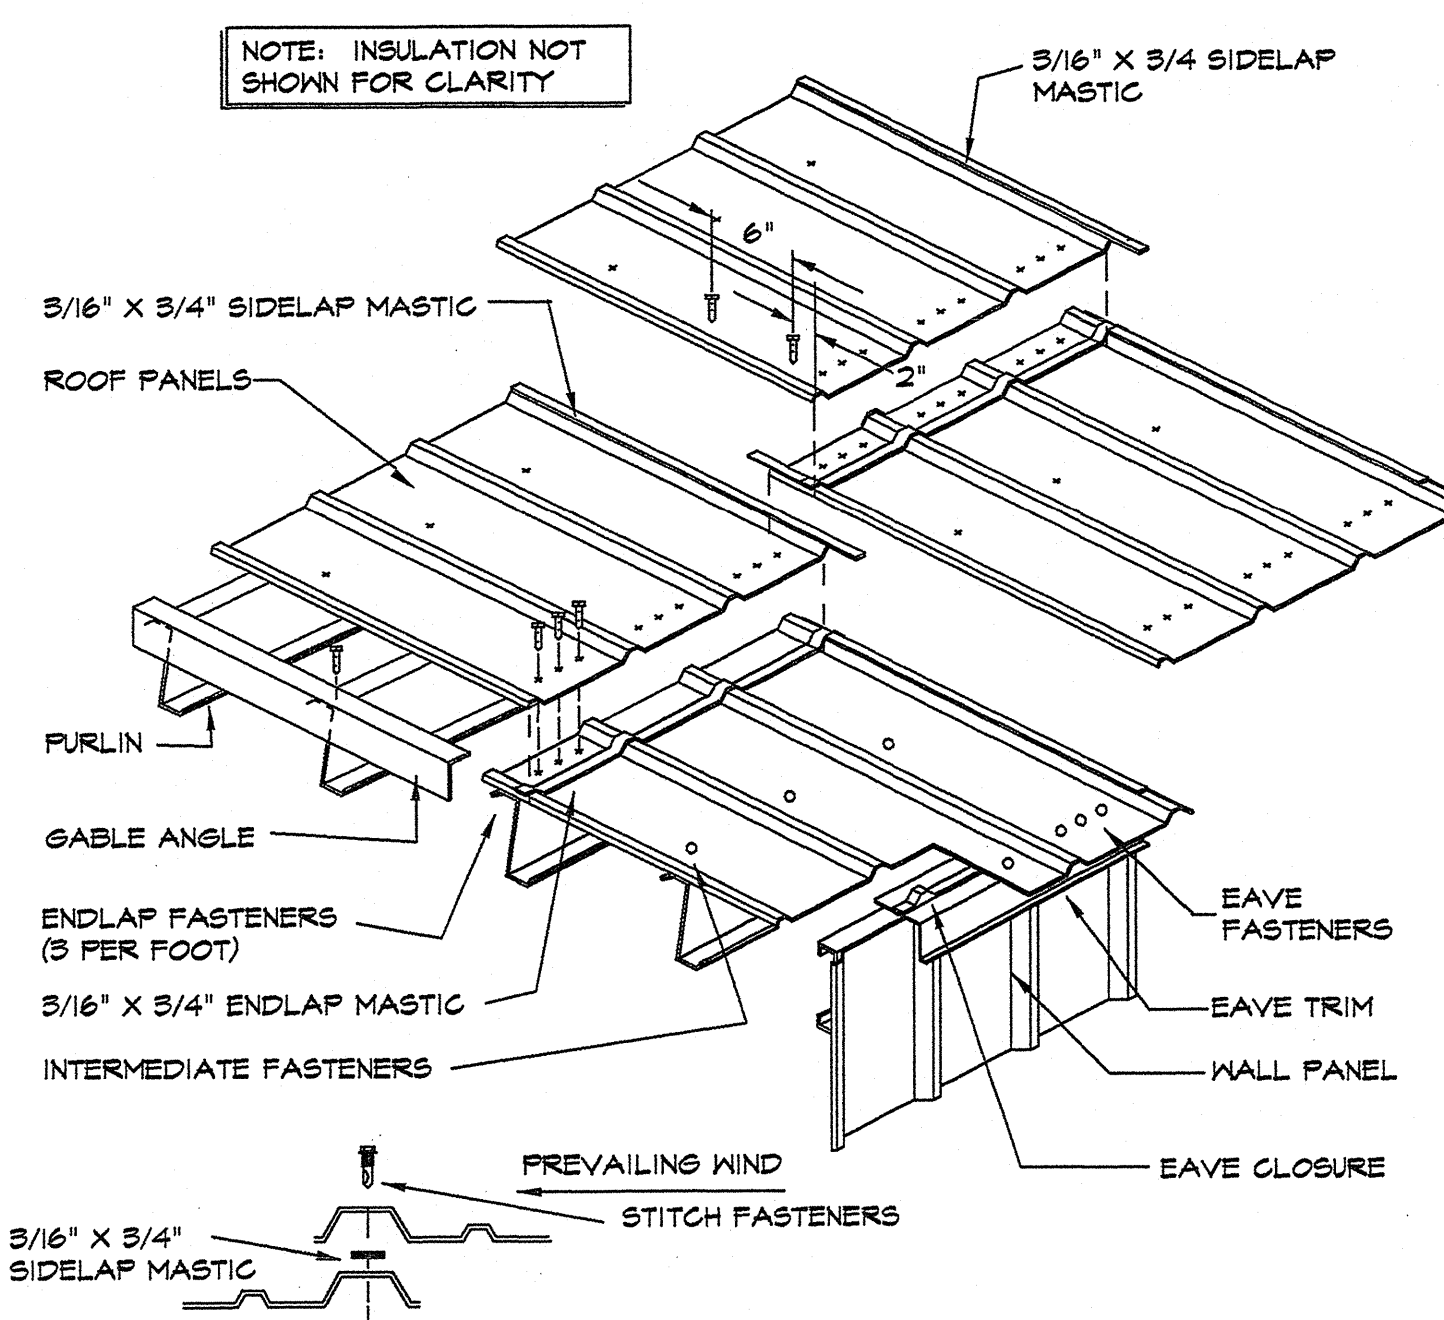


PANEL ROOF INSTALLATION DETAIL

SCALE: N.T.S.

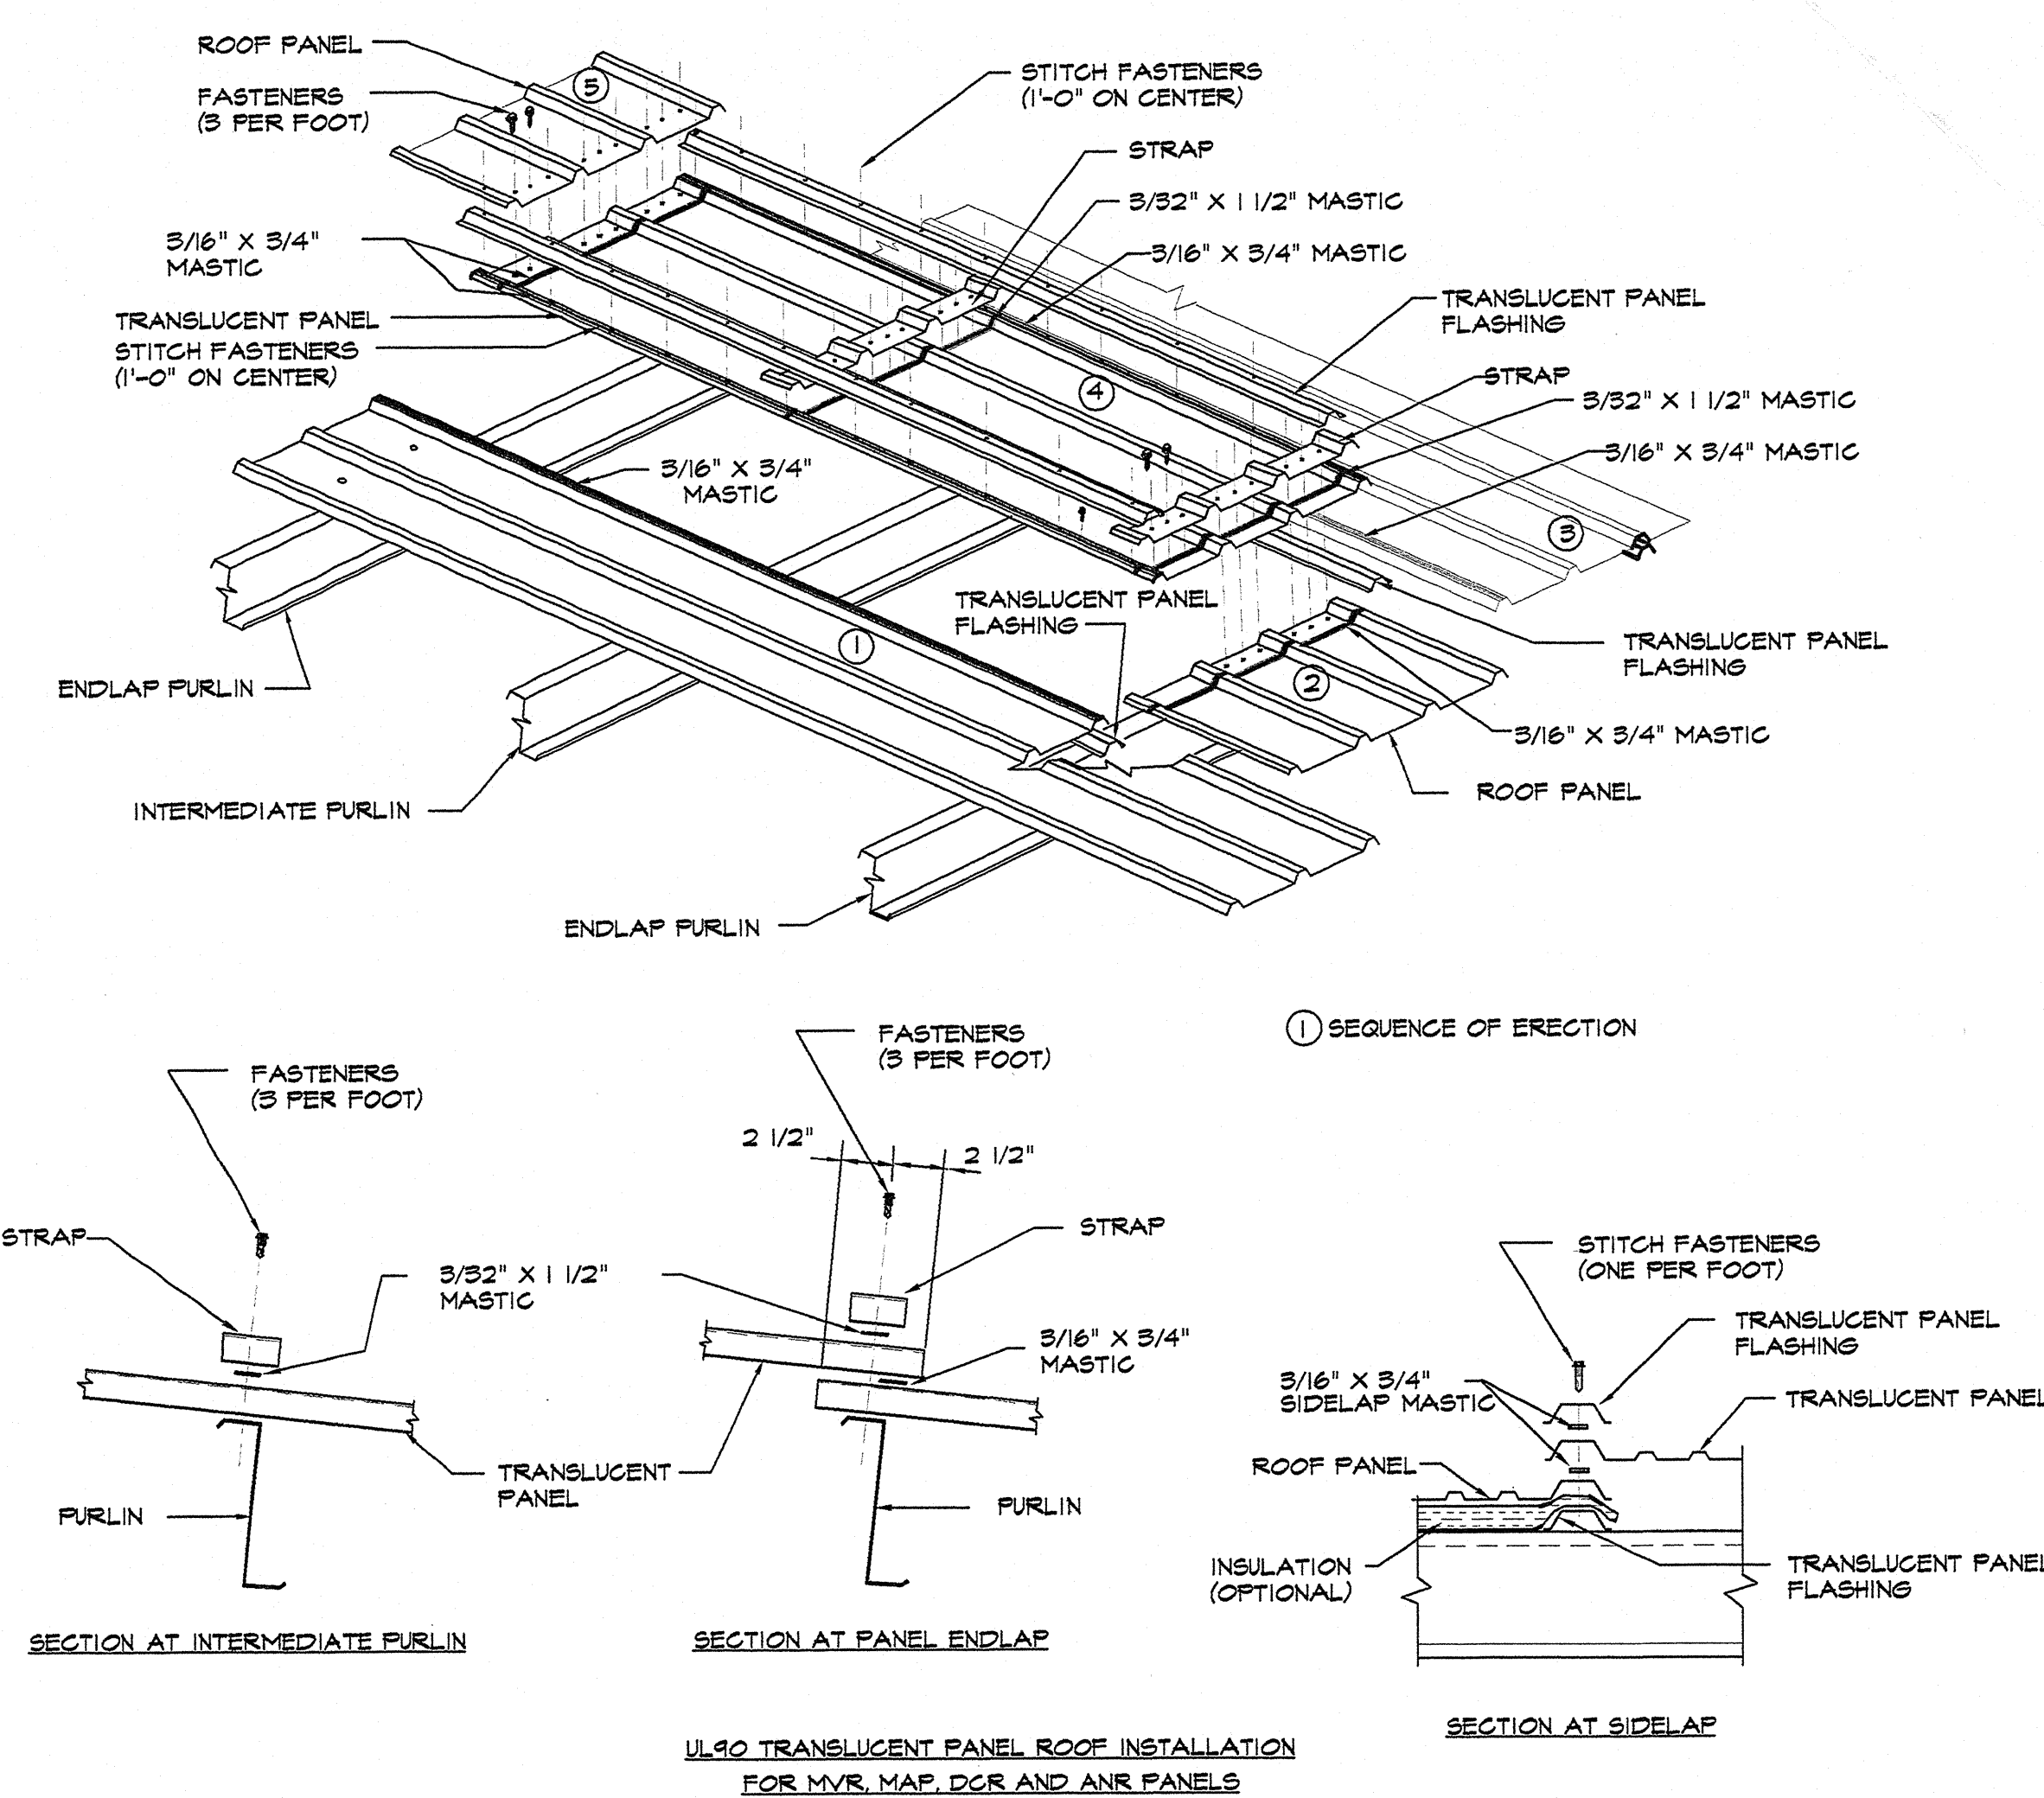

SKYLIGHT PANEL DETAILS

SCALE: N.T.S.

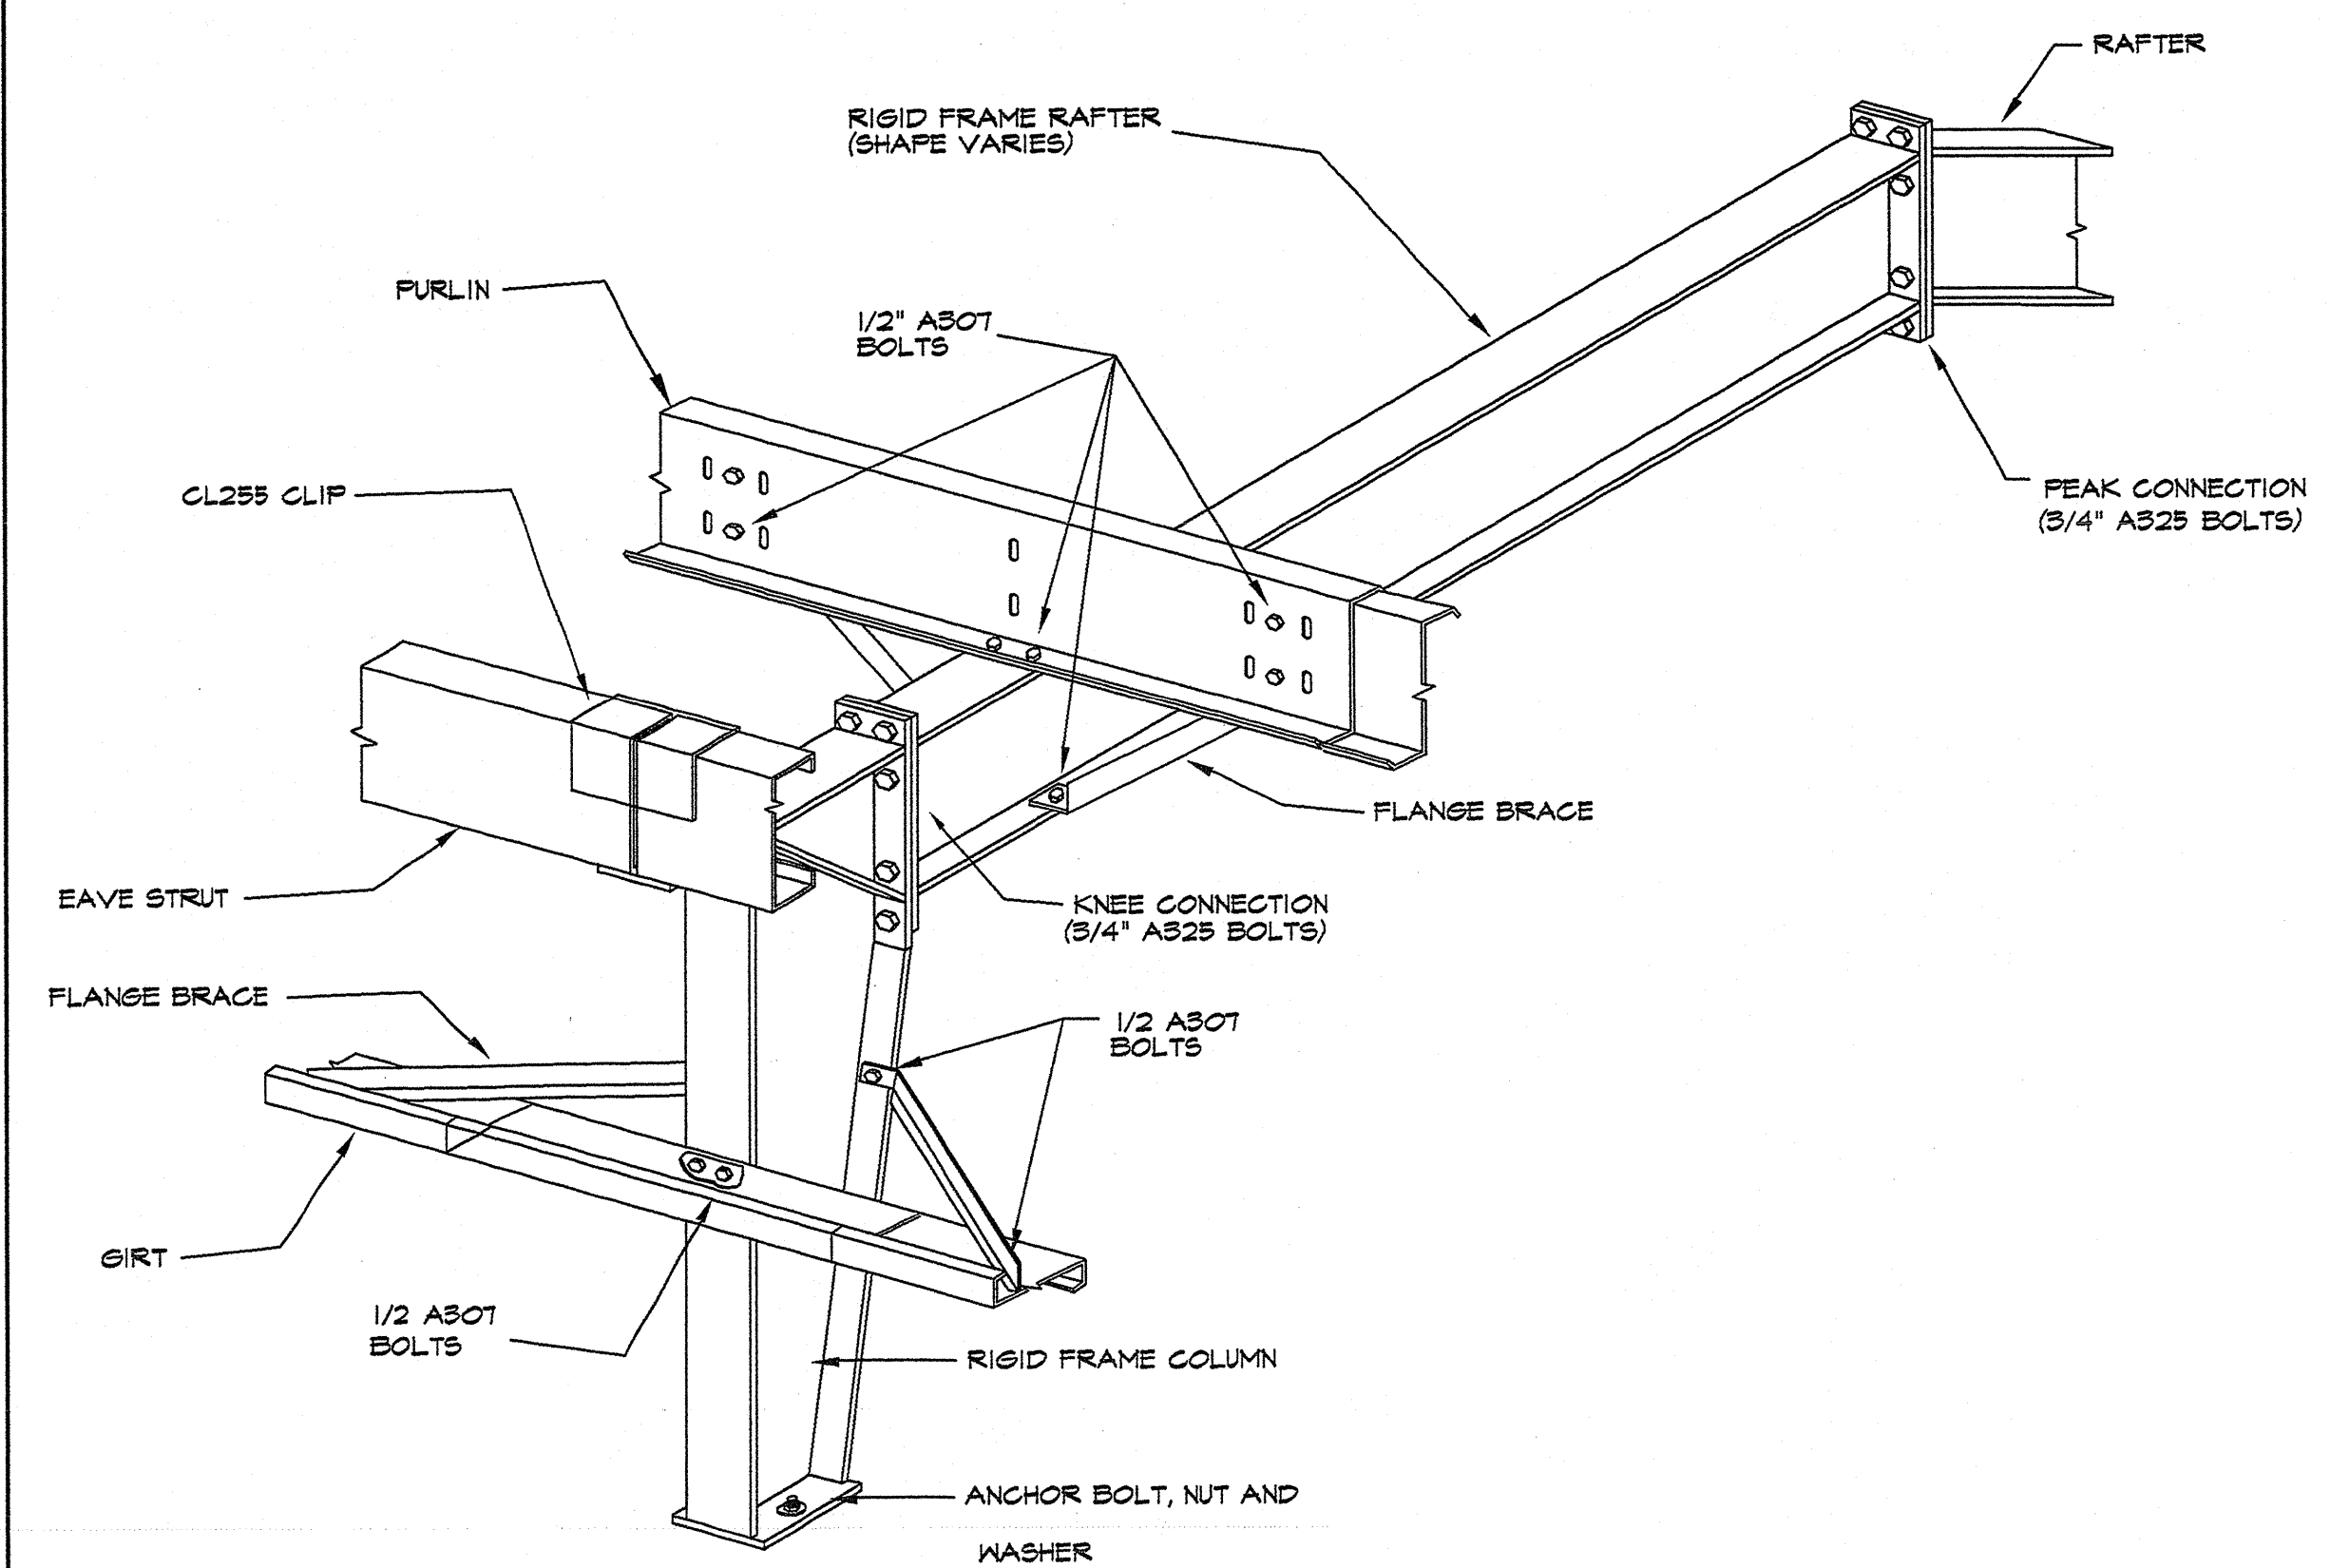

RIGID FRAME DETAIL

SCALE: N.T.S.

AN AUTOMOTIVE DEALERSHIP
ROGER BEASLEY VOLVO
INTERSTATE HIGHWAY 35 SOUTH
GEORGETOWN, TEXAS

ELASSER
ARCHITECTURAL
INC.
ARCHITECTURE AND PLANNING
P.O. BOX 833 GEORGETOWN, TX 78627
(512) 950-5533 FAX (512) 950-2616 www.ea-h.com











CONSULTANT
INFORMATION:

REGISTERED ARCHITECT
STATE OF TEXAS
071902

DATE:
09/18/02
REVISION DATE:

PROJECT NO.
02008
SHEET NO.

A7.1

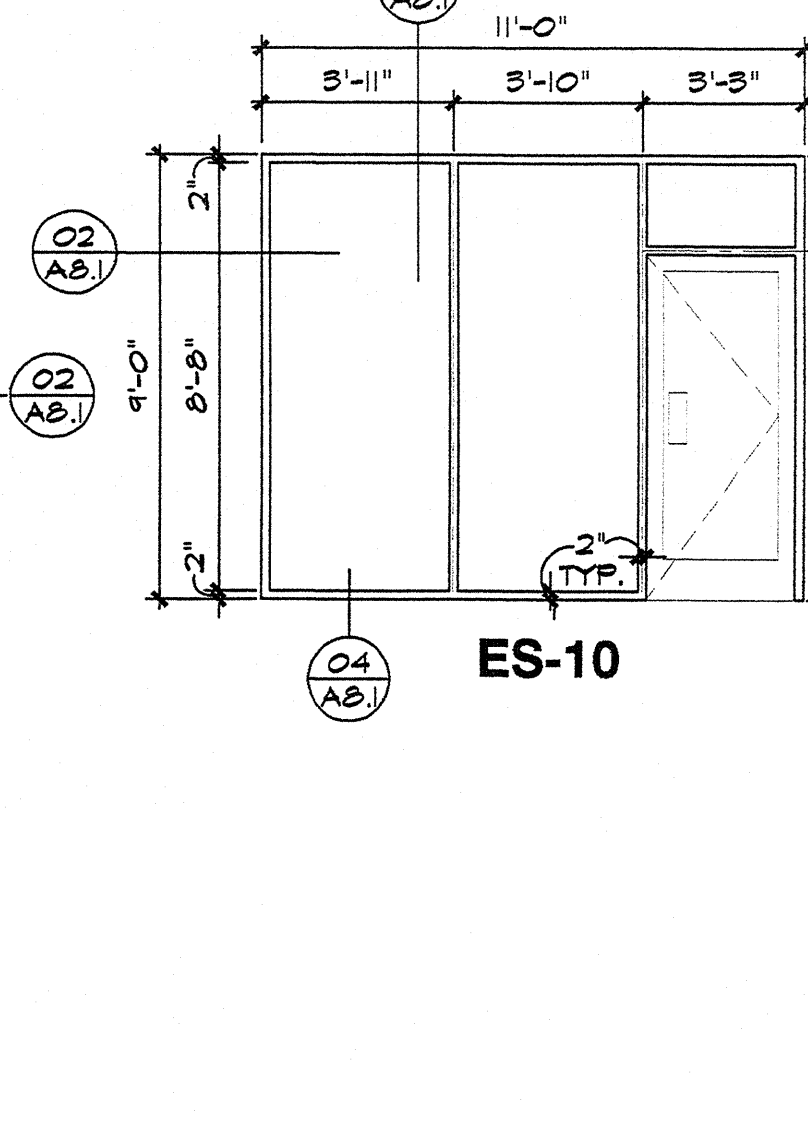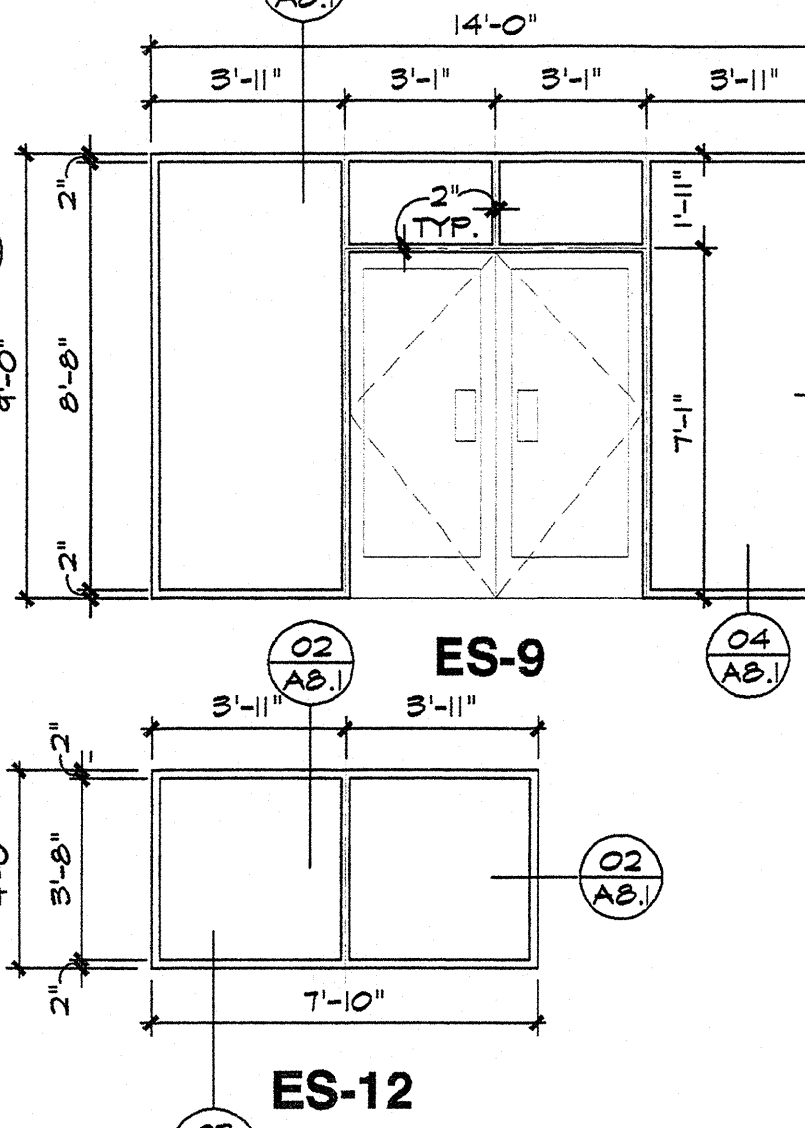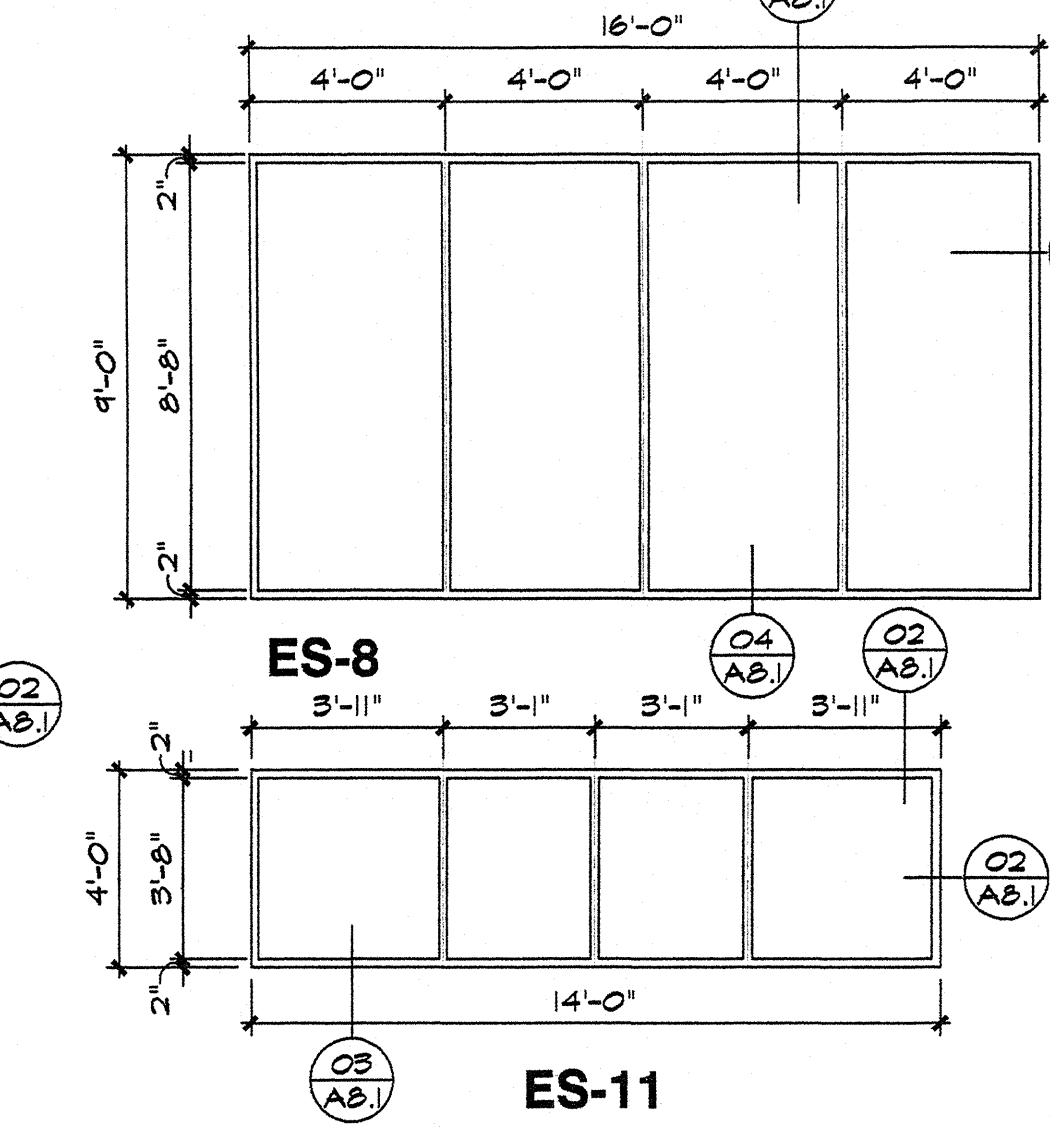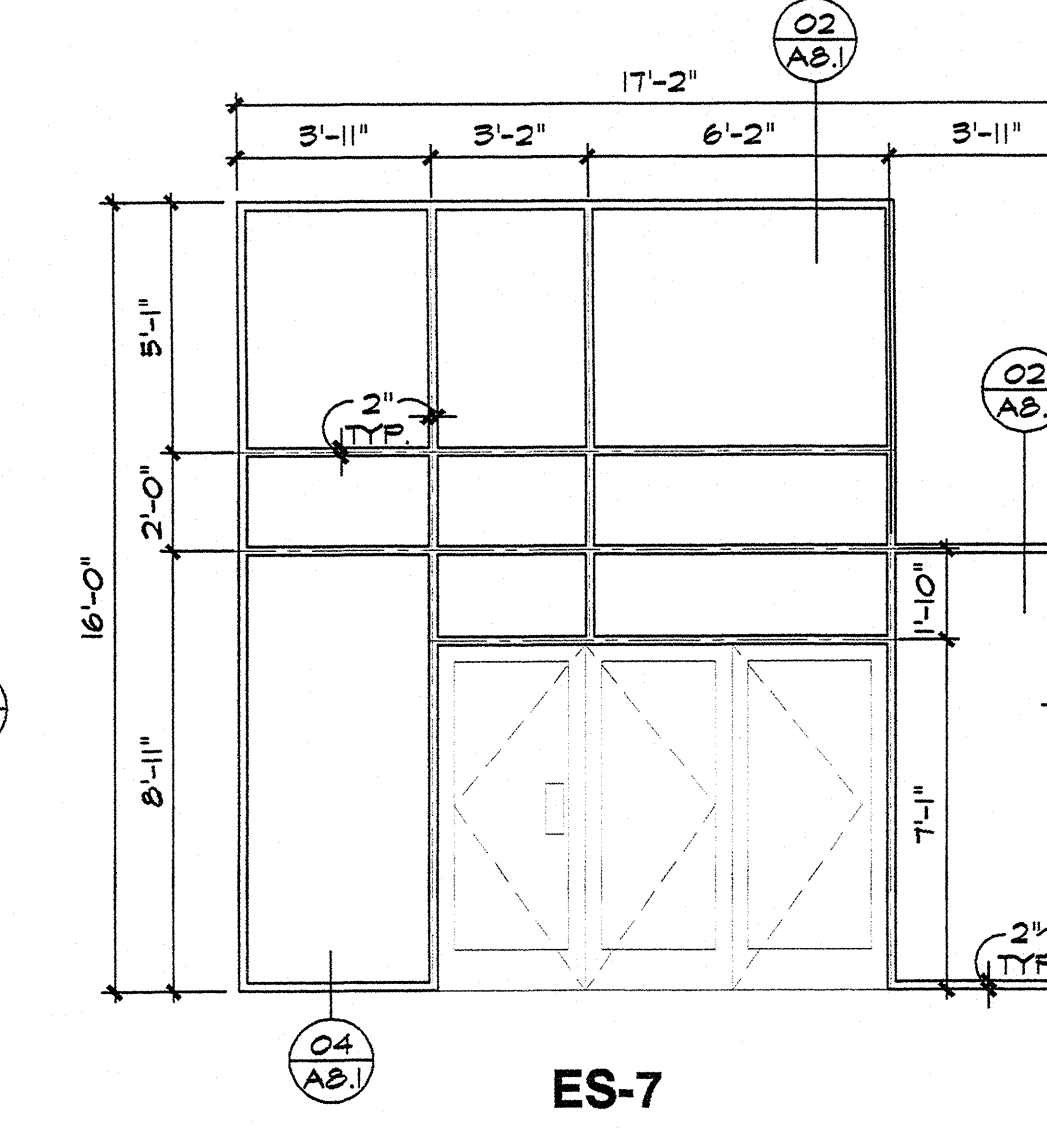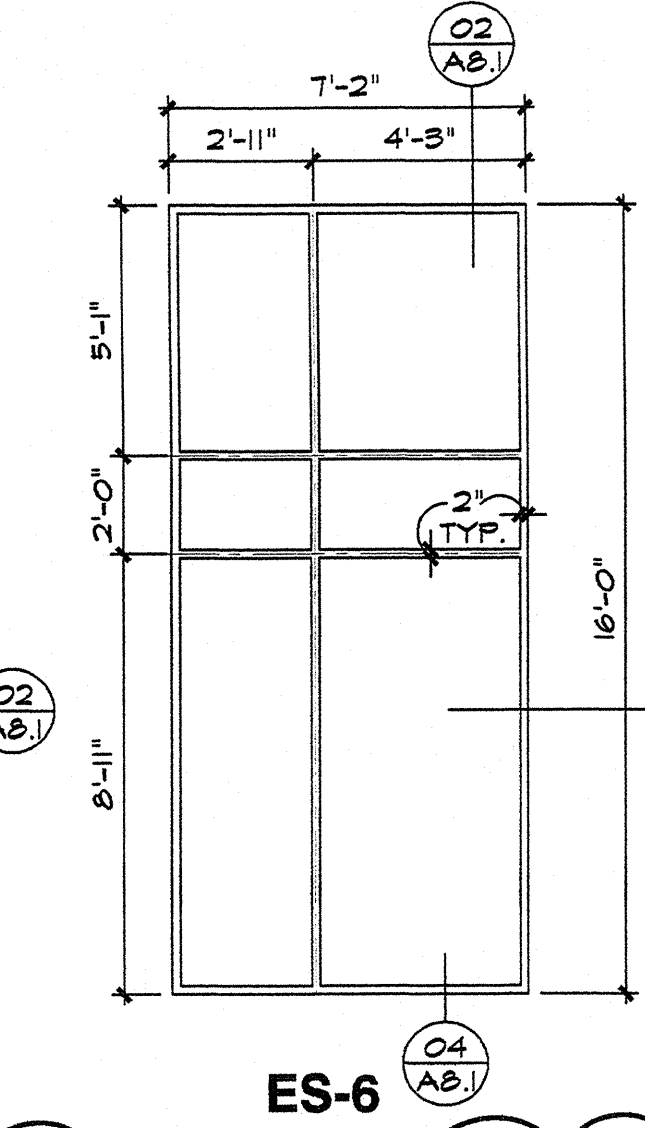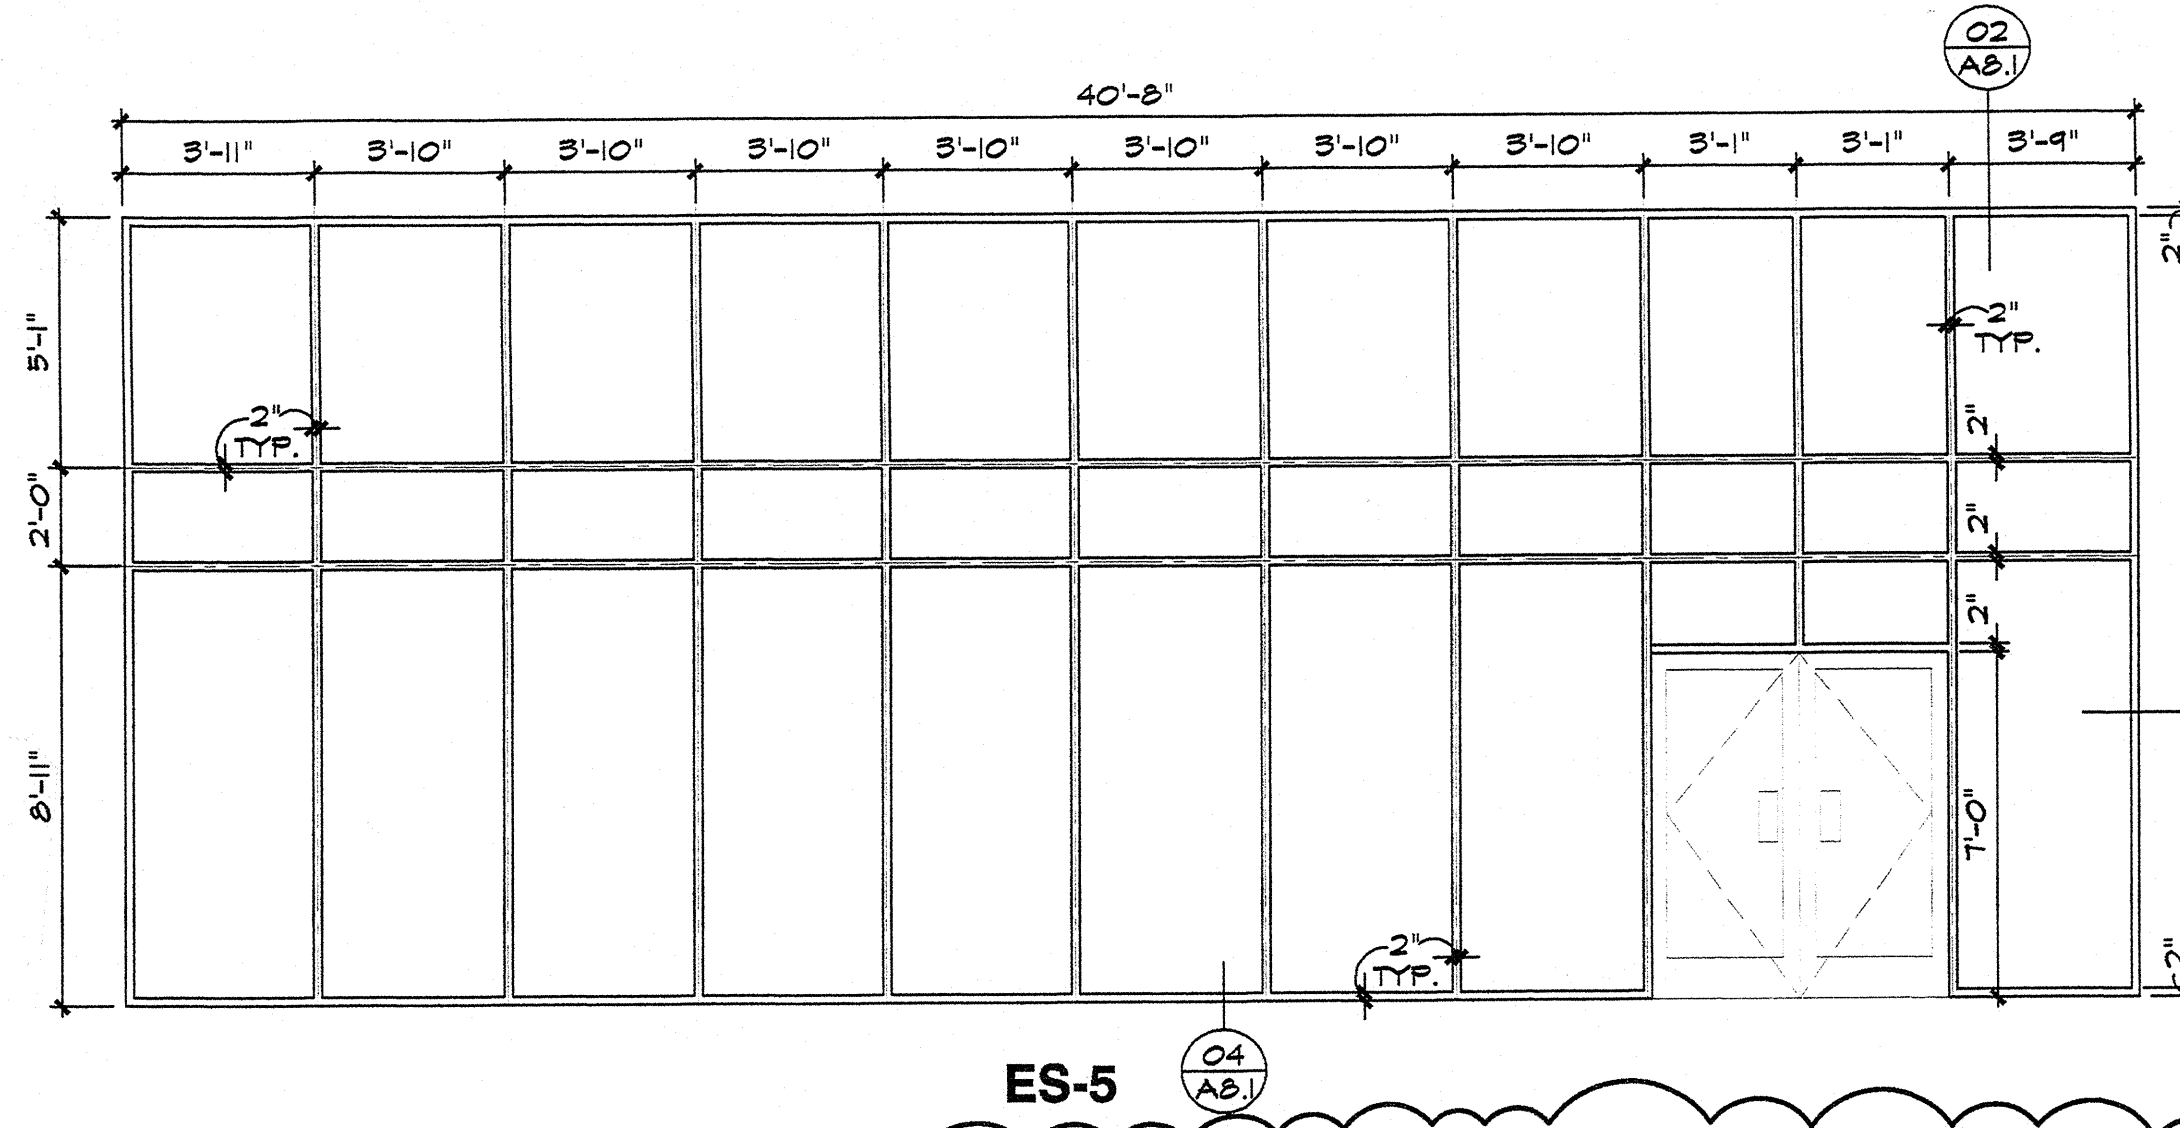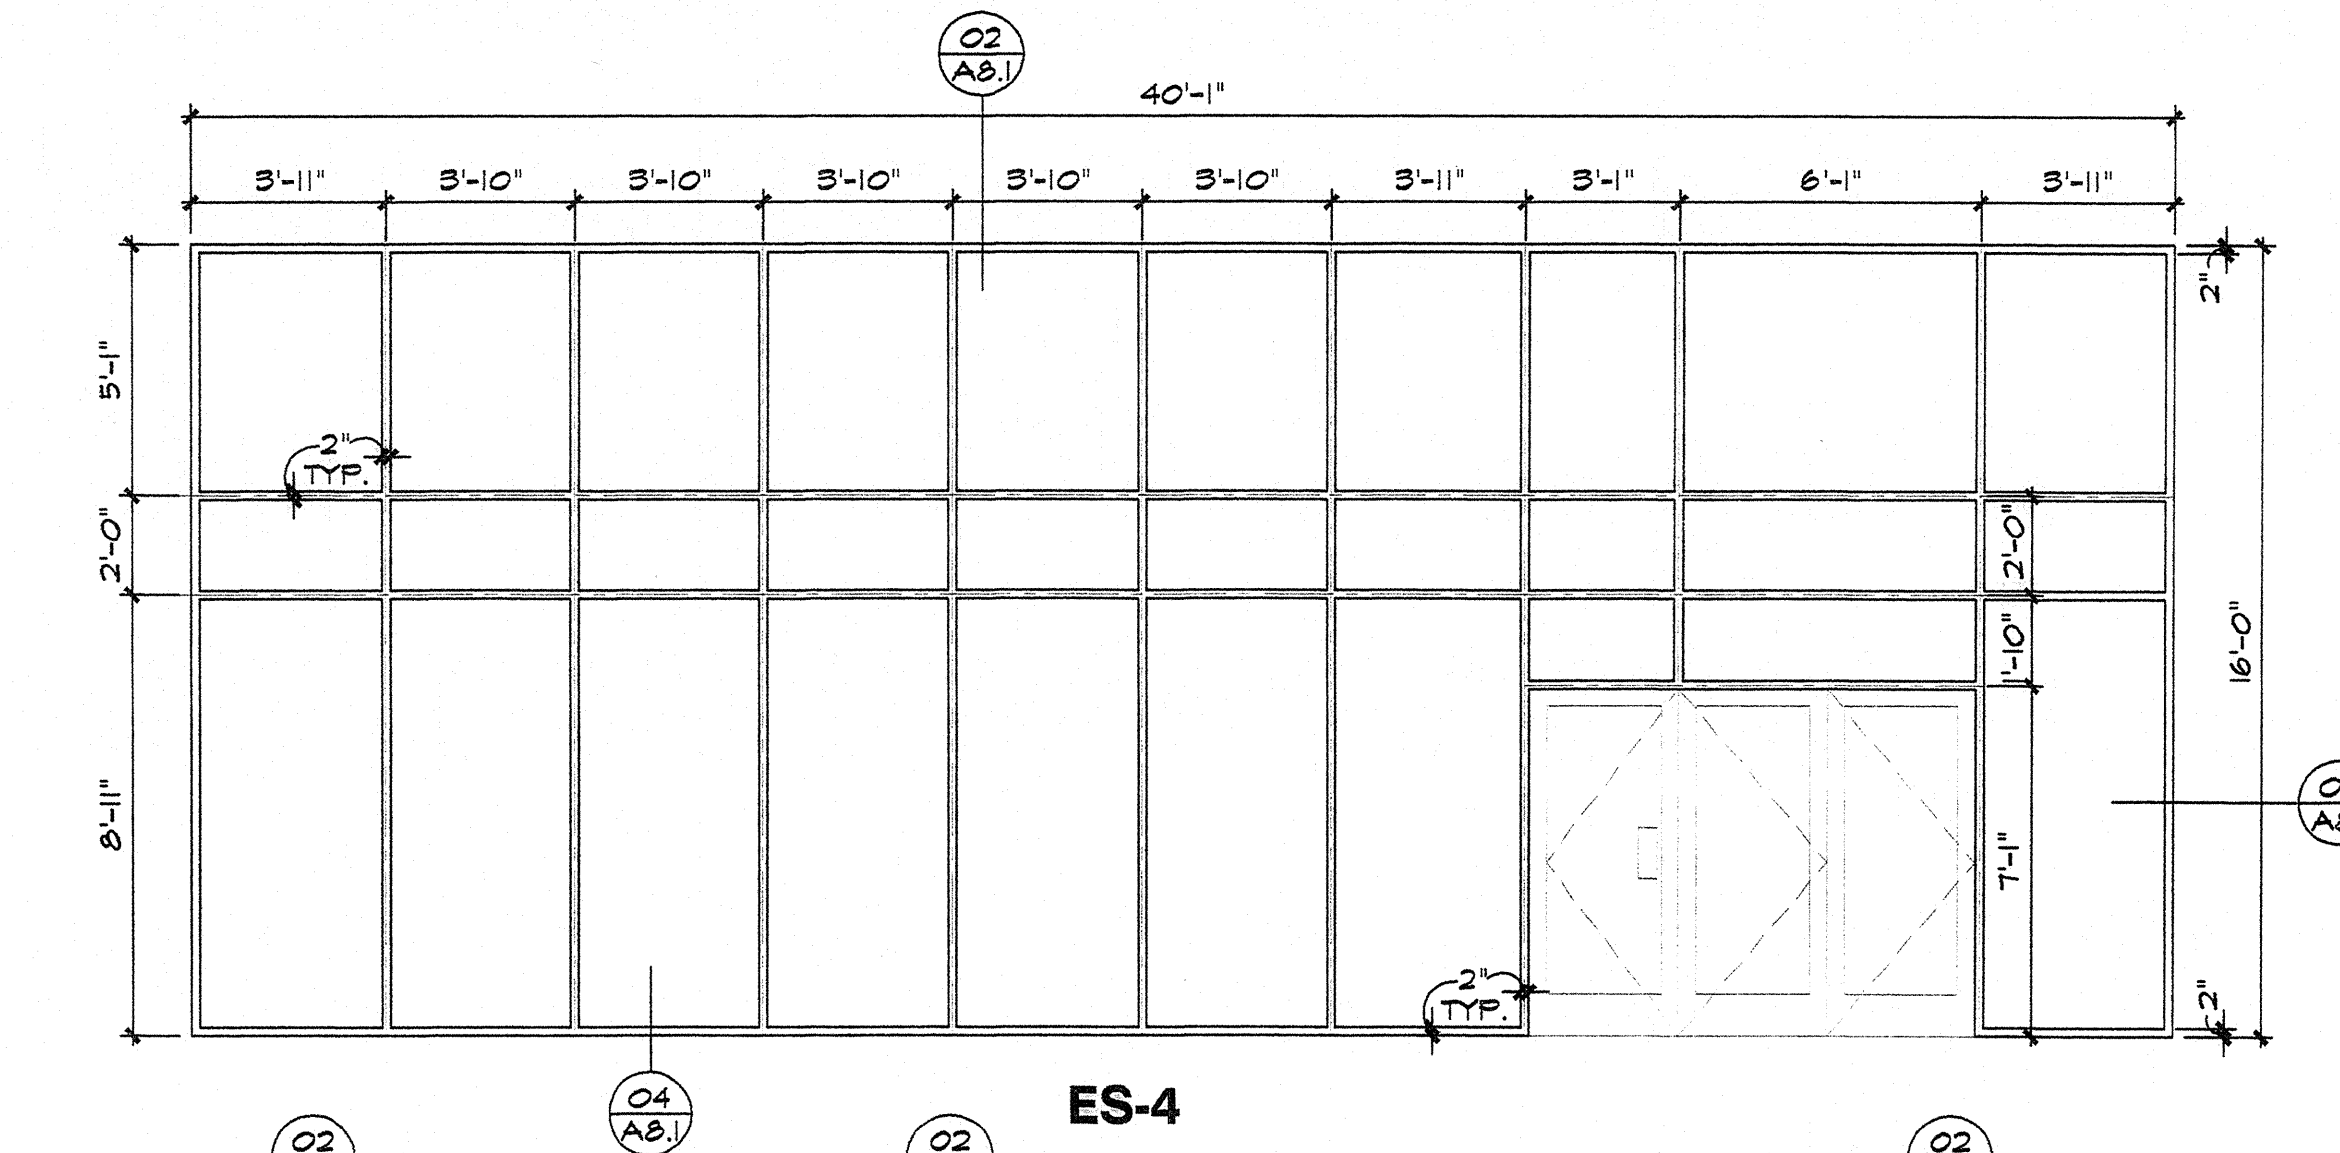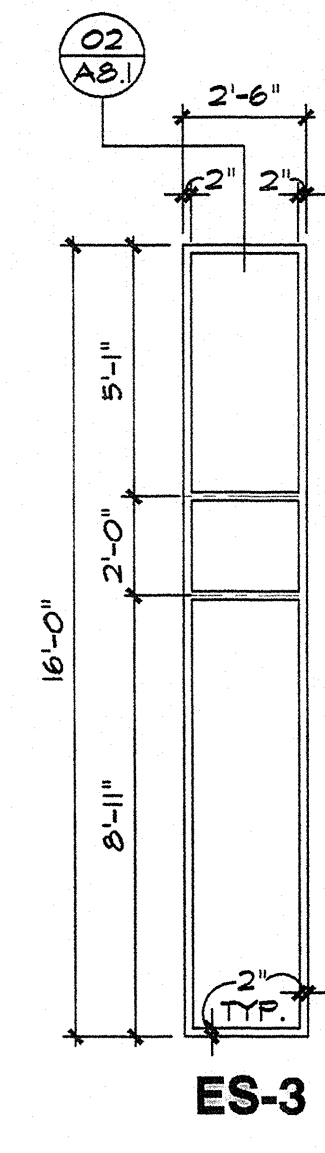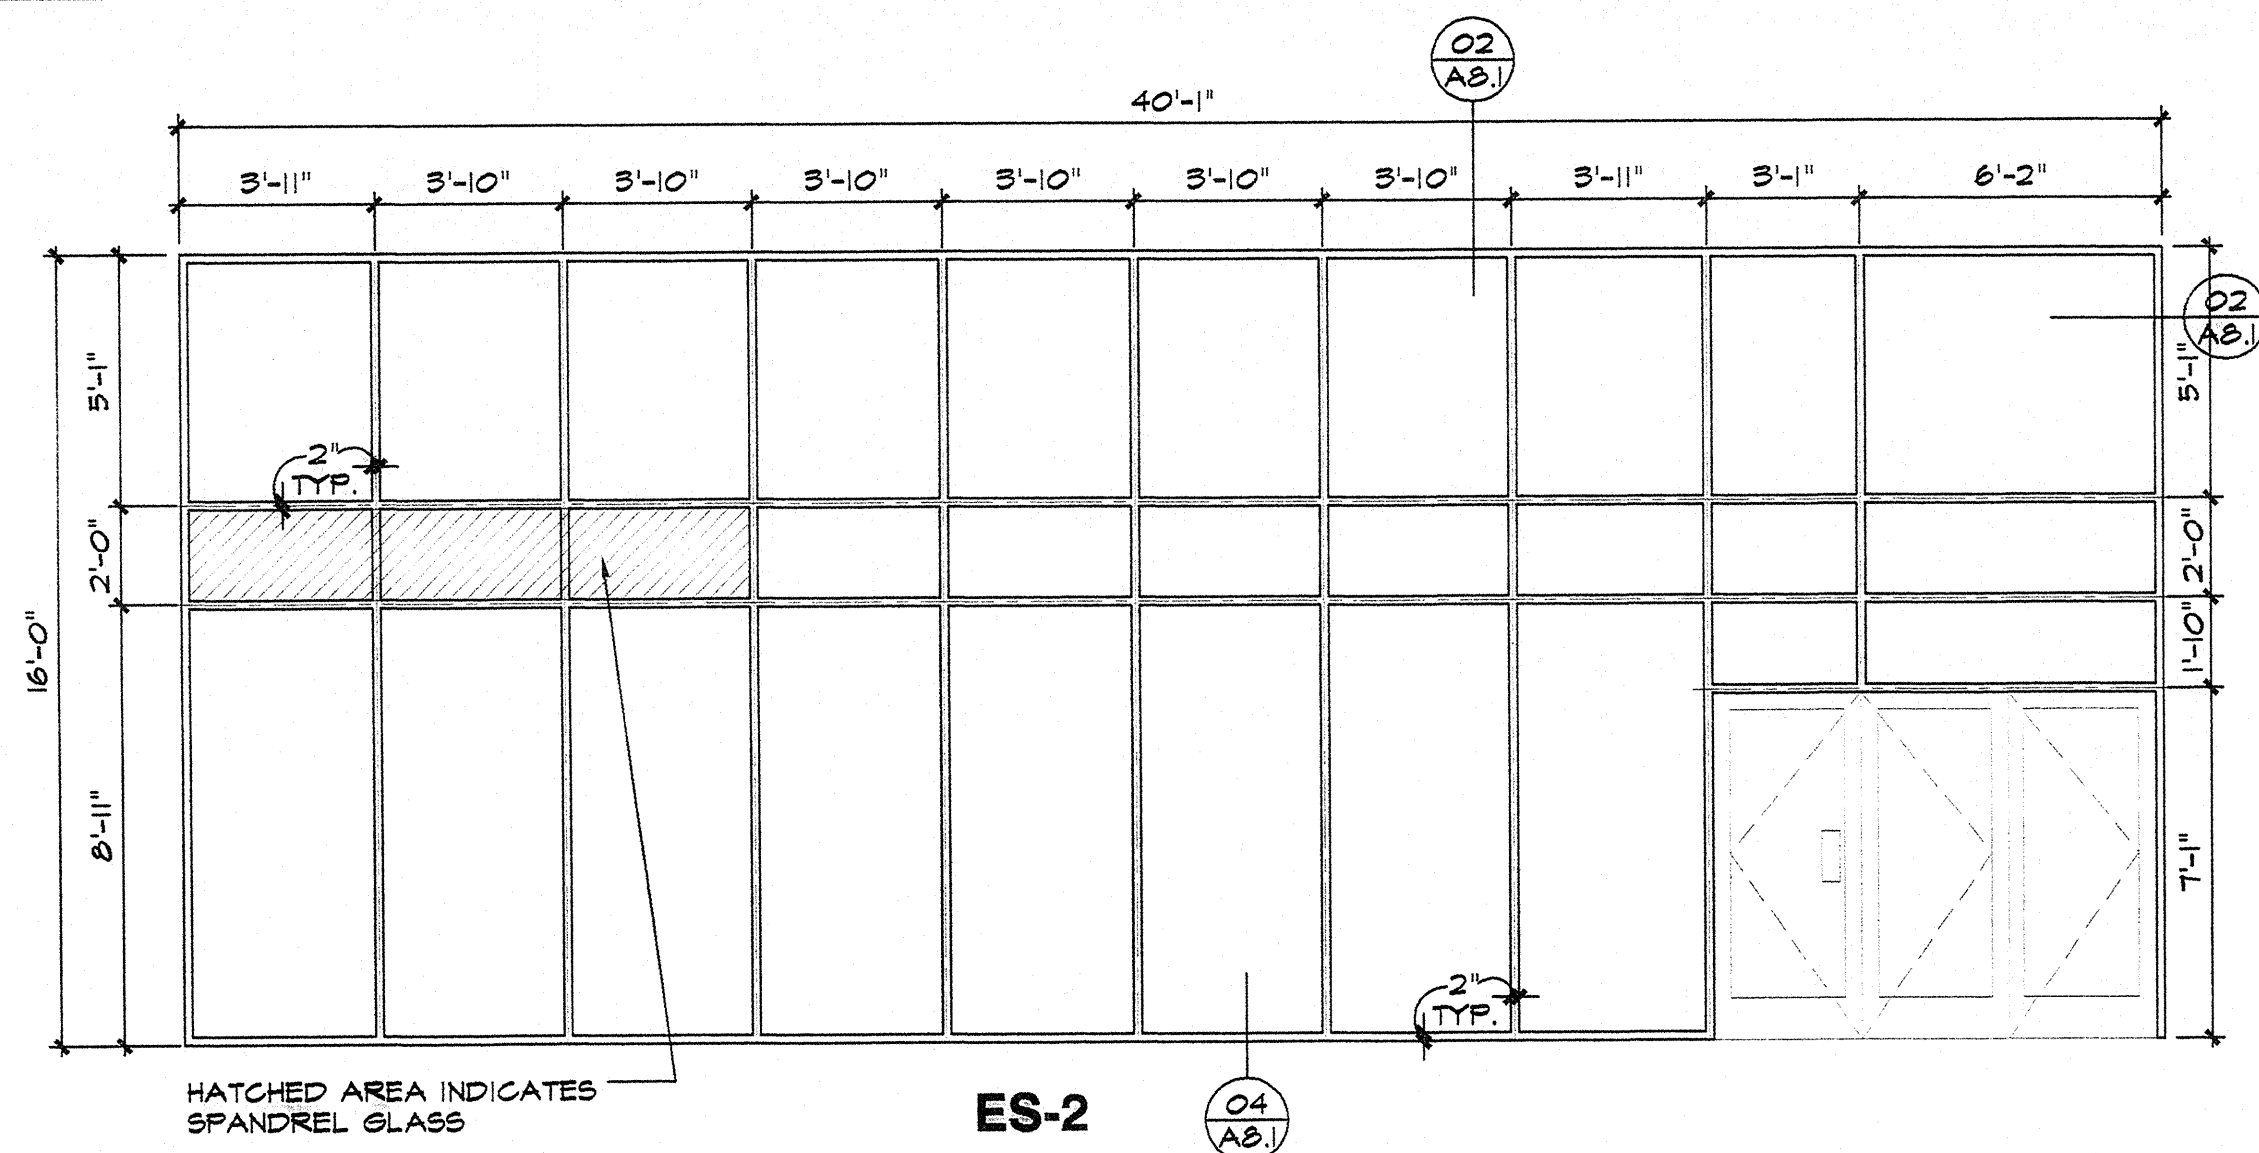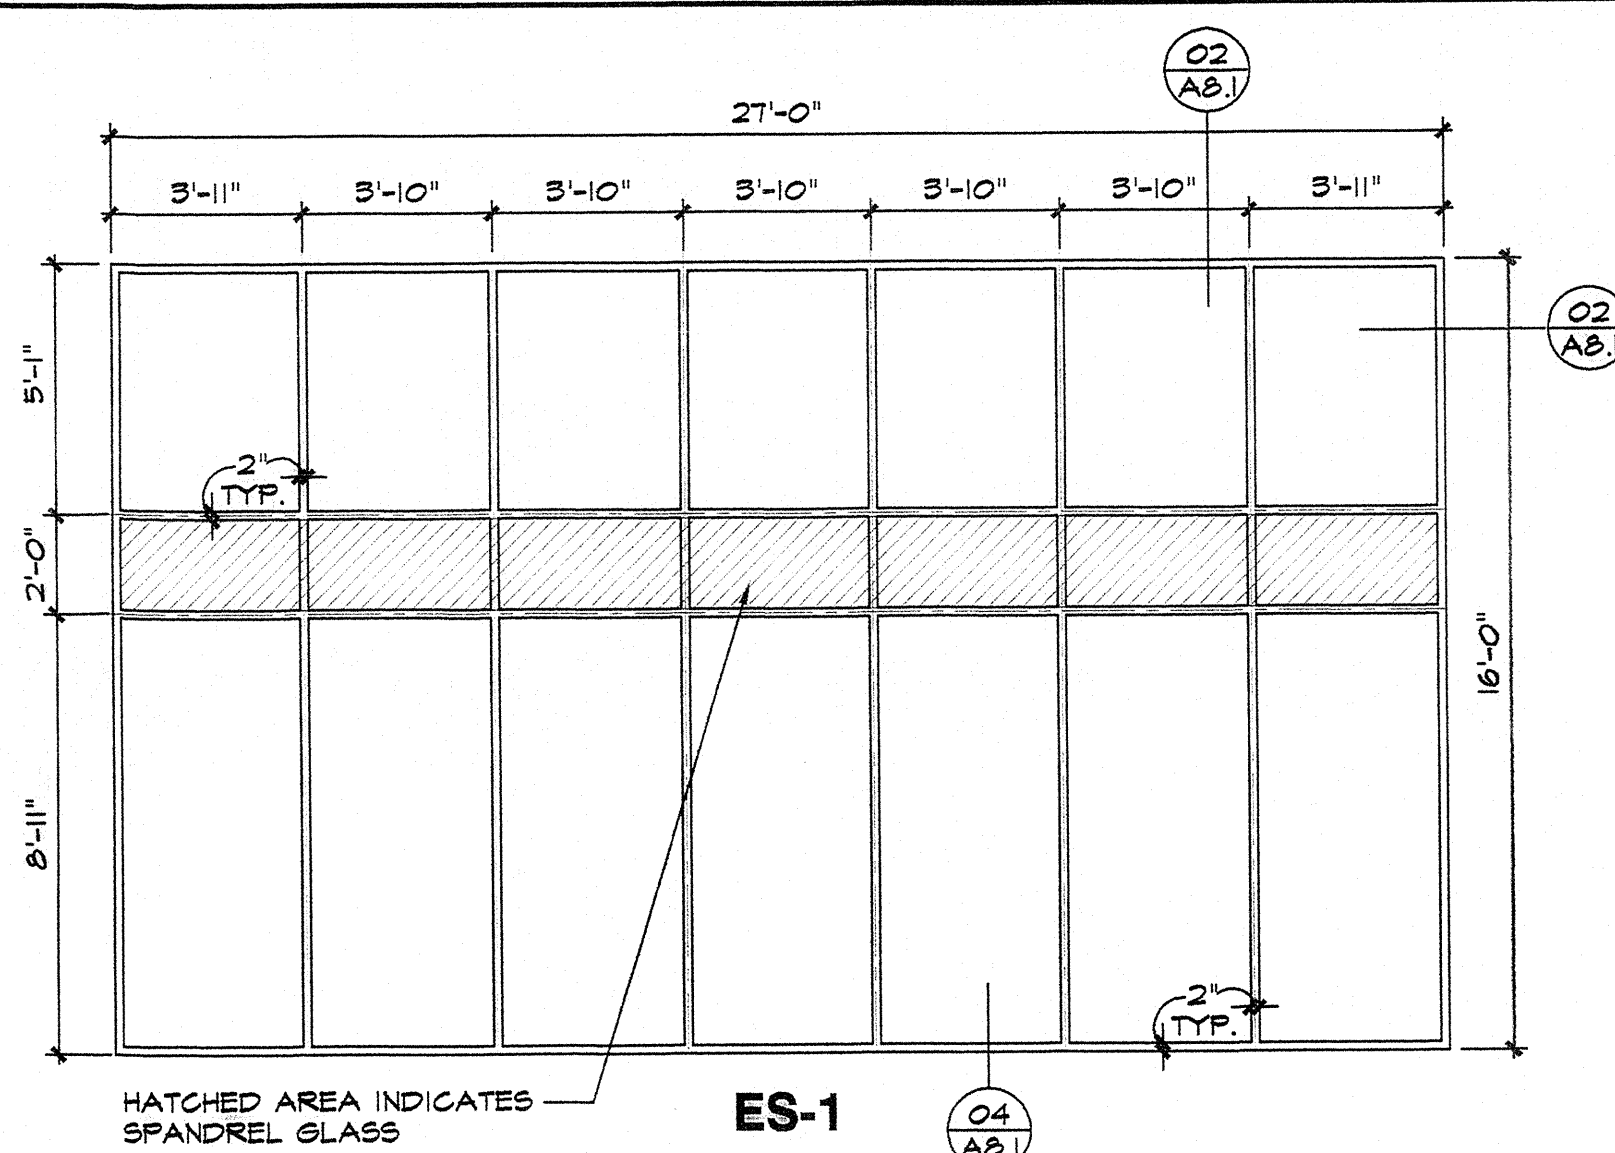

DOOR SCHEDULE - FIRST FLOOR


NUMBER	SIZE	DOOR TYPE	MATL	THICK	FINISH	RATING	FRAME TYPE	FRAME MATL	FRAME FINISH	JAMB DETAIL	HEAD DETAIL	SILL DETAIL	NOTES
D101	(2)3070	E	ALUMIN	1 3/4"	AS SPECIFIED	N/A	2	ALUMINUM	AS SPECIFIED	22/A8.1	21/A8.1	10/A8.1	-
D102	3070/8070	D	ALUMIN	1 3/4"	AS SPECIFIED	N/A	1	ALUMINUM	AS SPECIFIED	22/A8.1	21/A8.1	10/A8.1	-
D103	(2)3070	E	ALUMIN	1 3/4"	AS SPECIFIED	N/A	2	ALUMINUM	AS SPECIFIED	22/A8.1	21/A8.1	10/A8.1	-
D104	3070/8070	D	ALUMIN	1 3/4"	AS SPECIFIED	N/A	1	ALUMINUM	AS SPECIFIED	22/A8.1	21/A8.1	10/A8.1	-
D105	3070/8070	D	ALUMIN	1 3/4"	AS SPECIFIED	N/A	1	ALUMINUM	AS SPECIFIED	22/A8.1	21/A8.1	10/A8.1	-
D106	3070	J	S.W.	1 3/4"	P-2	N/A	6	ALUMINUM	AS SPECIFIED	26/A8.1	11/A8.1	15/A8.1	-
D107	3070	J	S.W.	1 3/4"	P-2	N/A	7	ALUMINUM	AS SPECIFIED	26/A8.1	11/A8.1	15/A8.1	-
D108	3070	J	S.W.	1 3/4"	P-2	N/A	6	ALUMINUM	AS SPECIFIED	26/A8.1	11/A8.1	15/A8.1	-
D109	3070	J	S.W.	1 3/4"	P-2	N/A	6	ALUMINUM	AS SPECIFIED	26/A8.1	11/A8.1	15/A8.1	-
D110	3070	N/A	STL	1 3/4"	P-2	.75 HR "C" LABEL	N/A	STL	P-2	N/A	N/A	N/A	-
D111	3070	J	S.W.	1 3/4"	P-2	N/A	5	ALUMINUM	AS SPECIFIED	11/A8.1	11/A8.1	15/A8.1	-
D112	3070	J	S.W.	1 3/4"	P-2	N/A	5	ALUMINUM	AS SPECIFIED	11/A8.1	011/A8.1	15/A8.1	-
D113	3070	J	S.W.	1 3/4"	P-2	N/A	5	ALUMINUM	AS SPECIFIED	11/A8.1	11/A8.1	15/A8.1	-
D114	3070	J	S.W.	1 3/4"	P-2	N/A	9	H.M.	P-2	12/A8.1	12/A8.1	14/A8.1	-
D115	3070	H	H.M.	1 3/4"	P-2	.75 HR "C" LABEL	9	H.M.	P-2	07/A8.1	07/A8.1	09/A8.1	-
D116	3070	H	H.M.	1 3/4"	P-2	.75 HR "C" LABEL	9	H.M.	P-2	12/A8.1	12/A8.1	14/A8.1	-
D117	3070	H	H.M.	1 3/4"	P-2	.75 HR "C" LABEL	9	H.M.	P-2	12/A8.1	12/A8.1	14/A8.1	-
D118	3070	F	ALUMIN	1 3/4"	AS SPECIFIED	N/A	3	ALUMINUM	AS SPECIFIED	22/A8.1	21/A8.1	10/A8.1	-
D119	3070	H	H.M.	1 3/4"	P-2	1.5 HR "B" LABEL	9	H.M.	P-2	13/A8.1	13/A8.1	14/A8.1	-
D120	3070	F	ALUMIN	1 3/4"	AS SPECIFIED	N/A	5	ALUMINUM	AS SPECIFIED	11/A8.1	11/A8.1	15/A8.1	-
D121	3070	J	S.W.	1 3/4"	P-2	N/A	5	ALUMINUM	AS SPECIFIED	11/A8.1	11/A8.1	15/A8.1	-
D122	3070	H	H.M.	1 3/4"	P-2	1.5 HR "B" LABEL	9	H.M.	P-2	13/A8.1	13/A8.1	14/A8.1	-
D123	3870	H	H.M.	1 3/4"	P-2	1.5 HR "B" LABEL	10	H.M.	P-2	13/A8.1	13/A8.1	14/A8.1	-
D124	4070	H	H.M.	1 3/4"	P-2	1.5 HR "B" LABEL	11	H.M.	P-2	13/A8.1	13/A8.1	14/A8.1	-
D125	(2)3070	L	HM	1 3/4"	P-2	1.5 HR "B" LABEL	12	HM	P-2	11/A8.1	11/A8.1	14/A8.1	-
D126	3070	K	HM	1 3/4"	P-2	N/A	9	HM	P-2	11/A8.1	11/A8.1	15/A8.1	-
D127	3070	J	S.W.	1 3/4"	P-2	1.5 HR "B" LABEL	9	H.M.	P-2	13/A8.1	13/A8.1	14/A8.1	-
D128	3070	J	S.W.	1 3/4"	AS SPECIFIED	N/A	5	ALUMINUM	AS SPECIFIED	11/A8.1	11/A8.1	15/A8.1	-
D129	3070	H	H.M.	1 3/4"	AS SPECIFIED	N/A	9	H.M.	P-2	11/A8.1	11/A8.1	14/A8.1	-
D130	3870	G	H.M.	1 3/4"	P-2	N/A	10	H.M.	P-2	11/A8.1	11/A8.1	15/A8.1	-
D131	8'X10'	C	STL	1 3/4"	P-2	N/A	N/A	STL	P-2	24/A8.1	24/A8.1	18/A8.1	-
D132	3070	H	H.M.	1 3/4"	P-2	N/A	9	H.M.	P-2	07/A8.1	07/A8.1	09/A8.1	-
D133	18'X12'	A	STL	1 3/4"	P-2	N/A	N/A	N/A	P-2	19/A8.1	18/A8.1	09/A8.1	-
D134	3070	H	H.M.	1 3/4"	P-2	N/A	9	H.M.	P-2	06/A8.1	06/A8.1	09/A8.1	-
D135	3070	H	H.M.	1 3/4"	P-2	N/A	9	H.M.	P-2	06/A8.1	06/A8.1	14/A8.1	-
D136	10'X10'	B	STL	1 3/4"	P-2	N/A	N/A	N/A	P-2	17/A8.1	17/A8.1	18/A8.1	-
D137	10'X10'	B	STL	1 3/4"	P-2	N/A	N/A	N/A	P-2	17/A8.1	17/A8.1	18/A8.1	-
D138	10'X10'	B	STL	1 3/4"	P-2	N/A	N/A	N/A	P-2	17/A8.1	17/A8.1	18/A8.1	-
D139	10'X10'	B	STL	1 3/4"	P-2	N/A	N/A	N/A	P-2	17/A8.1	17/A8.1	18/A8.1	-
D140	18'X12'	A	STL	1 3/4"	P-2	N/A	N/A	N/A	P-2	18/A8.1	18/A8.1	18/A8.1	-
D141	3070	H	H.M.	1 3/4"	P-2	N/A	9	H.M.	P-2	08/A8.1	08/A8.1	09/A8.1	-

DOOR SCHEDULE - SECOND FLOOR

NUMBER	SIZE	DOOR TYPE	MATL	THICK	FINISH	RATING	FRAME TYPE	FRAME MATL	FRAME FINISH	JAMB DETAIL	HEAD DETAIL	SILL DETAIL	NOTES
D200	3070	J	H.M.	1 3/4"	P-2	N/A	3	ALUMINUM	AS SPECIFIED	11/A8.1	11/A8.1	15/A8.1	-
D201	3070	N/A	STL	1 3/4"	P-2	.75 HR "C" LABEL	N/A	N/A	AS SPECIFIED	N/A	N/A	N/A	-
D202	3070	J	S.W.	1 3/4"	P-2	N/A	3	ALUMINUM	AS SPECIFIED	11/A8.1	11/A8.1	15/A8.1	-
D203	3870	J	S.W.	1 3/4"	P-2	N/A	4	ALUMINUM	AS SPECIFIED	11/A8.1	11/A8.1	15/A8.1	-
D204	3070	J	S.W.	1 3/4"	P-2	N/A	3	ALUMINUM	AS SPECIFIED	11/A8.1	11/A8.1	15/A8.1	-
D205	3070	J	S.W.	1 3/4"	P-2	N/A	3	ALUMINUM	AS SPECIFIED	02/A8.1	01/A8.1	03/A8.1	-
D206	3070	J	S.W.	1 3/4"	P-2	N/A	3	ALUMINUM	AS SPECIFIED	11/A8.1	11/A8.1	15/A8.1	-
D207	3070	J	S.W.	1 3/4"	P-2	N/A	3	ALUMINUM	AS SPECIFIED	11/A8.1	11/A8.1	15/A8.1	-
D208	3070	H	H.M.	1 3/4"	P-2	1 HR "B" LABEL	9	H.M.	P-2	12/A8.1	12/A8.1	14/A8.1	-
D209	3070	H	H.M.	1 3/4"	P-2	1 HR "B" LABEL	9	H.M.	P-2	12/A8.1	12/A8.1	14/A8.1	-

KEY
 H.M. --- HOLLOW METAL
 S.W. --- SOLID WOOD
 G.L. --- GLASS
 STL. --- STEEL
 ALUMIN. --- ALUMINUM
 G.M. --- GALVANIZED METAL


EXTERIOR STOREFRONT ELEVATIONS

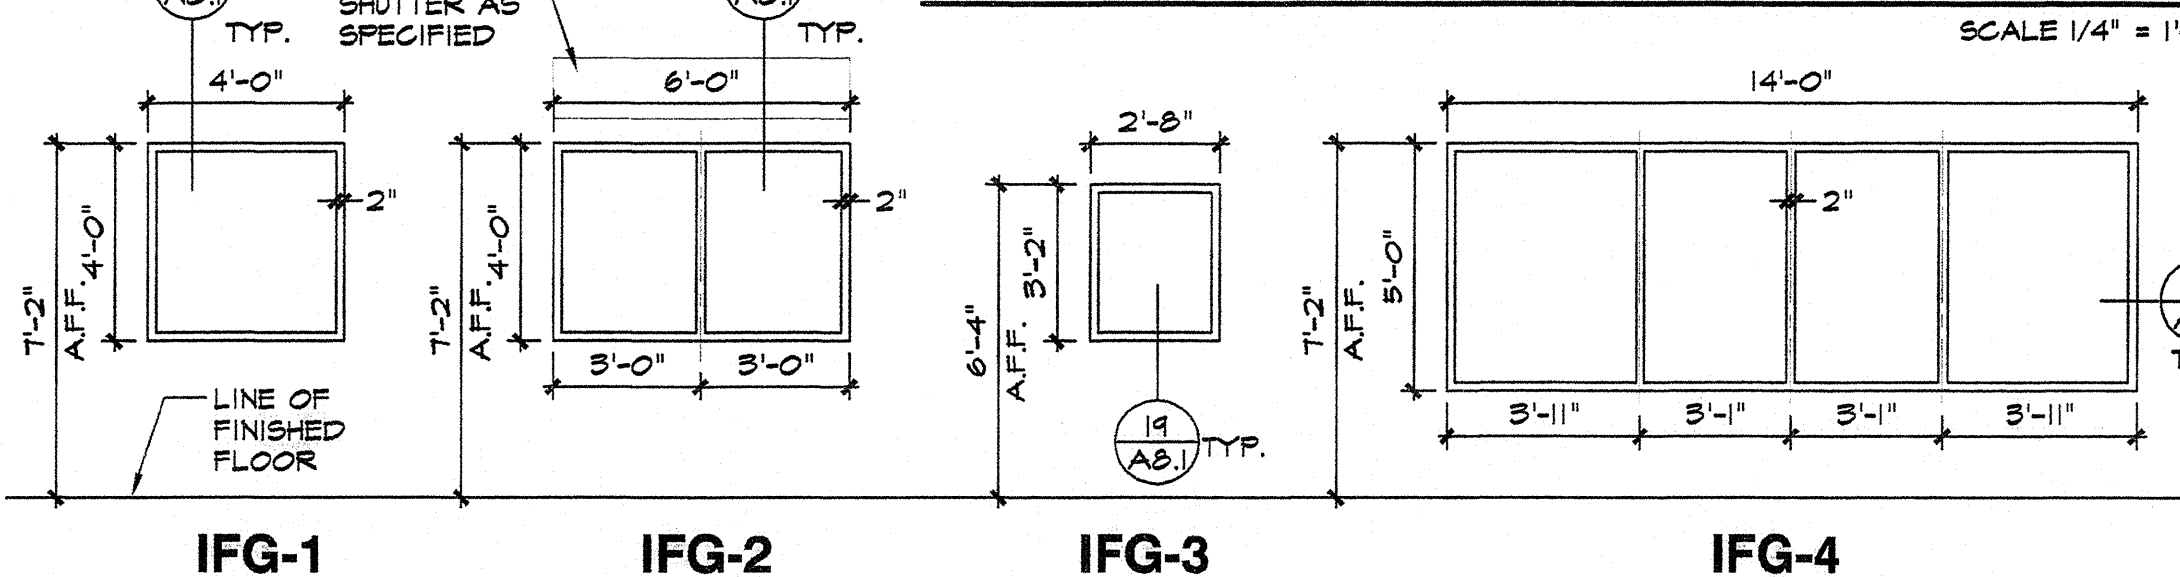

INTERIOR FIXED GLASS



ANODIZED ALUMINUM FRAMES SCALE 1/4" = 1'-0"

NOTE:
 PROVIDE TEMPERED GLASS AS REQUIRED BY SAFETY GLASS CODES TO ALL WINDOWS AND DOORS CONTAINING GLASS.

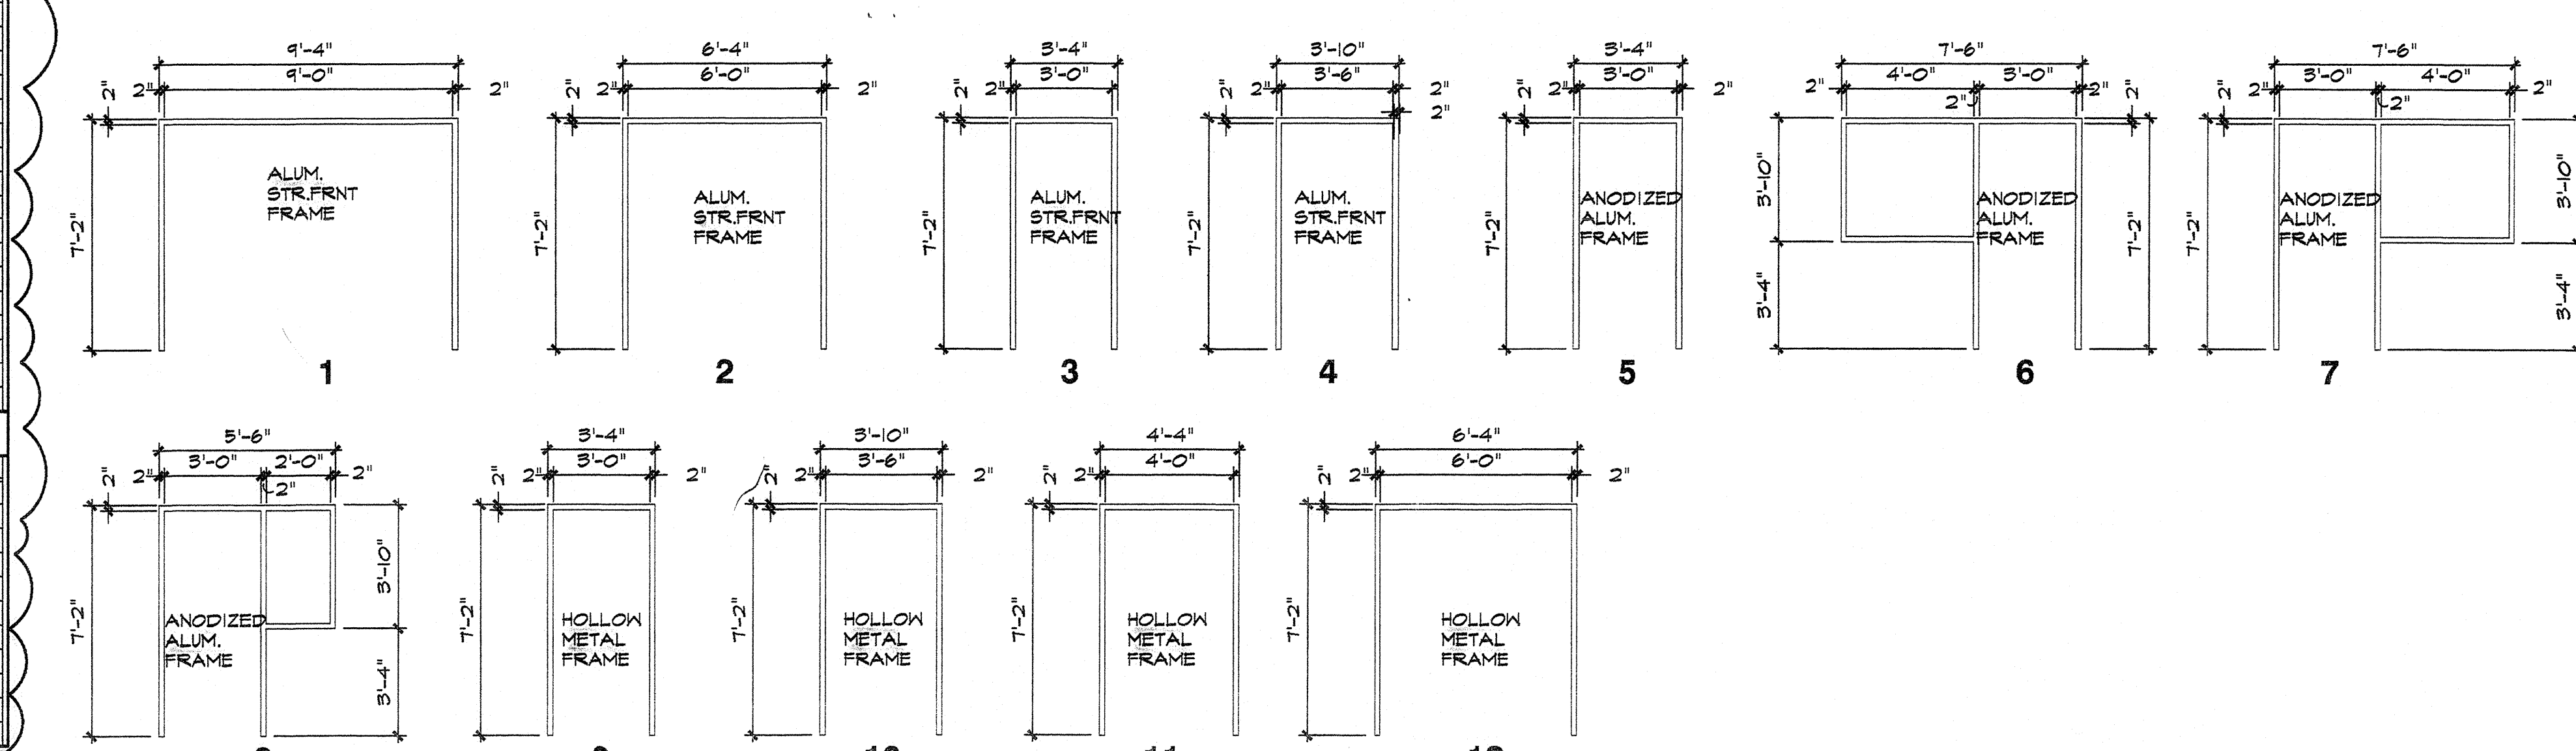

FRAME TYPES

SCALE 1/4" = 1'-0"

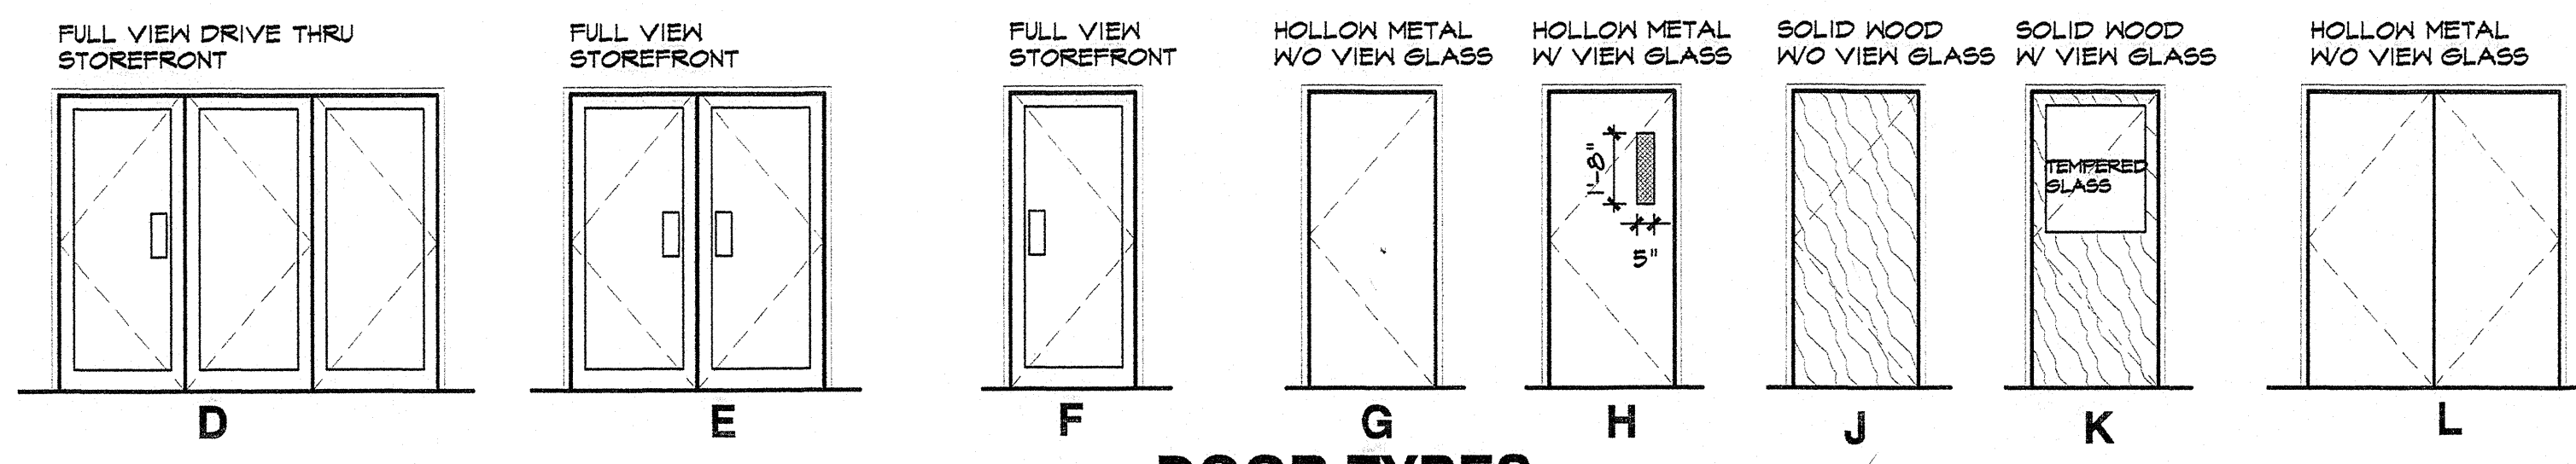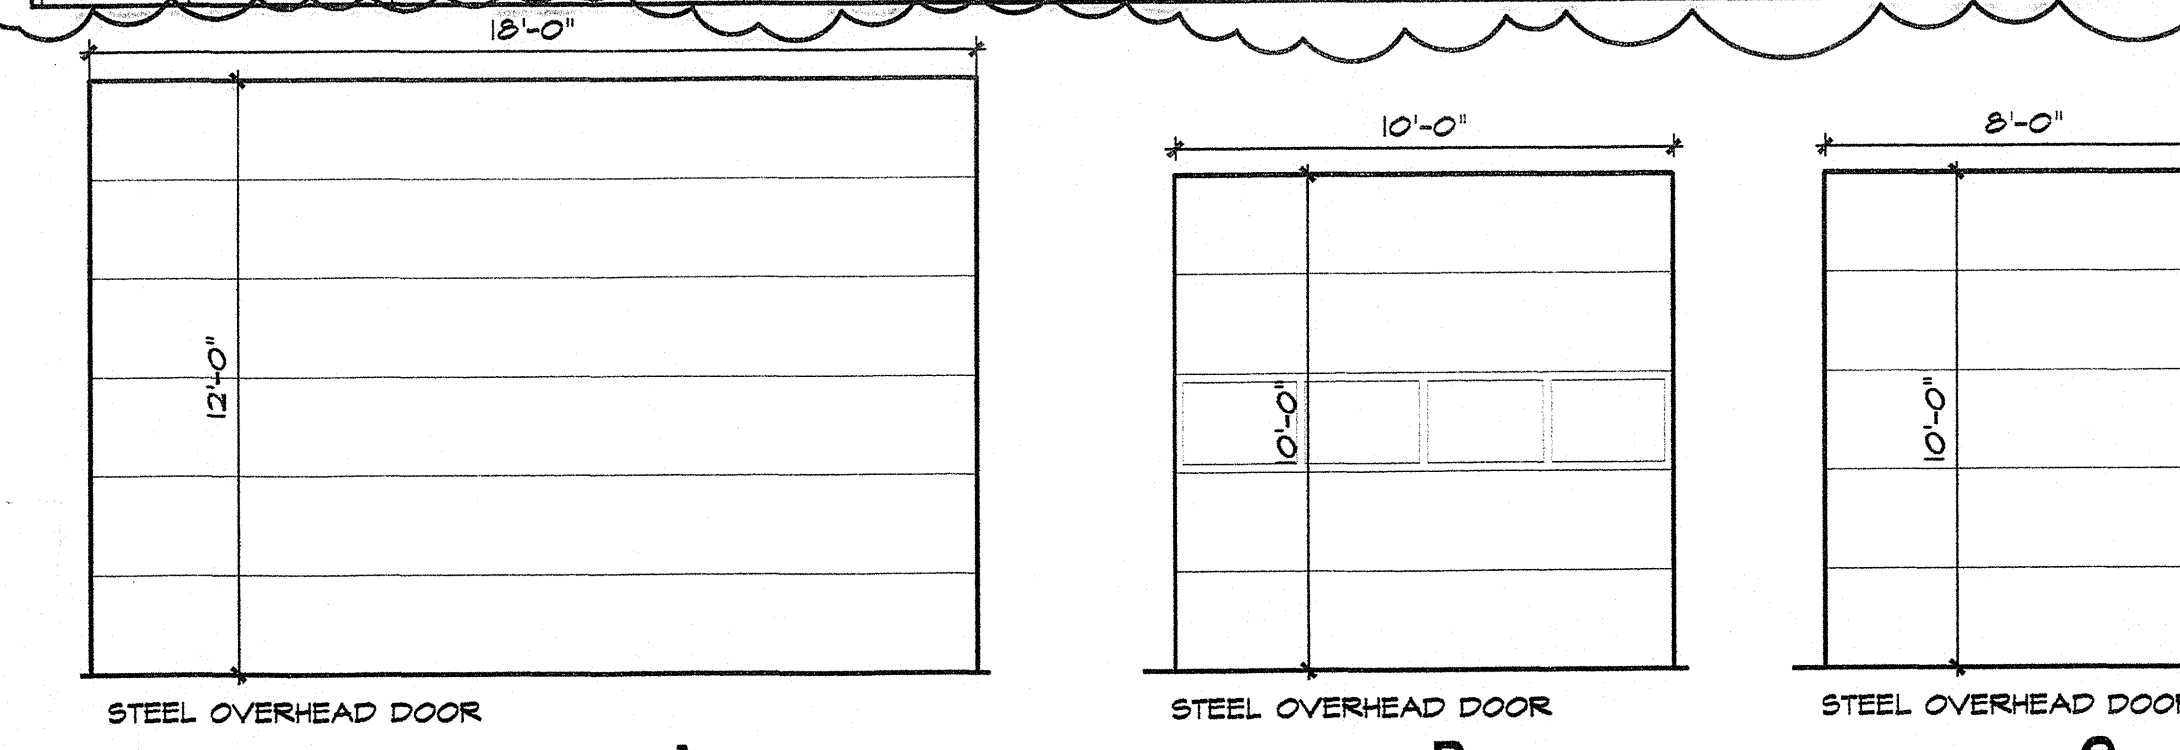

DOOR TYPES


SCALE 1/4" = 1'-0"

AN AUTOMOTIVE DEALERSHIP
ROGER BEASLEY VOLVO

INTERSTATE HIGHWAY 35 SOUTH
 GEORGETOWN, TEXAS


EL SASSER ARCHITECTURAL INC.
 ARCHITECTURE AND PLANNING
 P.O. BOX 833 GEORGETOWN TX 78627
 (512) 585-5555 FAX (512) 585-2818 www.el-sasser.com

REV. #	DESCRIPTION	DATE
1	REMOVED DOOR D210, REVISED DOORS D208 & D201	11/19/02

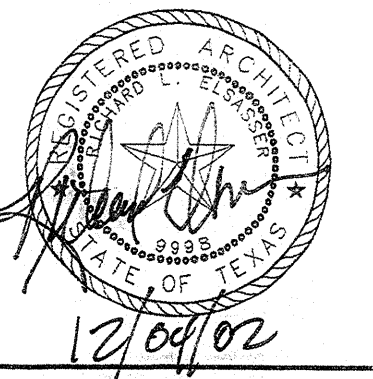


DATE: 09/18/02
 PROJECT NO. 02008
 SHEET NO.


A8.0

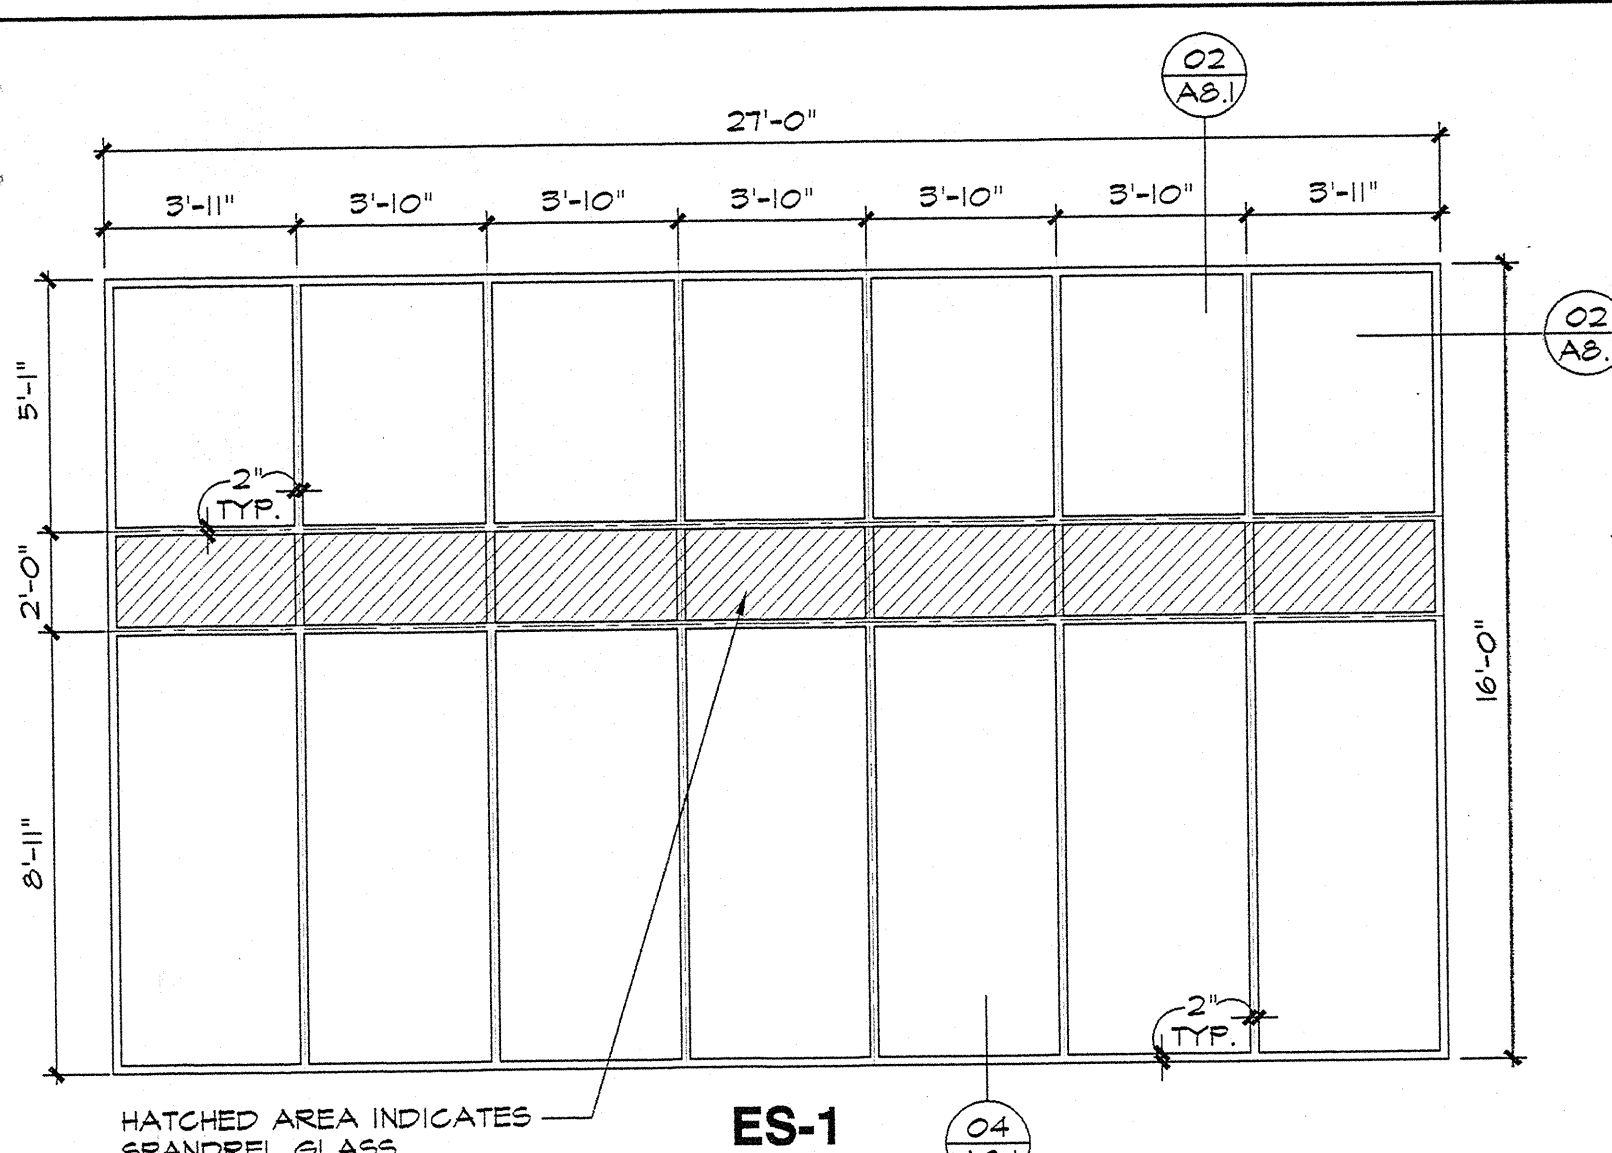


ES-1

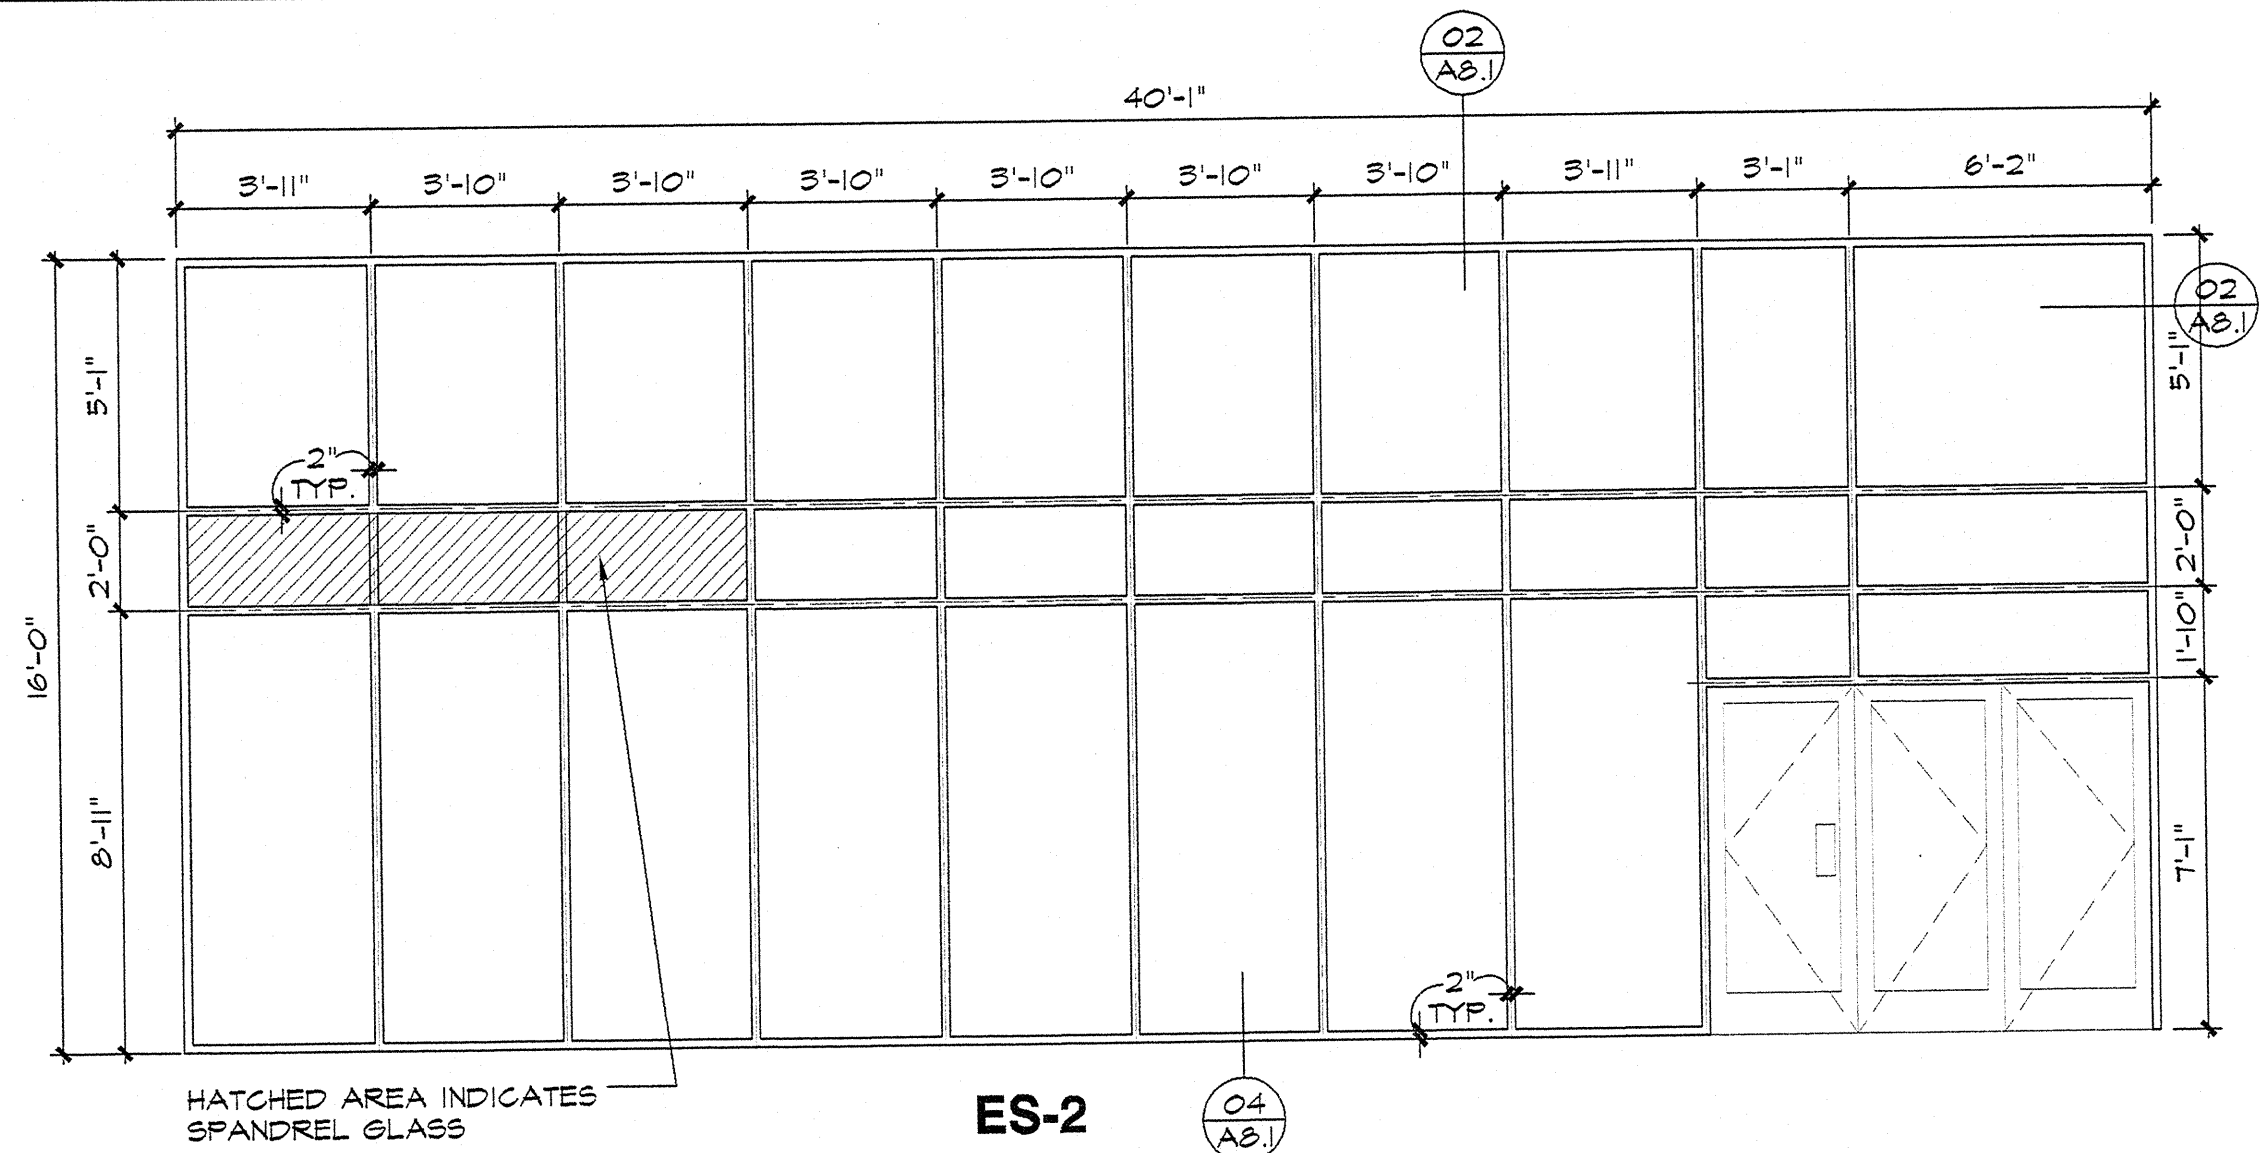


ES-2

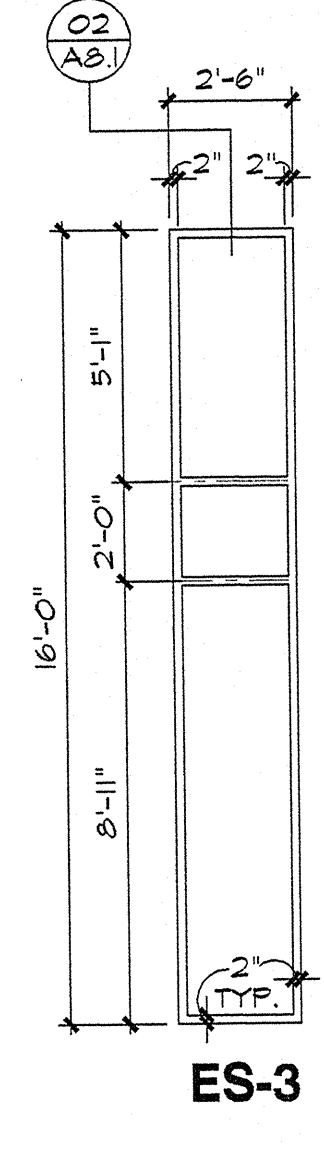


ES-3

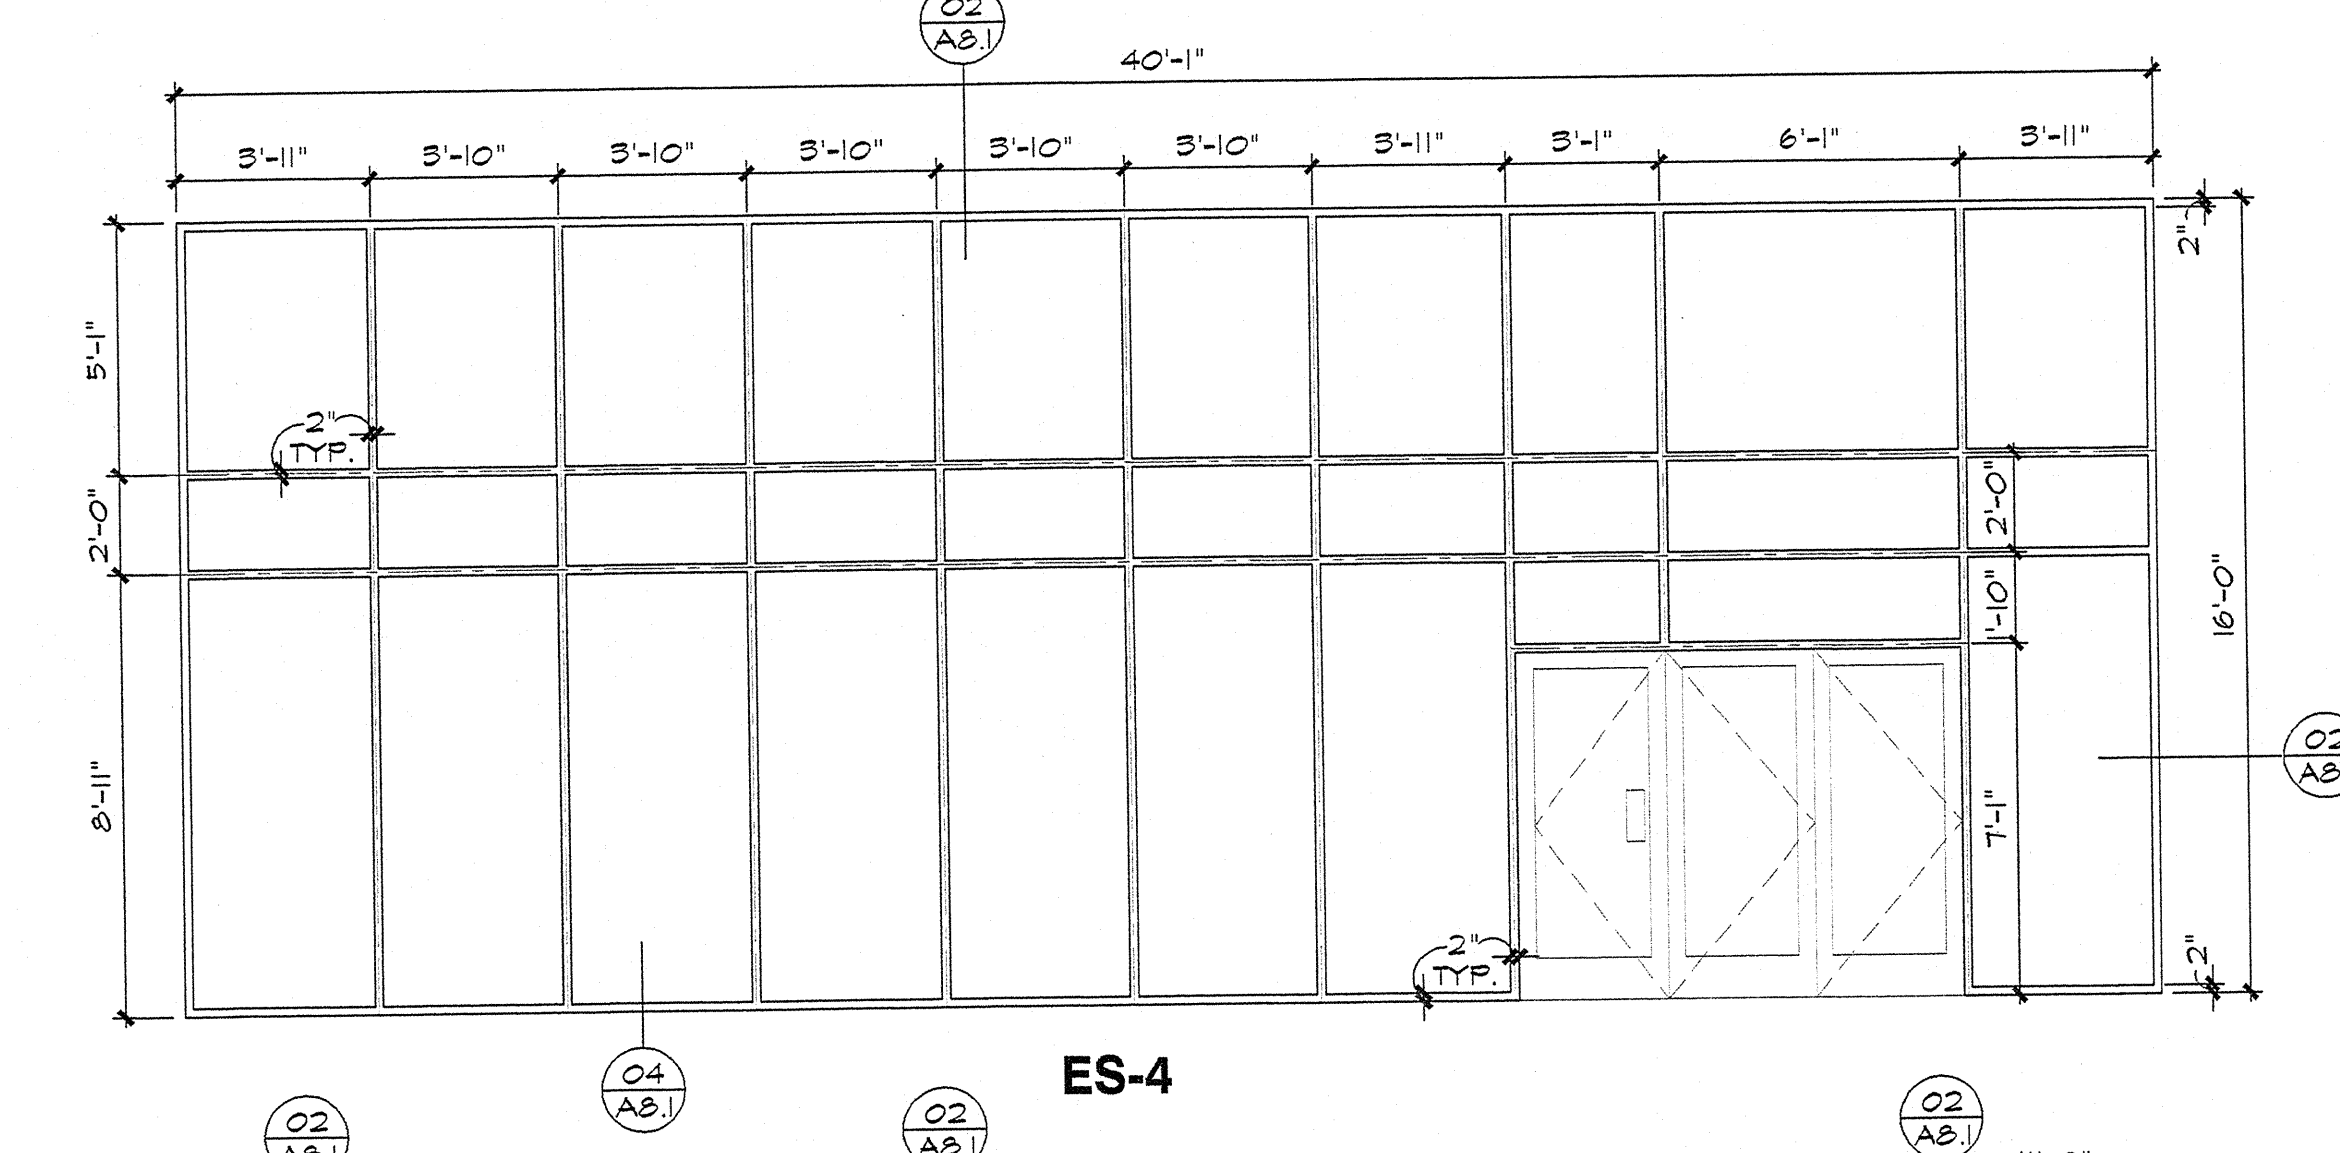


ES-4

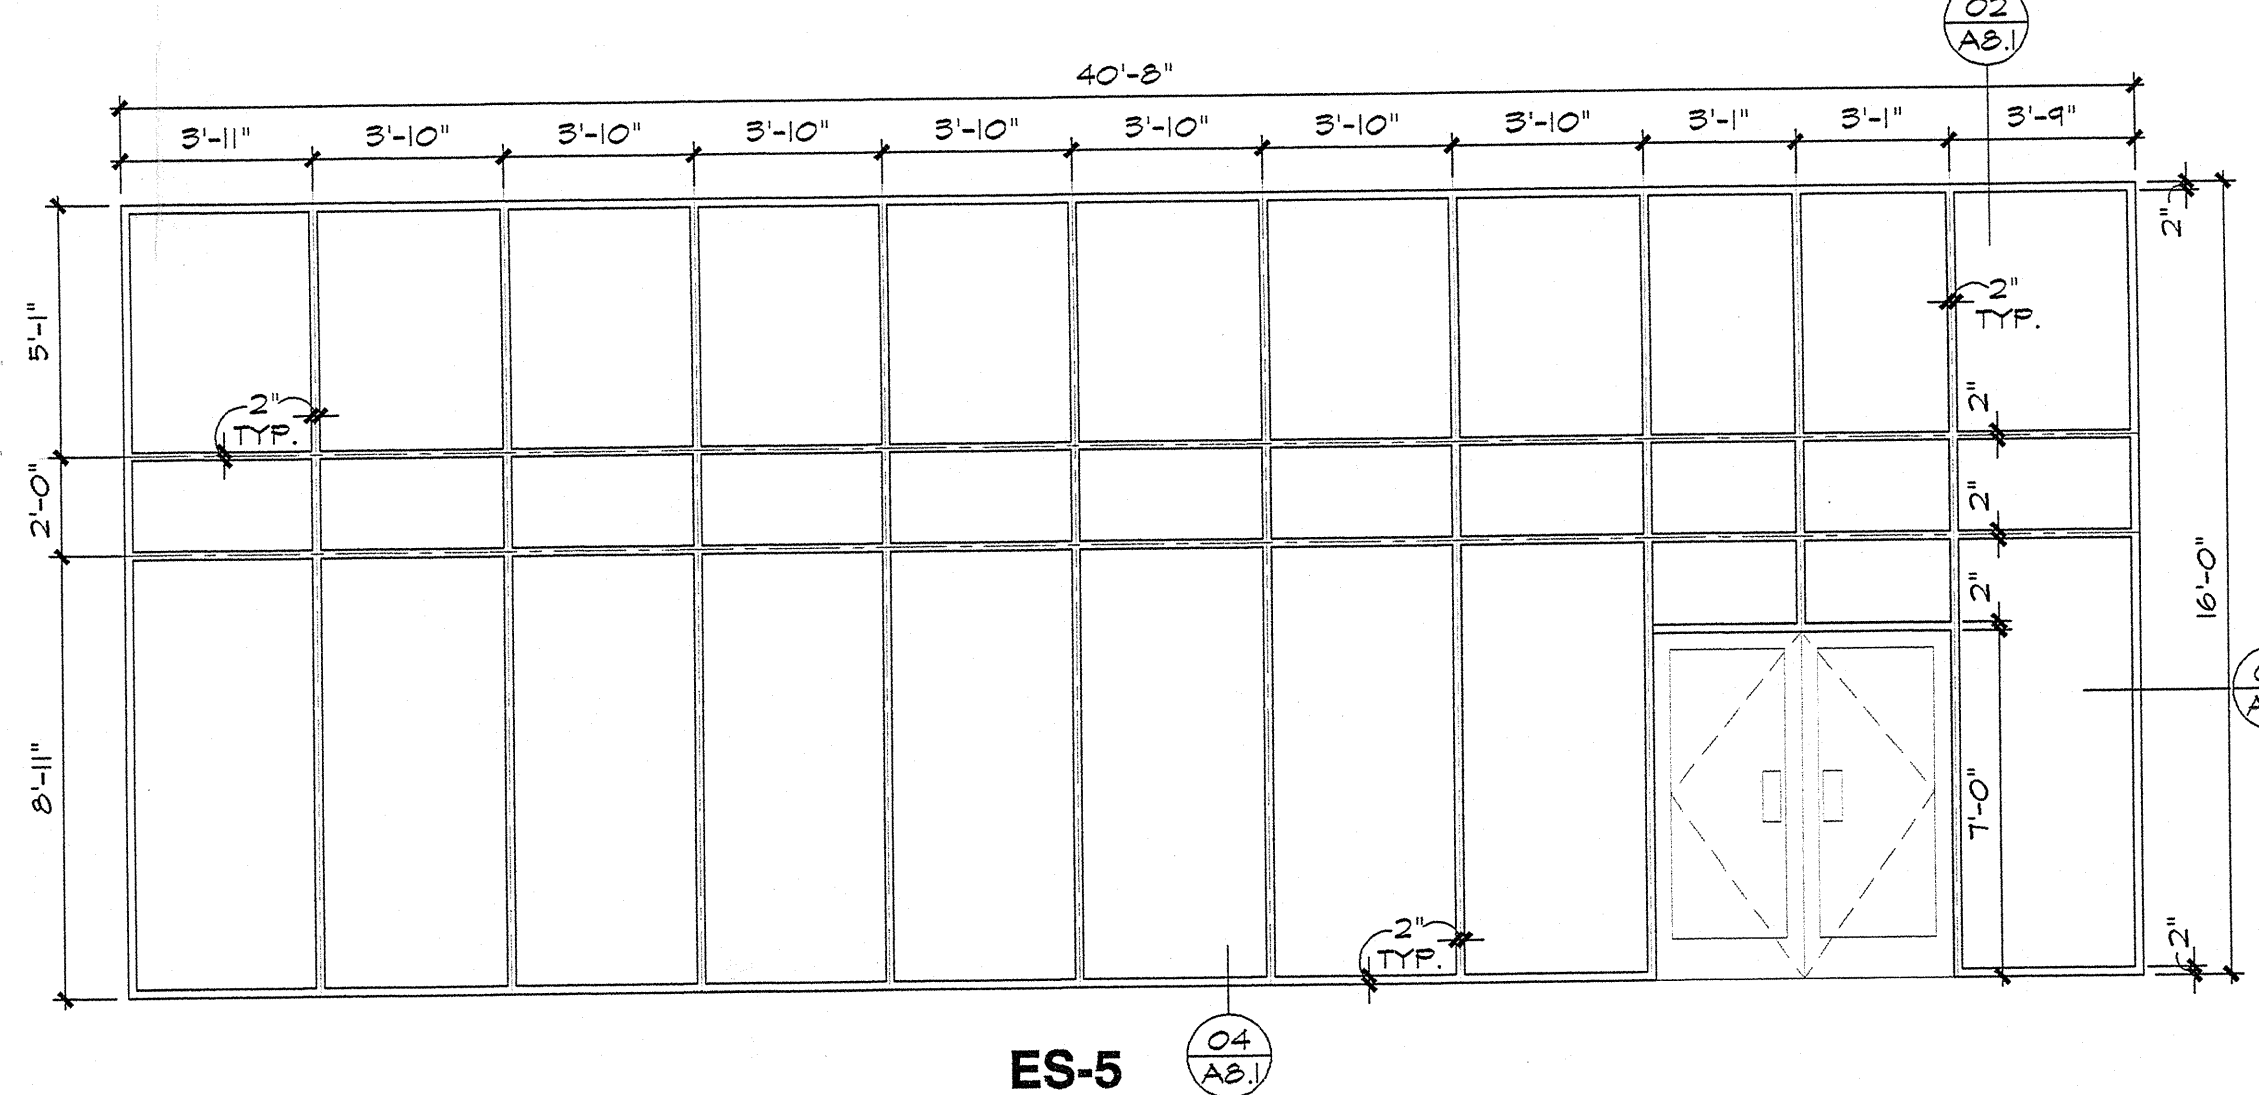


ES-5

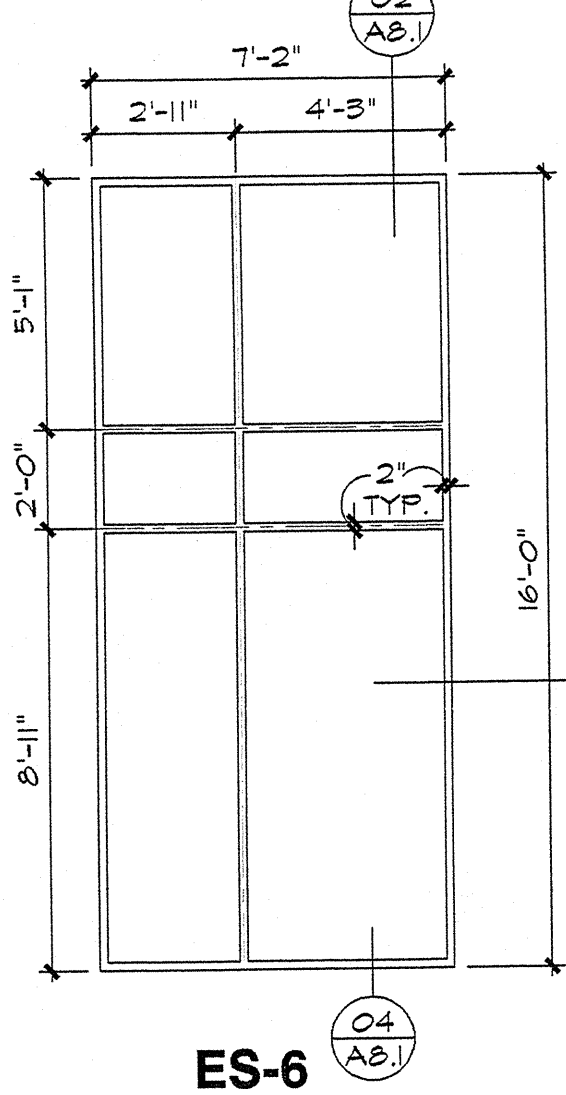


ES-6

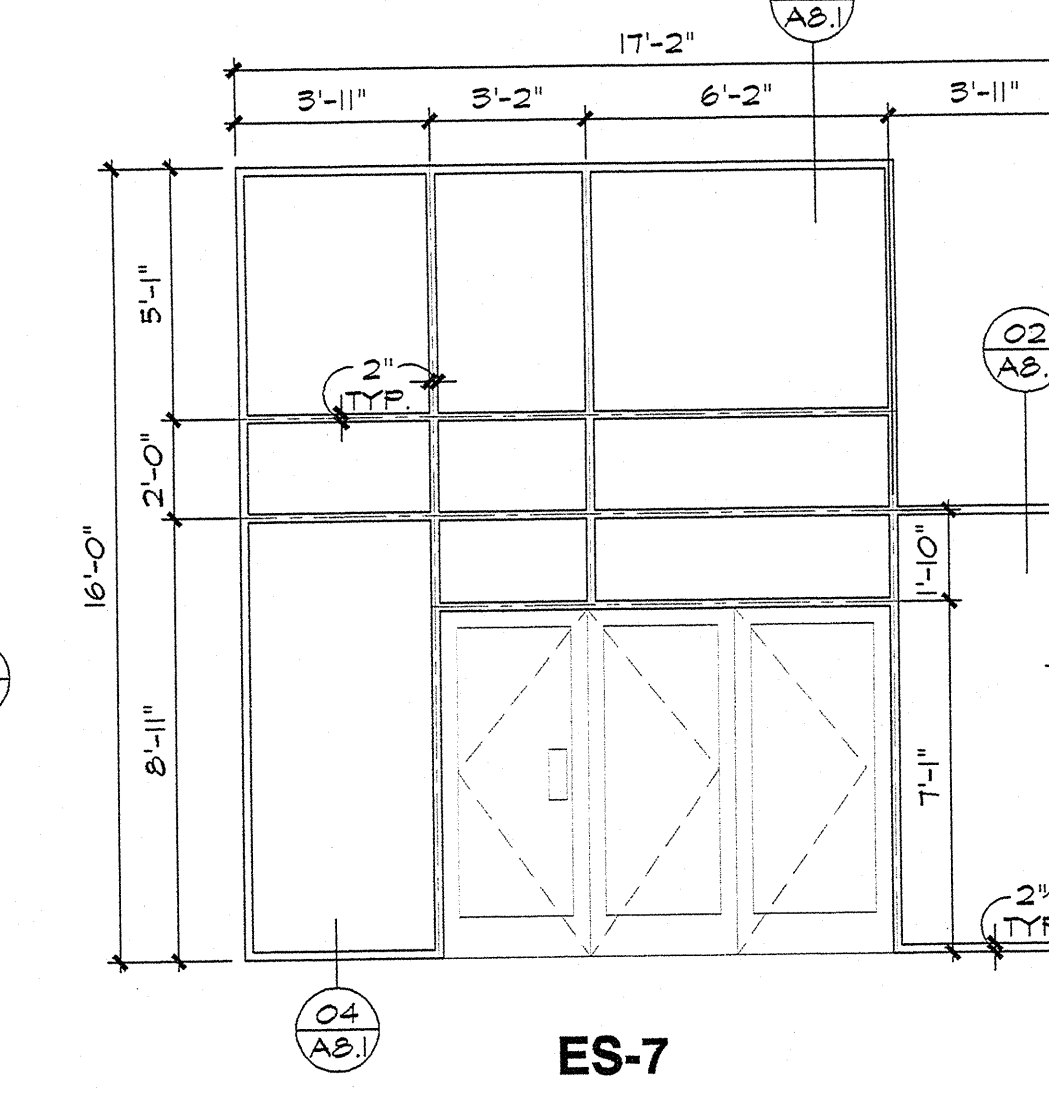


ES-7

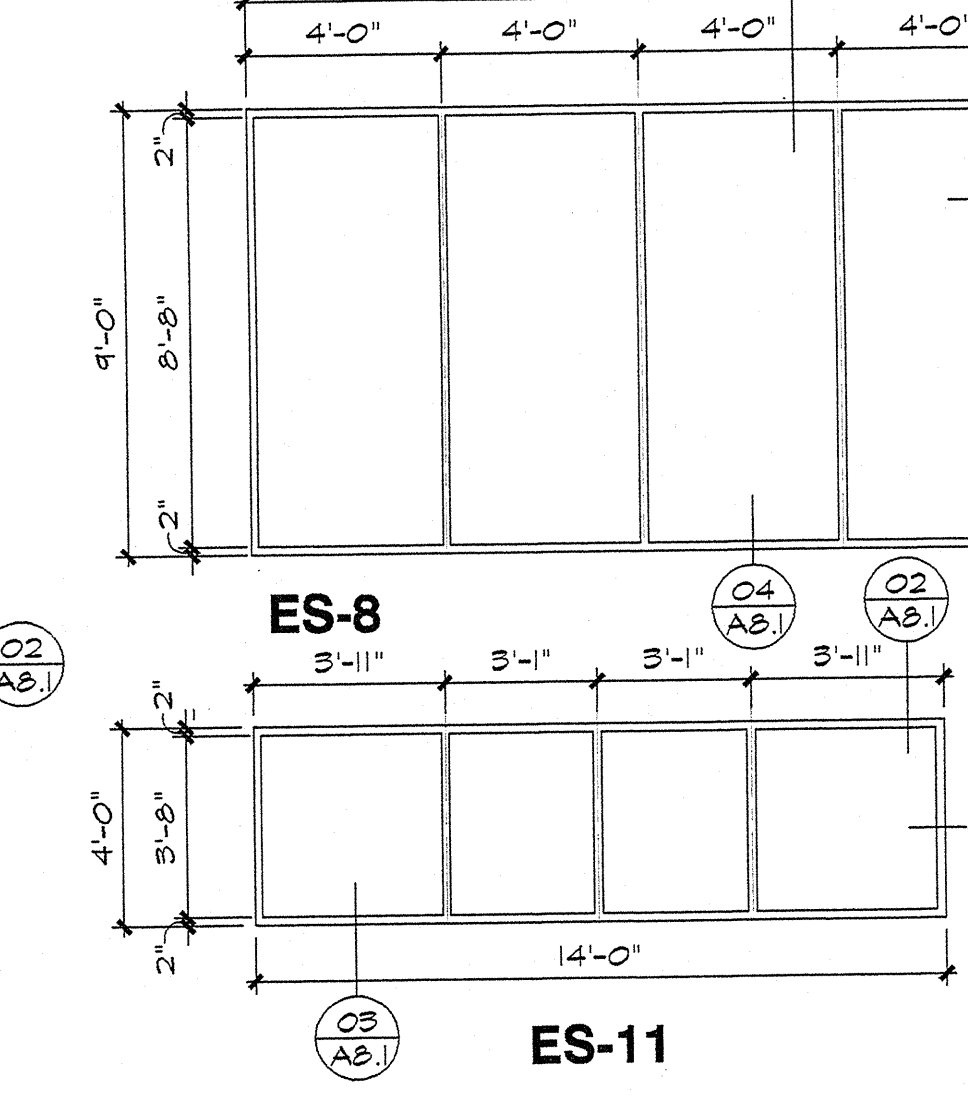

ES-8

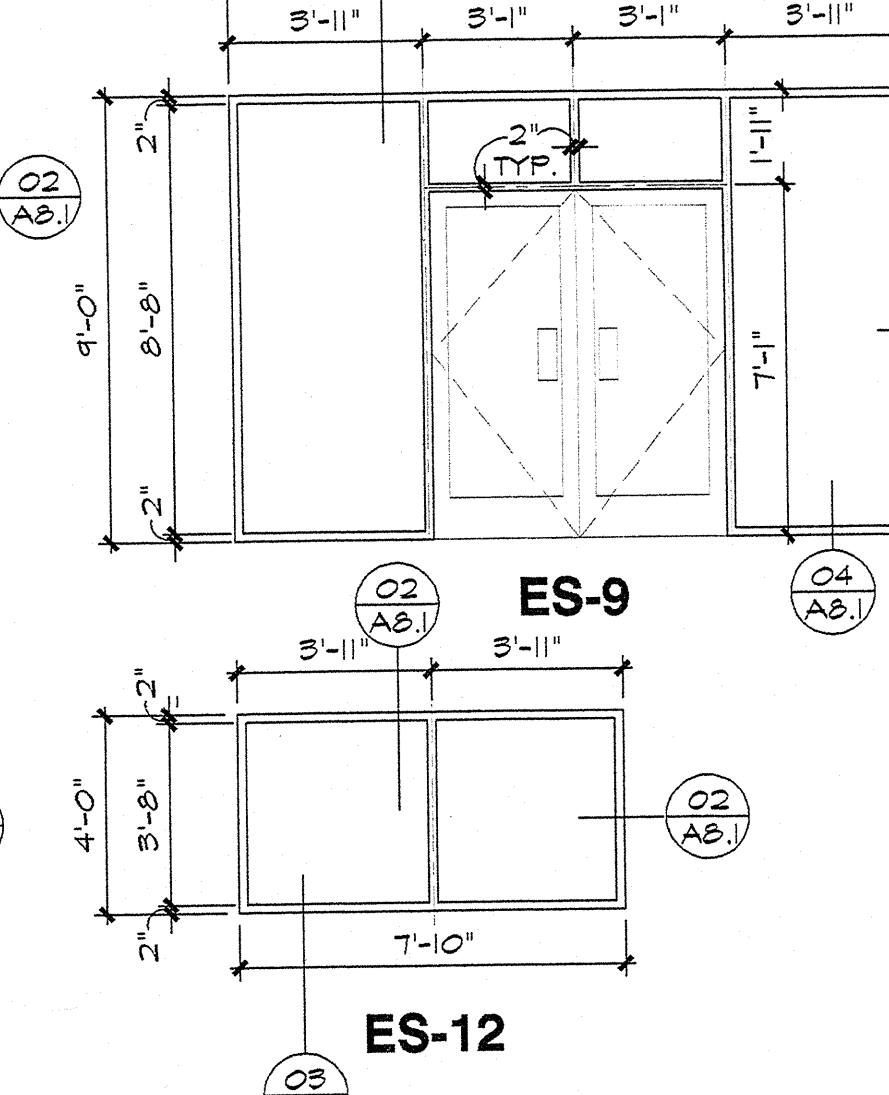

ES-9

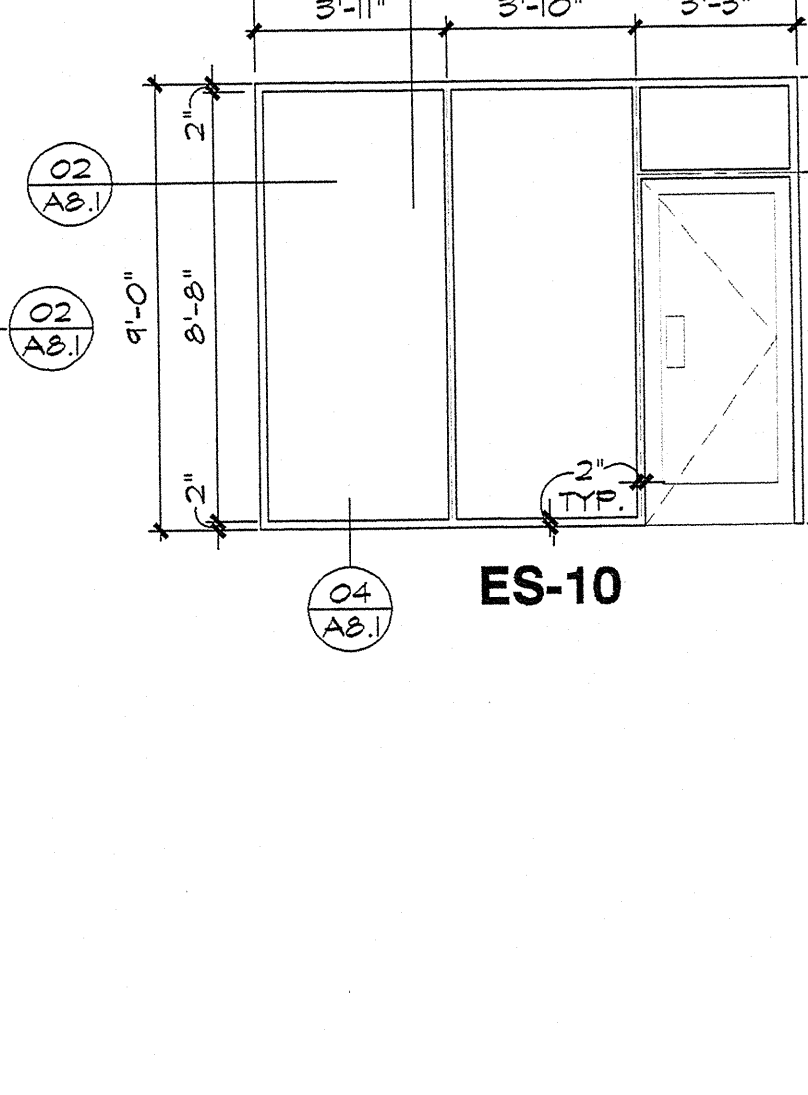


ES-10

NUMBER	SIZE	DOOR TYPE	MATL	THICK	FINISH	RATING	FRAME TYPE	FRAME MATL	FRAME FINISH	JAMB DETAIL	HEAD DETAIL	SILL DETAIL	NOTES
D101	(2)3070	E	ALUMIN	1 3/4"	AS SPECIFIED	N/A	2	ALUMINUM	AS SPECIFIED	22/A8.1	21/A8.1	10/A8.1	-
D102	3070/8070	D	ALUMIN	1 3/4"	AS SPECIFIED	N/A	1	ALUMINUM	AS SPECIFIED	22/A8.1	21/A8.1	10/A8.1	-
D103	(2)3070	E	ALUMIN	1 3/4"	AS SPECIFIED	N/A	2	ALUMINUM	AS SPECIFIED	22/A8.1	21/A8.1	10/A8.1	-
D104	3070/8070	D	ALUMIN	1 3/4"	AS SPECIFIED	N/A	1	ALUMINUM	AS SPECIFIED	22/A8.1	21/A8.1	10/A8.1	-
D105	3070/8070	D	ALUMIN	1 3/4"	AS SPECIFIED	N/A	1	ALUMINUM	AS SPECIFIED	22/A8.1	21/A8.1	10/A8.1	-
D106	3070	J	S.W.	1 3/4"	P-2	N/A	6	ALUMINUM	AS SPECIFIED	28/A8.1	11/A8.1	15/A8.1	-
D107	3070	J	S.W.	1 3/4"	P-2	N/A	7	ALUMINUM	AS SPECIFIED	28/A8.1	11/A8.1	15/A8.1	-
D108	3070	J	S.W.	1 3/4"	P-2	N/A	6	ALUMINUM	AS SPECIFIED	28/A8.1	11/A8.1	15/A8.1	-
D109	3070	J	S.W.	1 3/4"	P-2	N/A	8	ALUMINUM	AS SPECIFIED	28/A8.1	11/A8.1	15/A8.1	-
D110	3070	N/A	STL	1 3/4"	P-2	.75 HR "C" LABEL	N/A	ALUMINUM	AS SPECIFIED	11/A8.1	11/A8.1	15/A8.1	-
D111	3070	J	S.W.	1 3/4"	P-2	N/A	5	ALUMINUM	AS SPECIFIED	11/A8.1	11/A8.1	15/A8.1	-
D112	3070	J	S.W.	1 3/4"	P-2	N/A	5	ALUMINUM	AS SPECIFIED	11/A8.1	11/A8.1	15/A8.1	-
D113	3070	J	S.W.	1 3/4"	P-2	N/A	5	ALUMINUM	AS SPECIFIED	11/A8.1	11/A8.1	15/A8.1	-
D114	3070	J	S.W.	1 3/4"	P-2	N/A	5	ALUMINUM	AS SPECIFIED	11/A8.1	11/A8.1	15/A8.1	-
D115	3070	H	H.M.	1 3/4"	P-2	.75 HR "C" LABEL	9	H.M.	P-2	12/A8.1	12/A8.1	14/A8.1	-
D116	3070	H	H.M.	1 3/4"	P-2	.75 HR "C" LABEL	9	H.M.	P-2	12/A8.1	12/A8.1	14/A8.1	-
D117	3070	H	H.M.	1 3/4"	P-2	.75 HR "C" LABEL	3	ALUMINUM	AS SPECIFIED	22/A8.1	21/A8.1	10/A8.1	-
D118	3070	F	ALUMIN	1 3/4"	AS SPECIFIED	N/A	9	H.M.	P-2	13/A8.1	13/A8.1	14/A8.1	-
D119	3070	H	H.M.	1 3/4"	P-2	N/A	5	ALUMINUM	AS SPECIFIED	11/A8.1	11/A8.1	15/A8.1	-
D120	3070	F	ALUMIN	1 3/4"	AS SPECIFIED	N/A	5	ALUMINUM	AS SPECIFIED	11/A8.1	11/A8.1	15/A8.1	-
D121	3070	J	S.W.	1 3/4"	P-2	N/A	5	ALUMINUM	AS SPECIFIED	11/A8.1	11/A8.1	15/A8.1	-
D122	3070	H	H.M.	1 3/4"	P-2	1.5 HR "B" LABEL	9	H.M.	P-2	13/A8.1	13/A8.1	14/A8.1	-
D123	3070	H	H.M.	1 3/4"	P-2	1.5 HR "B" LABEL	10	H.M.	P-2	13/A8.1	13/A8.1	14/A8.1	-
D124	3070	H	H.M.	1 3/4"	P-2	1.5 HR "B" LABEL	11	H.M.	P-2	13/A8.1	13/A8.1	14/A8.1	-
D125	3070	L	H.M.	1 3/4"	P-2	1.5 HR "B" LABEL	12	H.M.	P-2	11/A8.1	11/A8.1	15/A8.1	-
D126	3070	K	H.M.	1 3/4"	P-2	N/A	9	H.M.	P-2	13/A8.1	13/A8.1	14/A8.1	-
D127	3070	J	S.W.	1 3/4"	P-2	1.5 HR "B" LABEL	9	H.M.	P-2	13/A8.1	13/A8.1	14/A8.1	-
D128	3070	J	S.W.	1 3/4"	AS SPECIFIED	N/A	5	ALUMINUM	AS SPECIFIED	11/A8.1	11/A8.1	15/A8.1	-
D129	3070	H	H.M.	1 3/4"	AS SPECIFIED	N/A	9	H.M.	P-2	11/A8.1	11/A8.1	14/A8.1	-
D130	3070	G	H.M.	1 3/4"	P-2	N/A	10	N/A	N/A	24/A8.1	24/A8.1	18/A8.1	-
D131	8'X10'	C	STL	1 3/4"	P-2	N/A	9	H.M.	P-2	07/A8.1	07/A8.1	09/A8.1	-
D132	3070	H	H.M.	1 3/4"	P-2	N/A	9	H.M.	P-2	16/A8.1	16/A8.1	18/A8.1	-
D133	18'X12'	A	STL	1 3/4"	P-2	N/A	9	H.M.	P-2	06/A8.1	06/A8.1	09/A8.1	-
D134	3070	H	H.M.	1 3/4"	P-2	N/A	9	H.M.	P-2	09/A8.1	09/A8.1	14/A8.1	-
D135	3070	H	H.M.	1 3/4"	P-2	N/A	9	H.M.	P-2	17/A8.1	17/A8.1	18/A8.1	-
D136	10'X10'	B	STL	1 3/4"	P-2	N/A	N/A	N/A	P-2	17/A8.1	17/A8.1	18/A8.1	-
D137	10'X10'	B	STL	1 3/4"	P-2	N/A	N/A	N/A	P-2	17/A8.1	17/A8.1	18/A8.1	-
D138	10'X10'	B	STL	1 3/4"	P-2	N/A	N/A	N/A	P-2	17/A8.1	17/A8.1	18/A8.1	-
D139	10'X10'	B	STL	1 3/4"	P-2	N/A	N/A	N/A	P-2	16/A8.1	16/A8.1	18/A8.1	-
D140	18'X12'	A	STL	1 3/4"	P-2	N/A	N/A	N/A	P-2	08/A8.1	08/A8.1	09/A8.1	-
D141	3070	H	H.M.	1 3/4"	P-2	N/A	9	H.M.	P-2	13/A8.1	13/A8.1	14/A8.1	-

DOOR SCHEDULE - SECOND FLOOR


NUMBER	SIZE	DOOR TYPE	MATL	THICK	FINISH	RATING	FRAME TYPE	FRAME MATL	FRAME FINISH	JAMB DETAIL	HEAD DETAIL	SILL DETAIL	NOTES
D201	3070	J	H.M.	1 3/4"	P-2	N/A	3	ALUMINUM	AS SPECIFIED	11/A8.1	11/A8.1	15/A8.1	-
D202	3070	N/A	STL	1 3/4"	P-2	.75 HR "C" LABEL	N/A	N/A	AS SPECIFIED	N/A	N/A	N/A	-
D203	3070	J	S.W.	1 3/4"	P-2	N/A	4	ALUMINUM	AS SPECIFIED	11/A8.1	11/A8.1	15/A8.1	-
D204	3070	J	S.W.	1 3/4"	P-2	N/A	3	ALUMINUM	AS SPECIFIED	02/A8.1	01/A8.1	03/A8.1	-
D205	3070	J	S.W.	1 3/4"	P-2	N/A	3	ALUMINUM	AS SPECIFIED	11/A8.1	11/A8.1	15/A8.1	-
D206	3070	J	S.W.	1 3/4"	P-2	N/A	3	ALUMINUM	AS SPECIFIED	11/A8.1	11/A8.1	15/A8.1	-
D207	3070	J	S.W.	1 3/4"	P-2	N/A	3	ALUMINUM	AS SPECIFIED	11/A8.1	11/A8.1	15/A8.1	-
D208	3070	H	H.M.	1 3/4"	P-2	.75 HR "C" LABEL	9	H.M.	P-2	12/A8.1	12/A8.1	14/A8.1	-
D209	3070	H	H.M.	1 3/4"	P-2	.75 HR "C" LABEL	9	H.M.	P-2	12/A8.1	12/A8.1	14/A8.1	-
D210	3070	G	H.M.	1 3/4"	P-2	1.5 HR "B" LABEL	9	H.M.	P-2	13/A8.1	13/A8.1	14/A8.1	-

KEY
 H.M. --- HOLLOW METAL
 S.W. --- SOLID WOOD
 G.L. --- GLASS
 STL. --- STEEL
 ALUMIN. --- ALUMINUM
 G.M. --- GALVANIZED METAL

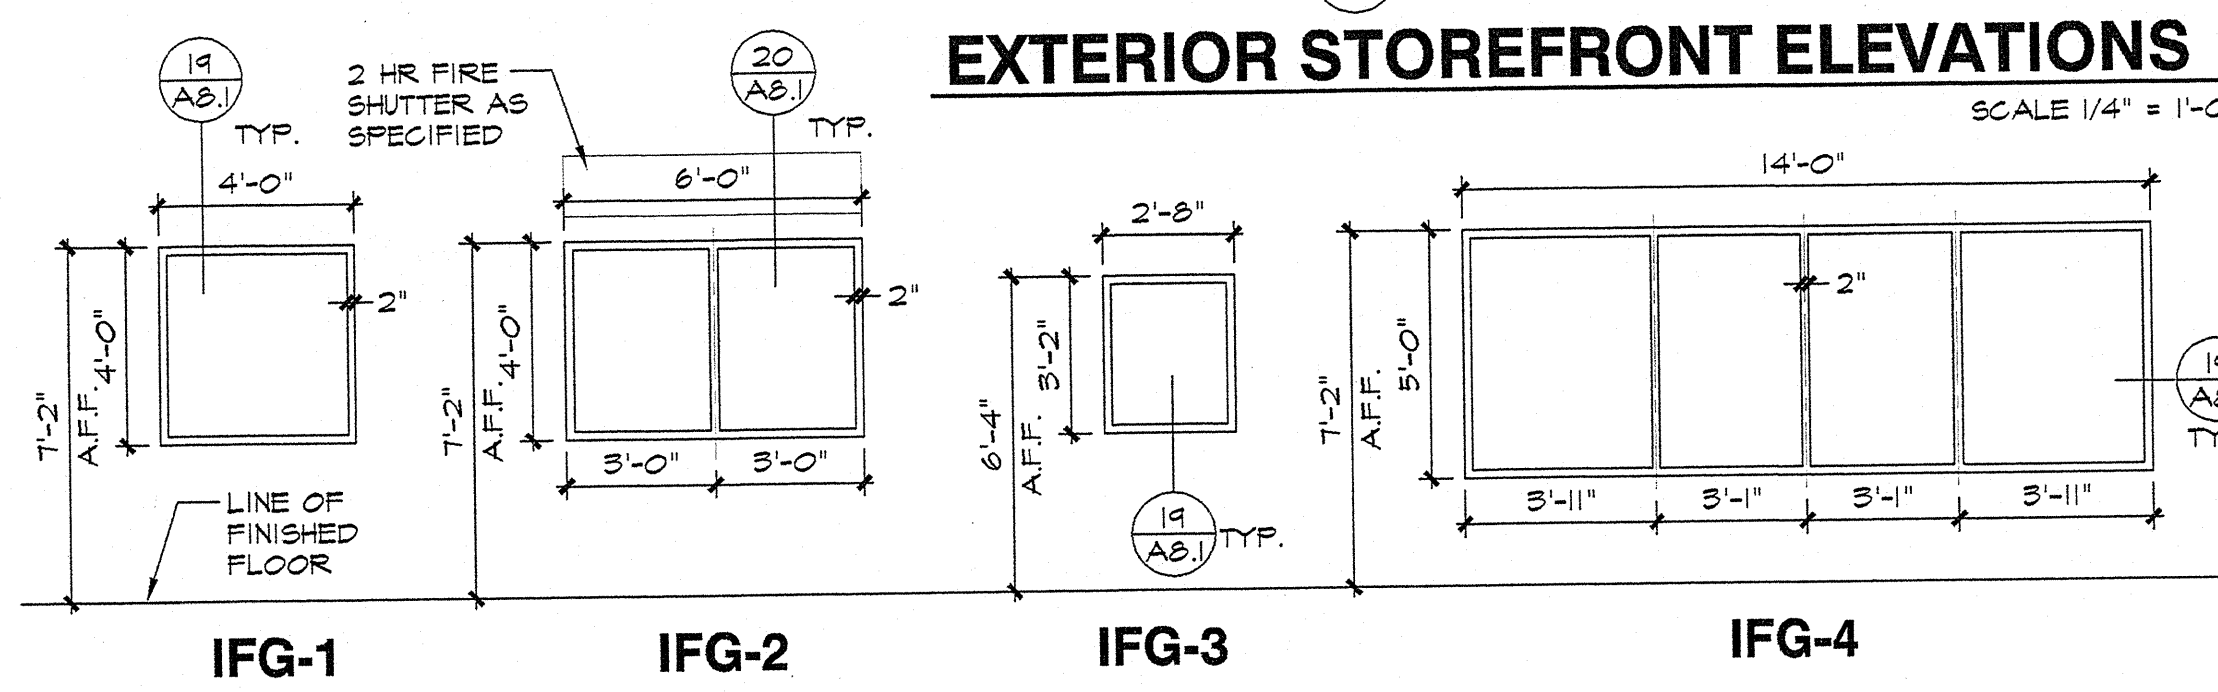


IFG-1

INTERIOR FIXED GLASS
 ANODIZED ALUMINUM FRAMES SCALE 1/4" = 1'-0"

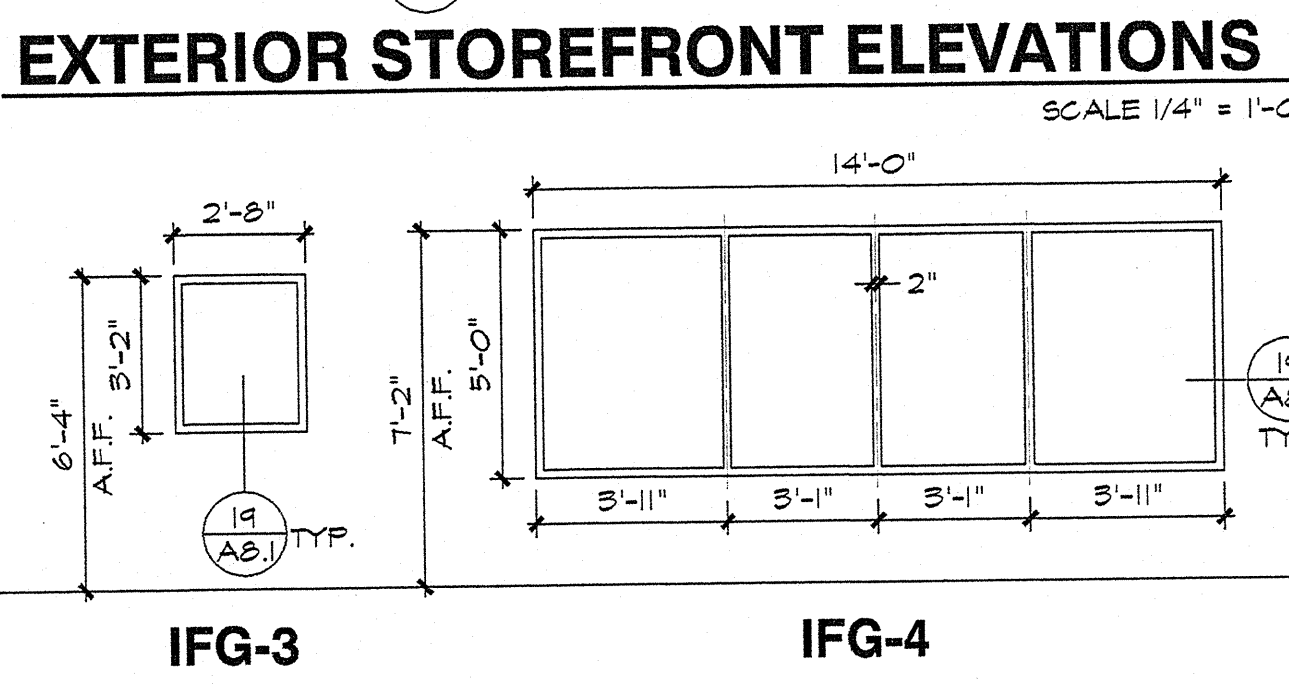


IFG-2


NOTE:
 PROVIDE TYPED GLASS AS REQUIRED BY
 SAFETY GLASS CODES TO ALL WINDOWS AND
 DOORS CONTAINING GLASS.

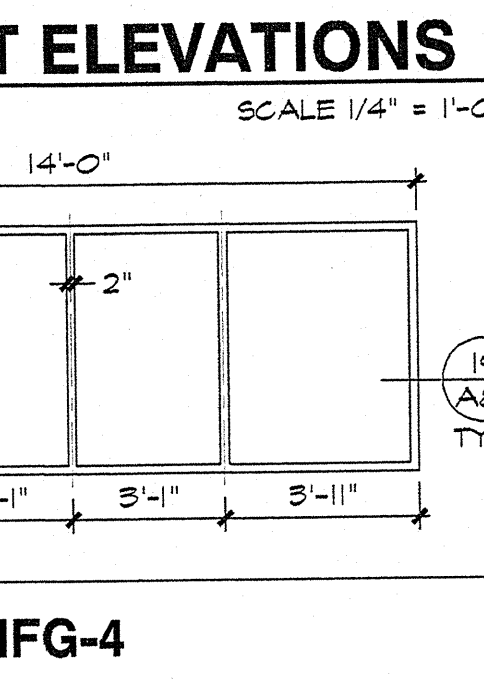


IFG-3

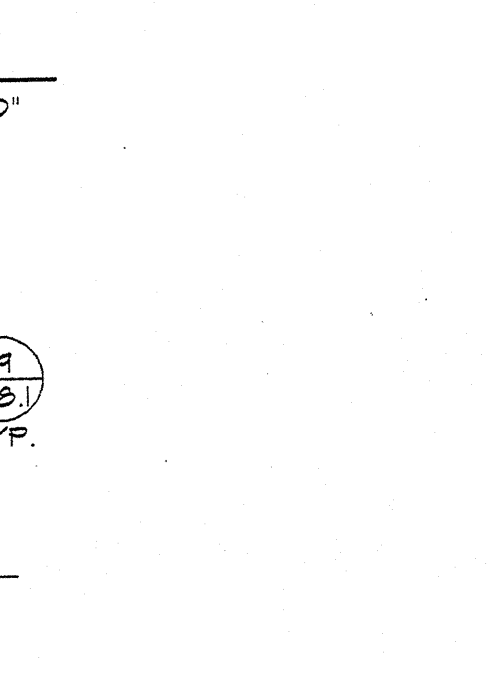


IFG-4

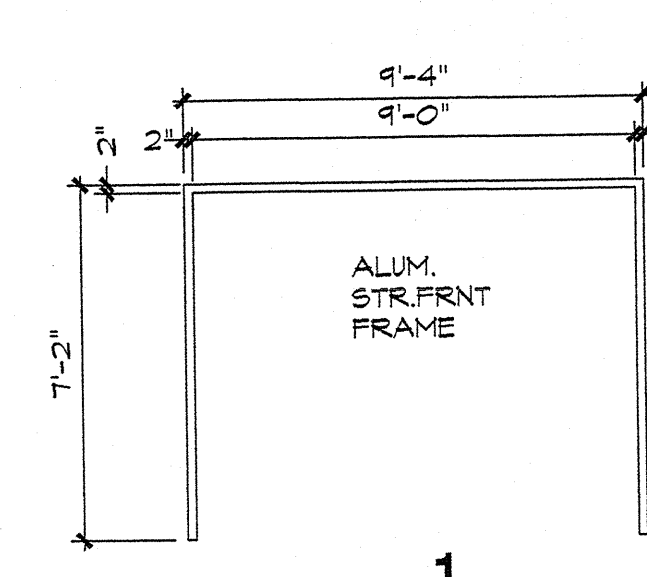


1

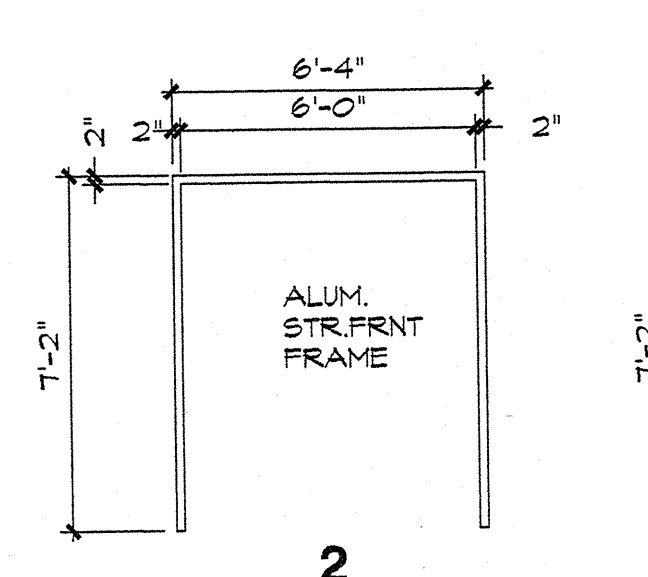


2

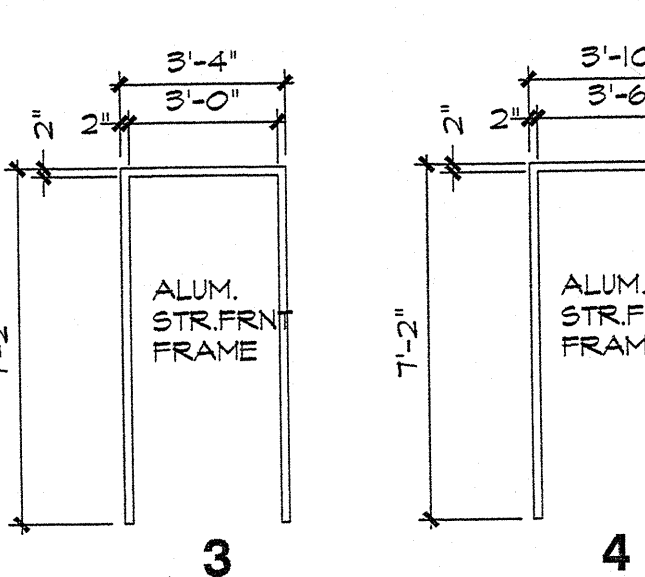


3

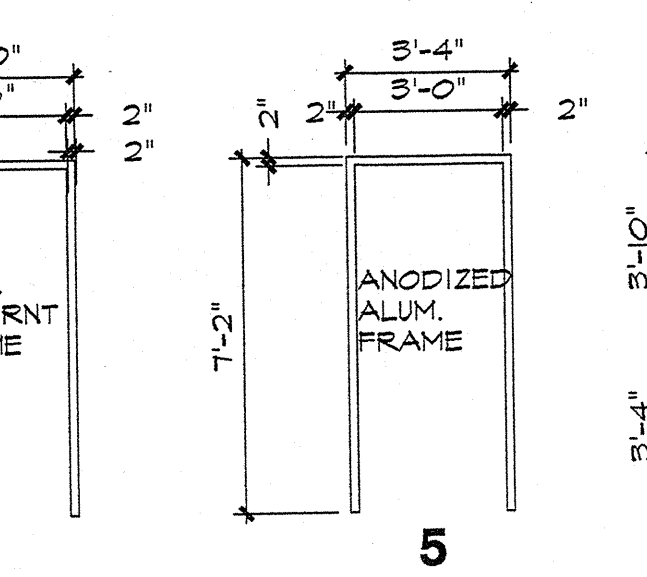


4

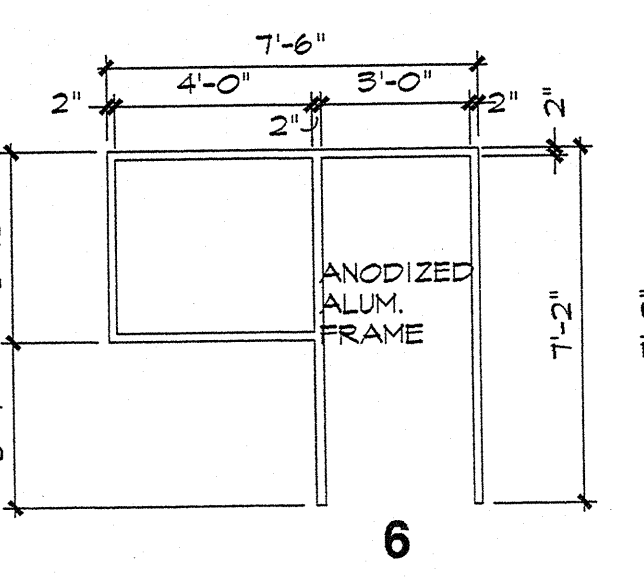


5

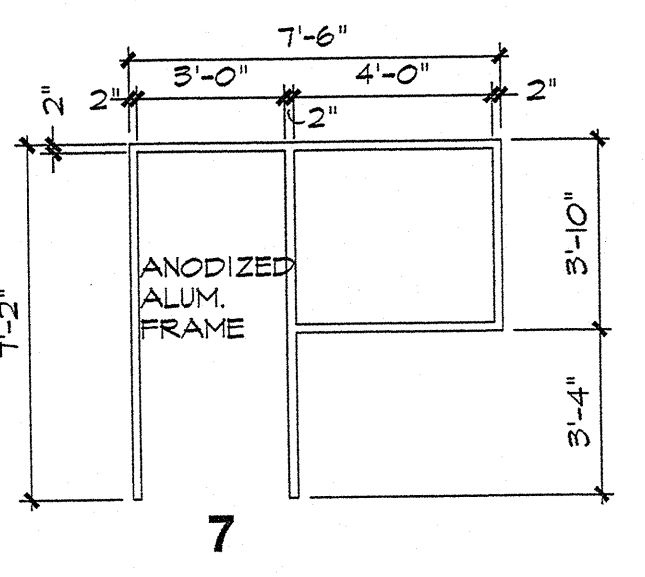


6

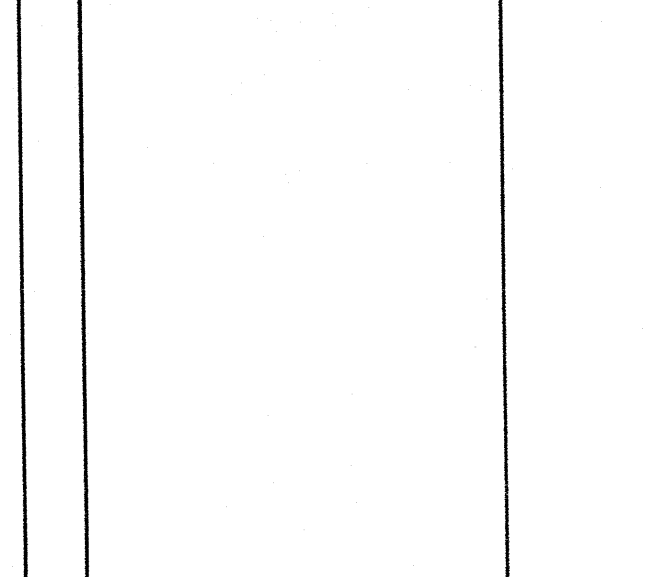


7

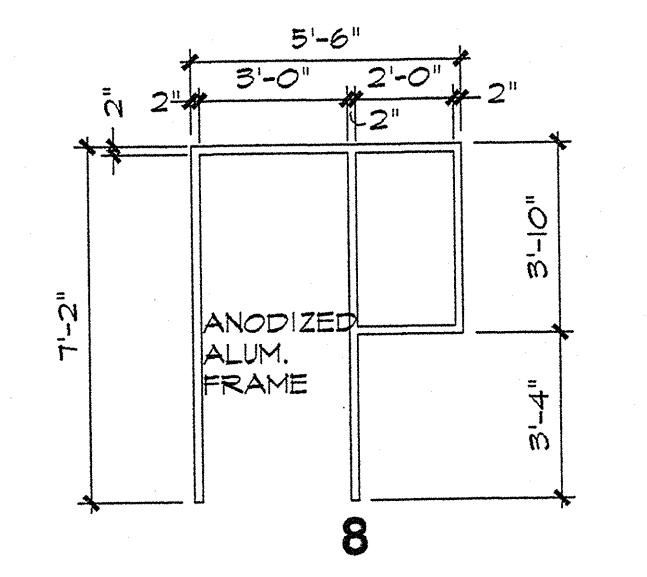


8

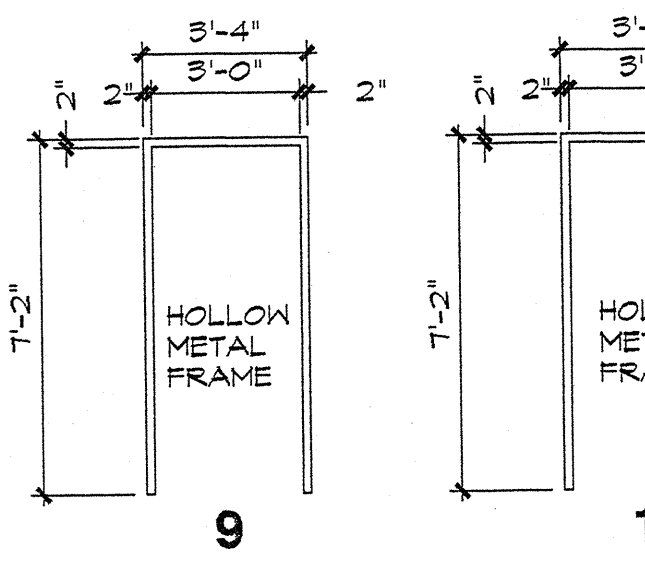

9

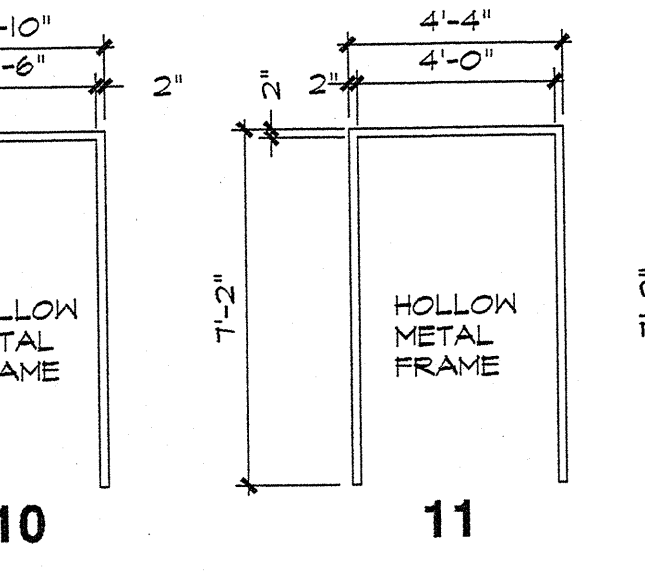

10

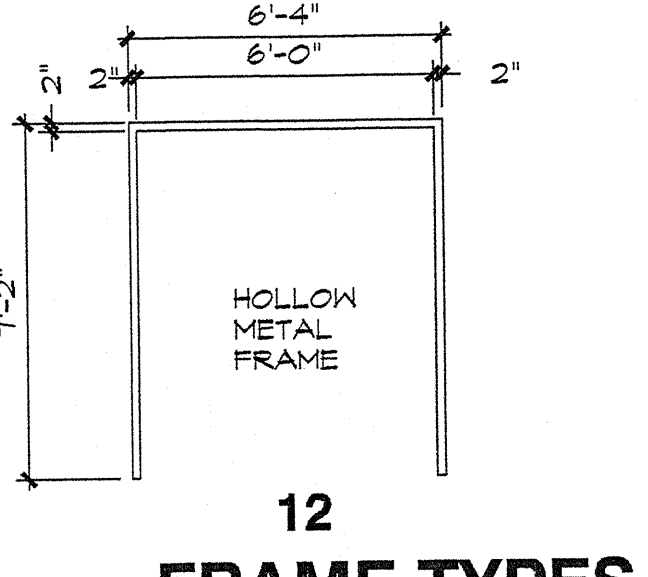


11




12


FRAME TYPES
 SCALE 1/4" = 1'-0"

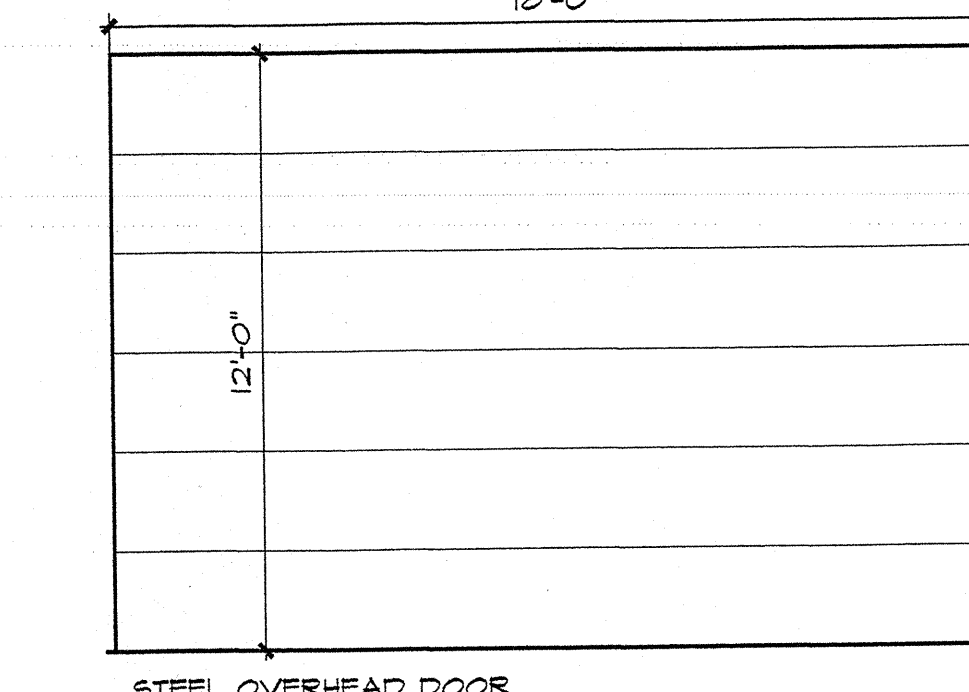


A

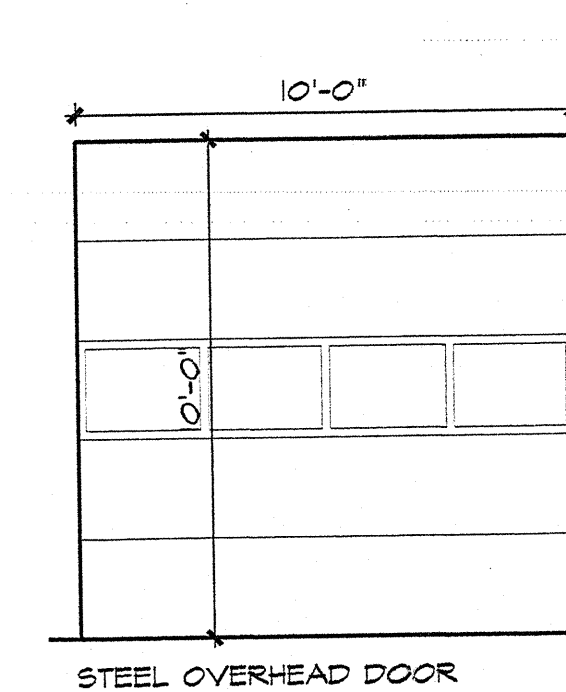


B

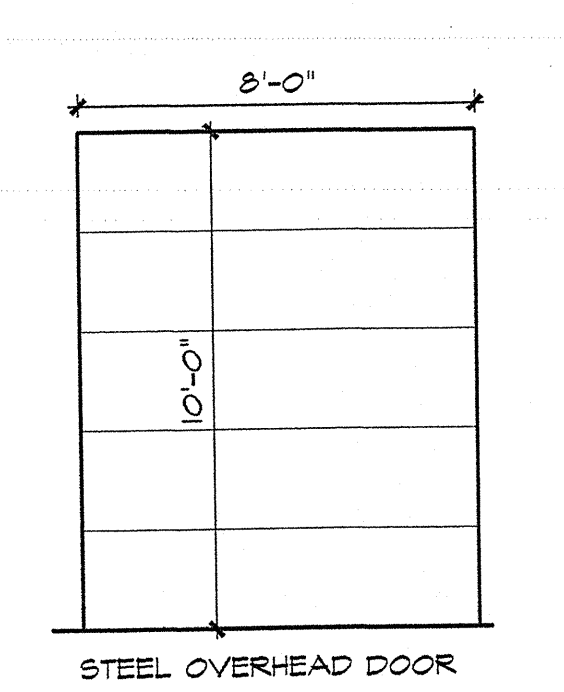


C

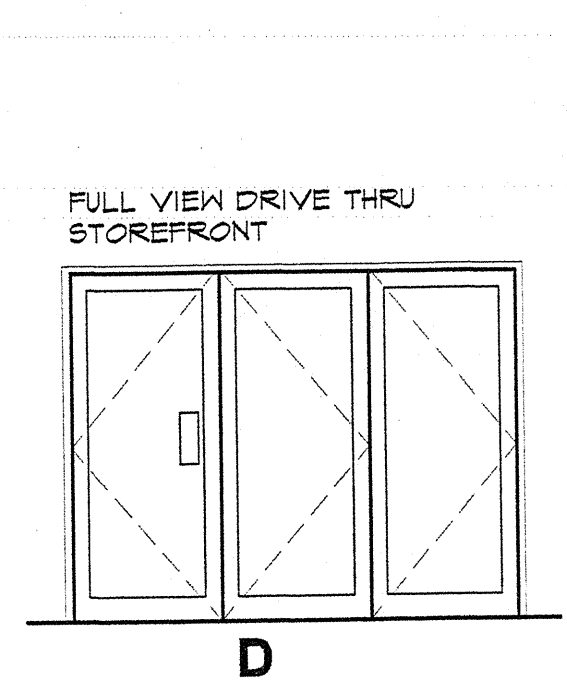


D

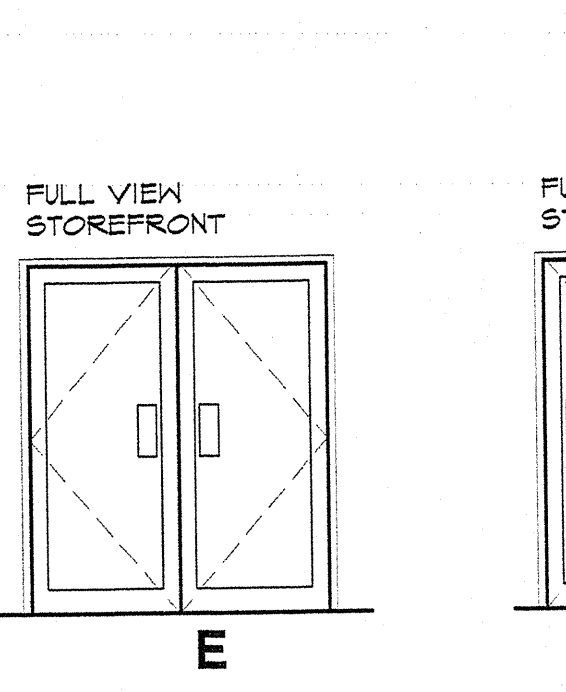


E

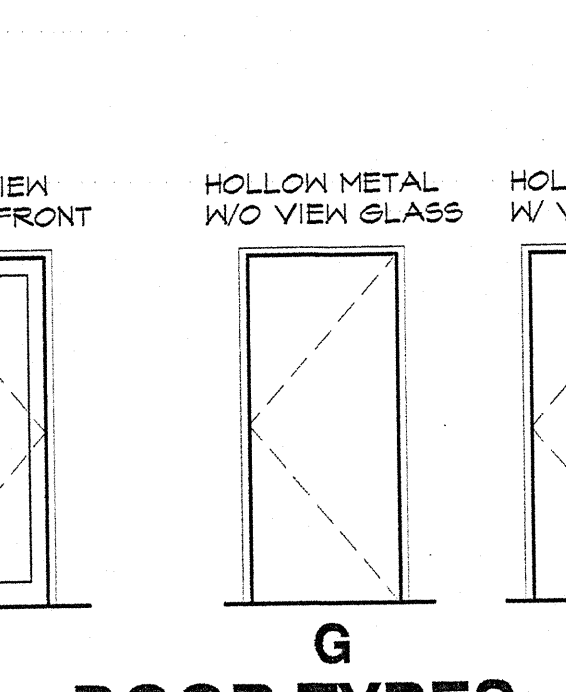


F

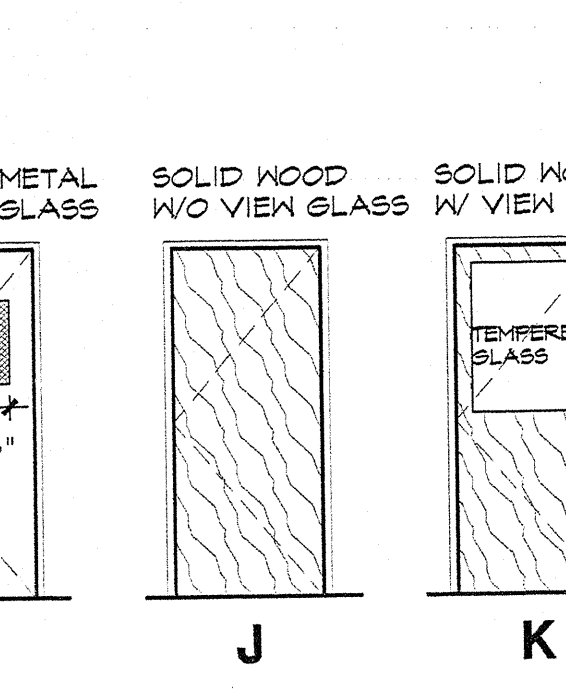


G

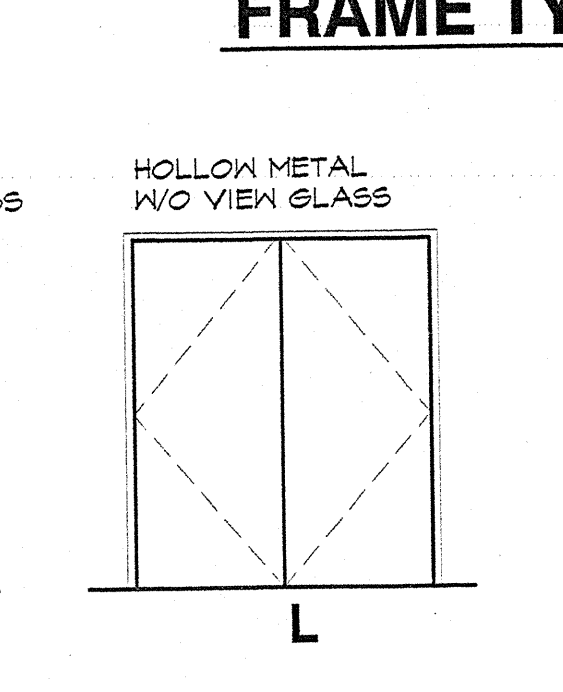


H

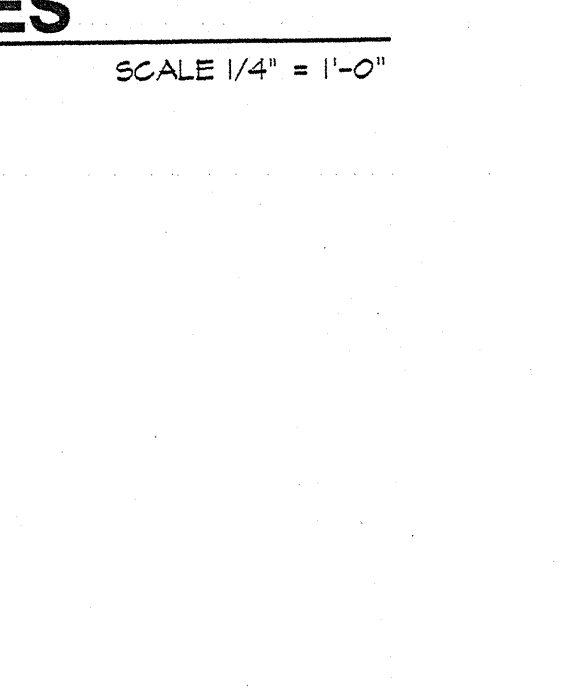

J

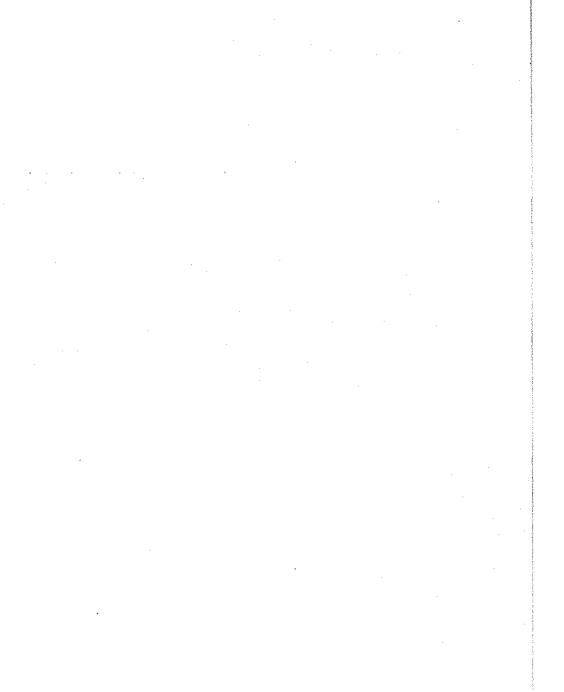

K

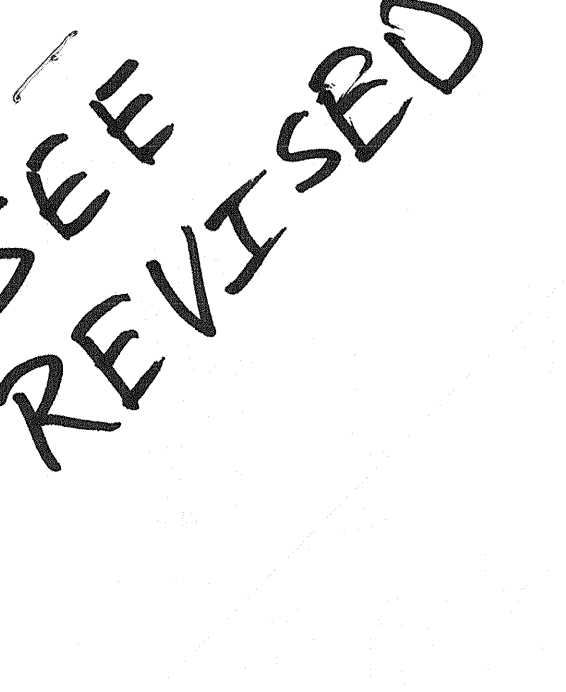

L


DOOR TYPES
 SCALE 1/4" = 1'-0"

AN AUTOMOTIVE DEALERSHIP
ROGER BEASLEY VOLVO


INTERSTATE HIGHWAY 35 SOUTH
 GEORGETOWN, TEXAS

ELASSER ARCHITECTURAL INC.
 ARCHITECTURE AND PLANNING
 P.O. BOX 533 GEORGETOWN, TX 78627
 (512) 530-5333 FAX (512) 530-3318 WWW.EBHA.COM


CONSULTANT INFORMATION:

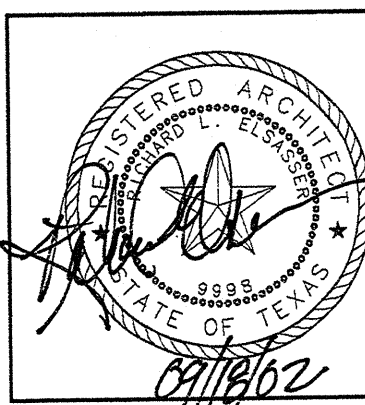


SEE
 REVISED

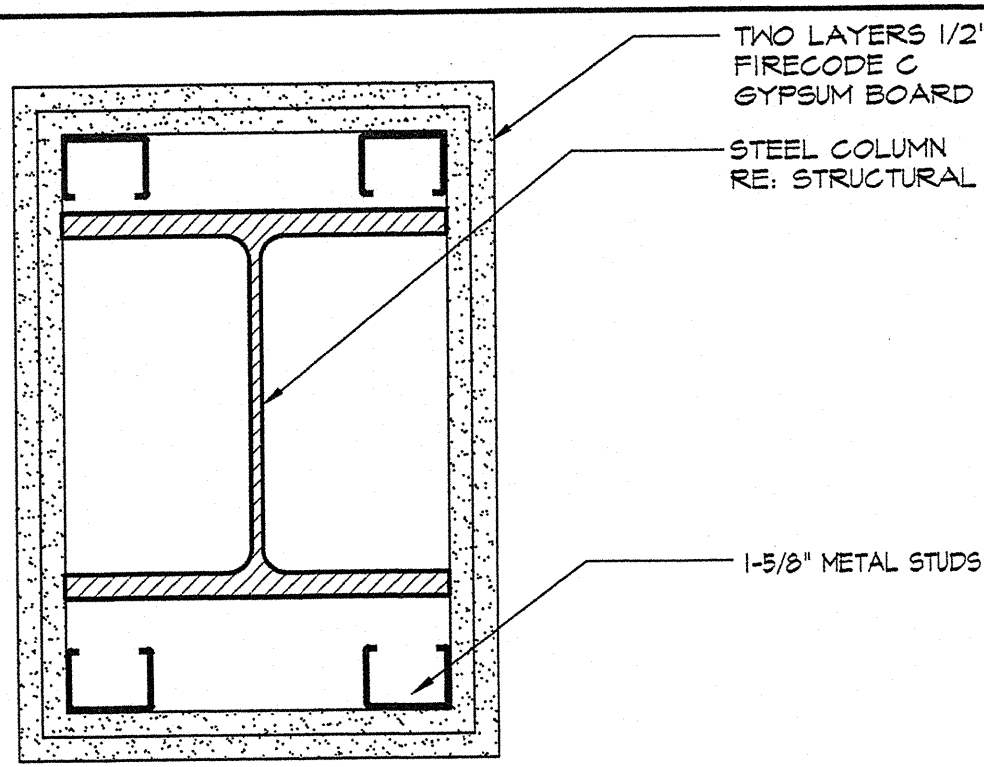


17 SURROUND @ 1 HR. RATED COLUMN
SCALE: 3" = 1'-0"

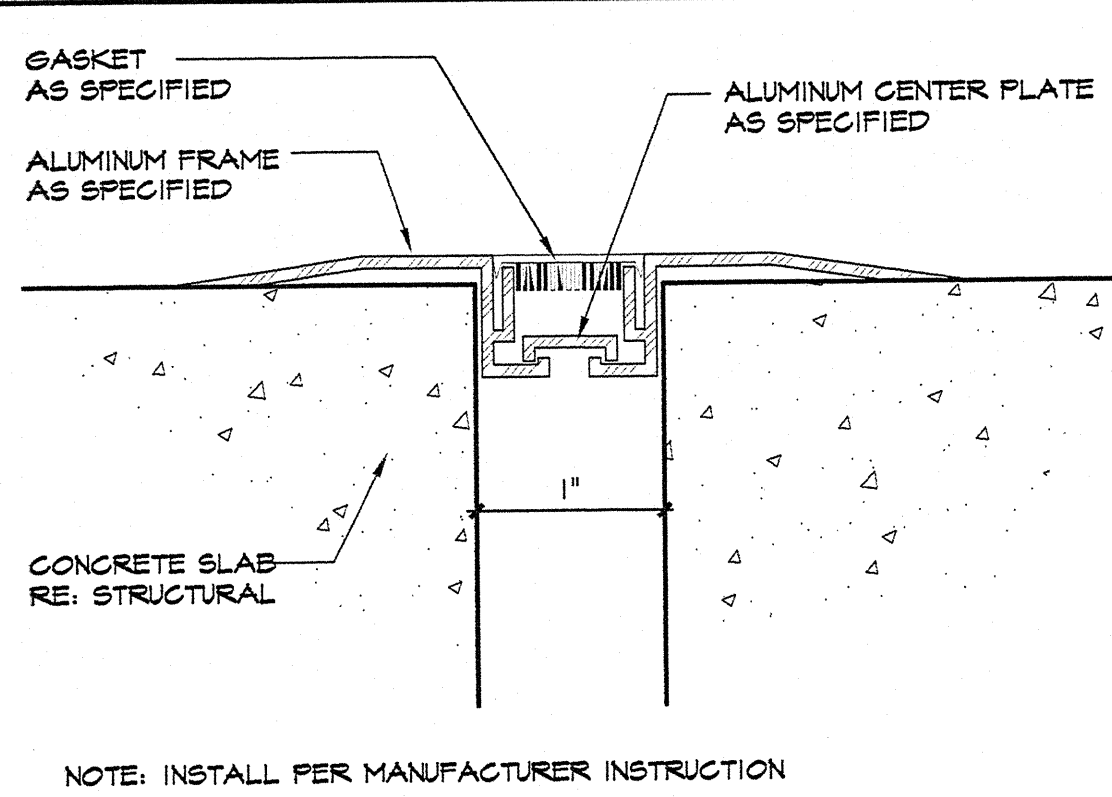


13 EXPANSION JOINT COVER
SCALE: N.T.S.

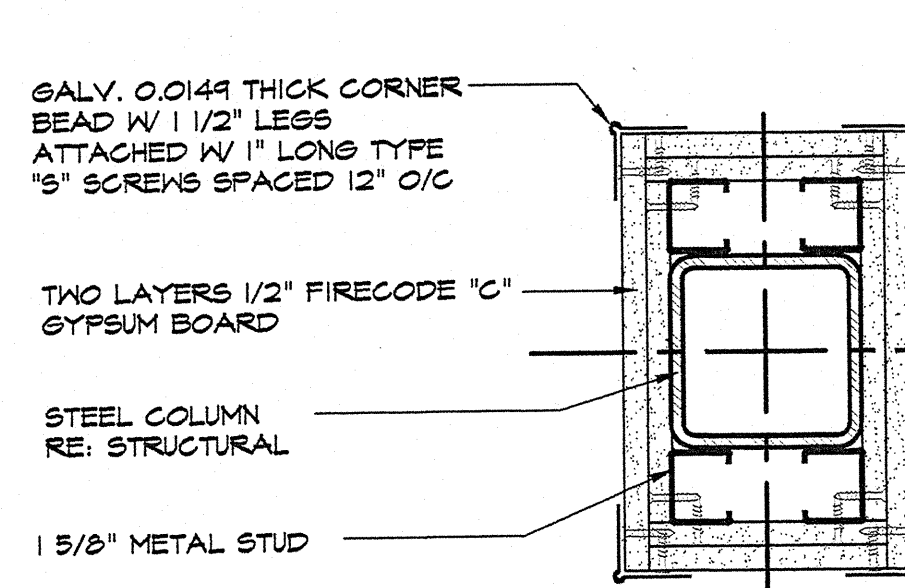


09 STRUCTURAL FIRE PROOFING
SCALE: 3" = 1'-0"

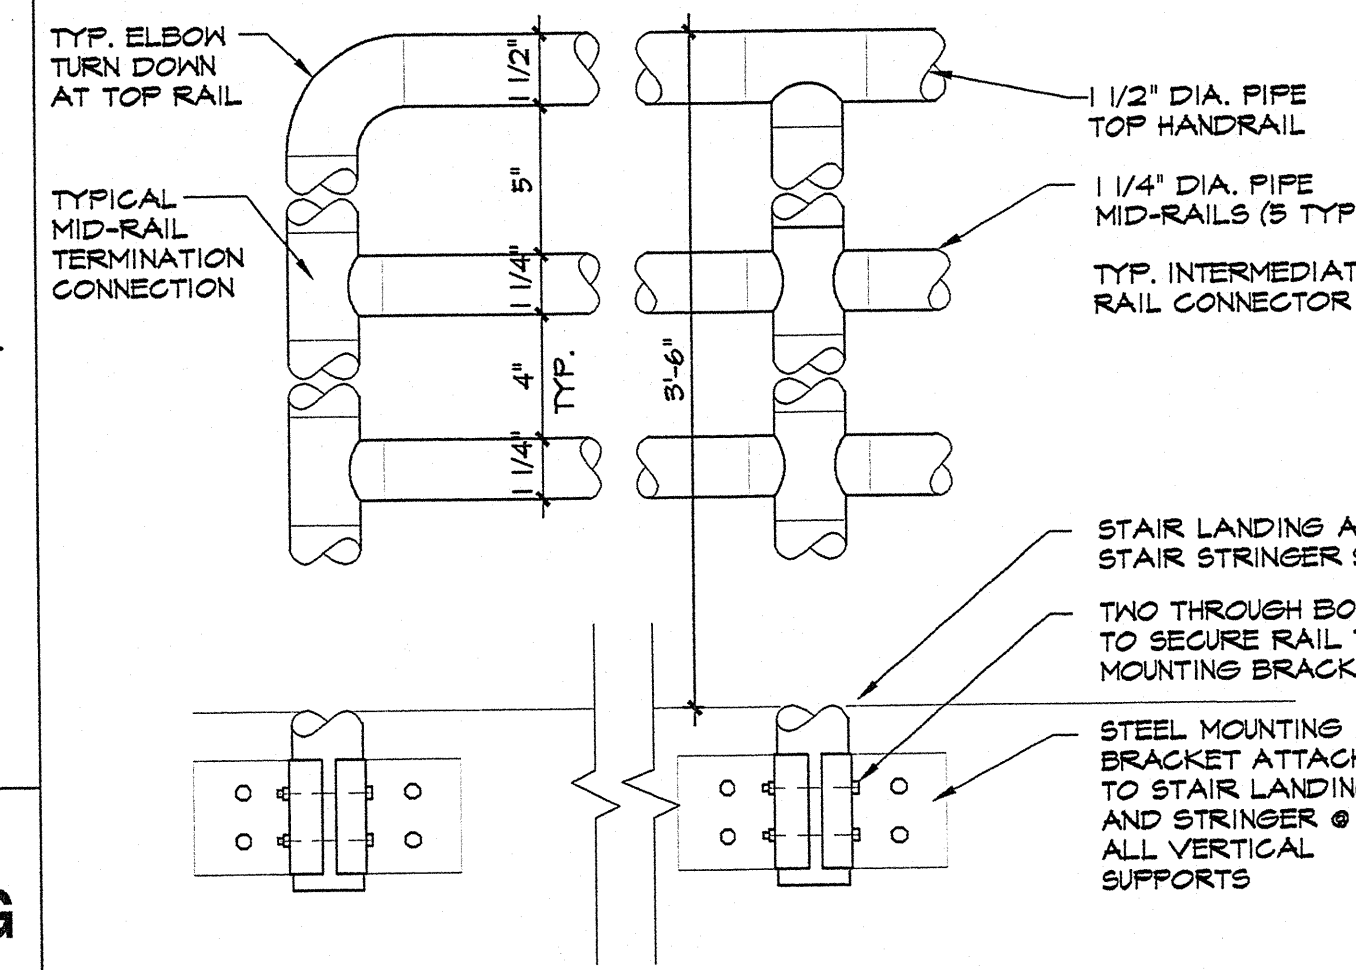


05 STAIR RAIL DETAIL
SCALE: 3" = 1'-0"

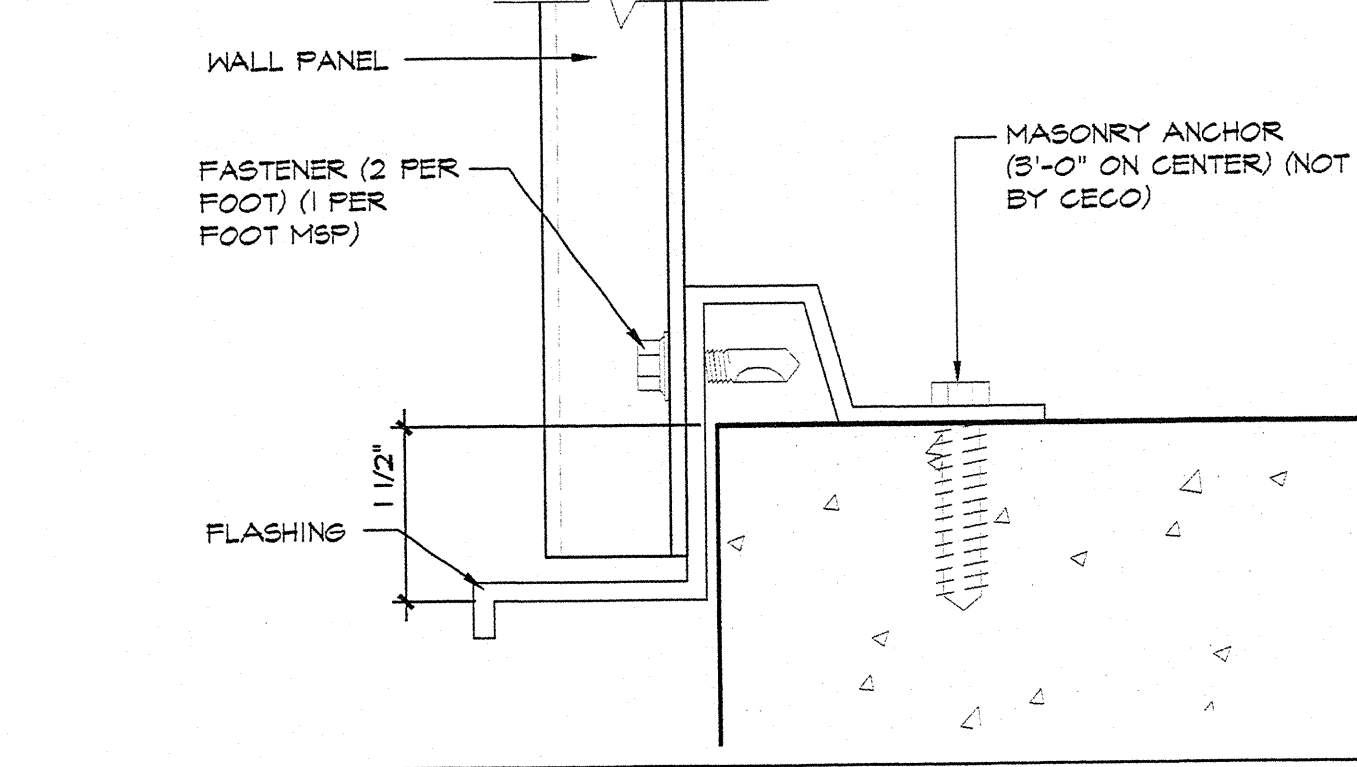


01 METAL PANEL BASE DETAIL
SCALE: N.T.S.

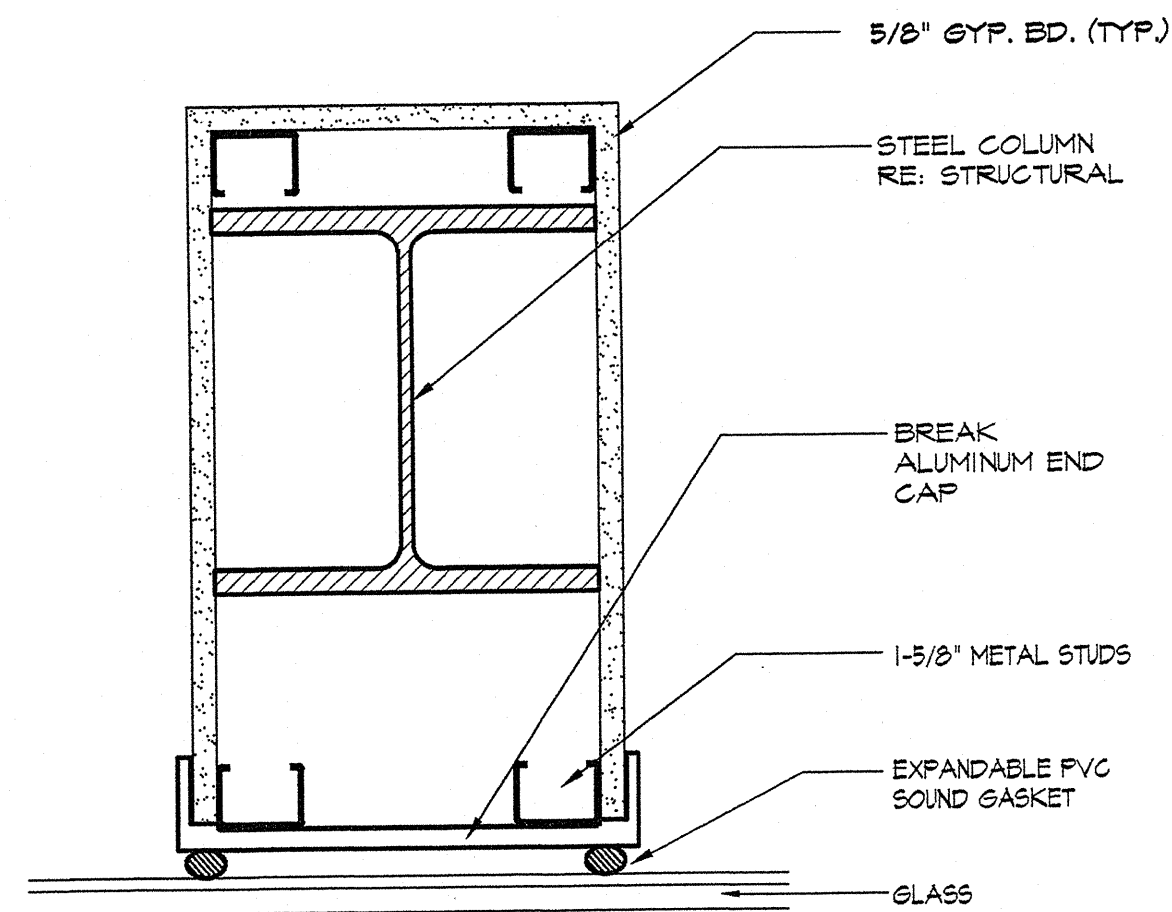


18 SURROUND @ COLUMN
SCALE: 3" = 1'-0"

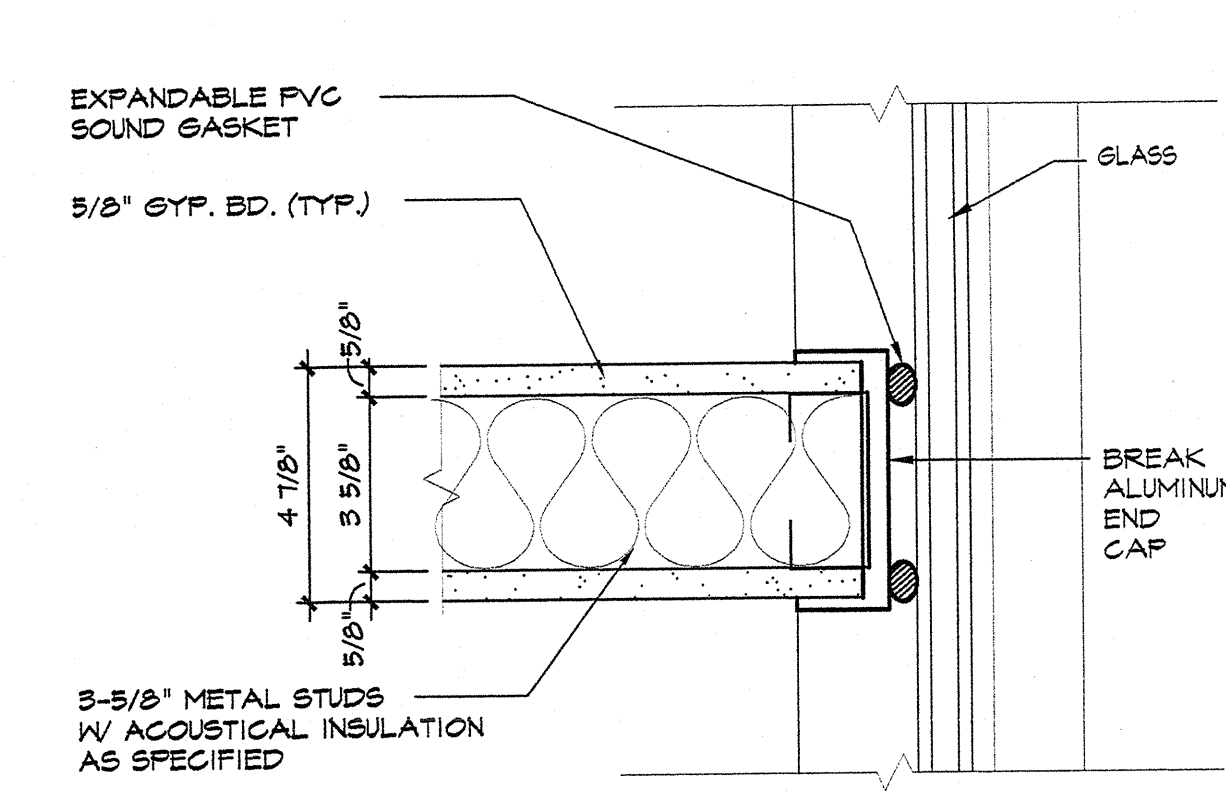


14 GYP. BD. PARTITION @ GLASS
SCALE: 3" = 1'-0"

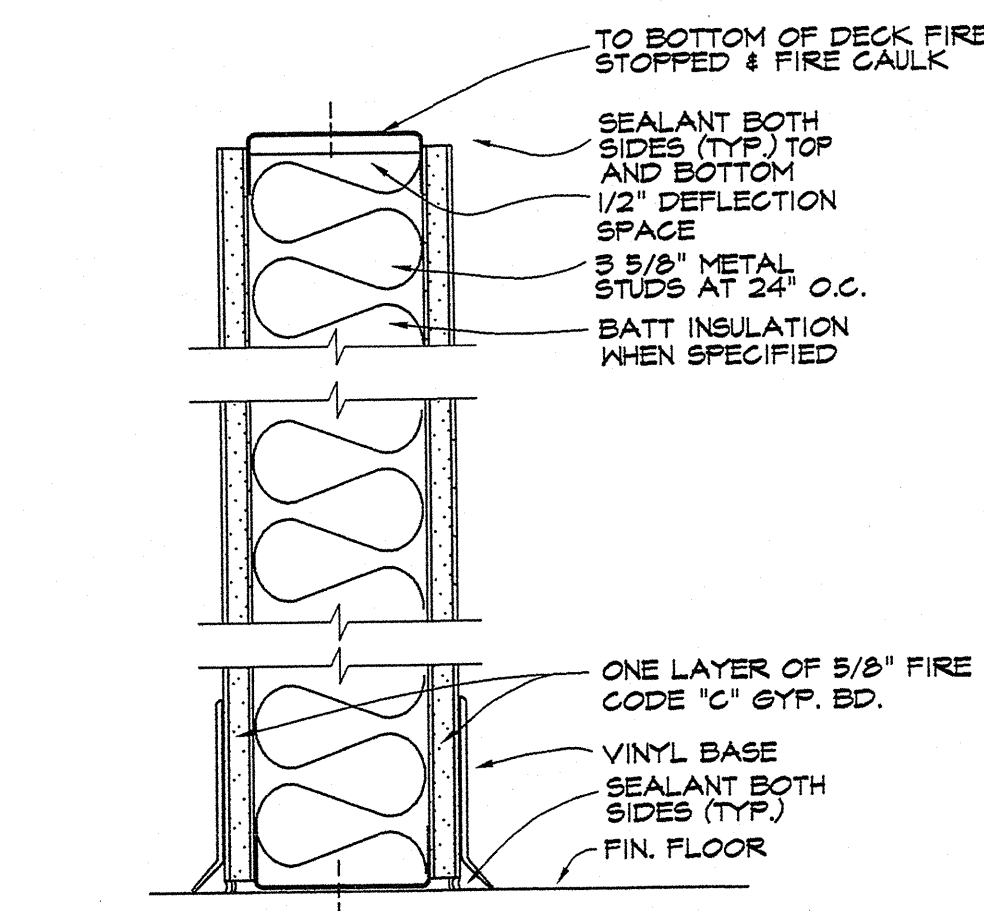


10 1 HOUR PARTITION
SCALE: 3" = 1'-0"

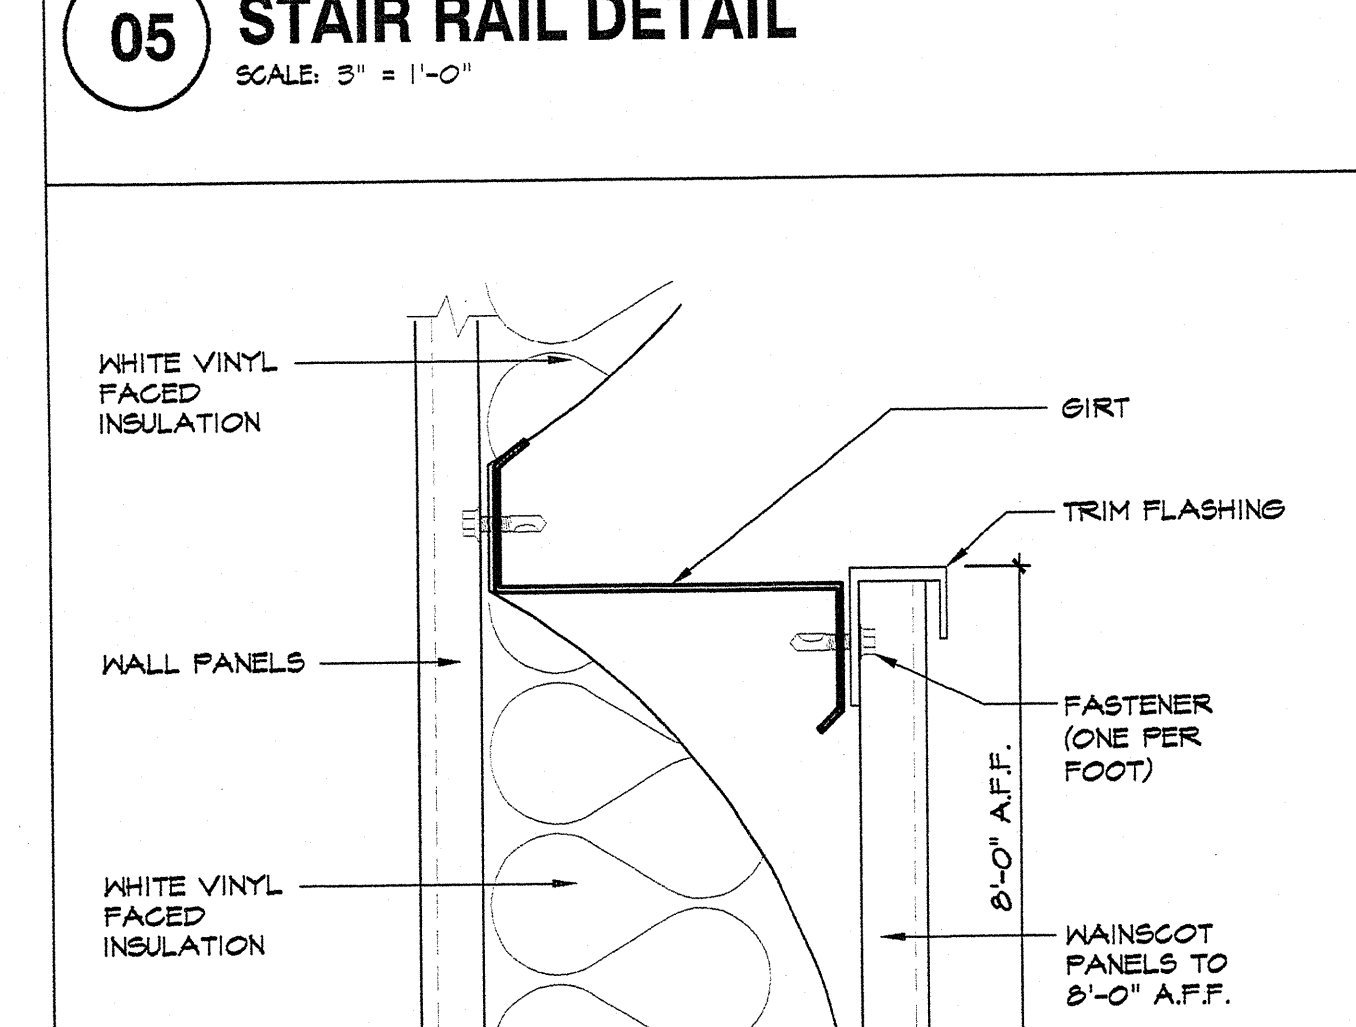


06 WAINSCOT @ SERVICE DEPT.
SCALE: N.T.S.

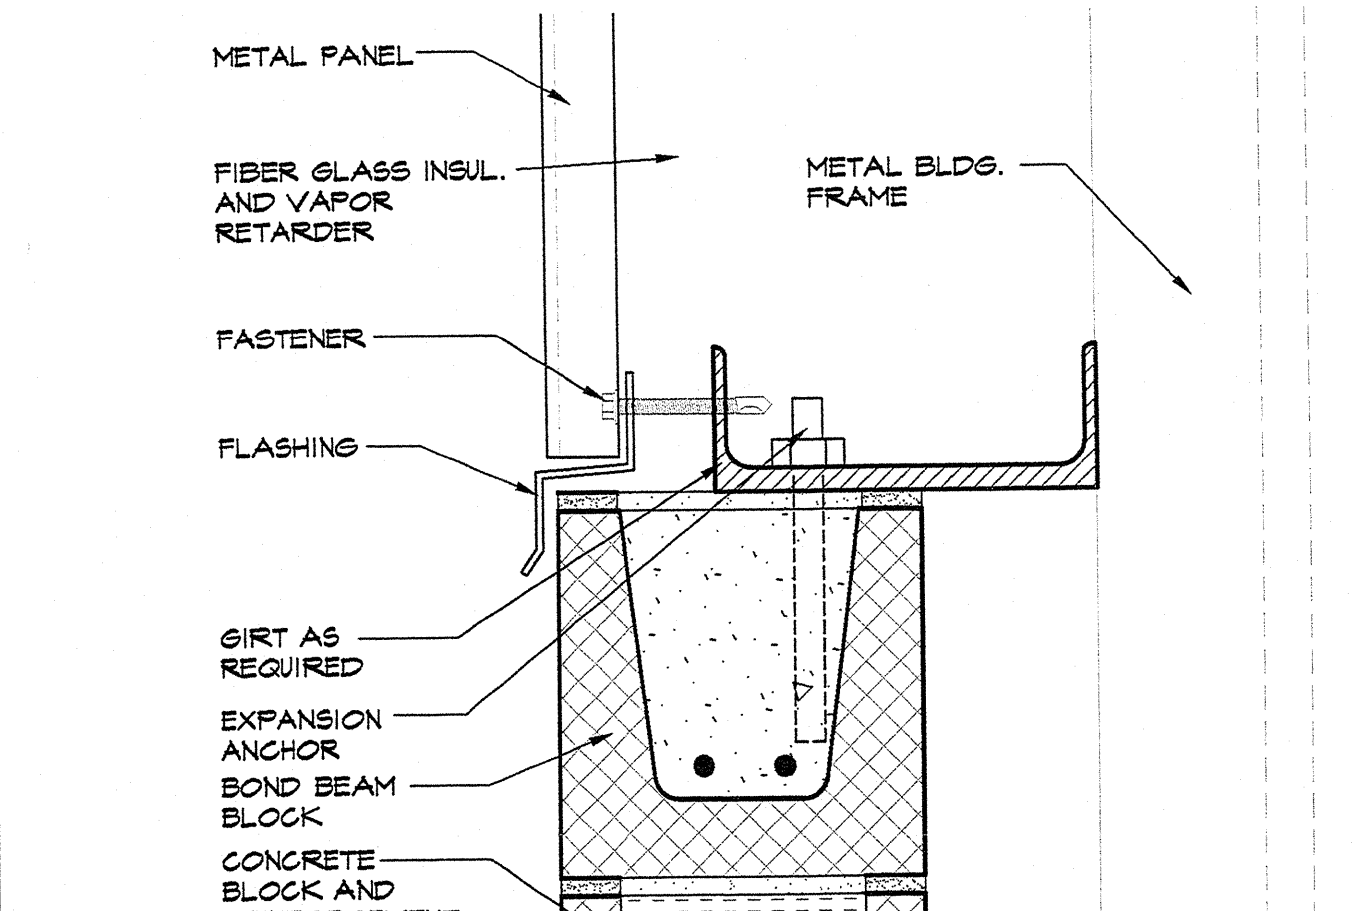


02 CMU/ METAL PANEL TRANS.
SCALE: 3" = 1'-0"

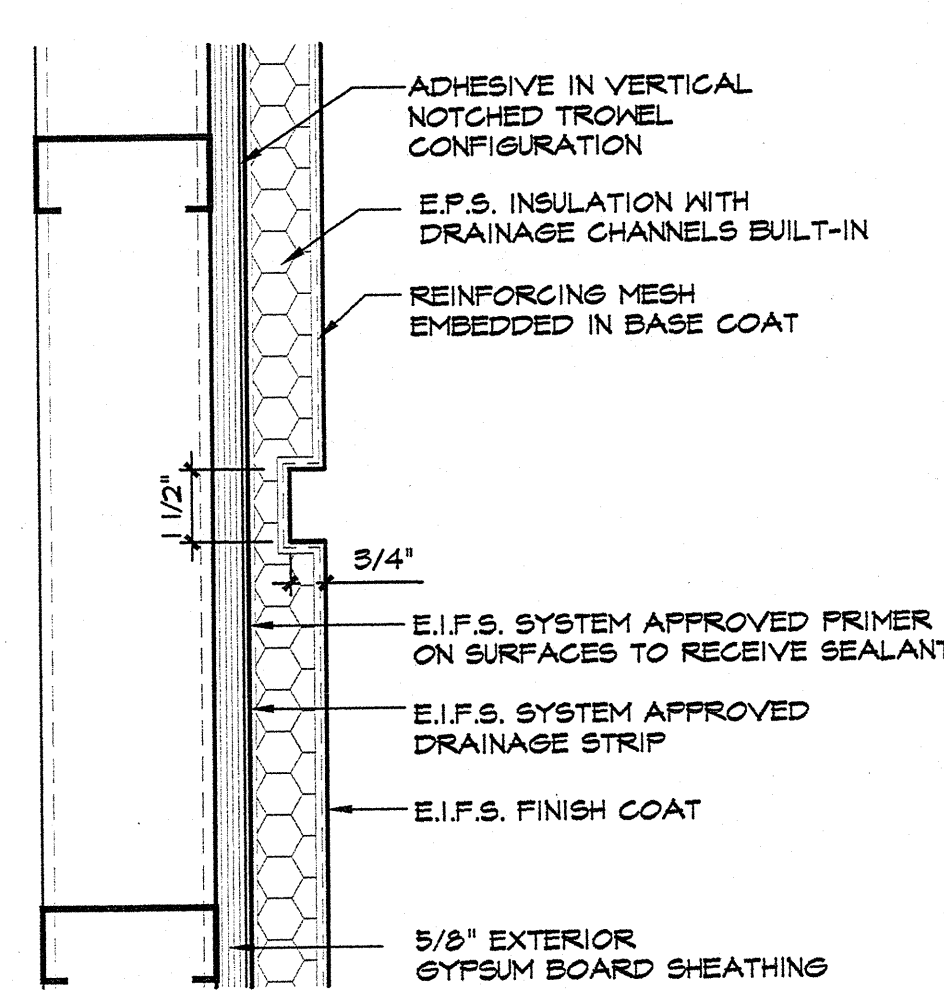


19 EIFS ACCENT CHAMFER
SCALE: 3" = 1'-0"

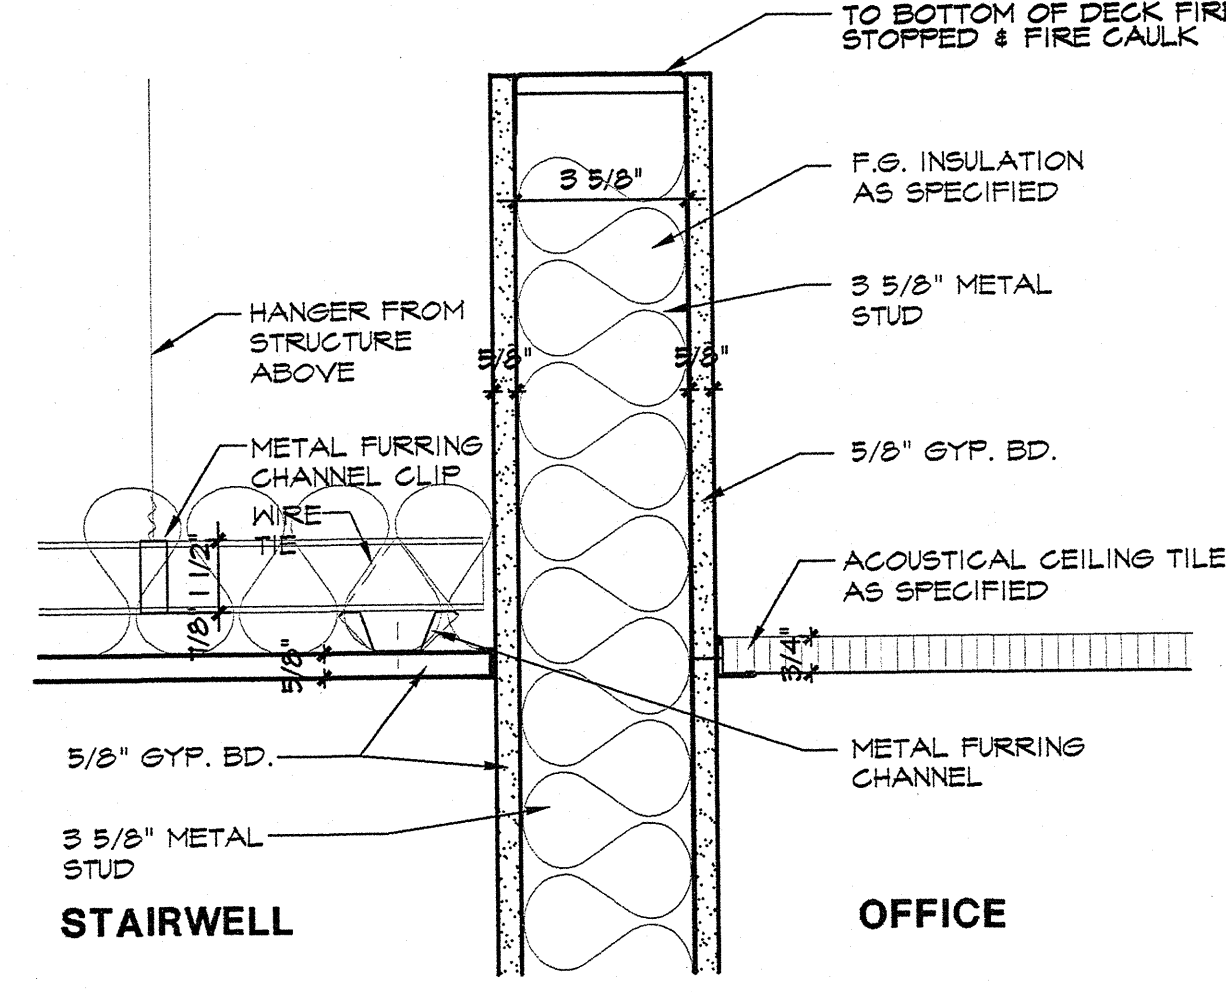


15 CEILING DETAIL @ STAIRWELL
SCALE: 3" = 1'-0"

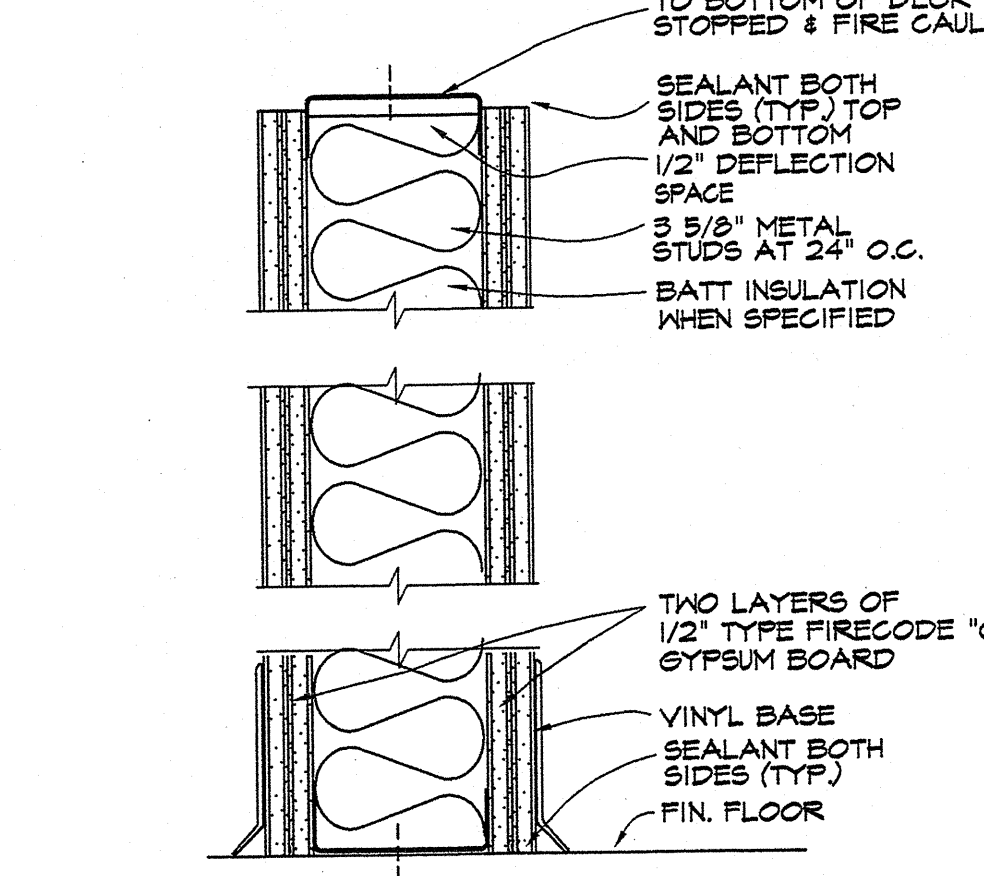


11 2 HOUR PARTITION
SCALE: 3" = 1'-0"

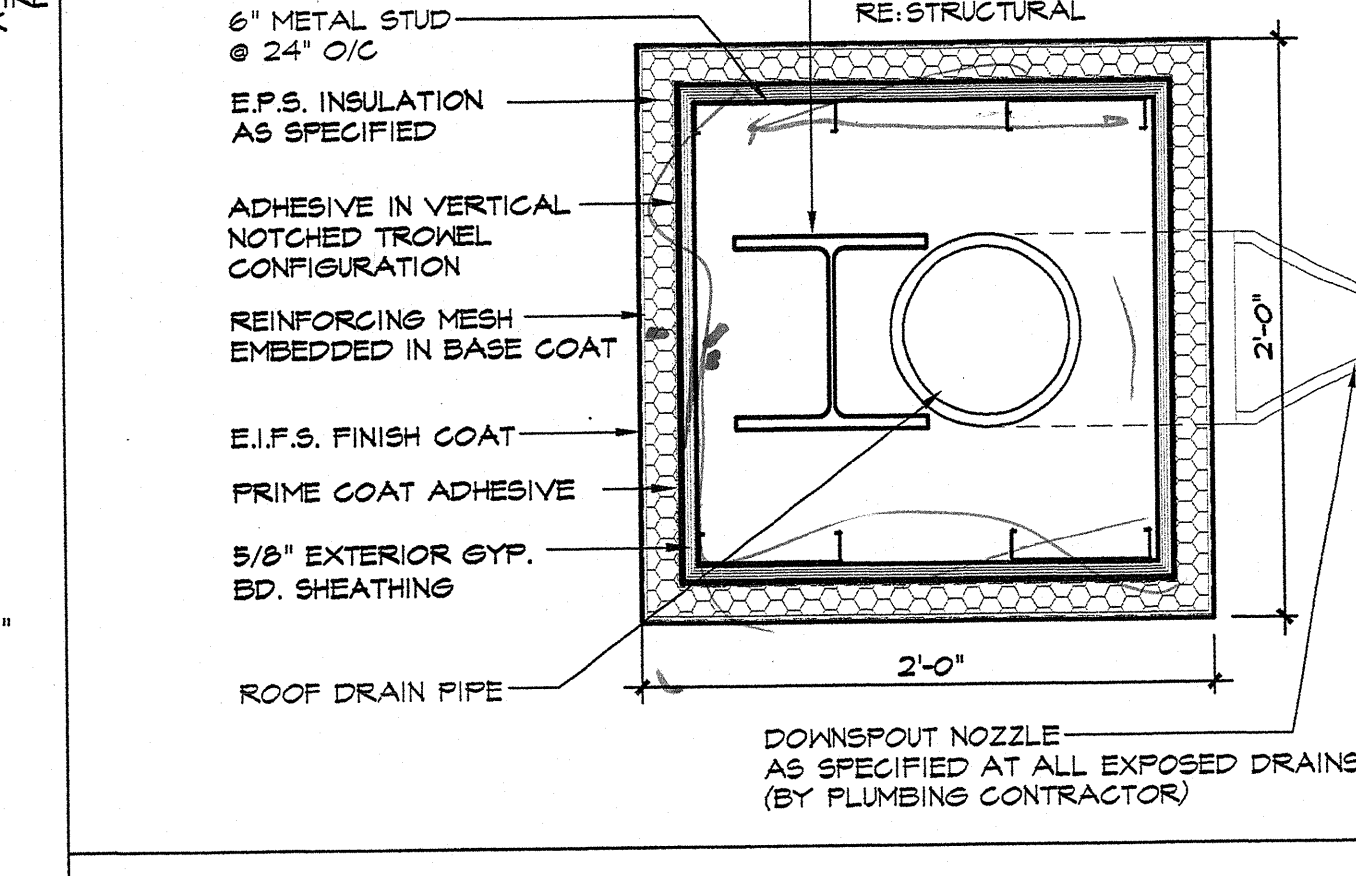


07 EXTERIOR COLUMN DETAIL
SCALE: 1 1/2" = 1'-0"

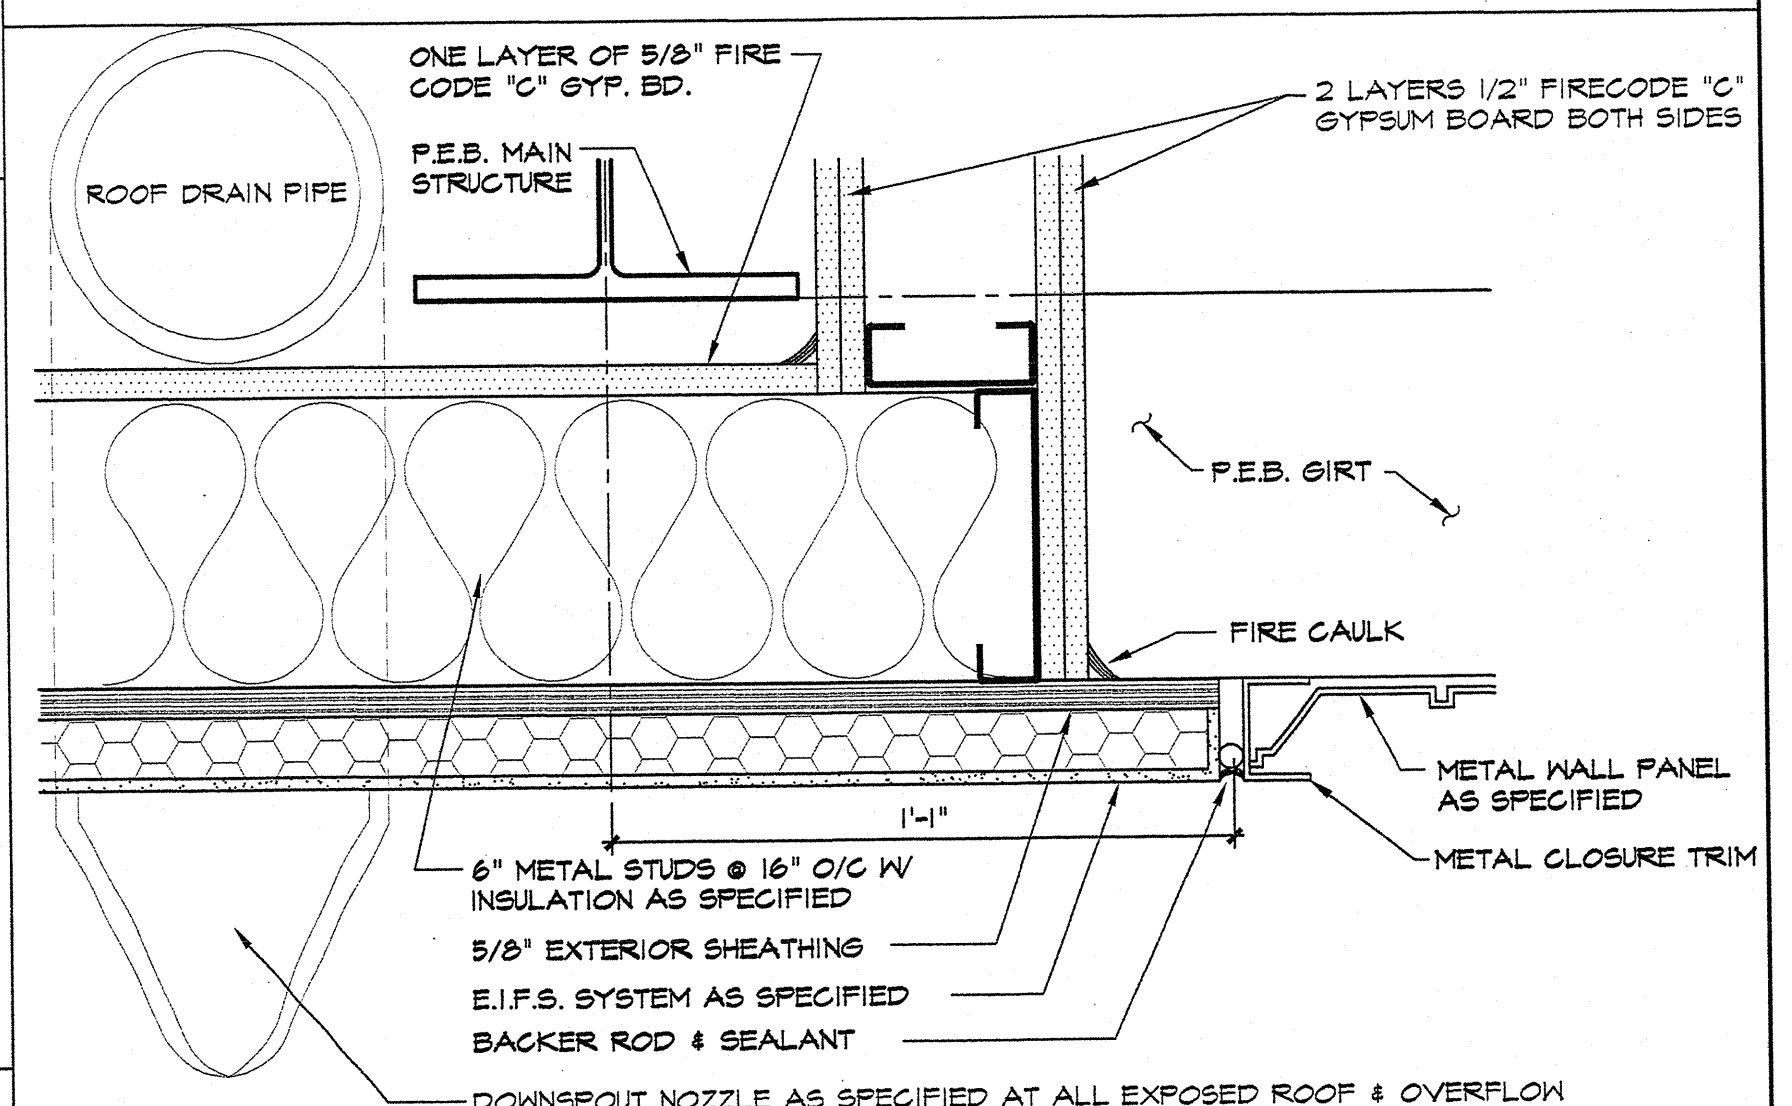


03 TRANSITION FROM E.I.F.S. TO METAL BLDG.
SCALE: 3" = 1'-0"

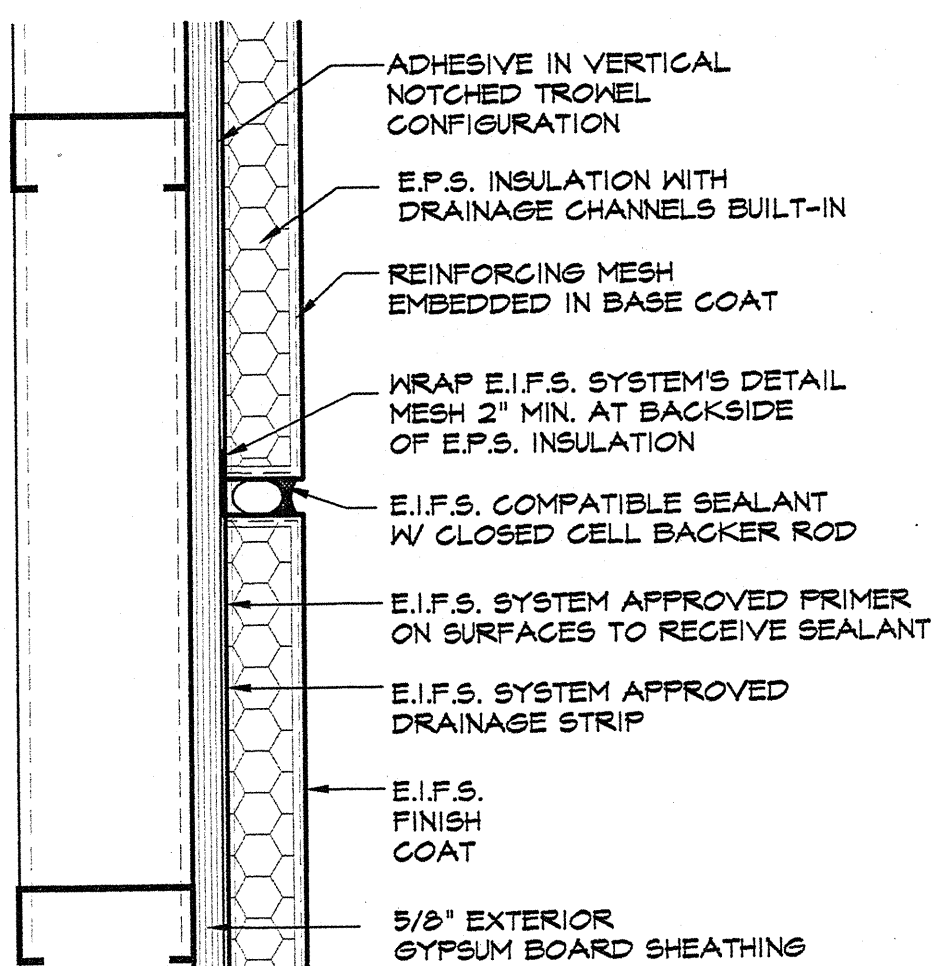


20 VERTICAL EIFS EXPANSION JOINT
SCALE: 3" = 1'-0"

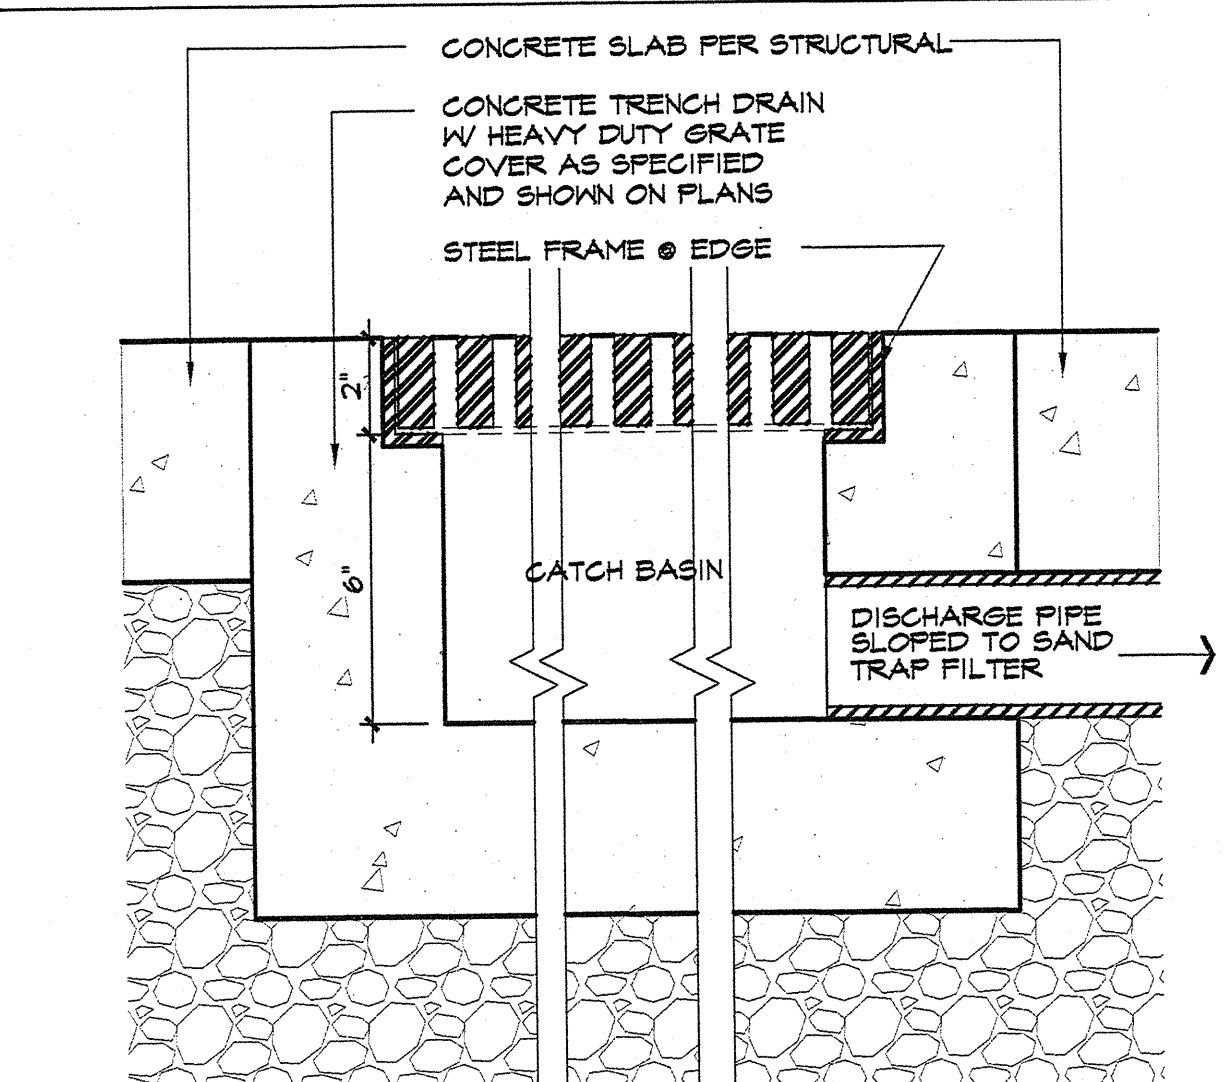


16 FLOOR DRAIN GRATE
SCALE: 3" = 1'-0"

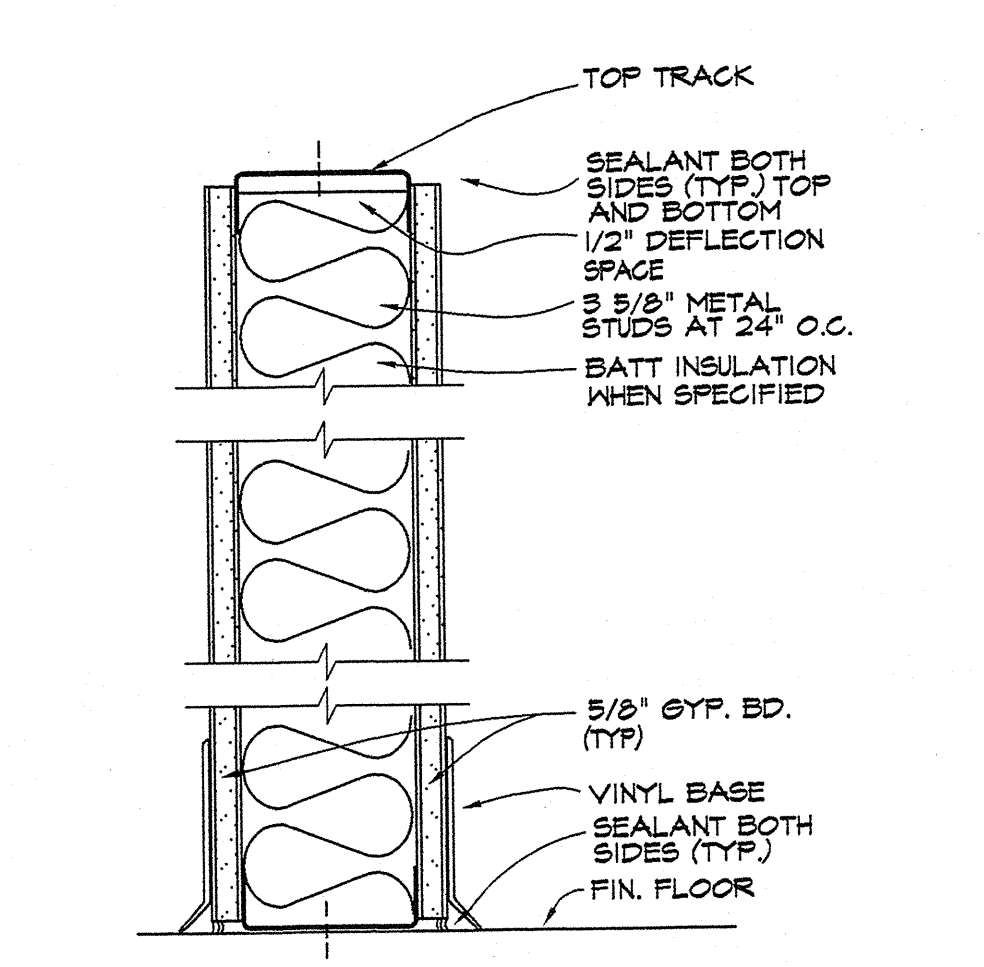



12 GYP. BD. PARTITION
SCALE: 3" = 1'-0"

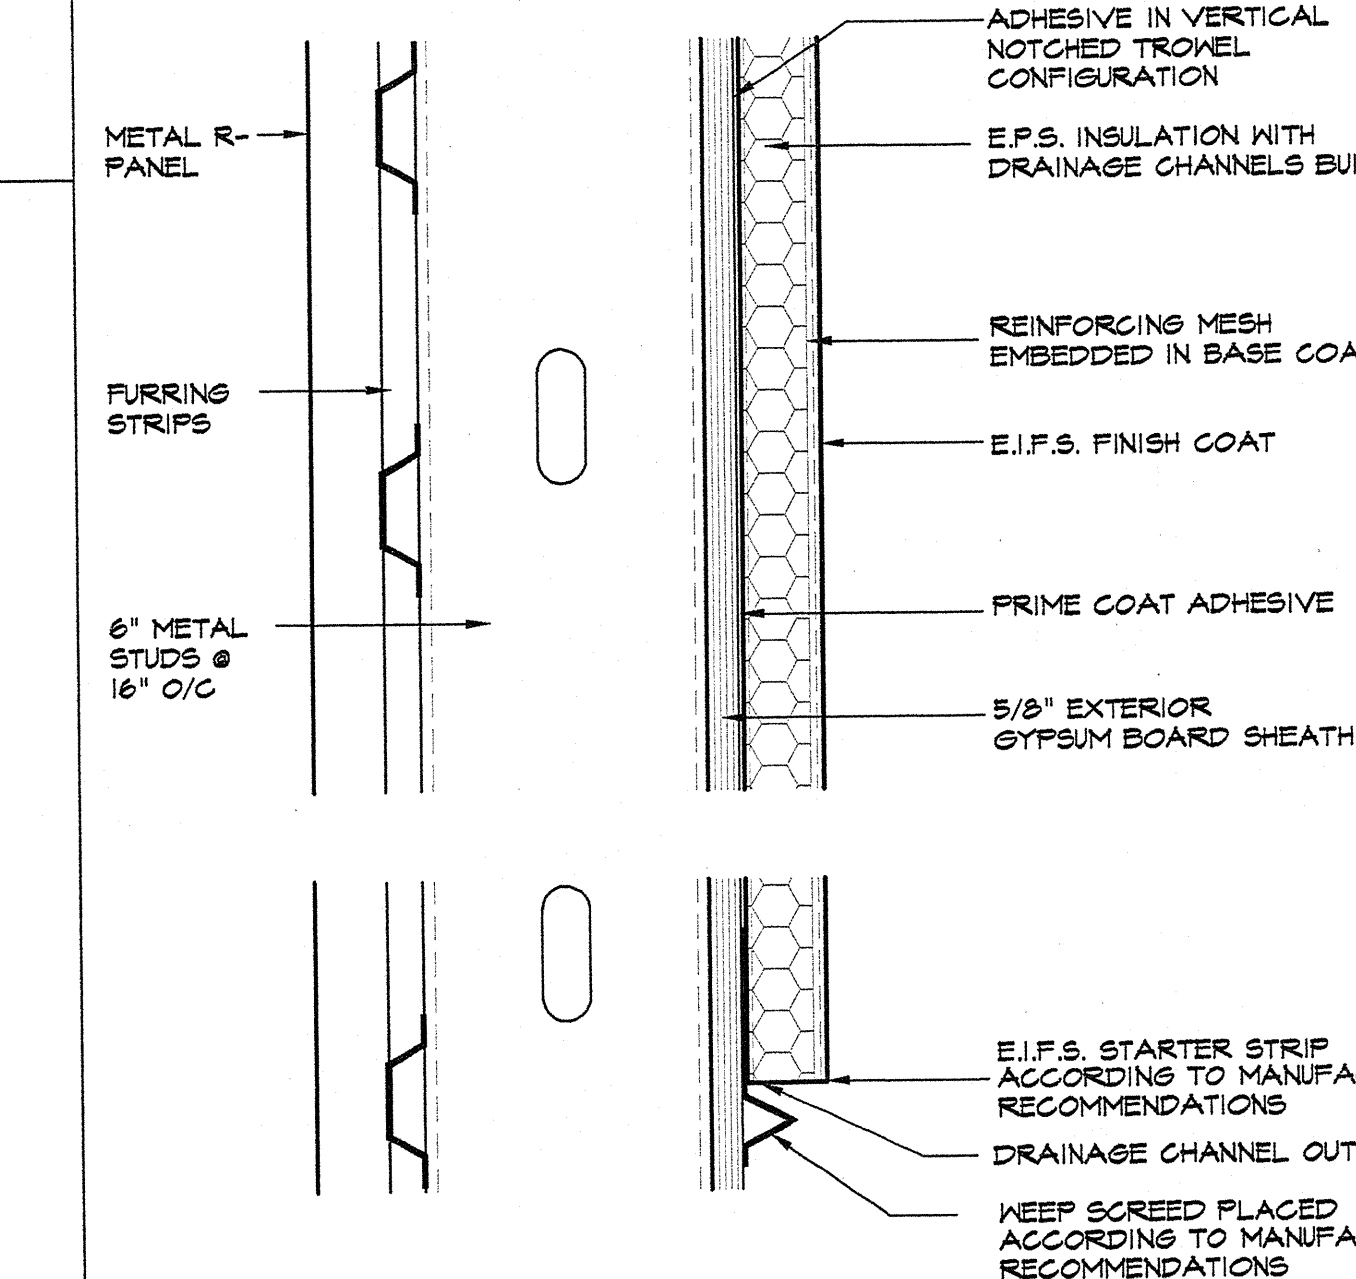

08 EIFS PARAPET WALL SECTION
SCALE: 3" = 1'-0"

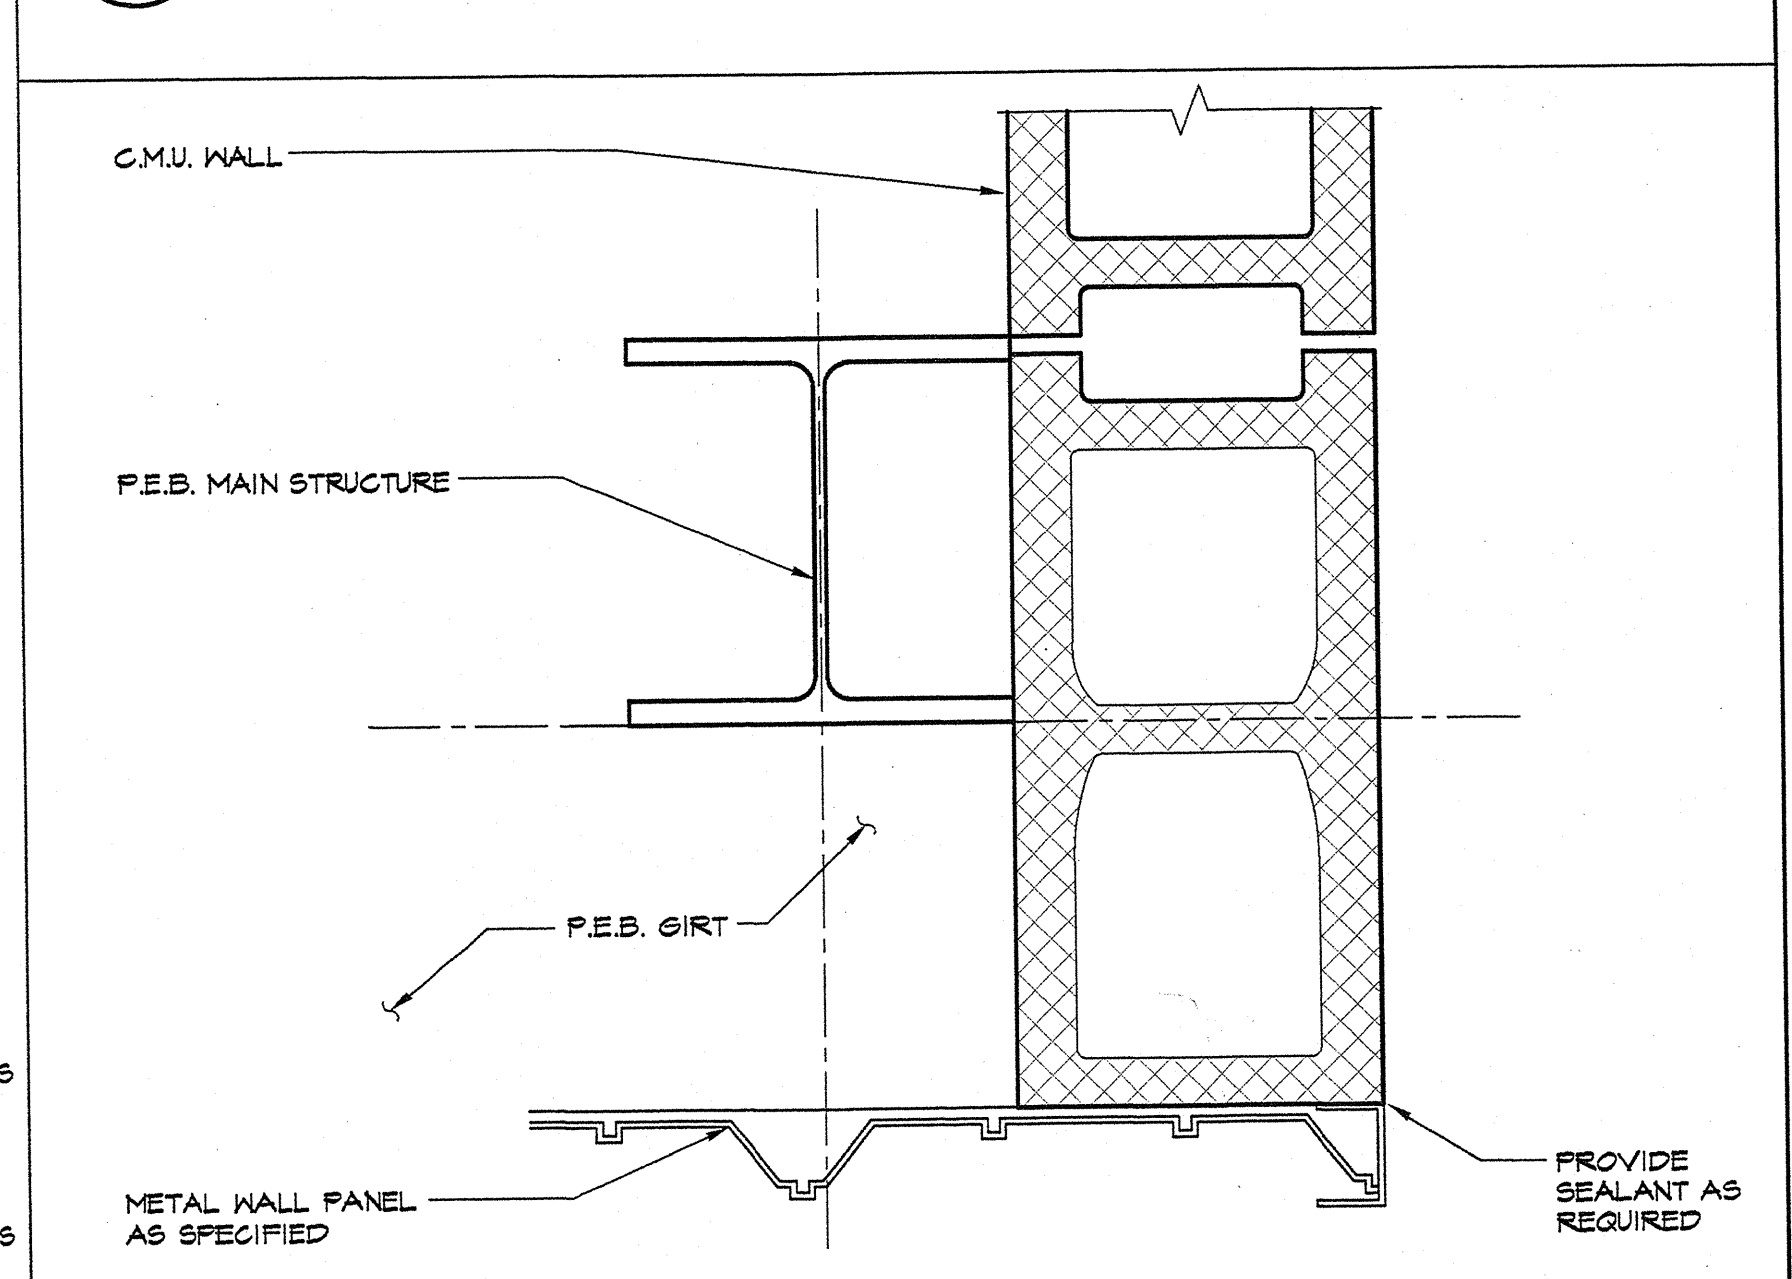

04 TRANSITION FROM METAL BLDG. TO CMU
SCALE: 3" = 1'-0"

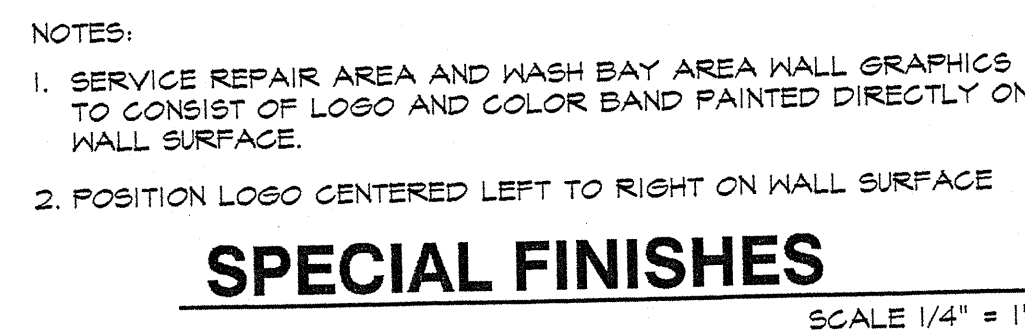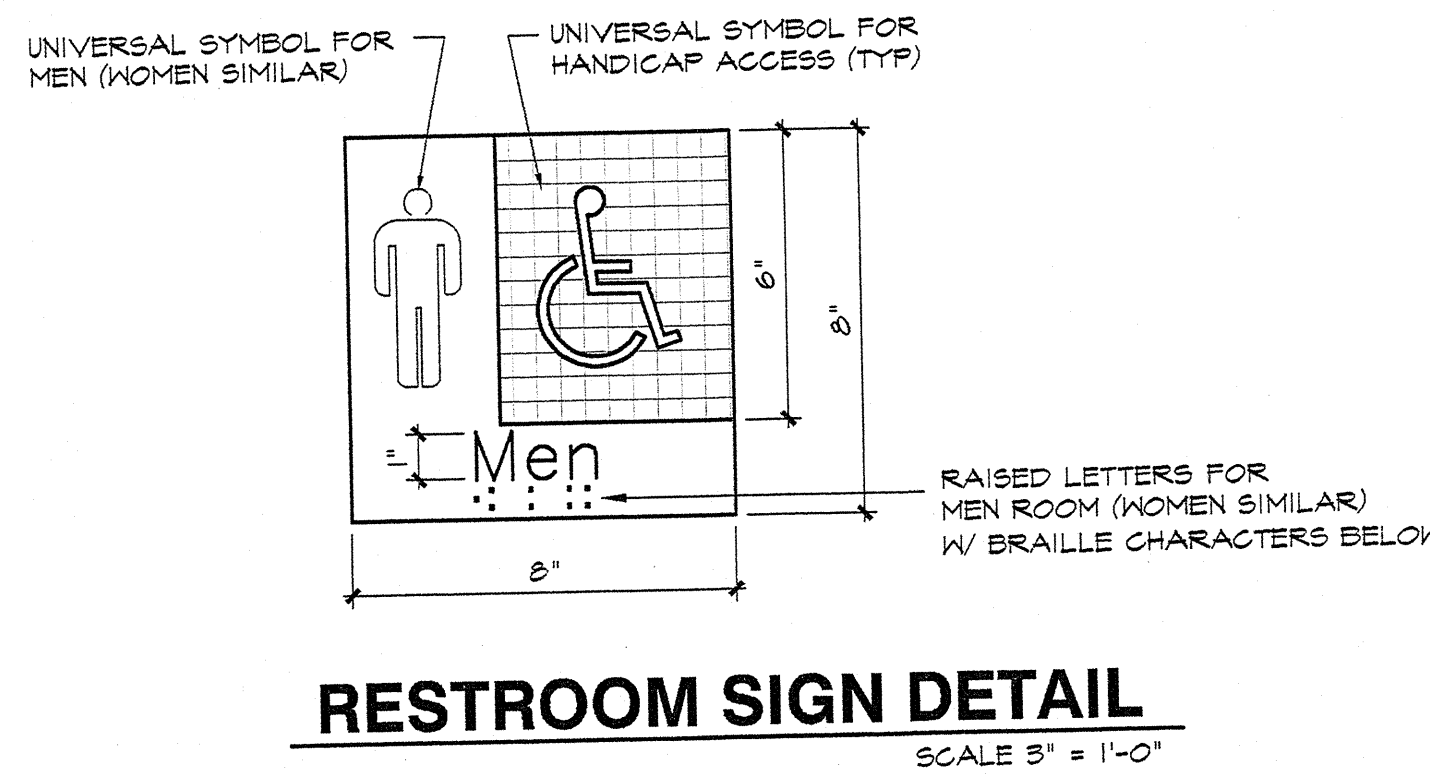

NOTE:
CONTRACTOR TO VERIFY SELECTED FINISHES WITH OWNER PRIOR TO PURCHASE AND INSTALLATION OF PRODUCT. CONTRACTOR SHALL PROVIDE OWNER WITH SAMPLE MATERIAL AND COLORS OF FINISHES TO BE APPLIED.

ROOM FINISH SCHEDULE																														
RM. NO.	ROOM NAME	WALLS										FLOOR										CEILING					TRIM	REMARKS		
		P-1	P-2	P-3	P-4	P-5	P-6	P-7	P-8	P-10	CT-1	CT-2	CT-3	CT-4	CT-5	CT-6	C-1	C-2	VC-1	VC-2	SC-1	P-9	RB-1	ACT-1	EIFS	MFI			GYP	NONE
100	SHOWROOM	X			0						0	0												0					0	
101	NEW VEHICLE MANGER				0						0													0					0	
102	SELECT VEHICLE MANAGER				0						0													0					0	
103	F & I OFFICE				0						0													0					0	
104	CONF. & SALES CONST. WORK AREA				0						0													0					0	
105	SALES				0						0													0					0	
106	SALES				0						0													0					0	
107	SALES				0						0													0					0	
108	SALES				0						0													0					0	
109	SALES				0						0													0					0	
110	CHILD'S PLAY CENTER				0												0							0					0	
111	ELEVATOR																										0		0	
112	CORRIDOR				0						0													0					0	
113	ACCESSORIES DISPLAY				0						0	0												0					0	
114	SERVICE WRITE-UP				0						0	0												0					0	
115	CASHIER				0																0			0					0	
116	WOMEN'S RESTROOM				0									0										0					0	
117	MEN'S RESTROOM				0									0										0					0	
118	PARTS MANAGER				0																0			0					0	
119	PARTS STORAGE/RECEIVING			0																	0			0				0	0	
120	SECURE TOOLS			0																			0						0	
121	EMPLOYEE LOUNGE				0															0			0						0	
122	WOMEN'S TECH RESTROOM				0													0					0						0	
123	MEN'S TECH RESTROOM				0													0					0						0	
124	SPEC. TOOLS				0																0		0						0	
125	TECH PARTS			0																	0		0						0	
126	SERVICE MANAGER				0																0		0						0	
127	EXPRESS SERVICE PARTS			0																	0		0						0	
128	EXPRESS SERVICE ENTRY			0																	0		0						0	
129	STAIRWELL				0															0			0				0		0	
130	SERVICE DEPARTMENT	0			0		0													0								0		
131	MAKE READY MANAGER	0			0		0													0								0		
132	WASH BAYS	0			0		0													0								0		
133	WASH BAYS	0			0		0													0						0		0		
200	MECHANICAL ROOM				0																0								0	
201	RECEPTION/ WAITING MEZZANINE				0													0						0					0	
202	ELEVATOR EQUIPMENT				0															0								0		
203	GENERAL MANAGERS/CONF./TRAINING				0													0						0					0	
204	ELECTRICAL/MECHANICAL				0															0									0	
205	WOMEN'S RESTROOM				0								0											0					0	
206	MEN'S RESTROOM				0								0											0					0	
207	GENERAL OFFICE				0												0							0					0	
208	BREAK ROOM				0													0						0					0	
209	MECHANICAL DECK				0																					0				
	SERVICE DRIVE CANOPY																						0							
	SHOWROOM STAIR																													
																			</											

ROOM FINISH SCHEDULE

ROGER BEASLEY VOLVO

AN AUTOMOTIVE DEALERSHIP

INTERSTATE HIGHWAY 35 SOUTH
GEORGETOWN, TEXAS

**ELSASSER
ARCHITECTURAL
INC.**

ARCHITECTURE AND PLANNING



P.O. BOX 833 GEORGETOWN, TN 38627
TEL: 662.920.5353 FAX: 662.920.2618 WWW.ELSAX.COM

CONSULTANT INFORMATION

DATE:	09/18/02
REVISION DATE:	

PROJECT NO.	02008
SHEET NO.	

A8.3

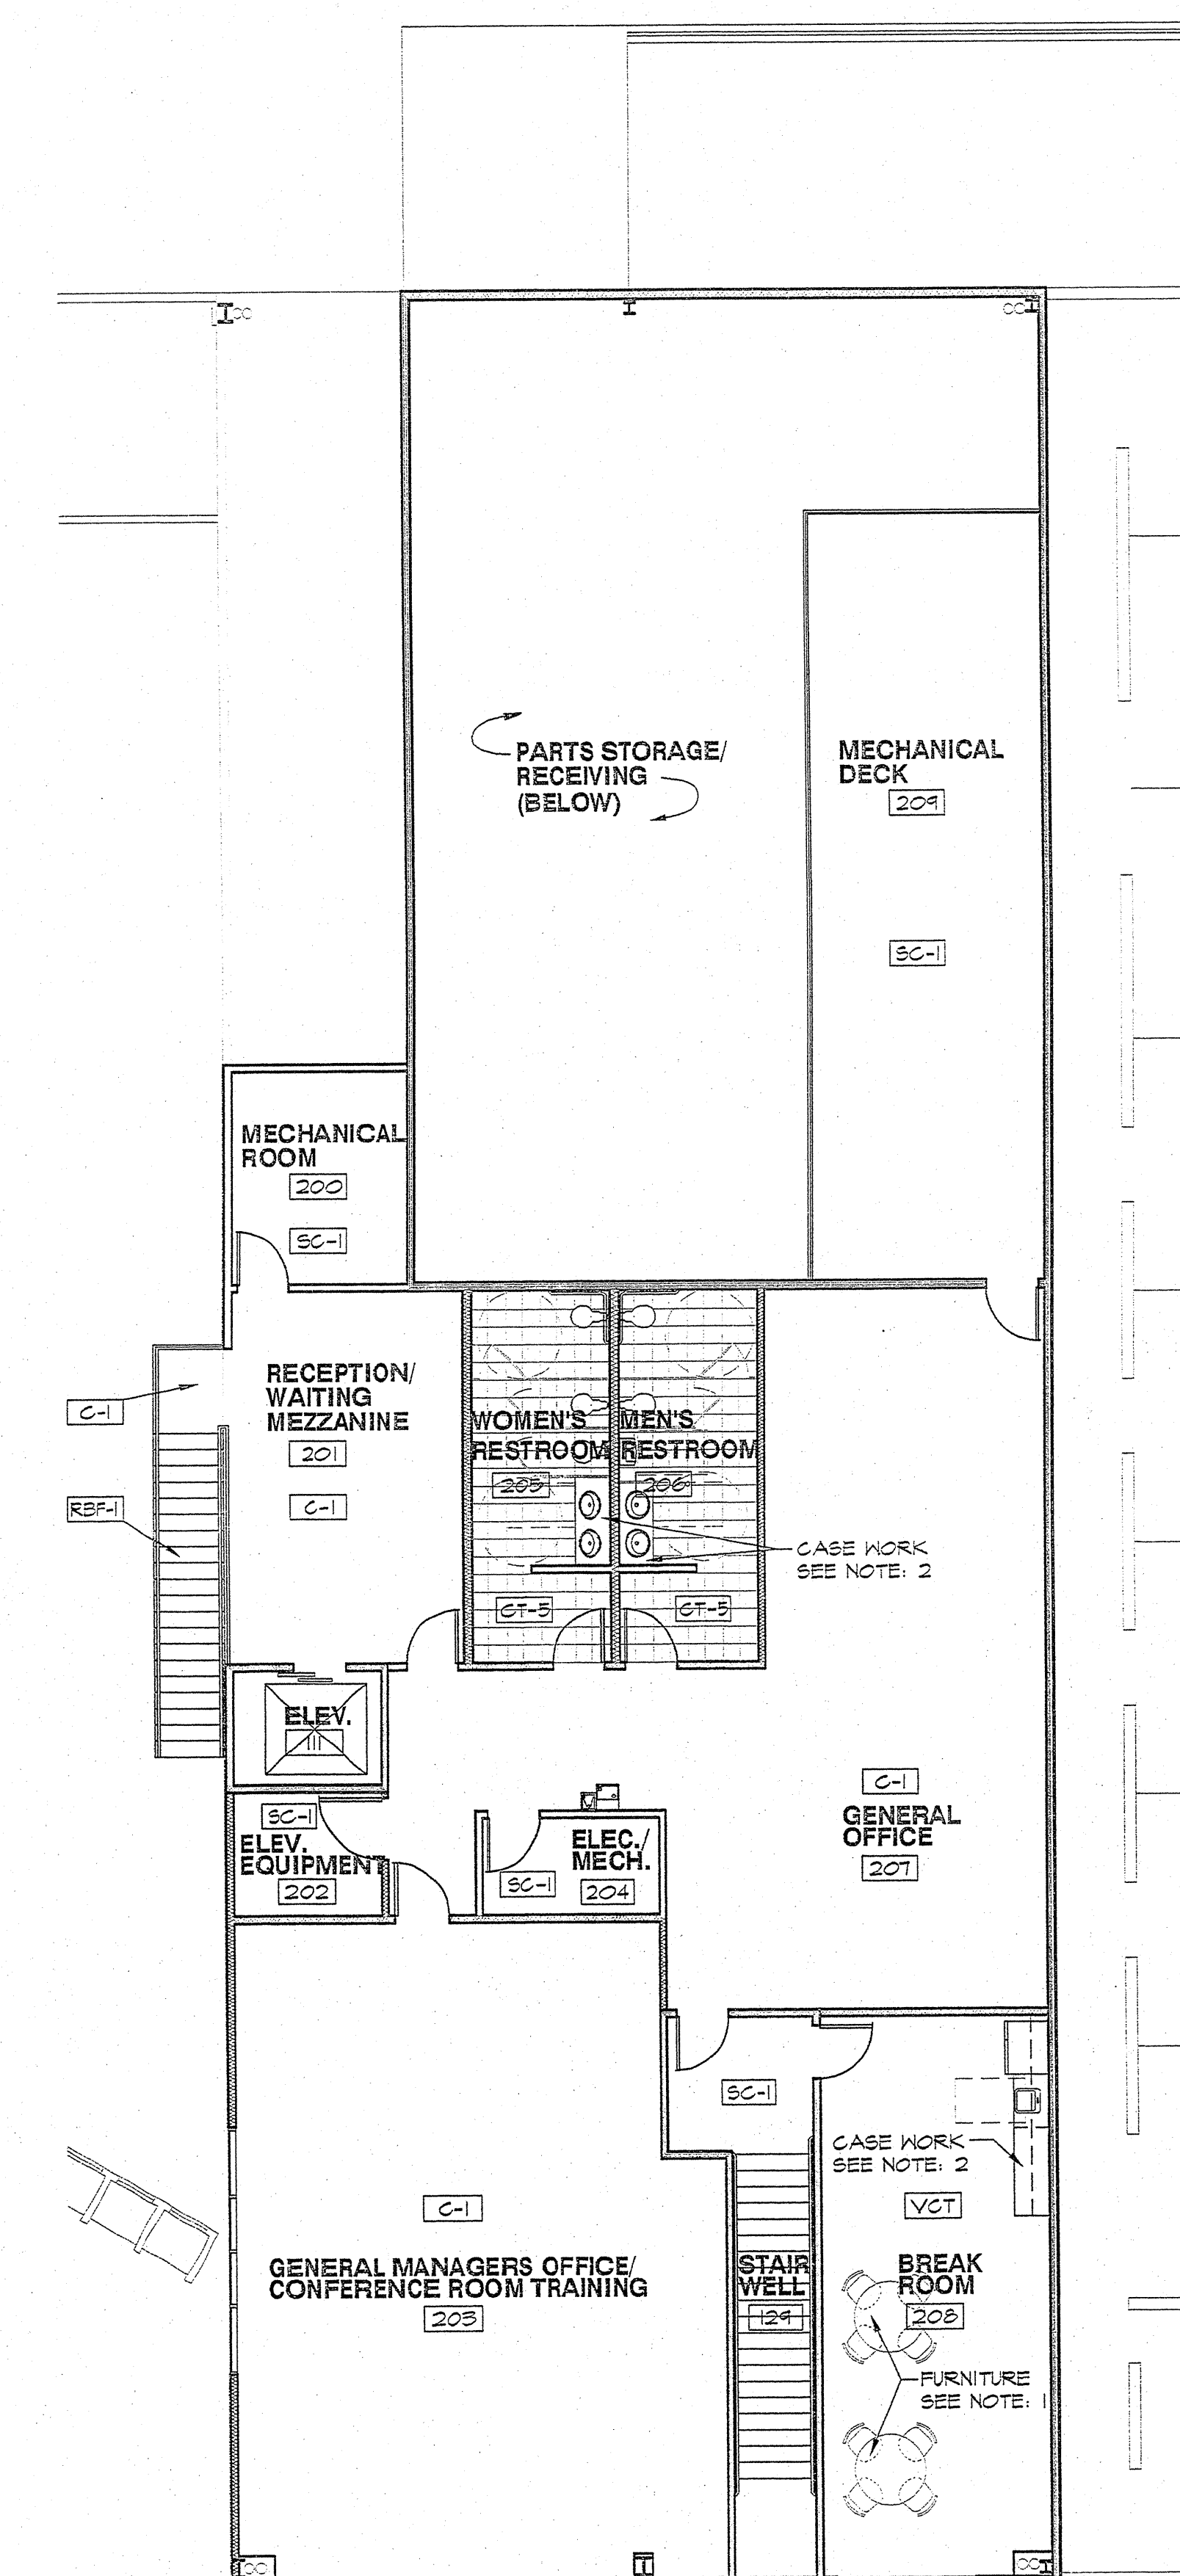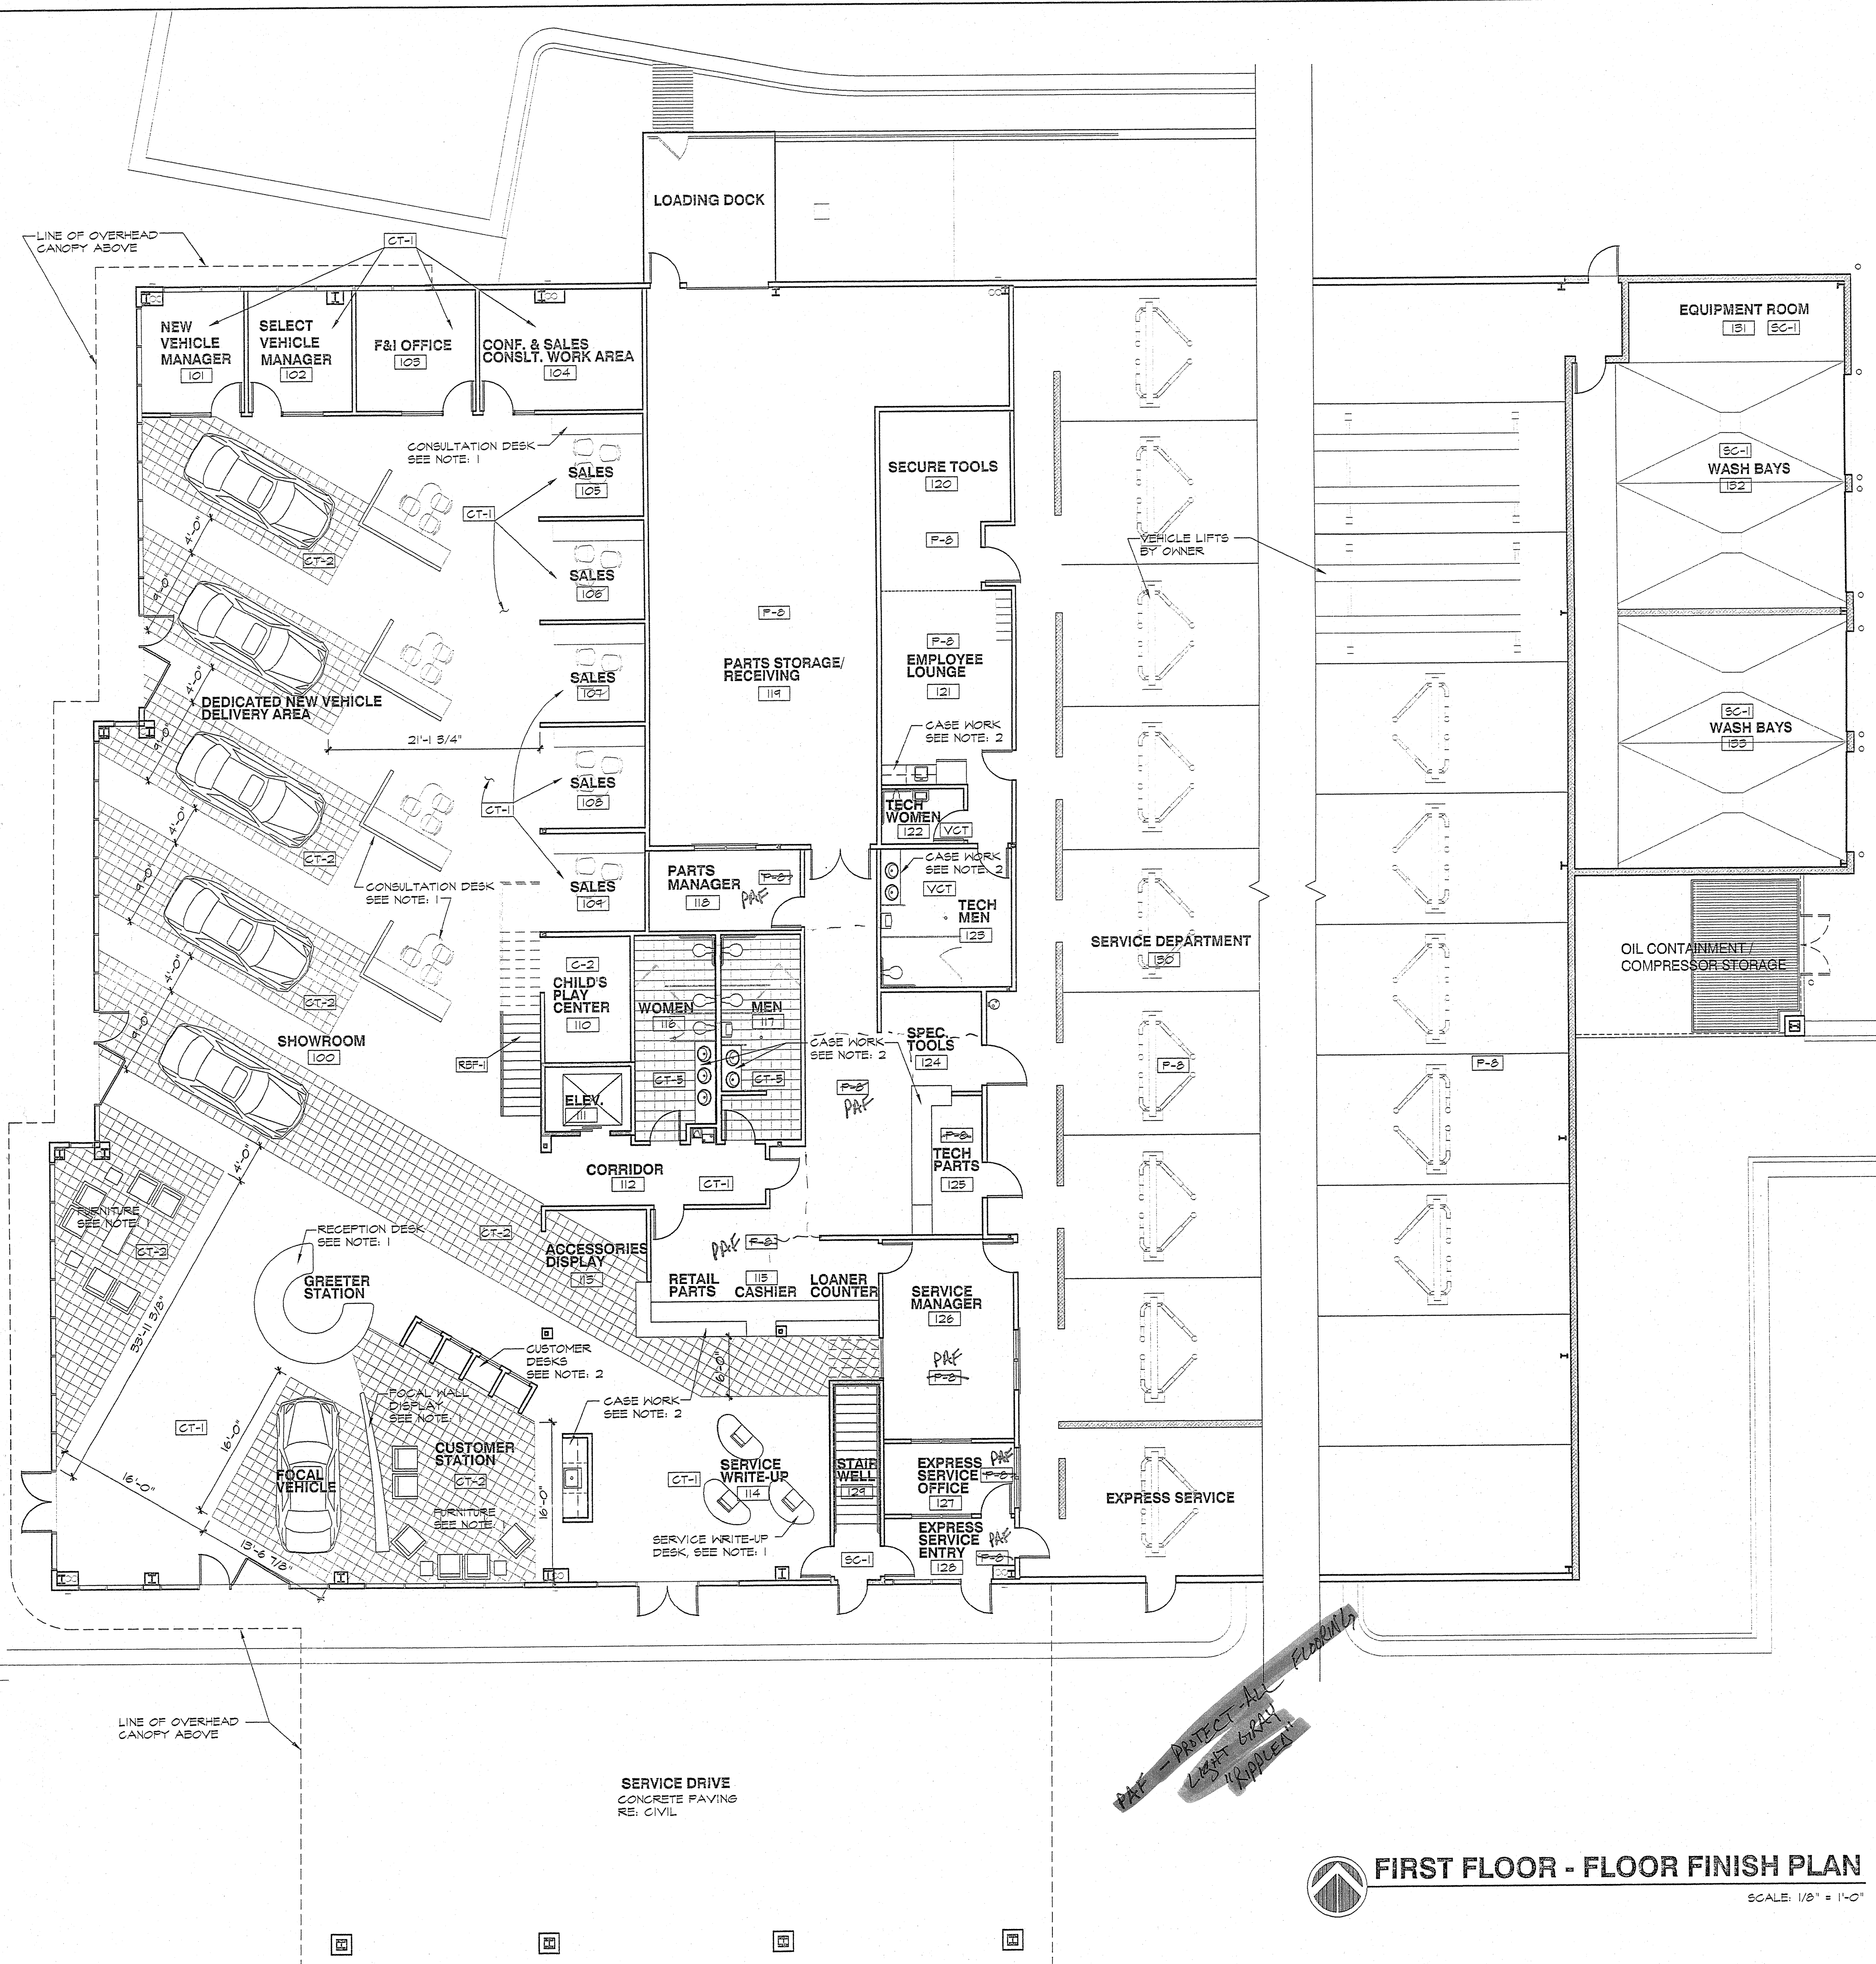


AN AUTOMOTIVE DEALERSHIP
ROGER BEASLEY VOLVO

INTERSTATE HIGHWAY 35 SOUTH
GEORGETOWN, TEXAS

**ELSASSER
ARCHITECTURAL
INC.**
ARCHITECTURE AND PLANNING

P.O. BOX 433 GEORGETOWN, TX 78627
(512) 930-5563 FAX (512) 930-2618 www.eai-h.com

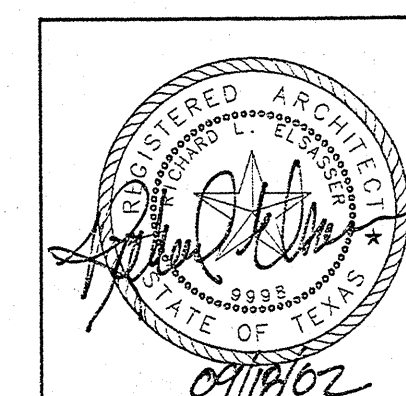CONSULTANT
INFORMATION:





DATE:
09/18/02

REVISION DATE:

PROJECT NO.	02008
-------------	-------

SHEET NO.

A9.0

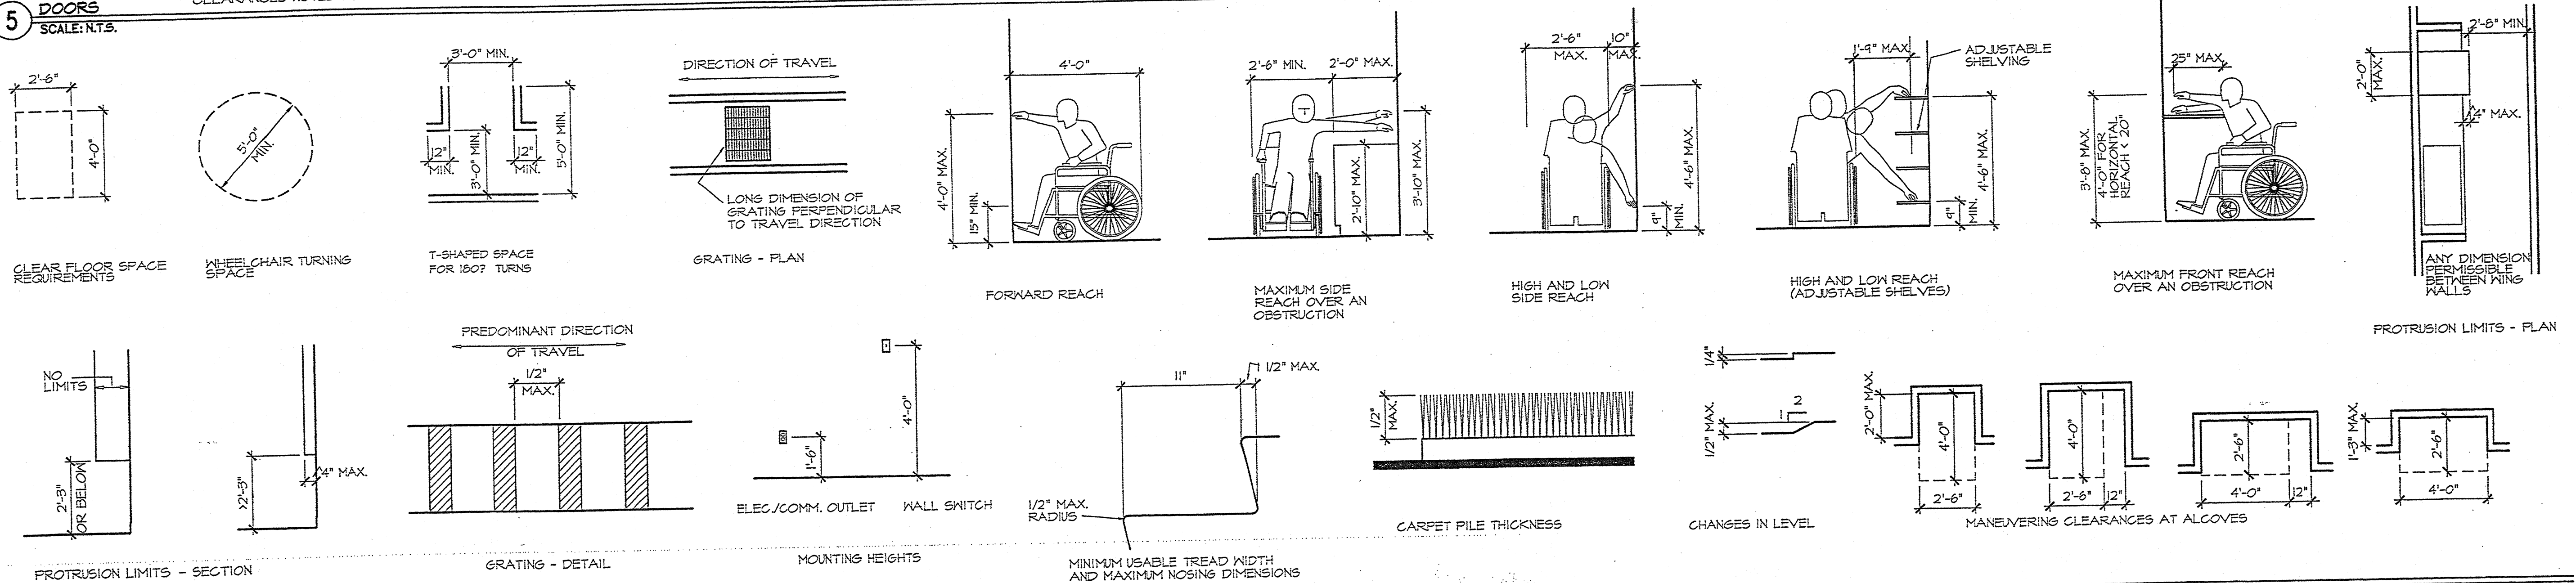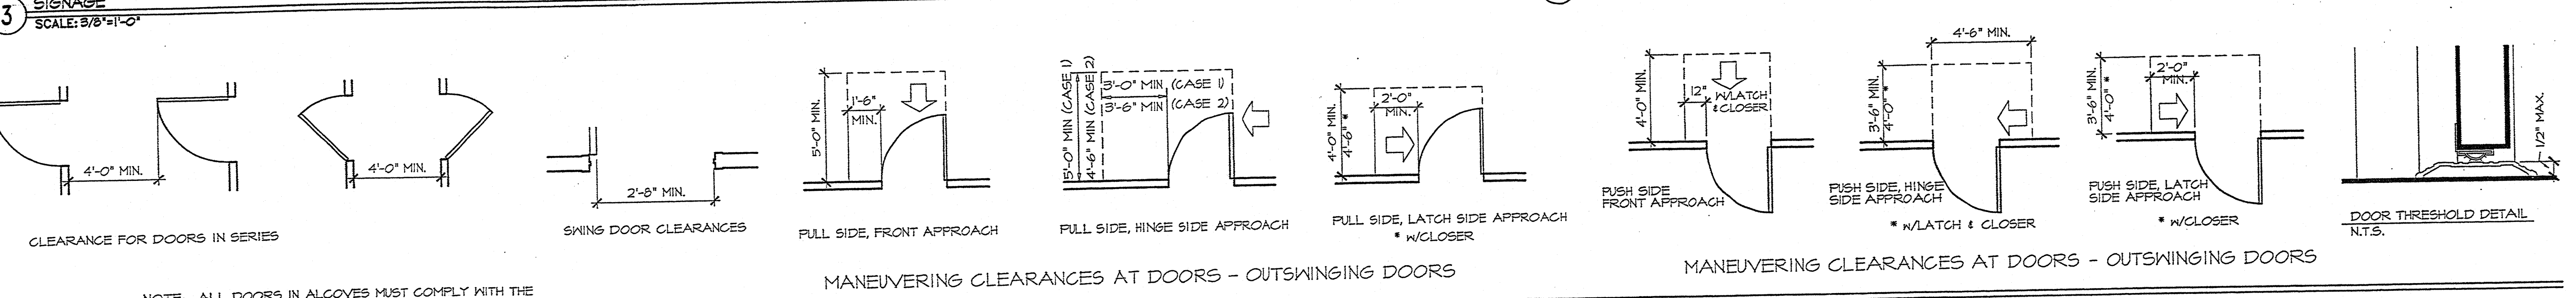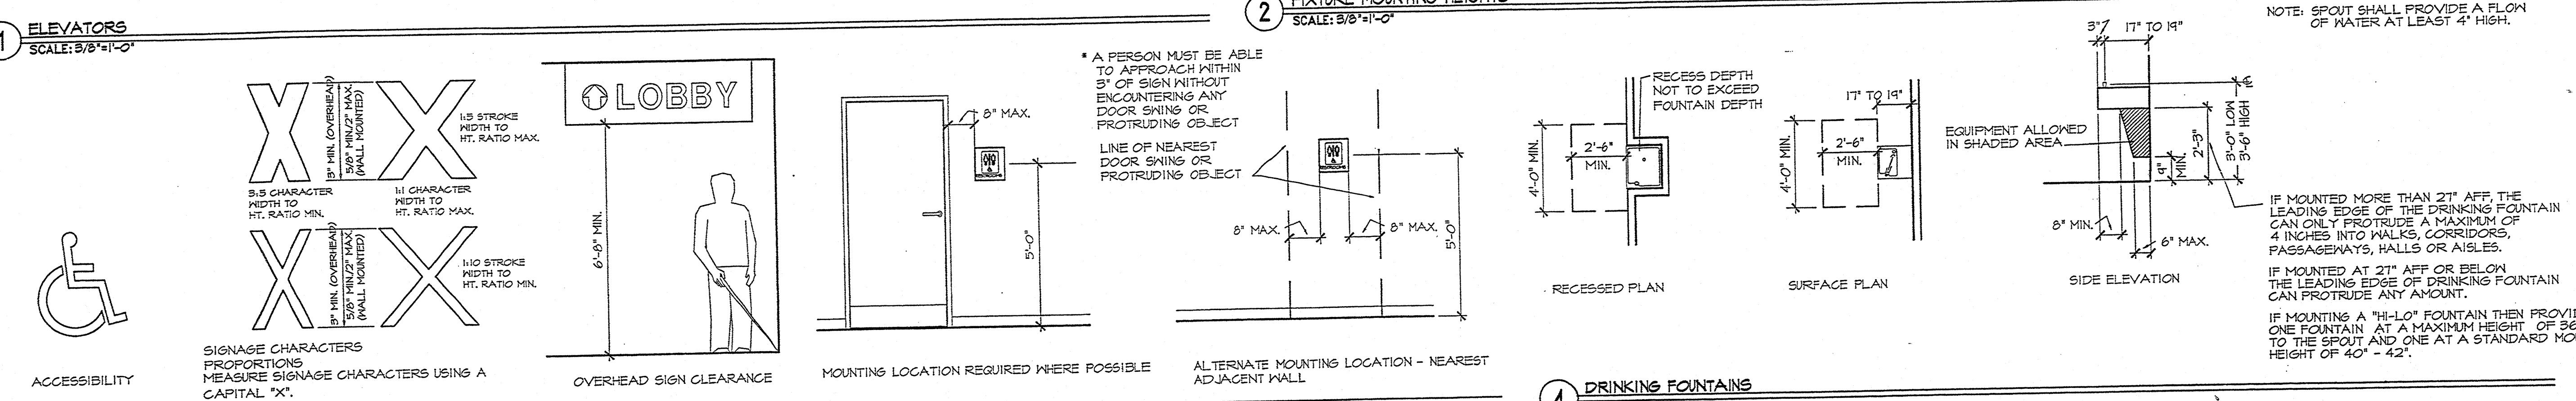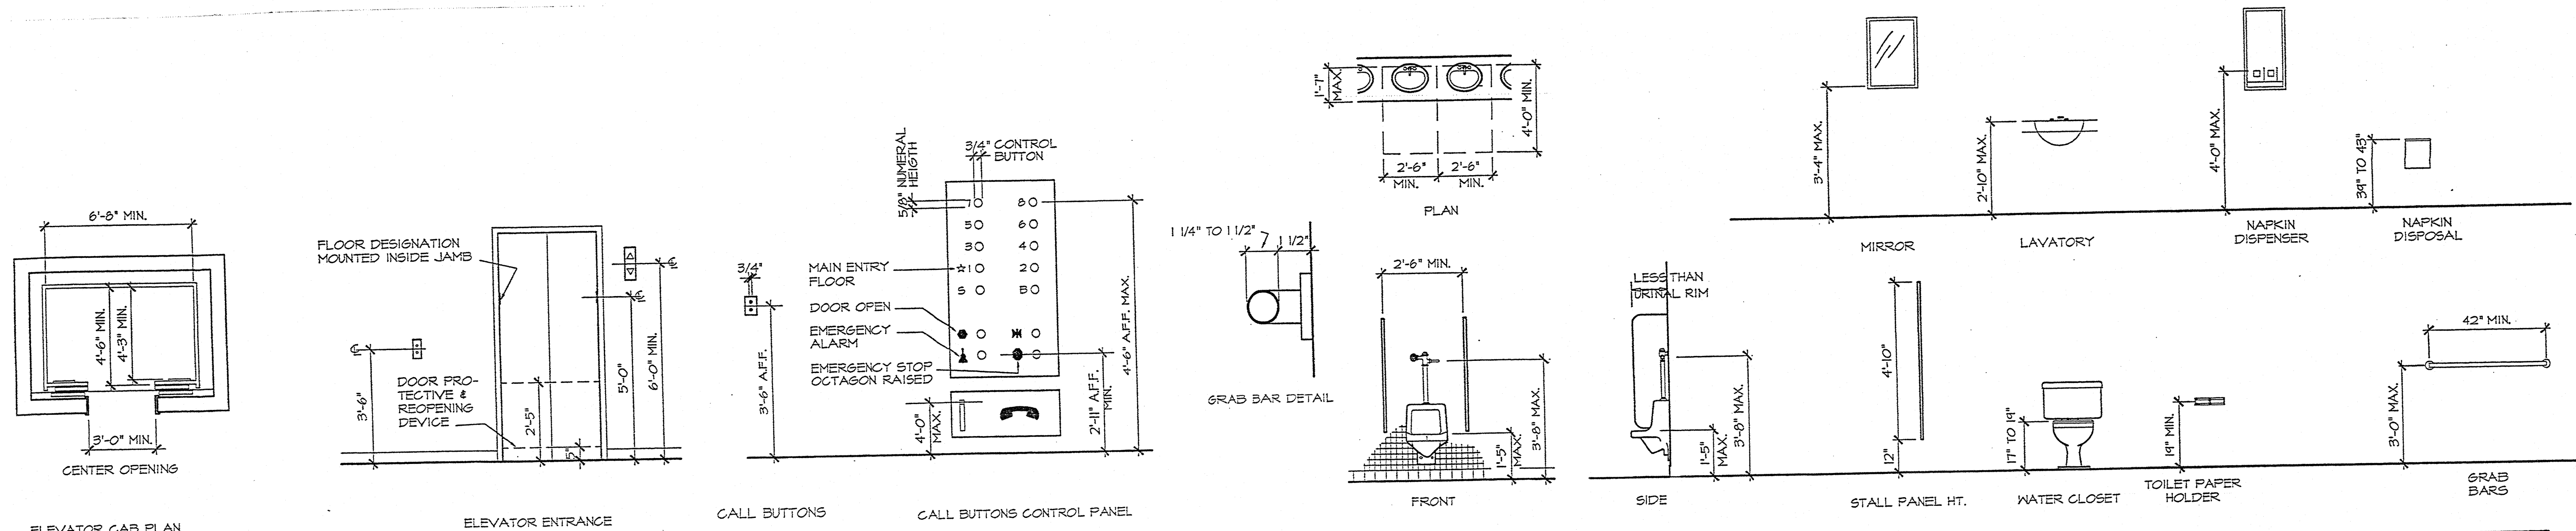

A.D.A REQUIREMENTS

AN AUTOMOTIVE DEALERSHIP

ROGER BEASLEY VOLVO

INTERSTATE HIGHWAY 35 SOUTH
GEORGETOWN, TEXAS

ELASSER ARCHITECTURAL INC.
ARCHITECTURE AND PLANNING
P.O. BOX 883 GEORGETOWN, TX 78627
(512) 350-3553 FAX (512) 350-8118 www.ea-inc.com

CONSULTANT INFORMATION:

DATE: 09/18/02
REVISION DATE:

PROJECT NO. 02008
SHEET NO.

A9.1

GENERAL REQUIREMENTS:

- ALL CODES AND STANDARDS REFERENCED HEREIN SHALL BE THE LATEST EDITION. THE REQUIREMENTS OF THE STANDARD BUILDING CODE AS PUBLISHED BY THE SOUTHERN BUILDING CODE CONGRESS INTERNATIONAL, INC. SHALL GOVERN THE DESIGN AND CONSTRUCTION OF THIS WORK.
- THE CONTRACTOR SHALL FIELD VERIFY EXISTING CONDITIONS AT THE JOBSITE AND SHALL NOTIFY THE ARCHITECT OF ANY DISCREPANCIES.
- PRINCIPLE OPENINGS THROUGH THE STRUCTURAL SYSTEM ARE INDICATED ON THE STRUCTURAL DRAWINGS. THE CONTRACTOR SHALL EXAMINE THE ARCHITECTURAL AND MECHANICAL DRAWINGS FOR REQUIRED OPENINGS AND SHALL COORDINATE WITH THE STRUCTURAL ENGINEER ON ANY DISCREPANCIES. THE CONTRACTOR SHALL VERIFY THE SIZE AND LOCATION OF ALL OPENINGS WITH THE MECHANICAL SUBCONTRACTOR.
- ANY CHANGES TO THE STRUCTURAL DRAWINGS REQUIRED DUE TO THE ACCEPTANCE OF ALTERNATES AND/OR SUBSTITUTIONS ARE THE RESPONSIBILITY OF THE CONTRACTOR AND SHALL BE SUBMITTED TO THE STRUCTURAL ENGINEER FOR APPROVAL.
- FLOOR SLOPES, LOCATIONS AND DEPTHS OF FLOOR DEPRESSIONS, FLOOR FINISHES, TOPPING SLABS, ETC. ARE SHOWN ON THE DRAWINGS. THE CONTRACTOR SHALL PROVIDE ALL SLAB RECESSES AS SHOWN ON THE ARCHITECTURAL OR STRUCTURAL DRAWINGS.
- JOB SAFETY SHALL BE THE SOLE RESPONSIBILITY OF THE CONTRACTOR.
- THESE DRAWINGS ARE DIAGRAMMATIC IN NATURE. DO NOT SCALE THESE DRAWINGS.
- IMPORTANT BIDDING NOTE: CONTRACTOR SHALL REVISE THE CONTRACT AMOUNT BASED ON ANY CHANGES THAT MAY BE REQUIRED WHEN PRE-ENGINEERED BUILDING FRAME REACTIONS AND DRAWINGS ARE AVAILABLE.

DESIGN LOADS:

THE FOLLOWING LOADS WERE USED TO PROPORTION THE STRUCTURAL MEMBERS AND CONNECTIONS FOR THESE DRAWINGS:

- LIVE LOADS
ROOF _____ 20 PSF
FLOOR _____ 50 PSF
SECOND FLOOR OFFICE _____ 50 PSF
SECOND FLOOR STORAGE _____ 125 PSF
- WIND LOADS (BASIC WIND SPEED OF 70 MILES PER HOUR, EXPOSURE C)
- DEAD LOADS
ROOF/CEILING _____ 20 PSF
- FINAL PIER SIZES AND LOCATIONS MUST BE BASED ON LOADS AND DRAWINGS PROVIDED BY P.E.B. MANUFACTURER (NOT AVAILABLE AT THE TIME THESE DRAWINGS WERE ISSUED).

GEOTECHNICAL NOTES:

- THIS DESIGN IS BASED ON A GEOTECHNICAL INVESTIGATION AND REPORT PREPARED BY P.S.L. INC. COPIES MAY BE OBTAINED AT THE OFFICE OF THE ARCHITECT.
- IF EXCAVATION REVEALS CONDITIONS DIFFERENT FROM THOSE INDICATED IN THE REPORT, STOP THE WORK AND CONTACT THE ENGINEER FOR RECOMMENDATIONS.

FOUNDATION NOTES:

- STRAIGHT SHAFT DRILLED PIERS SHALL BE FOUNDED 20 FEET BELOW EXISTING GRADE (SEE GEOTECHNICAL REPORT). DESIGN BEARING VALUES ARE AS FOLLOWS:
END BEARING _____ 15,000 PSF
- ALL PIER SHAFTS SHALL BE CAREFULLY CLEANED TO THE SATISFACTION OF THE GEOTECHNICAL ENGINEER. EACH PIER SHALL BE INSPECTED AND APPROVED BY THE GEOTECHNICAL ENGINEER PRIOR TO PLACEMENT OF CONCRETE.
- CONCRETE SHALL BE PLACED IN THE DRILLED SHAFTS AS SOON AS POSSIBLE AFTER APPROVAL OF THE SHAFT BY THE GEOTECHNICAL ENGINEER. IN NO CASE SHOULD A SHAFT BE LEFT OPEN LONGER THAN EIGHT (8) HOURS WITHOUT BEING FILLED WITH CONCRETE.
- CONTRACTOR SHALL INCLUDE IN HIS BID ALLOWANCES FOR INCREASES OR DECREASES IN PIER DEPTHS FROM THOSE INDICATED ON THE DRAWINGS.
- SHOULD SLOUGHING AND/OR GROUNDWATER SEEPAGE OCCUR DURING PIER CONSTRUCTION PROVIDE TEMPORARY STEEL CASING AS REQUIRED.

PREPARATION OF THE BUILDING PAD:

- REMOVE ALL TRASH, BRUSH OR OTHER DEBRIS FROM THE SURFACE OF THE BUILDING SITE AND HAUL AWAY.
- PREPARE THE SUBGRADE IN ONE OF TWO METHODS (A OR B) (AS DESCRIBED IN THE GEOTECHNICAL REPORT):
 - REMOVE 90", 5 FEET PAST BUILDING LINE AND REPLACE WITH SELECT FILL AS DESCRIBED IN THE GEOTECHNICAL REPORT.
 - REMOVE 90" OF EXISTING FILL MATERIAL (ONLY) 5 FEET PAST THE BUILDING LINE. REMOVE ALL DELETERIOUS MATERIALS AND PARTICLES LARGER THAN 1 INCH IN DIAMETER FROM THE EXCAVATED MATERIAL. RESTORE PROCESSED FILL MATERIAL TO EXCAVATION ACCORDING TO THE GEOTECHNICAL REPORT. IF THE GRADES IN THE BUILDING PAD AREAS CANNOT BE RESTORED WITH THE VOLUME OF MATERIALS EXCAVATED, THE REMAINING PORTION OF THE EXCAVATION SHOULD BE FILLED WITH CRUSHED LIMESTONE SELECT FILL ACCORDING TO THE GEOTECHNICAL REPORT. CHEMICALLY INJECT ENGINEERED FILL SOILS ACCORDING TO THE GEOTECHNICAL REPORT.
- CONDUCT IN-PLACE DENSITY TESTS FOR EACH LIFT TO VERIFY THE COMPACTION OF THE SUBGRADE. EACH LIFT SHALL BE INSPECTED PRIOR TO PLACEMENT OF THE SUBSEQUENT LIFT.
- PREVENT EXCESSIVE LOSS OF SUBGRADE MOISTURE DURING CONSTRUCTION PRIOR TO PLACING THE INTERIOR SLAB.
- COMPACT BACKFILL FOR UTILITY LINES TO THE DENSITY REQUIREMENTS FOR SELECT FILL SPECIFICATIONS IN THE GEOTECHNICAL REPORT.

CONCRETE NOTES:

- CONCRETE CONSTRUCTION SHALL BE IN ACCORDANCE WITH THE AMERICAN CONCRETE INSTITUTE "BUILDING CODE REQUIREMENTS FOR REINFORCED CONCRETE," ACI 318.
- PROPORTIONING OF CONCRETE SHALL BE IN ACCORDANCE WITH THE AMERICAN CONCRETE INSTITUTE "STANDARD SPECIFICATION FOR STRUCTURAL CONCRETE," ACI 301.
- DETAILING, FABRICATION AND ERECTION OF REINFORCING STEEL BARS SHALL COMPLY WITH THE ACI "MANUAL OF STANDARD PRACTICE FOR DETAILING REINFORCED CONCRETE STRUCTURES," ACI 315.
- CONCRETE SHALL HAVE THE FOLLOWING MINIMUM COMPRESSIVE STRENGTH AT 28 DAYS:
DRILLED SHAFT FOUNDATIONS _____ 3000 PSI
SLAB-ON-GRADE _____ 3000 PSI
PIER CAPS _____ 3000 PSI
BEAMS _____ 3000 PSI

CONCRETE SLUMPS SHALL BE AS FOLLOWS:

	MAX	MIN
DRILLED SHAFTS	5"	3"
SLAB-ON-GRADE	5"	3"
PIER CAPS	5"	3"
BEAMS	5"	3"

MAXIMUM AGGREGATE SIZE SHALL BE AS FOLLOWS:

DRILLED SHAFTS	1 1/2 INCH
SLAB-ON-GRADE	1 1/2 INCH
PIER CAPS	1 1/2 INCH
BEAMS	1 1/2 INCH

- DEFORMED STEEL REINFORCING BARS SHALL CONFORM TO ASTM A615 GRADE 40 FOR #3 BARS, GRADE 60 FOR ALL OTHERS.
- LAP ALL CONTINUOUS REINFORCING BARS 30 BAR DIAMETERS UNLESS NOTED OTHERWISE. LAP BOTTOM BARS AT SUPPORTS AND TOP BARS AT MIDSPAN BETWEEN SUPPORTS UNLESS NOTED OTHERWISE.
- SEE ARCHITECTURAL DRAWINGS FOR FINISH REQUIREMENTS FOR ALL EXPOSED CONCRETE.
- CONSTRUCTION JOINTS SHALL BE DETAILED AND LOCATED AS SHOWN ON THE DRAWINGS. NO OTHER CONSTRUCTION JOINTS SHALL BE PLACED WITHOUT THE APPROVAL OF THE ENGINEER.
- SUBMIT DESIGN MIX AND TEST DATA ON THE PROPOSED DESIGN MIX FOR EACH TYPE AND STRENGTH OF CONCRETE IN THE PROJECT TO THE OWNER, ARCHITECT AND STRUCTURAL ENGINEER FOR APPROVAL SEVEN DAYS PRIOR TO PLACEMENT.
- TESTING AND SUBMITTALS
 - SHOP DRAWINGS SHOWING REINFORCEMENT FABRICATION, BAR PLACEMENT LOCATION, SPICES, SPACING AND BAR DESIGNATION, BAR TYPE, LENGTH, SIZE, BENDING, NUMBER OF BARS, DIMENSIONS AND ANY OTHER PERTINENT INFORMATION. SHOP DRAWINGS SHALL CONTAIN SUFFICIENT DETAIL TO PERMIT PLACEMENT OF REINFORCING WITHOUT THE USE OF THE DESIGN DRAWINGS. DO NOT BEGIN FABRICATION OF REINFORCING STEEL UNTIL AFTER SHOP DRAWINGS HAVE BEEN APPROVED BY THE ENGINEER.
 - THE OWNER SHALL SECURE THE SERVICES OF A COMMERCIAL TESTING LABORATORY TO PERFORM THE FOLLOWING QUALITY ASSURANCE FUNCTIONS:
 - OBTAIN SAMPLES FROM EVERY 100 CUBIC YARDS OF CONCRETE (OR PORTION THEREOF)
 - MOLD THREE CYLINDERS FROM EACH SAMPLE AND CURE PER ASTM C31. TEST ONE SPECIMIN AT 7 DAYS AND TWO AT 28 DAYS. FORWARD TEST REPORTS TO THE ENGINEER FOR REVIEW. PREPARE ONE ADDITIONAL CYLINDER DURING HOT OR COLD WEATHER CONCRETING TO BE CURED ON THE JOB SITE UNDER THE SAME CONDITIONS AS THE CONCRETE IT REPRESENTS.
 - PERFORM ONE SLUMP TEST FOR EACH SET OF CYLINDERS TAKEN.
 - PERFORM ONE TEST FOR AIR ENTRAINMENT IN CONCRETE AT LEAST ONCE DURING EACH DAY IN WHICH CONCRETE IS PLACED.
 - NORMAL WEIGHT CONCRETE SHALL WEIGH NO MORE THAN 160 POUNDS PER CUBIC FOOT. LIGHTWEIGHT CONCRETE SHALL WEIGH NO MORE THAN 120 POUNDS PER CUBIC FOOT.
 - MAKE CONSTRUCTION JOINTS ONLY AT LOCATIONS SHOWN ON THE CONTRACT DRAWINGS. THE REVIEWED SHOP DRAWINGS OR AS DIRECTED OR APPROVED BY THE ENGINEER. ANY ADDITIONAL CONSTRUCTION JOINTS OR RELOCATION OF CONSTRUCTION JOINTS SHOWN ON THE DRAWINGS, PROPOSED BY THE CONTRACTOR, MUST BE SUBMITTED TO THE ENGINEER FOR REVIEW.

PRE-ENGINEERED BUILDING NOTES:

- PRE-ENGINEERED BUILDING SHALL BE DESIGNED, FABRICATED AND ERECTED BY A MANUFACTURER WITH A MINIMUM OF 5 YEARS EXPERIENCE WITH PROJECTS THE SIZE AND COMPLEXITY OF THIS PROJECT.
- THE BUILDING MANUFACTURER SHALL SUPPLY ERECTION DRAWINGS SEALED BY AN ENGINEER CURRENTLY REGISTERED IN THE STATE OF TEXAS.
- THE BUILDING MANUFACTURER SHALL SUPPLY FRAME REACTIONS TO CONRAD ENGINEERING FOR USE IN THE DESIGN OF THE BUILDING FOUNDATION.
- CONRAD ENGINEERING IS THE STRUCTURAL ENGINEER OF RECORD FOR THE BUILDING FOUNDATION ONLY. CONRAD ENGINEERING IS NOT THE ENGINEER OF RECORD FOR THE DESIGN, FABRICATION OR ERECTION OF THE PRE-ENGINEERED BUILDING. RESPONSIBILITY FOR THE STRUCTURAL PERFORMANCE OF THE PRE-ENGINEERED BUILDING FRAME AND THE COMPONENTS SHALL BE THE SOLE RESPONSIBILITY OF THE ENGINEER WHOSE SEAL APPEARS ON THE PRE-ENGINEERED BUILDING DRAWINGS.
- ANCHOR BOLTS SHALL BE PROVIDED BY THE PRE-ENGINEERED BUILDING MANUFACTURER FOR INSTALLATION BY THE GENERAL CONTRACTOR.
- WHERE PRE-ENGINEERED BUILDING FRAMES SUPPORT MASONRY WALLS, MANUFACTURER SHALL LIMIT DEFLECTION DUE TO WIND TO 1/480 OF THE EAVE HEIGHT OR ONE INCH, WHICHEVER IS LESS.

CONCRETE MASONRY UNIT NOTES

- CONCRETE MASONRY UNIT CONSTRUCTION SHALL CONFORM TO THE PROVISIONS OF THE UNIFORM BUILDING CODE.
- CONCRETE MASONRY UNITS SHALL CONFORM TO ASTM C90, STANDARD SPECIFICATION FOR HOLLOW LOAD-BEARING CONCRETE MASONRY UNITS, GRADE N.
- CONCRETE MASONRY UNITS SHALL BE "NORMAL WEIGHT" WITH A MAXIMUM DENSITY OF 125 POUNDS PER CUBIC FOOT AND SHALL HAVE A MINIMUM COMPRESSIVE STRENGTH ON THE AVERAGE GROSS AREA OF 1000 PSI
- DESIGN OF CONCRETE MASONRY UNIT WALLS IS BASED ON THE FOLLOWING:

SPECIAL INSPECTION REQUIRED	NO
1/3 STRESS INCREASE FOR WIND LOAD	YES
ULTIMATE COMPRESSIVE STRENGTH	1500 PSI
ALLOWABLE AXIAL COMPRESSION	150 PSI
ALLOWABLE FLEXURAL COMPRESSION	250 PSI
ALLOWABLE SHEAR STRESS	25 PSI
MODULUS OF ELASTICITY	750,000 PSI
MODULAR RATIO	40
- DEFORMED STEEL REINFORCING BARS SHALL CONFORM TO ASTM A615, GRADE 60.
- JOINT REINFORCING SHALL BE TRUSS TYPE AND SHALL BE MANUFACTURED FROM 9 GAGE WIRE CONFORMING TO ASTM A82 FOR COLD DRAWN STEEL WIRE FOR CONCRETE REINFORCEMENT. MINIMUM EFFECTIVE STEEL AREA FOR AN 8 INCH WALL SHALL BE 0.048 SQUARE INCHES AND SPACING SHALL BE AS NOTED ON THE DRAWINGS. (DUR-O-WALL NO. 8 OR APPROVED EQUAL)
- GROUT FOR REINFORCED CONCRETE MASONRY UNITS SHALL CONFORM TO ASTM C476, GRADE PM AND SHALL ACHIEVE A MINIMUM COMPRESSIVE STRENGTH OF 2,500 POUNDS PER SQUARE INCH AT 28 DAYS.
- ALL GROUTING OF REINFORCED CELLS SHALL BE BY THE LOW-LIFT METHOD UNLESS NOTED OTHERWISE ON THE DRAWINGS. CENTER REINFORCING BARS IN CELL. PROVIDE MINIMUM 40 DIAMETER LAP AT ALL SPLICES.
- PROVIDE REINFORCING IN CMU ACCORDING TO THE DRAWINGS.



ABBREVIATIONS:

THE FOLLOWING ABBREVIATIONS ARE USED ON THE STRUCTURAL DRAWINGS:

ABBREVIATION	MEANING
A.F.F.	ABOVE FINISHED FLOOR
B.O.	BOTTOM OF
CMU	CONCRETE MASONRY UNIT
DIAM	DIAMETER
EL	ELEVATION
GA	GAUGE
GL	GLUE LAMINATED
HORIZ	HORIZONTAL
I.S.F.	INSIDE FACE
MFR	MANUFACTURER
O.C.	ON CENTER
O.C.E.W.	ON CENTER EACH WAY
O.H.	OPPOSITE HAND
O.S.F.	OUTSIDE FACE
RCP	REINFORCED CONCRETE PIPE
SM	SIMILAR
STD	STANDARD
T.O.	TOP OF
TS	TUBULAR STEEL
TYP.	TYPICAL
U.N.O.	UNLESS NOTED OTHERWISE
VERT	VERTICAL
W	WIDE FLANGE
WWF	WELDED WIRE FABRIC

AN AUTOMOTIVE DEALERSHIP
ROGER BEASLEY VOLVO

INTERSTATE HIGHWAY 35 SOUTH
GEORGETOWN, TEXAS

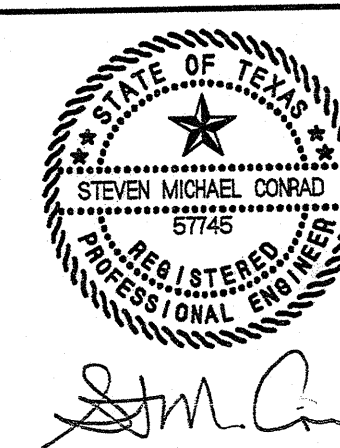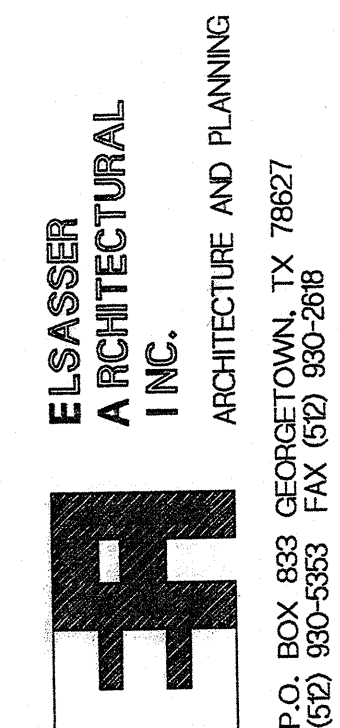

SEPTEMBER 23, 2002


DATE:
09/23/2002

REVISION DATE:

PROJECT NO.
02008

SHEET NO.


S1.0

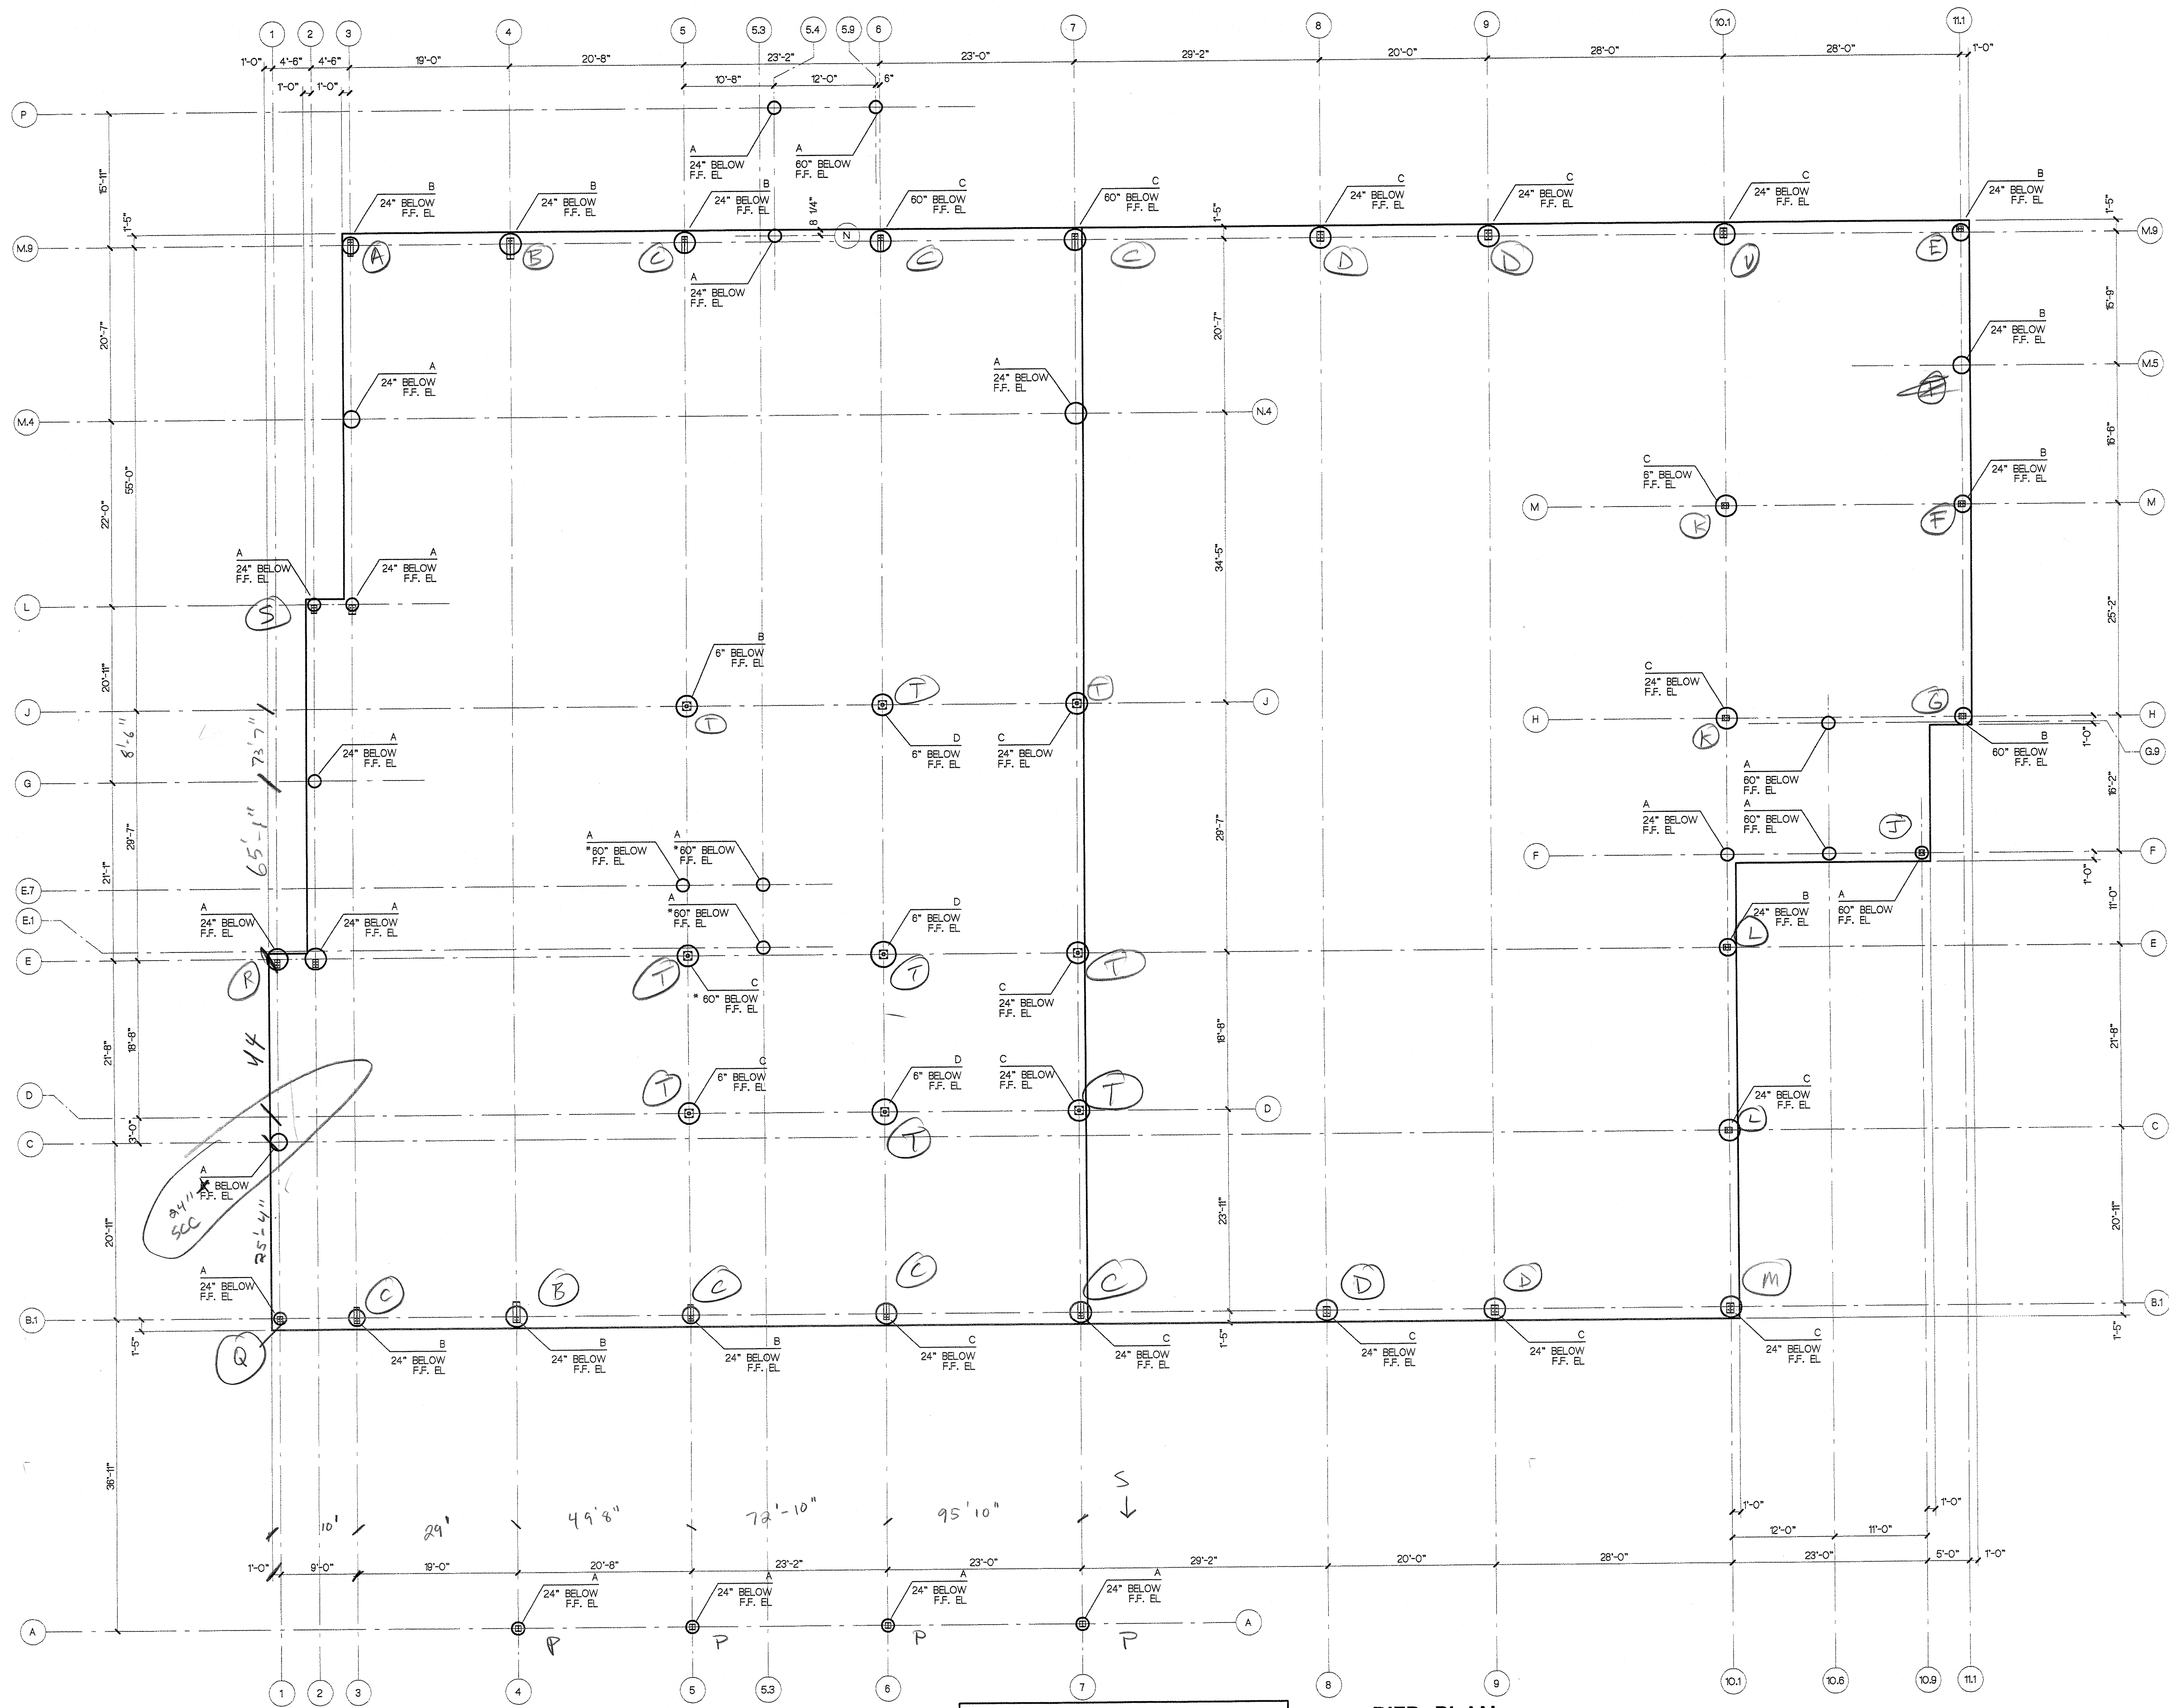

Pier Conc. 30' Depth

A	1.30 C.Y. - .065 C.Y. to 1.F.
B	2.32 C.Y. - .116 C.Y. to 1.F.
C	3.63 C.Y. - .181 C.Y. to 1.F.
D	5.23 C.Y. - .261 C.Y. to 1.F.

PIER SYMBOL

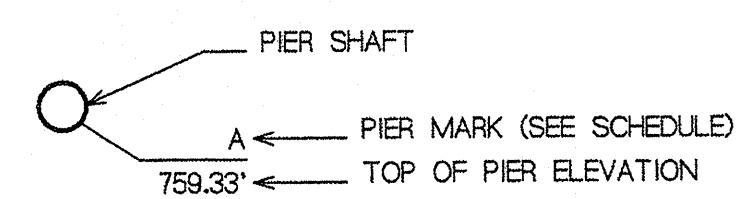

PIER SCHEDULE

MRK	PIER/PIER BELL DIAMETER	PIER REINFORCING VERTICAL	PIER REINFORCING TIES
A	18"	6 - #5	#3 @ 10" O.C.
B	24"	6 - #6	#3 @ 12" O.C.
C	30"	6 - #7	#3 @ 12" O.C.
D	36"	9 - #7	#3 @ 14" O.C.

PIER PLAN

SCALE: 1/8" = 1'-0"

PLAN NOTES

- SEE SHEET S1.0 FOR STRUCTURAL GENERAL NOTES.
- FINAL PIER SIZES AND LOCATIONS MUST BE BASED ON LOADS AND DRAWINGS PROVIDED BY PRE-ENGINEERED BUILDING MANUFACTURER. PRE-ENGINEERED BUILDING DRAWINGS NOT AVAILABLE AT THE TIME THESE DRAWINGS WERE ISSUED.
- ** TO PIER ELEVATION MAY CHANGE DEPENDING ON SUMP LOCATION. VERIFY SUMP LOCATION BEFORE PLACING PIER.


REVISIONS

NUMBER	DATE	DESCRIPTION
1	March 20, 2003	REVISED PIER LOCATIONS

AN AUTOMOTIVE DEALERSHIP
ROGER BEASLEY VOLVO

INTERSTATE HIGHWAY 35 SOUTH
GEORGETOWN, TEXAS

ELSASSER ARCHITECTURAL INC.
ARCHITECTURE AND PLANNING
P.O. BOX 583 GEORGETOWN, TX 78627
(512) 860-5833 FAX (512) 990-286

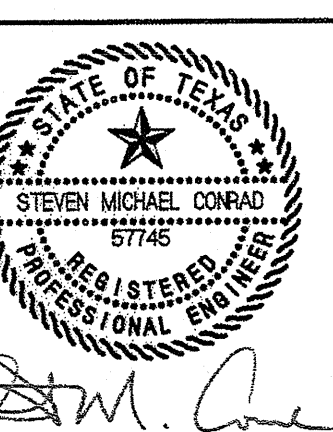

SEPTEMBER 23, 2002

DATE:
08/23/2002


REVISION DATE:
03/20/2003

PROJECT NO.
02008


SHEET NO.

\$2.0

PIER PLAN

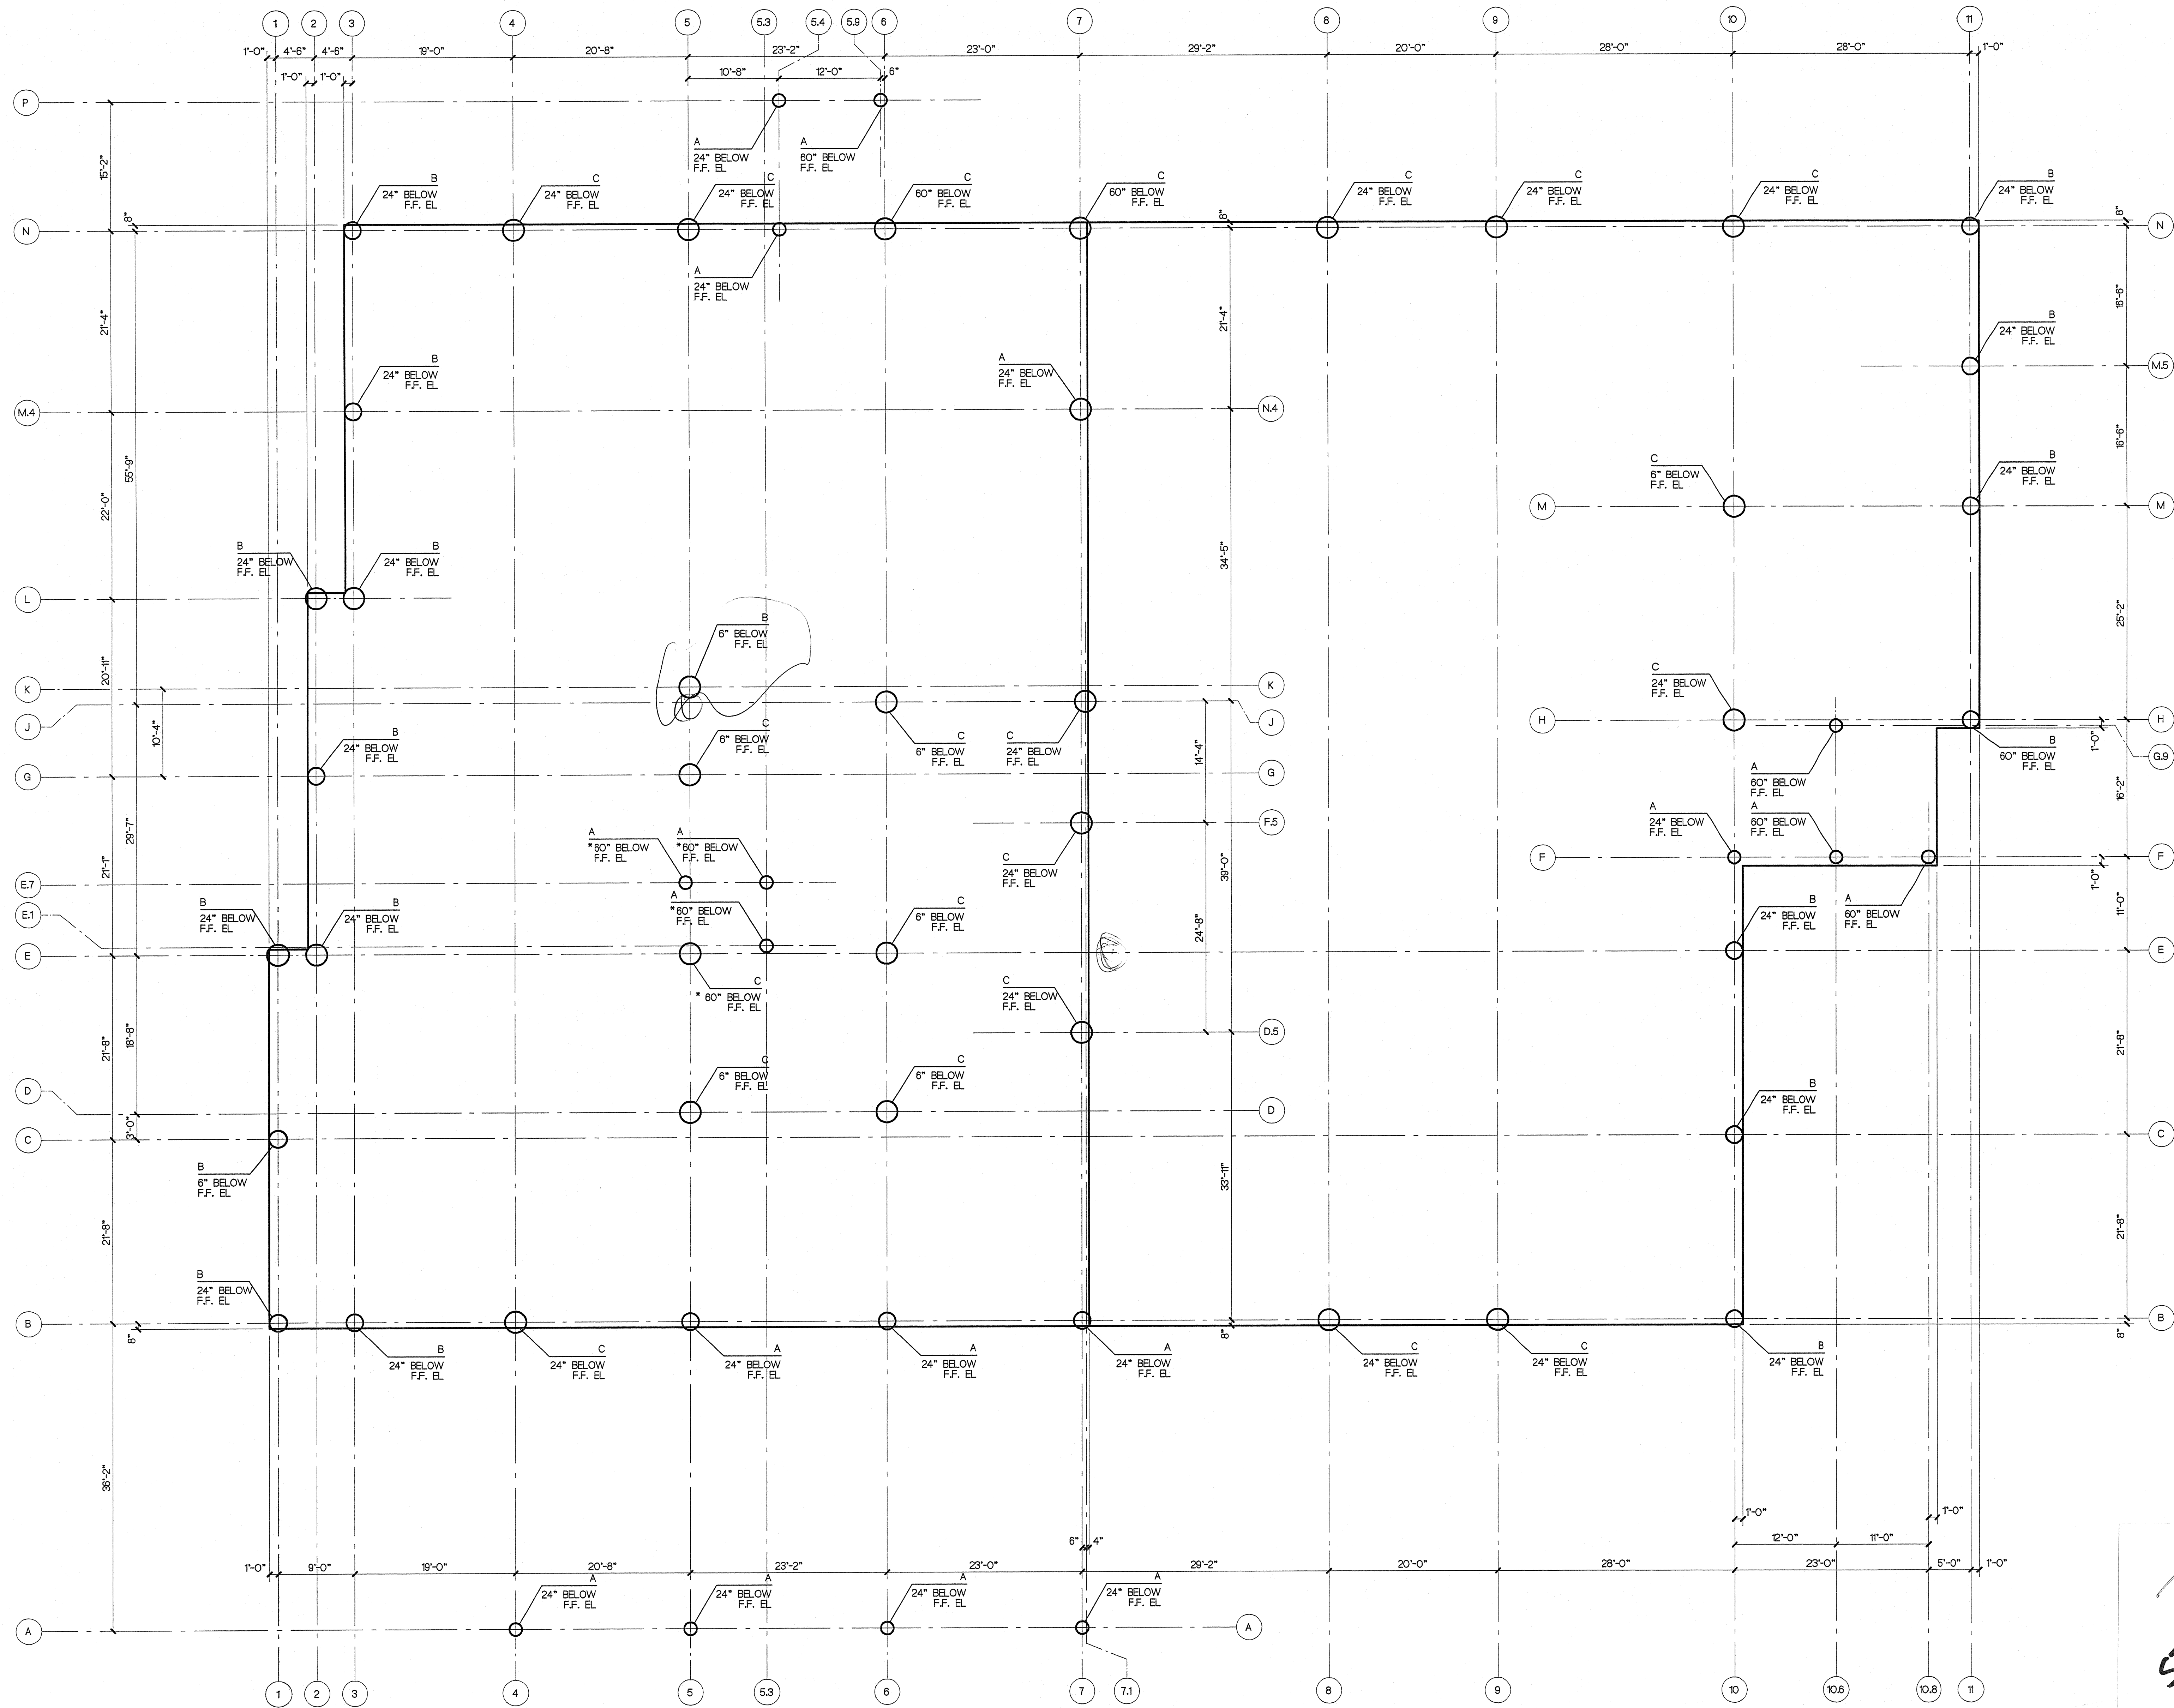

PIER SYMBOL

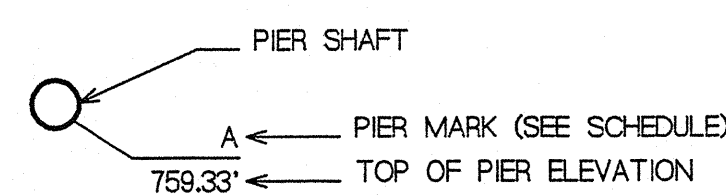

PIER SCHEDULE			
MRK	PIER/PIER BELL DIAMETER	PIER REINFORCING VERTICAL TIES	
A	18"	6 - #5	*3 @ 10" O.C.
B	24"	6 - #6	*3 @ 12" O.C.
C	30"	6 - #7	*3 @ 12" O.C.

PIER PLAN

SCALE: 1/8" = 1'-0"

PLAN NOTES


- SEE SHEET S1.0 FOR STRUCTURAL GENERAL NOTES.
- FINAL PIER SIZES AND LOCATIONS MUST BE BASED ON LOADS AND DRAWINGS PROVIDED BY PRE-ENGINEERED BUILDING MANUFACTURER. PRE-ENGINEERED BUILDING DRAWINGS NOT AVAILABLE AT THE TIME THESE DRAWINGS WERE ISSUED.
- * - T.O. PIER ELEVATION MAY CHANGE DEPENDING ON SUMP LOCATION. VERIFY SUMP LOCATION BEFORE PLACING PIER.

SEE REVISION


AN AUTOMOTIVE DEALERSHIP
ROGER BEASLEY VOLVO

INTERSTATE HIGHWAY 35 SOUTH
GEORGETOWN, TEXAS

ELSASSER
ARCHITECTURAL
INC.
ARCHITECTURE AND PLANNING
P.O. BOX 833 GEORGETOWN, TX 78627
(512) 860-5533 FAX (512) 860-2618

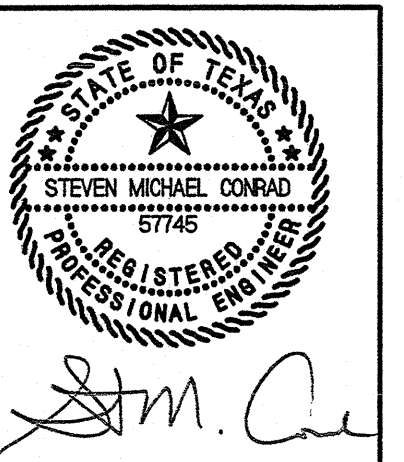

SEPTEMBER 23, 2002

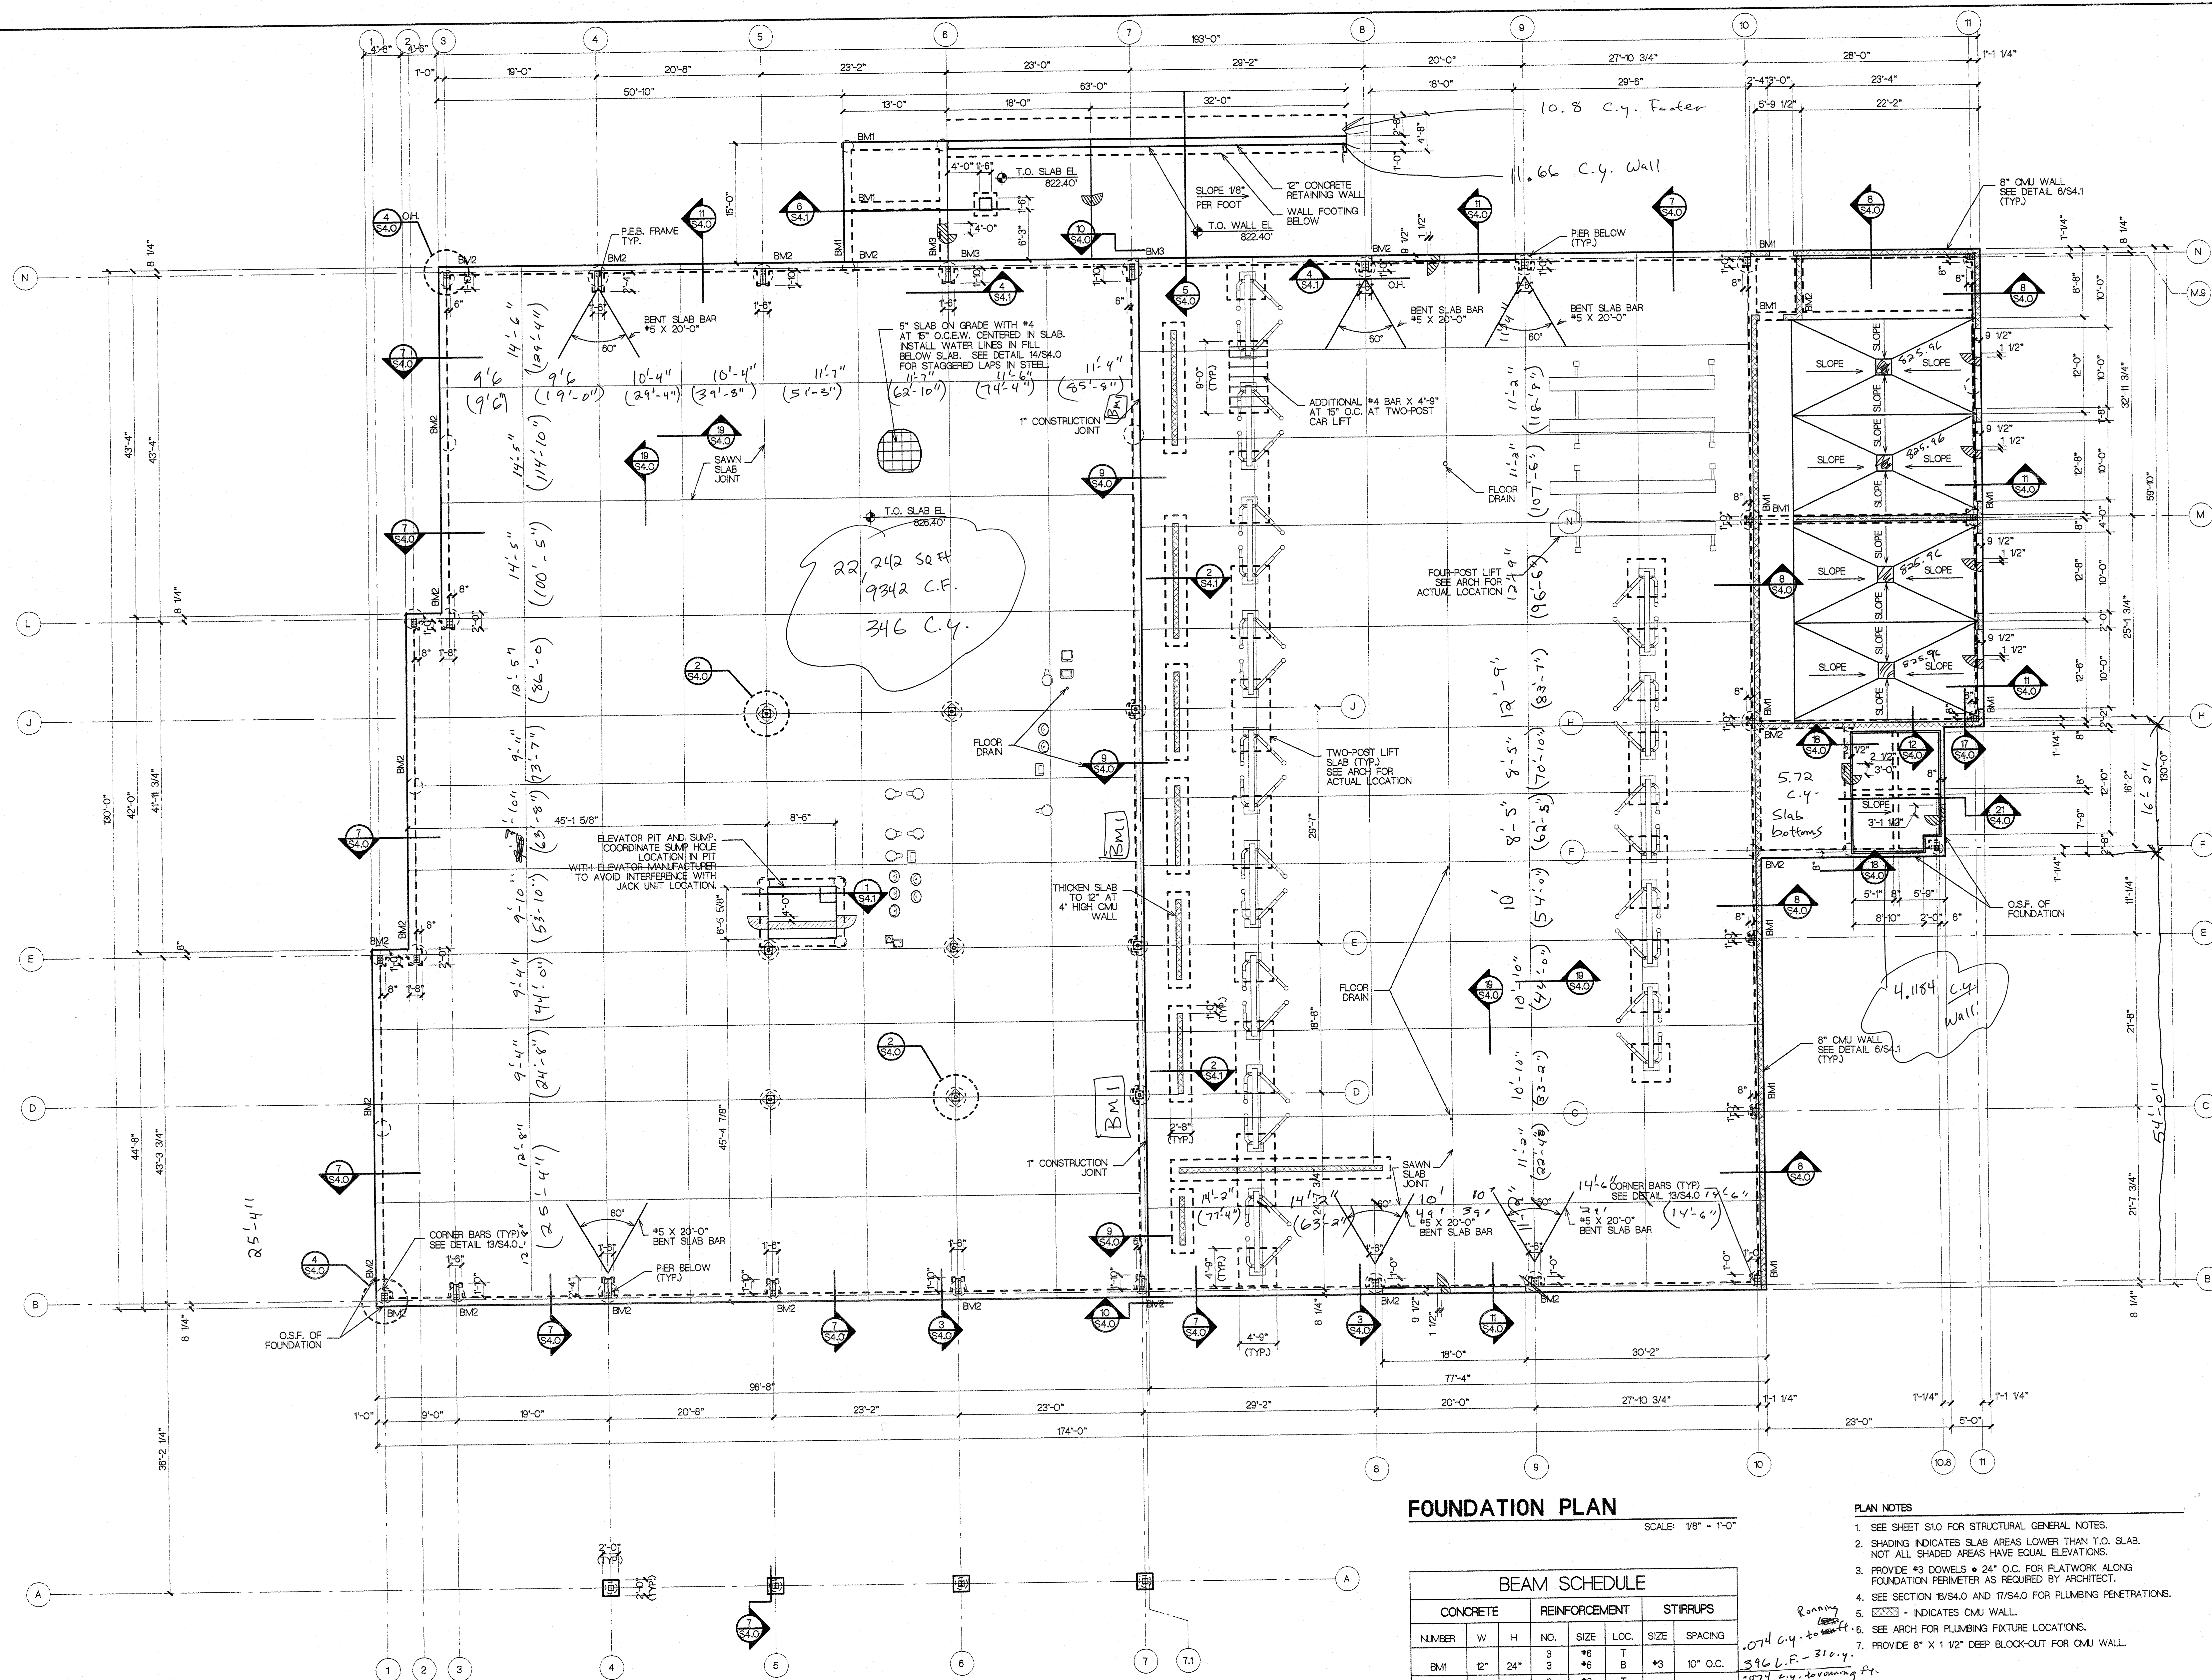

FOUNDATION PLAN

SCALE: 1/8" = 1'-0"

BEAM SCHEDULE									
CONCRETE			REINFORCEMENT			STIRRUPS			
NUMBER	W	H	NO.	SIZE	LOC.	SIZE	SPACING		
BM1	12"	24"	3	#6	T	#3	10" O.C.		
BM2	12"	24"	2	#6	T	#3	10" O.C.		
BM3	12"	60"	2	#6	T	#3	24" O.C.		

PLAN NOTES

- SEE SHEET S1.0 FOR STRUCTURAL GENERAL NOTES.
- SHADING INDICATES SLAB AREAS LOWER THAN T.O. SLAB. NOT ALL SHADING AREAS HAVE EQUAL ELEVATIONS.
- PROVIDE #3 DOWELS @ 24" O.C. FOR FLATWORK ALONG FOUNDATION PERIMETER AS REQUIRED BY ARCHITECT.
- SEE SECTION 16/S4.0 AND 17/S4.0 FOR PLUMBING PENETRATIONS.
- SEE ARCH FOR PLUMBING FIXTURE LOCATIONS.
- PROVIDE 8" X 1 1/2" DEEP BLOCK-OUT FOR CMU WALL.

REVISIONS

NUMBER	DATE	DESCRIPTION
1	March 20, 2003	REVISED FRAME LOCATIONS AND PIER CAPS

AN AUTOMOTIVE DEALERSHIP
ROGER BEASLEY VOLVO

INTERSTATE HIGHWAY 35 SOUTH
 GEORGETOWN, TEXAS

ELSASSER ARCHITECTURAL INC.
 ARCHITECTURE AND PLANNING
 P.O. BOX 183 GEORGETOWN, TX 78627
 (512) 860-5553 FAX (512) 860-2983

STEVEN MICHAEL CONRAD
 REGISTERED PROFESSIONAL ARCHITECT
 STATE OF TEXAS
 No. 14848

SEPTEMBER 23, 2002


DATE: 09/23/2002

REVISION DATE: 03/20/2003

PROJECT NO. 02008

SHEET NO.

S3.0
 FOUNDATION PLAN

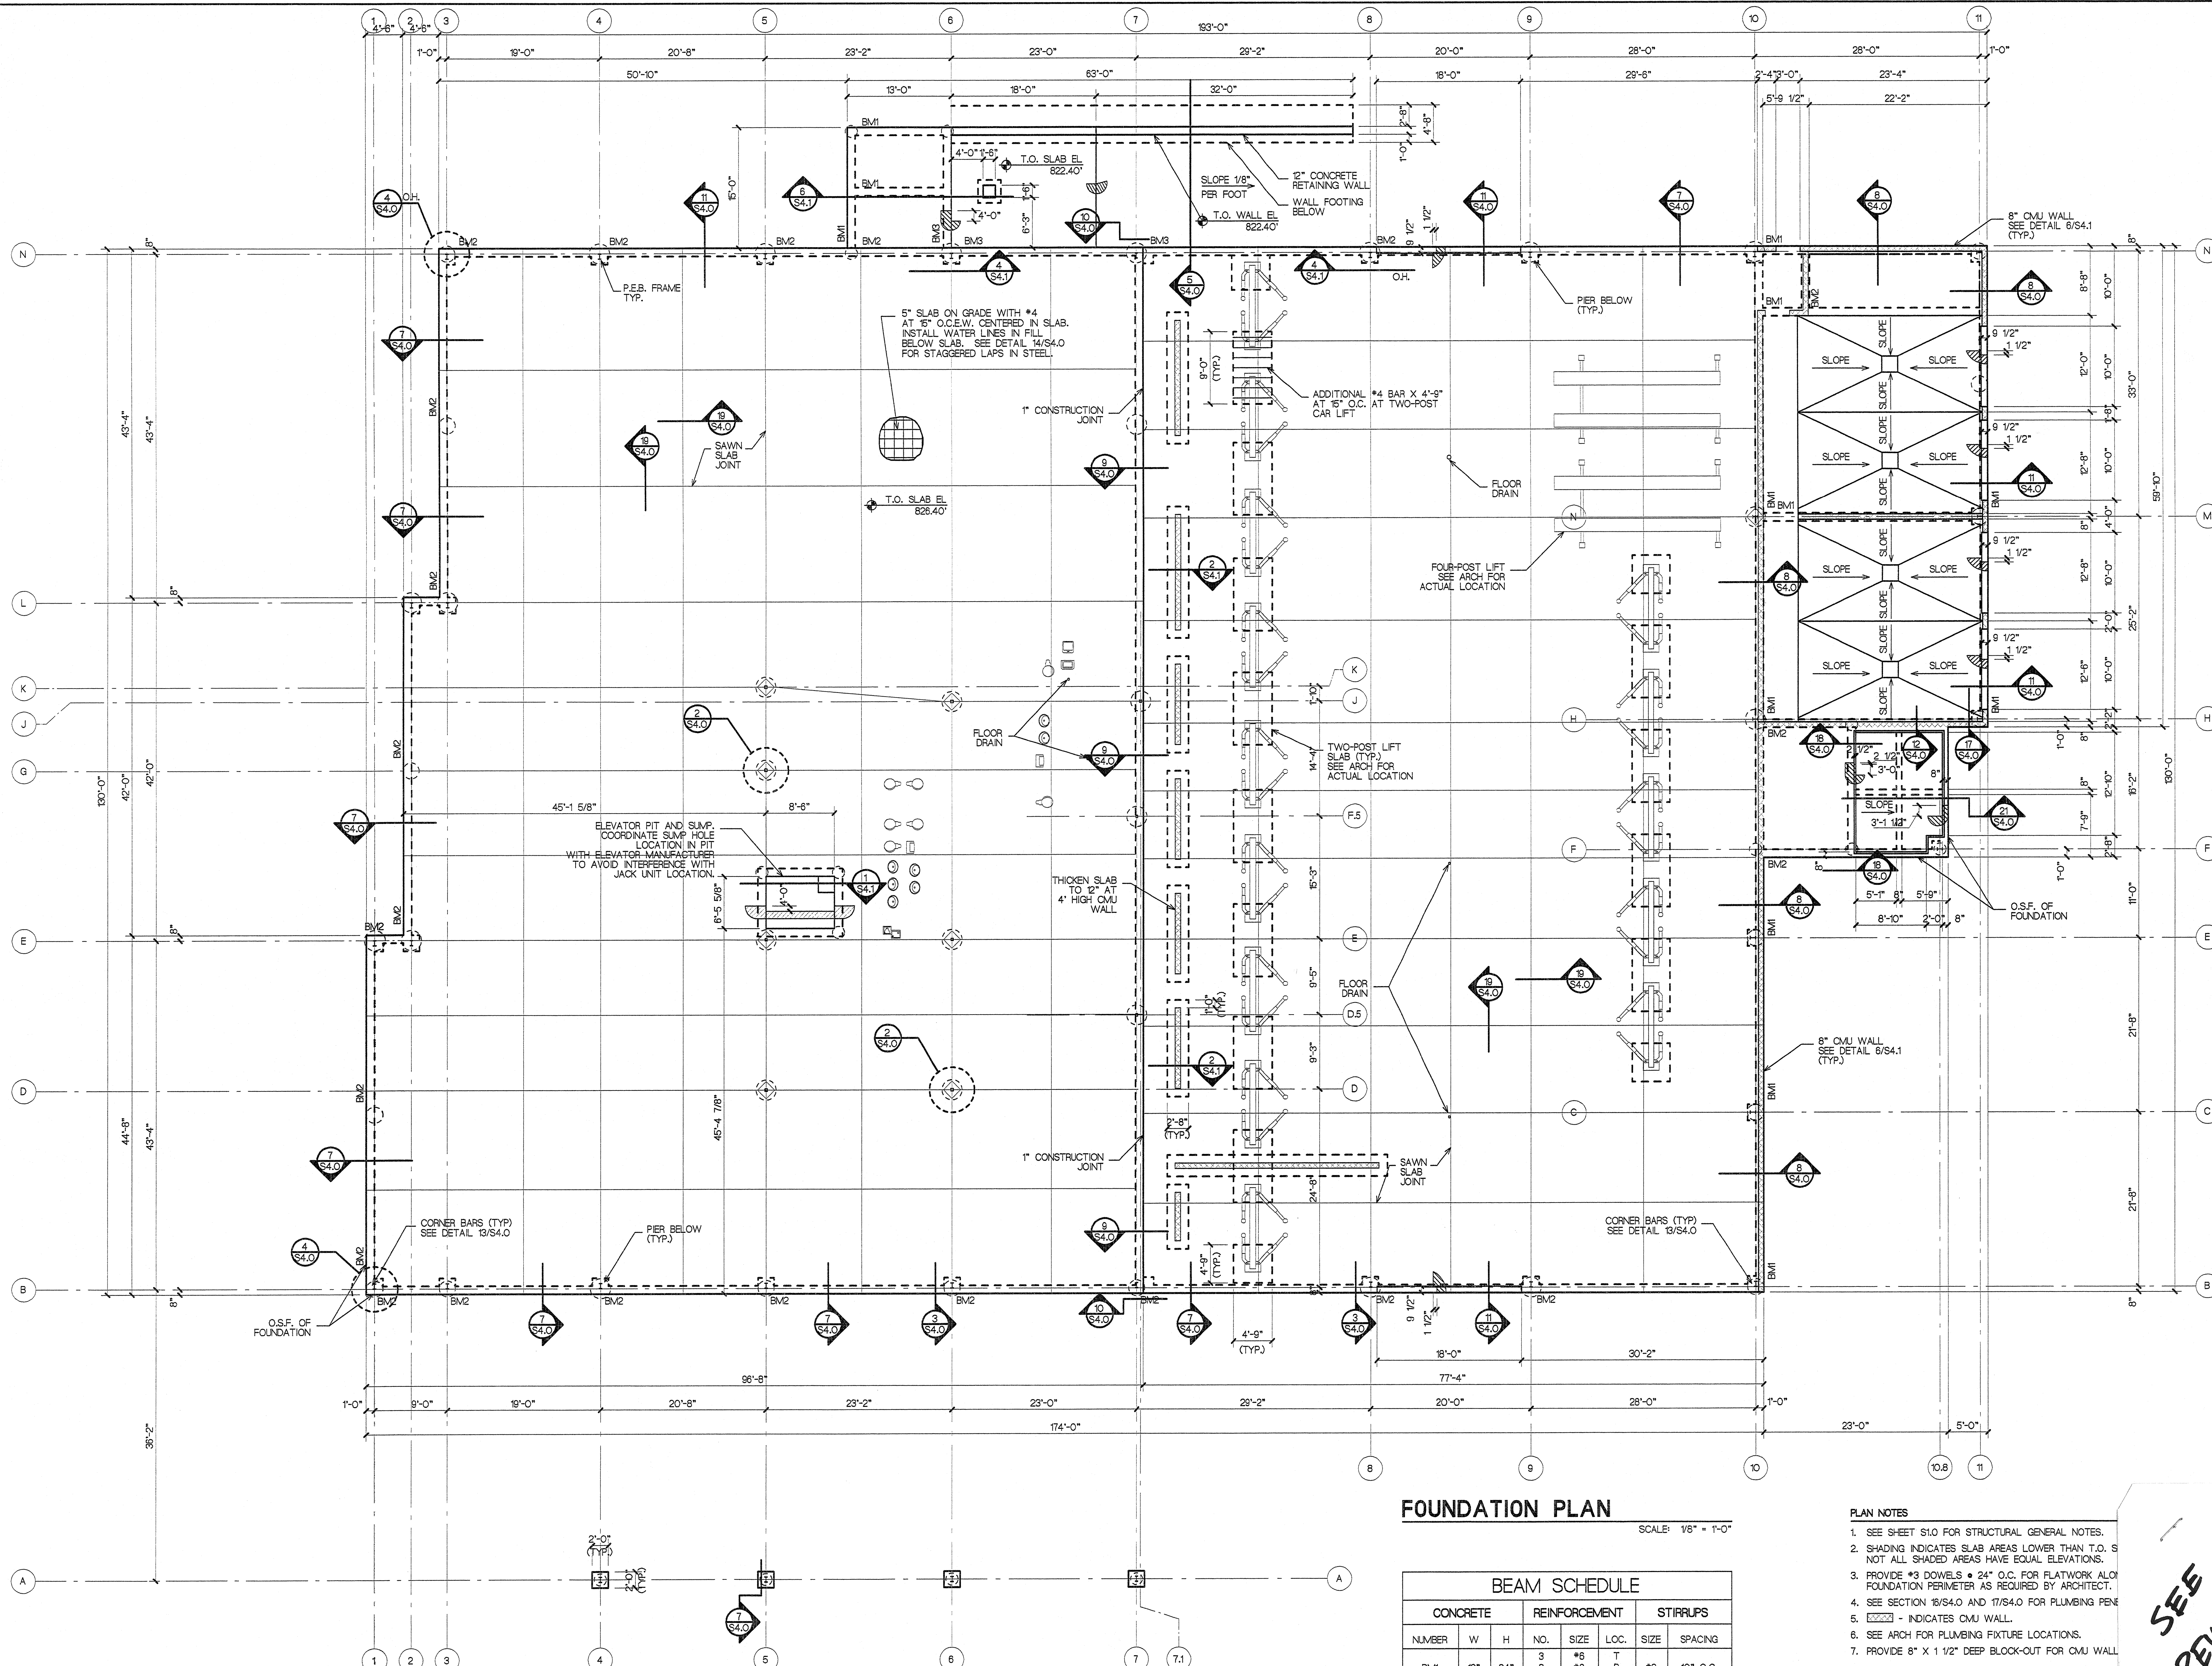

FOUNDATION PLAN

SCALE: 1/8" = 1'-0"

BEAM SCHEDULE							
CONCRETE			REINFORCEMENT			STIRRUPS	
NUMBER	W	H	NO.	SIZE	LOC.	SIZE	SPACING
BM1	12"	24"	3	#6	T B	#3	10" O.C.
BM2	12"	24"	2	#6	T B	#3	10" O.C.
BM3	12"	80"	2	#6	T B	#3	24" O.C.

PLAN NOTES

- SEE SHEET S1.0 FOR STRUCTURAL GENERAL NOTES.
- SHADING INDICATES SLAB AREAS LOWER THAN T.O. S NOT ALL SHADED AREAS HAVE EQUAL ELEVATIONS.
- PROVIDE #3 DOWELS • 24" O.C. FOR FLATWORK ALON FOUNDATION PERIMETER AS REQUIRED BY ARCHITECT.
- SEE SECTION 18/S4.0 AND 17/S4.0 FOR PLUMBING PENE.
- INDICATES CMU WALL.
- SEE ARCH FOR PLUMBING FIXTURE LOCATIONS.
- PROVIDE 8" X 1 1/2" DEEP BLOCK-OUT FOR CMU WALL.

SEE
REVISION


AN AUTOMOTIVE DEALERSHIP
ROGER BEASLEY VOLVO

INTERSTATE HIGHWAY 35 SOUTH
GEORGETOWN, TEXAS

ELSASSER
ARCHITECTURAL
INC.
ARCHITECTURE AND PLANNING
P.O. BOX 633 GEORGETOWN, TX 78627
(512) 860-3355 FAX (512) 860-3358

STATE OF TEXAS
REGISTERED PROFESSIONAL ENGINEER
STEVEN MICHAEL CONRAD
07746
Stm. Conrad

SEPTEMBER 23, 2002

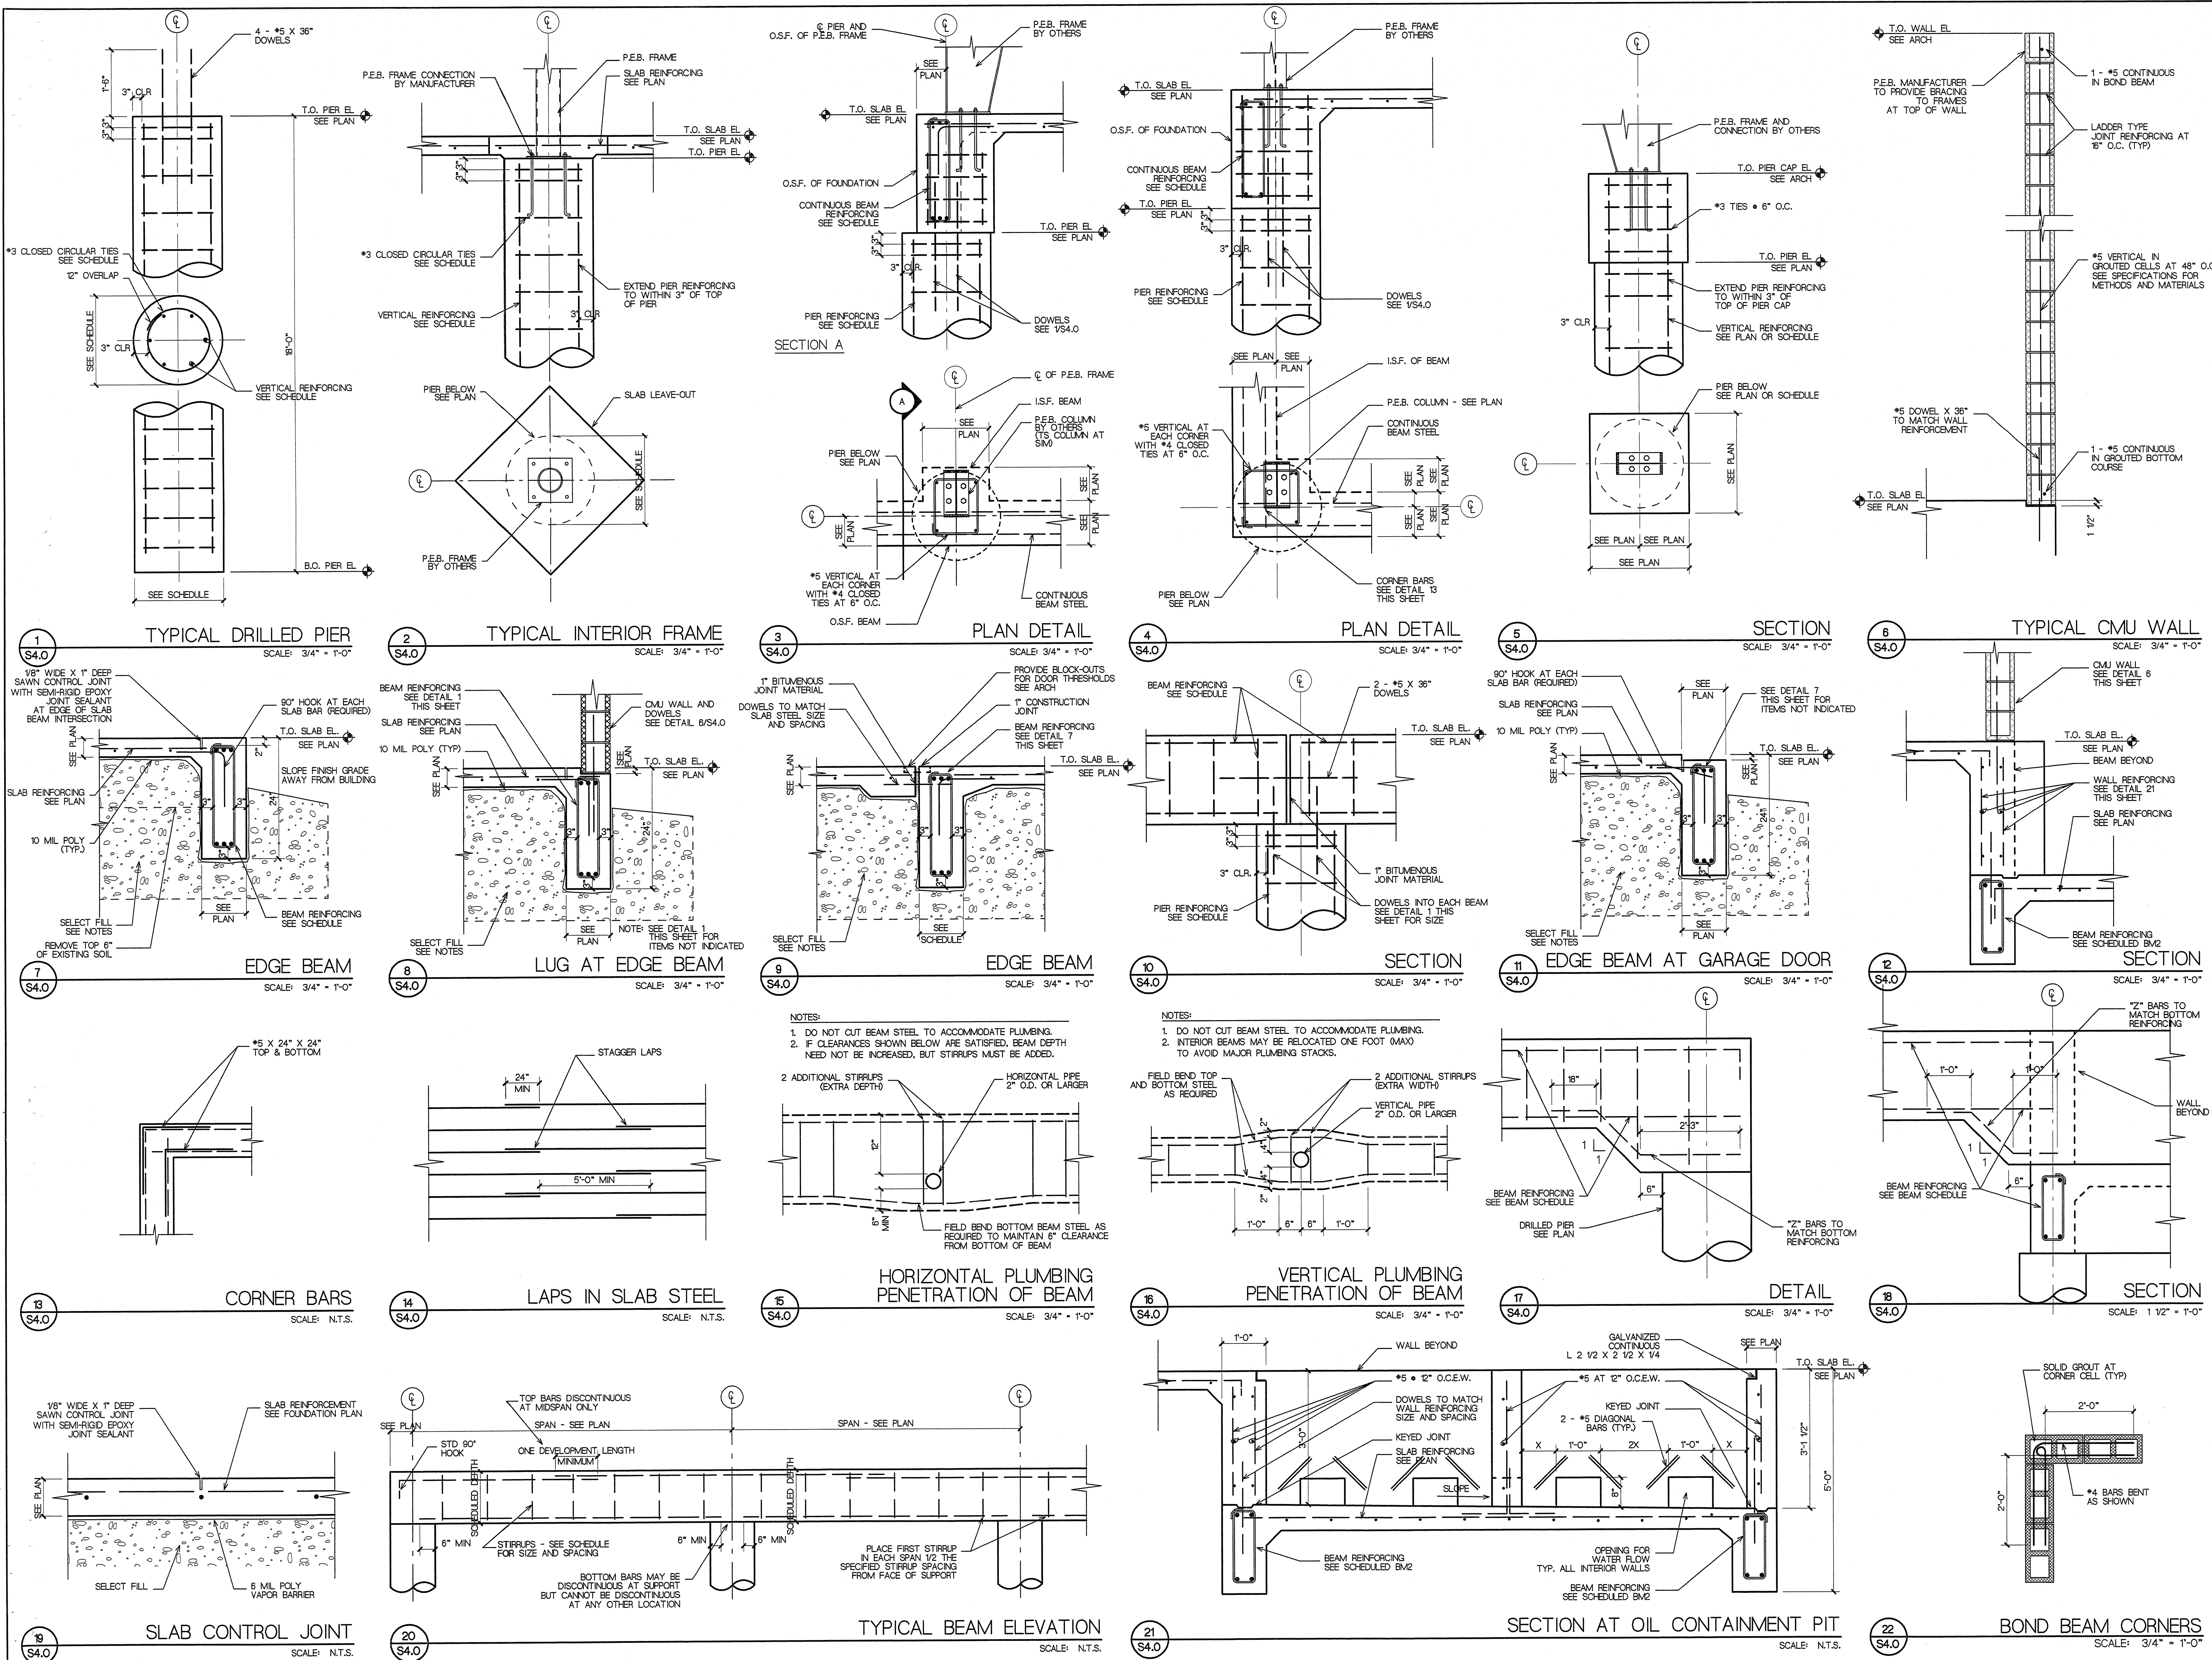

AN AUTOMOTIVE DEALERSHIP

ROGER BEASLEY VOLVO

INTERSTATE HIGHWAY 35 SOUTH
GEORGETOWN, TEXAS

ELSASSER
A ARCHITECTURAL
FIRM

ARCHITECTURE AND PLANNING
P.O. BOX 833 GEORGETOWN, TX 78627
(512) 980-5583

CONSULTANT SEAL:

SEPTEMBER 23, 2002


DATE: 09/23/02

REVISION DATE:

PROJECT NO. 02008

SHEET NO. **S4.0**

FOUNDATION DETAILS

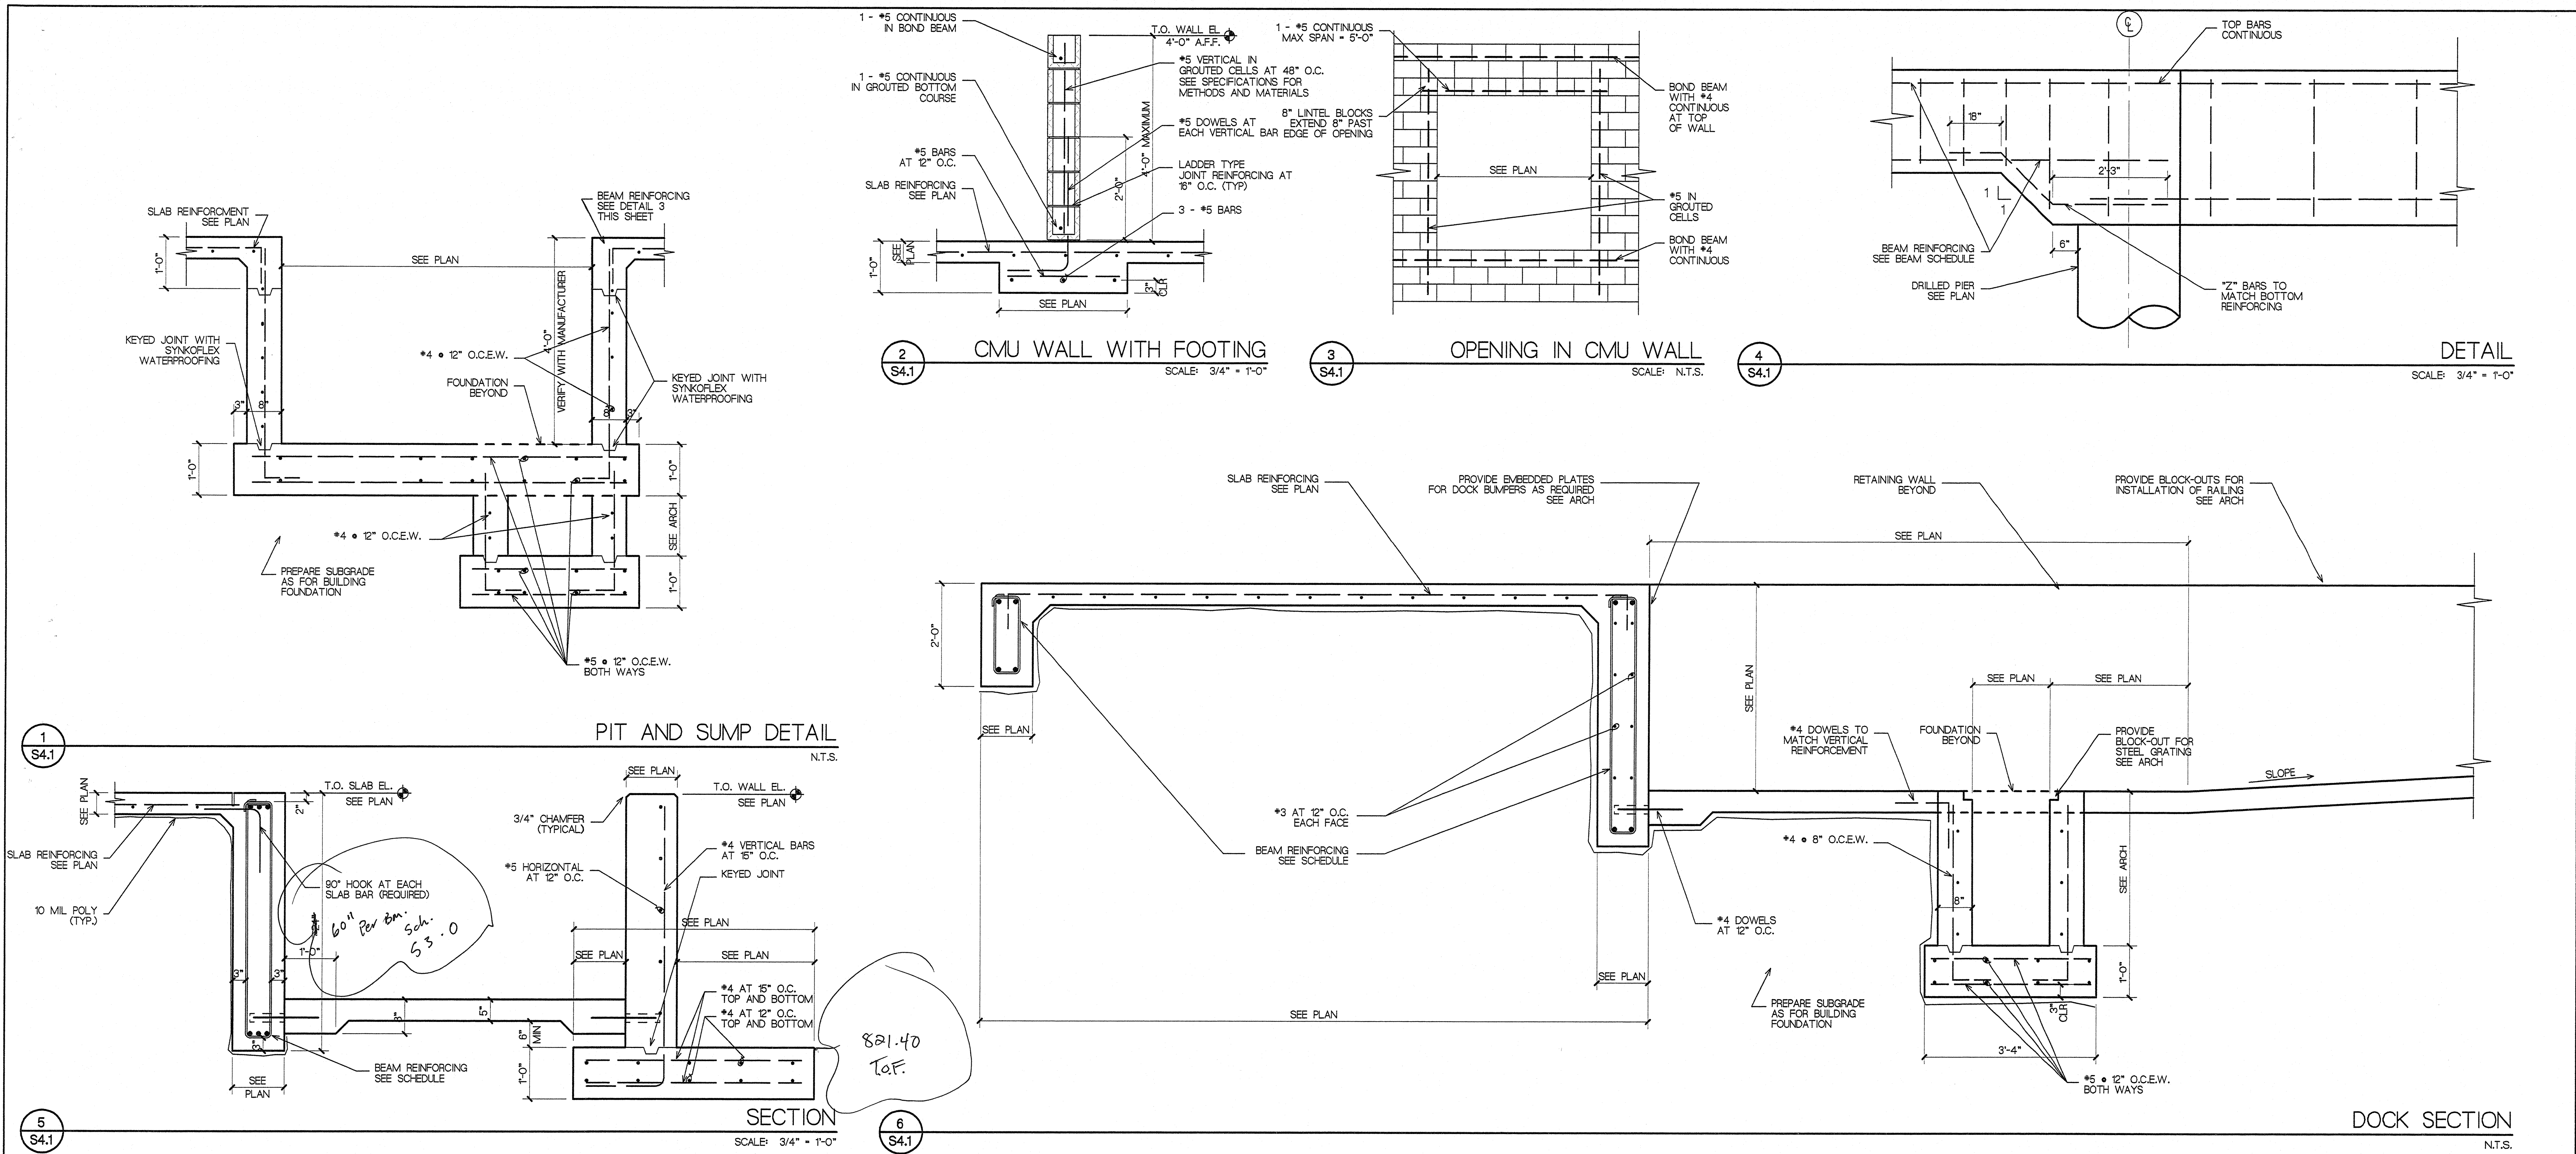

AN AUTOMOTIVE DEALERSHIP
ROGER BEASLEY VOLVO
 INTERSTATE HIGHWAY 35 SOUTH
 GEORGETOWN, TEXAS

ELSASSER ARCHITECTURAL INC.
 ARCHITECTURE AND PLANNING
 P.O. BOX 833 GEORGETOWN, TX 78627
 (512) 860-5583 FAX (512) 860-3888

CONSULTANT SEAL:

Steven Michael Conrad
 SEPTEMBER 23, 2002


DATE:
 09/23/02

REVISION DATE:


PROJECT NO.
 02008

SHEET NO.
S4.1


FOUNDATION DETAILS

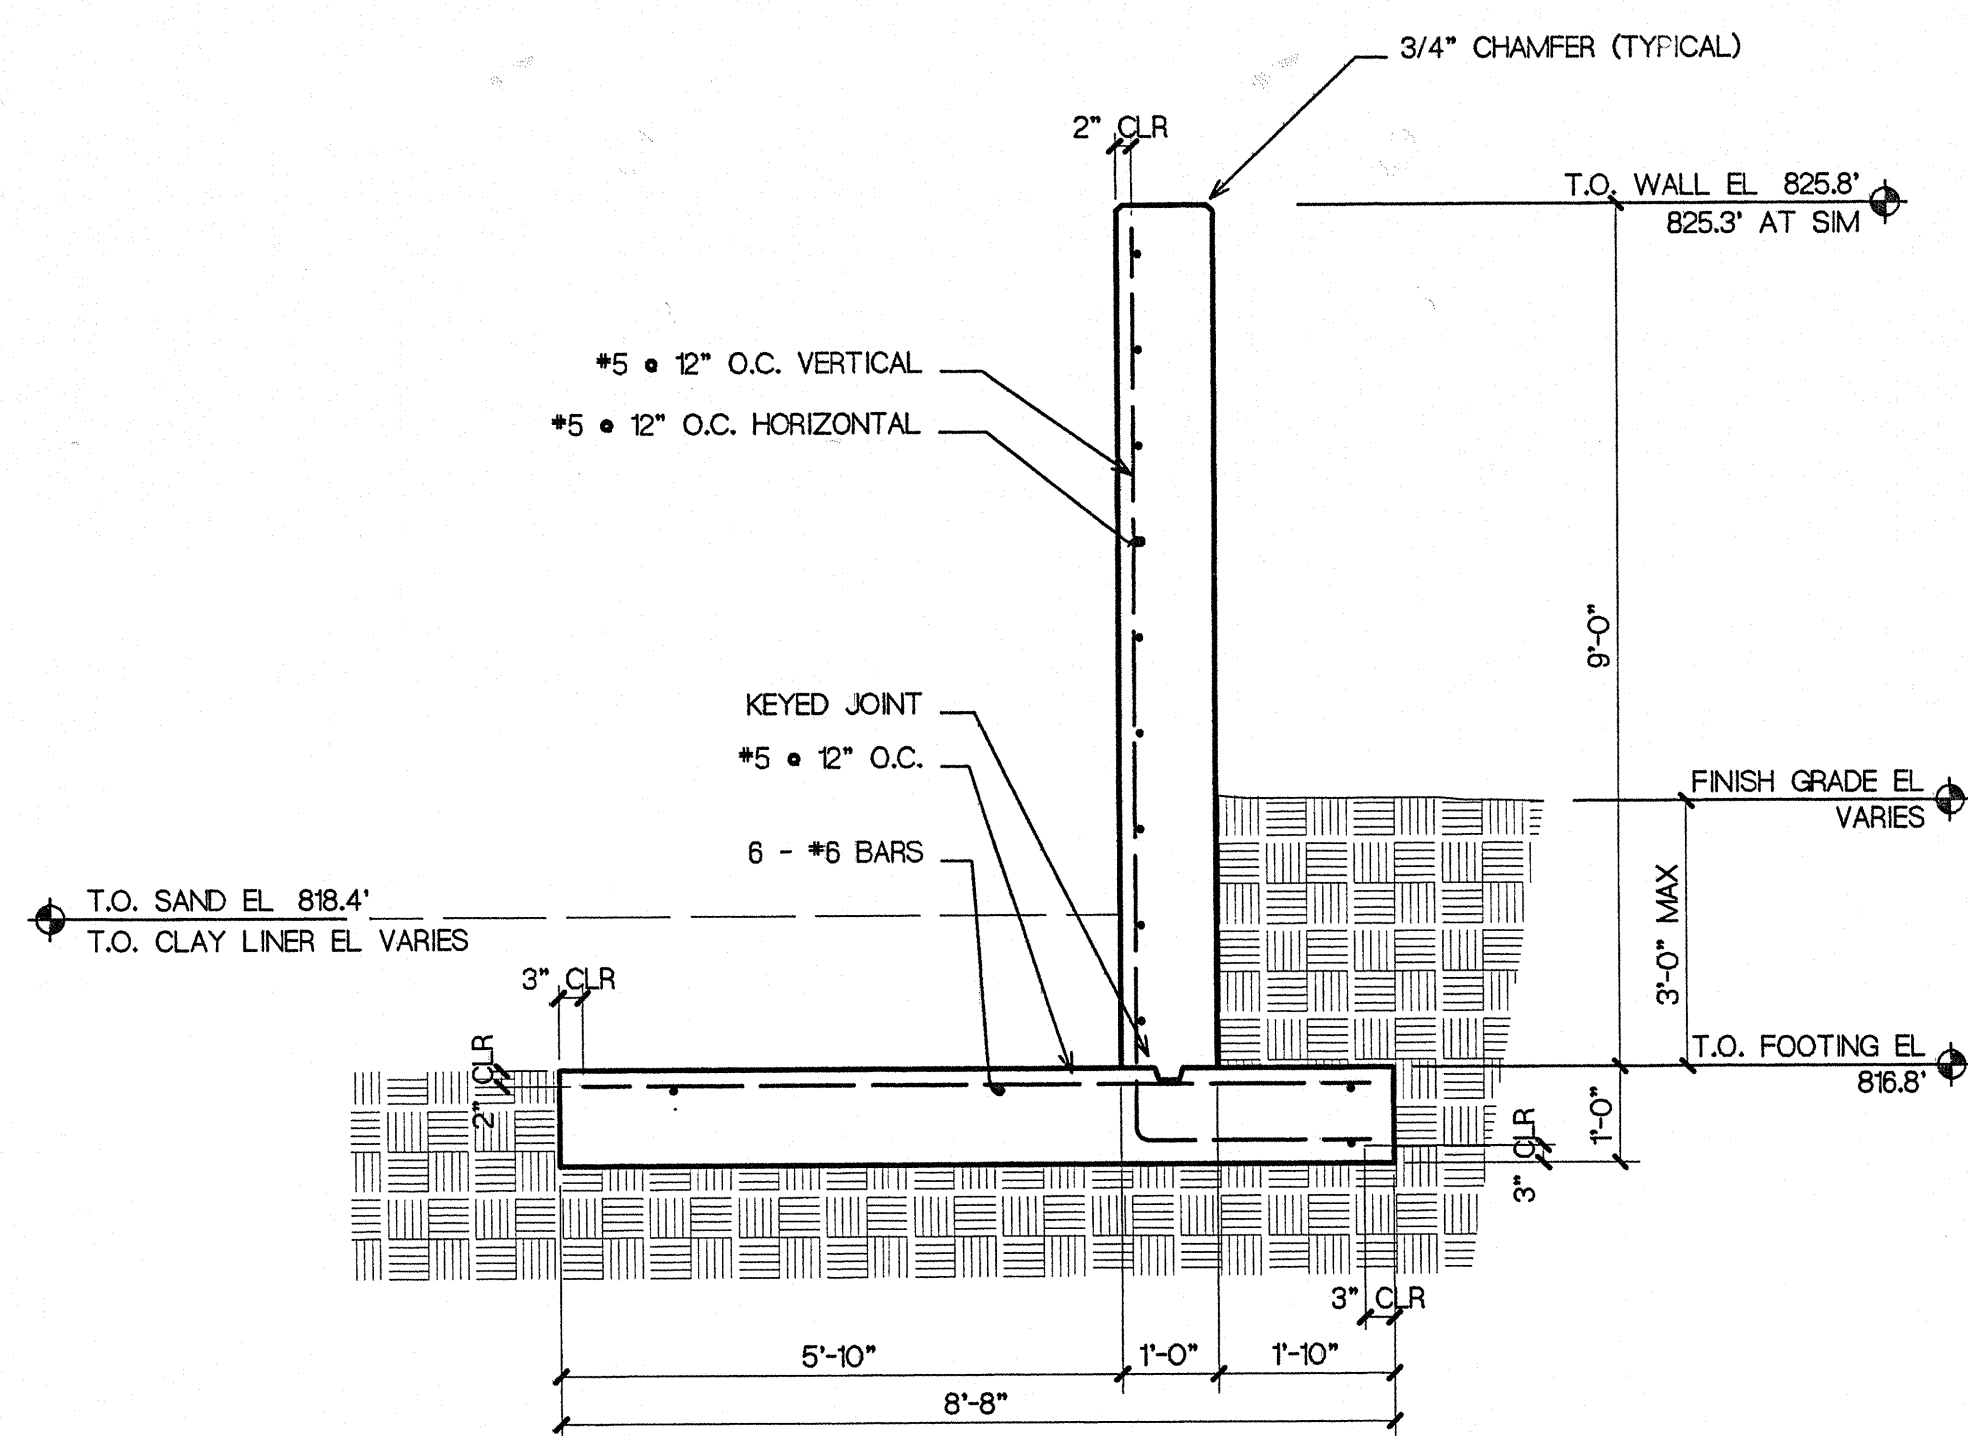


SECTION 1
SCALE: 3/4" = 1'-0"

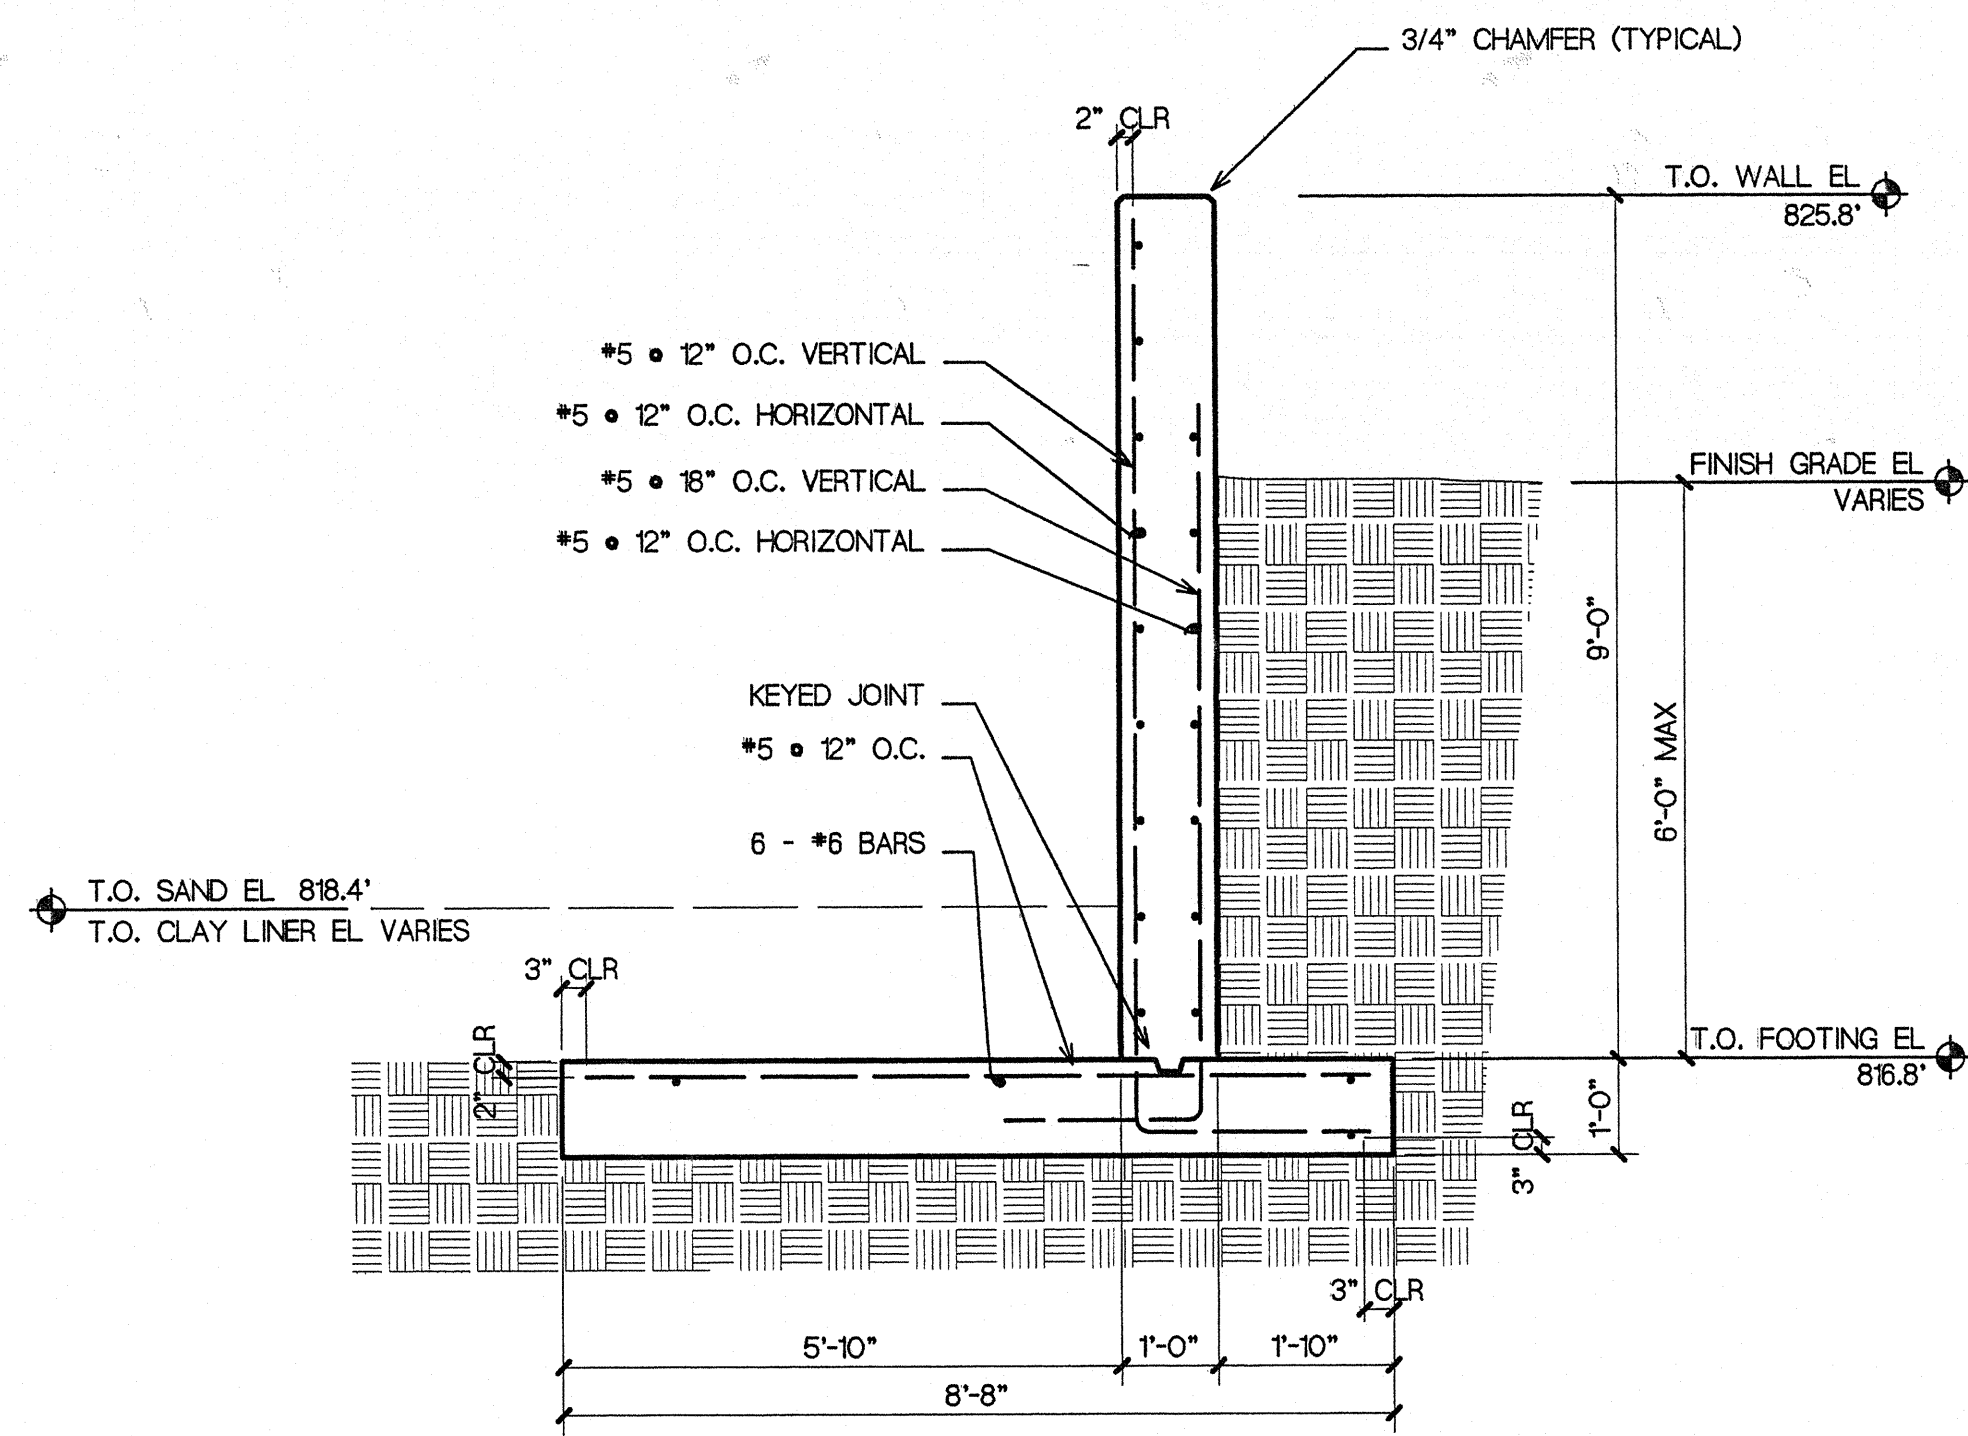


SECTION 2
SCALE: 3/4" = 1'-0"

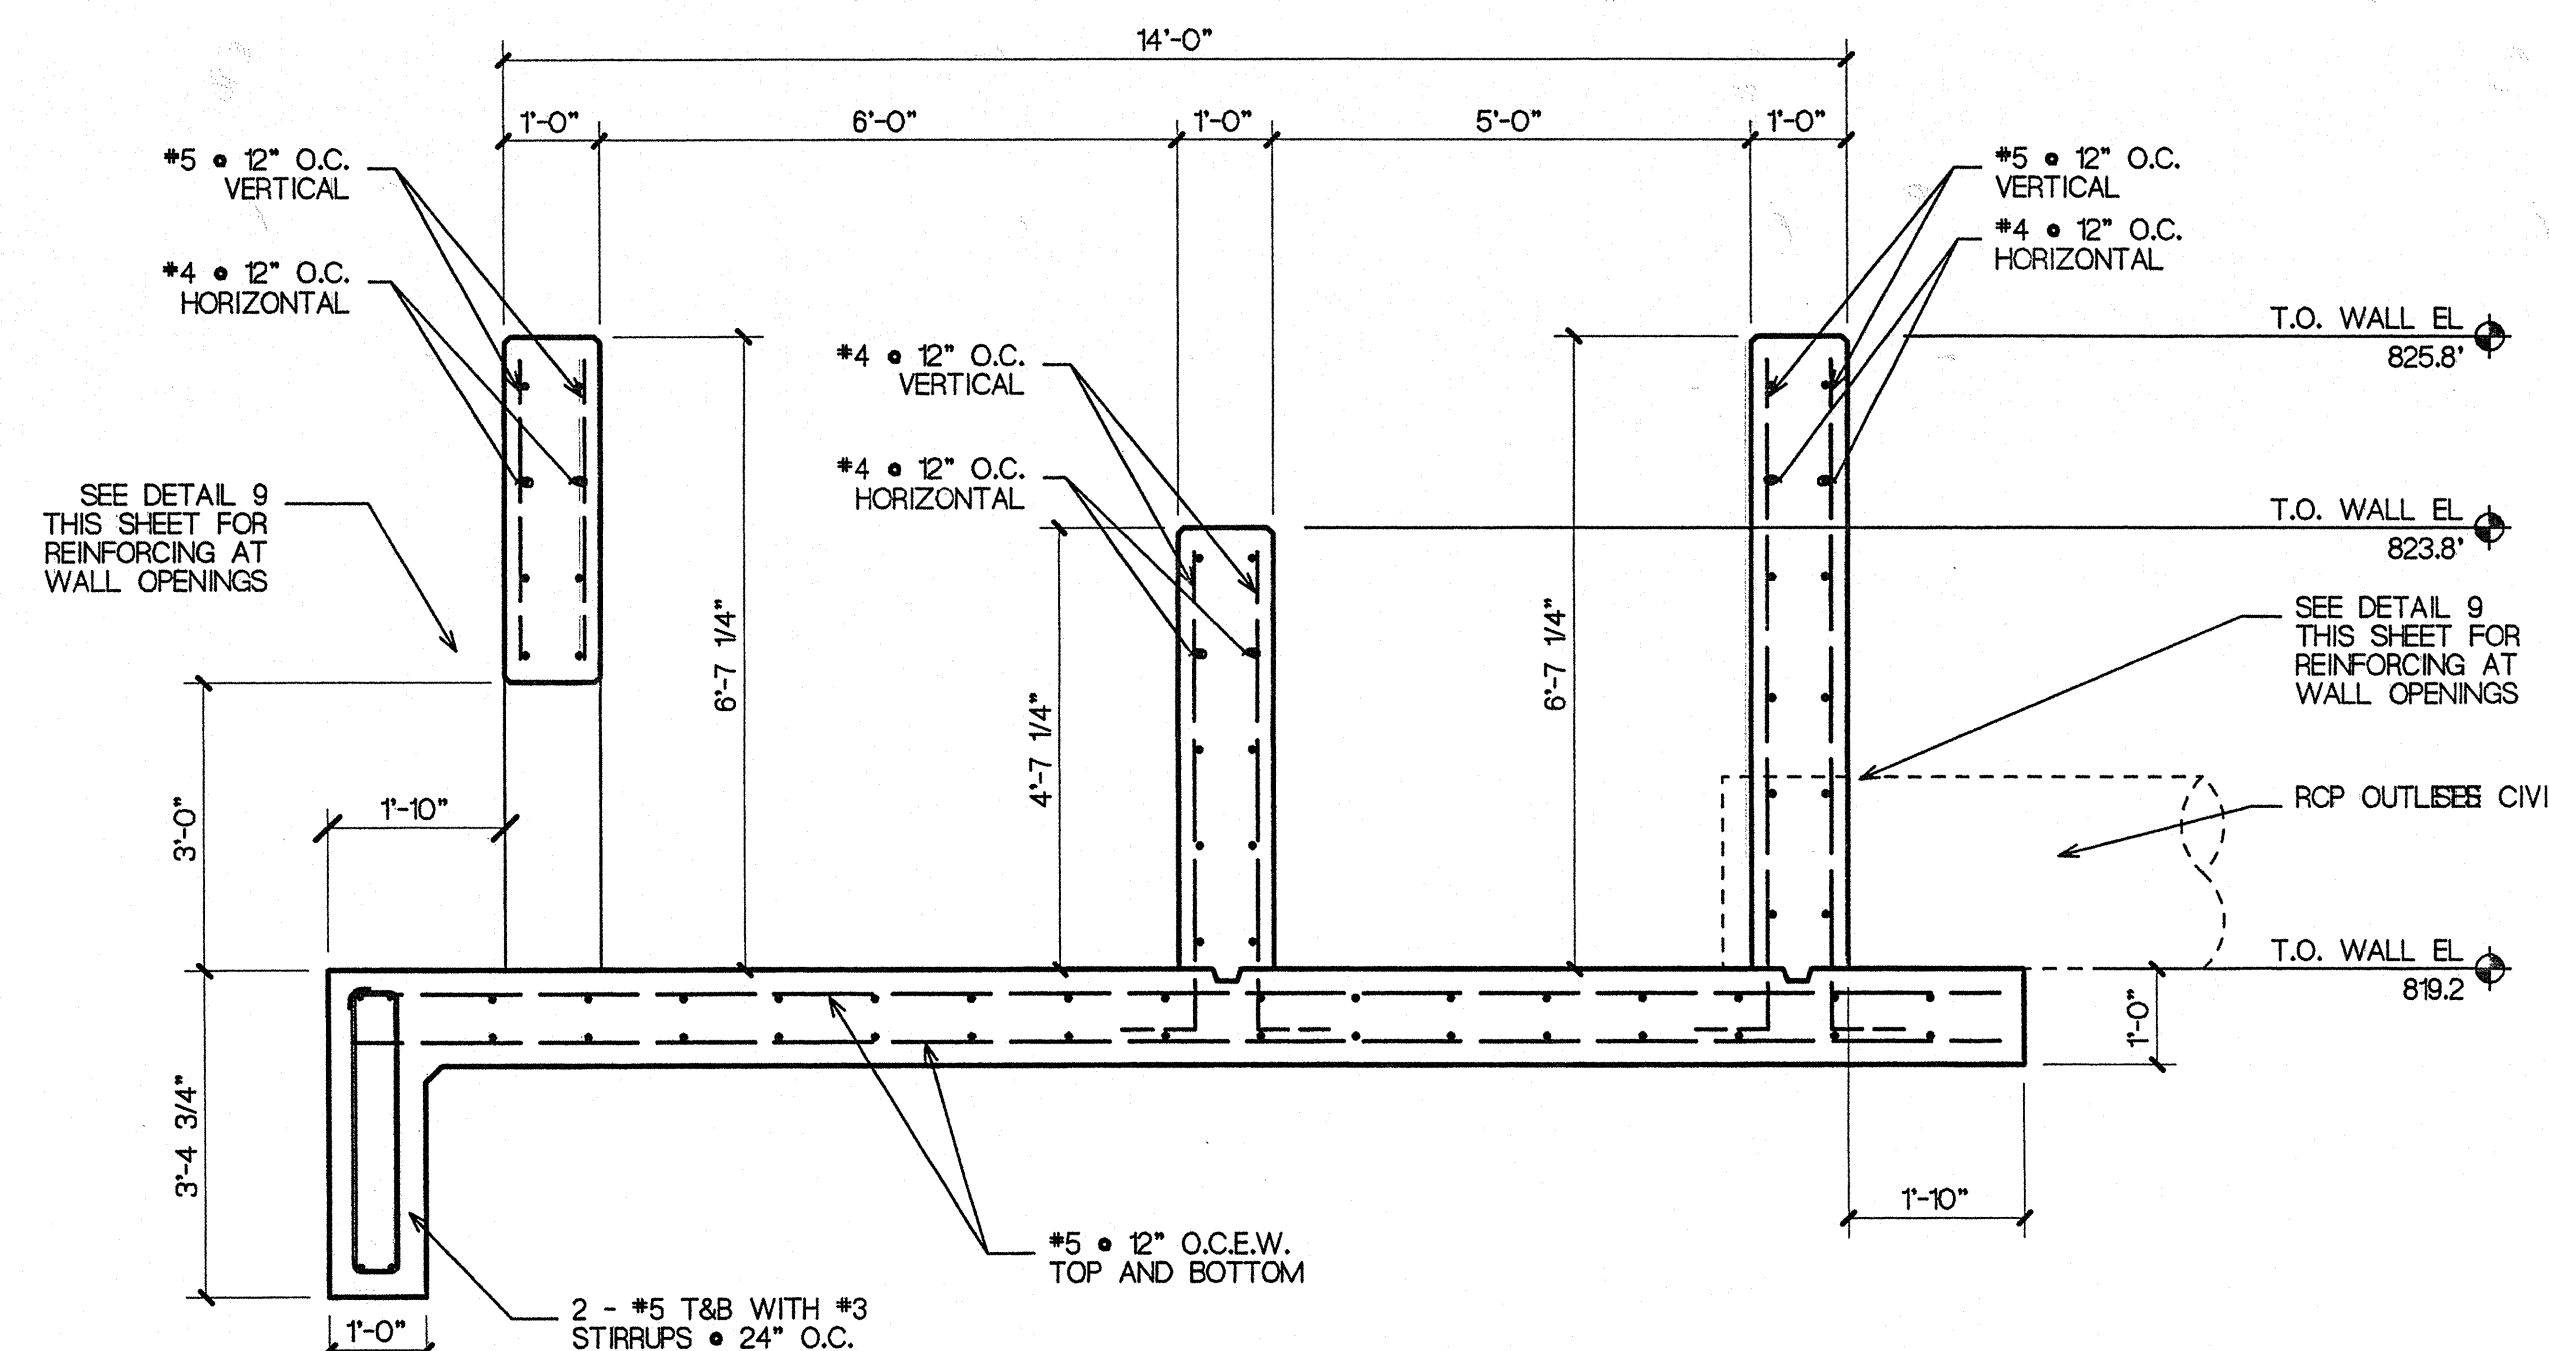


SECTION 3
SCALE: 3/4" = 1'-0"

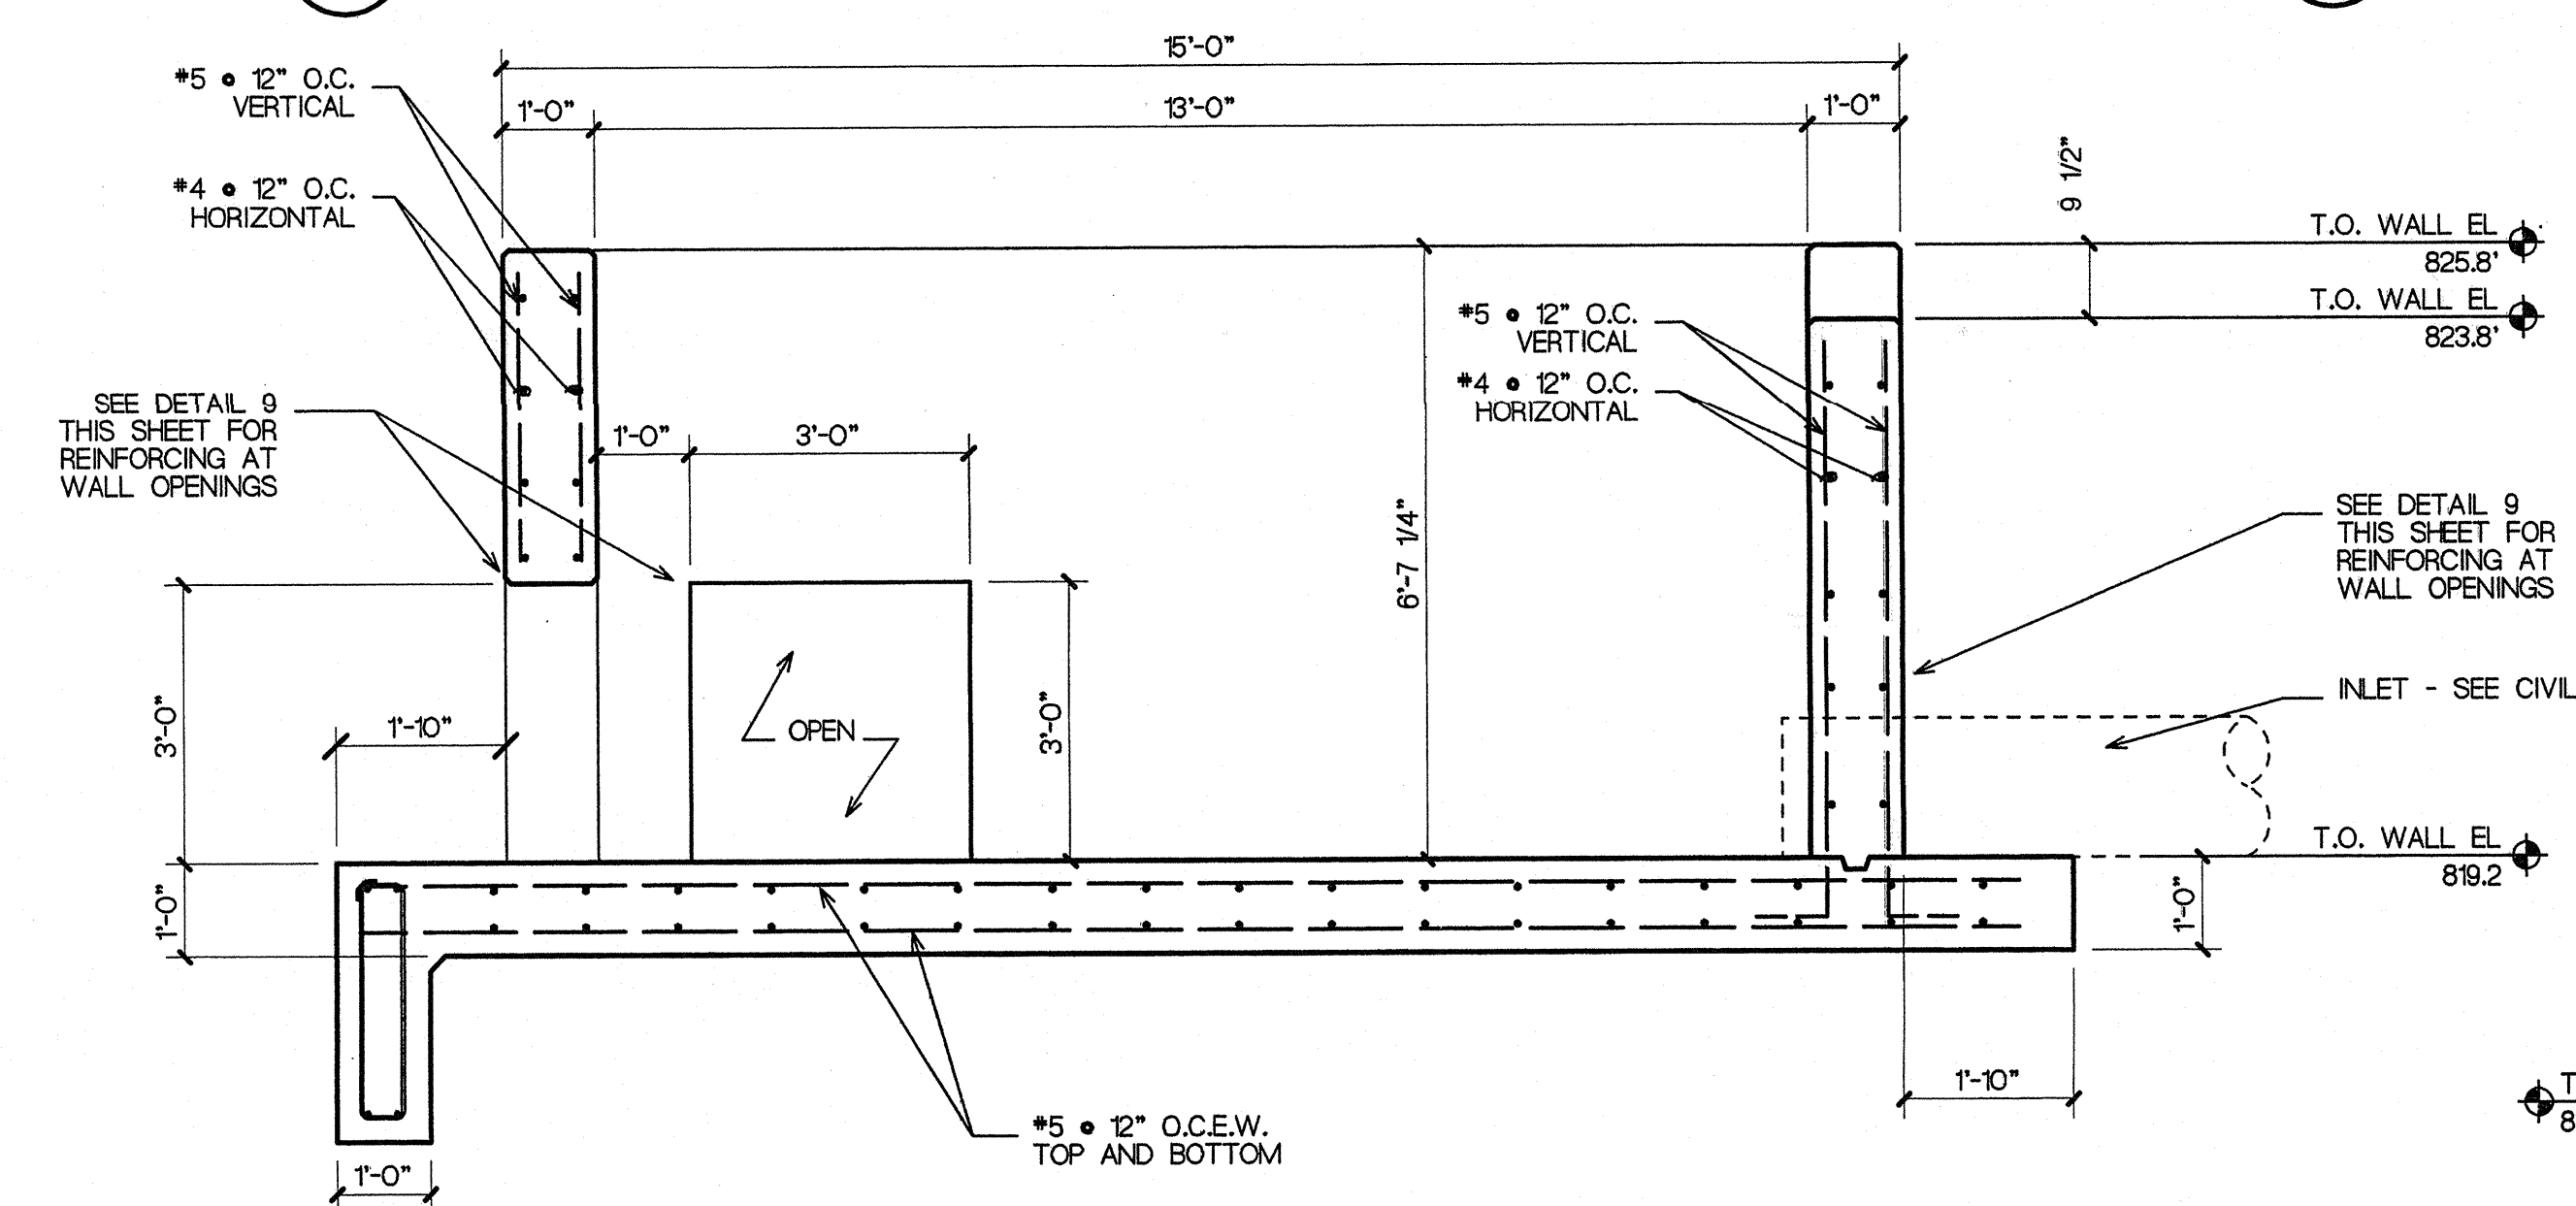


SECTION 4
SCALE: 3/4" = 1'-0"

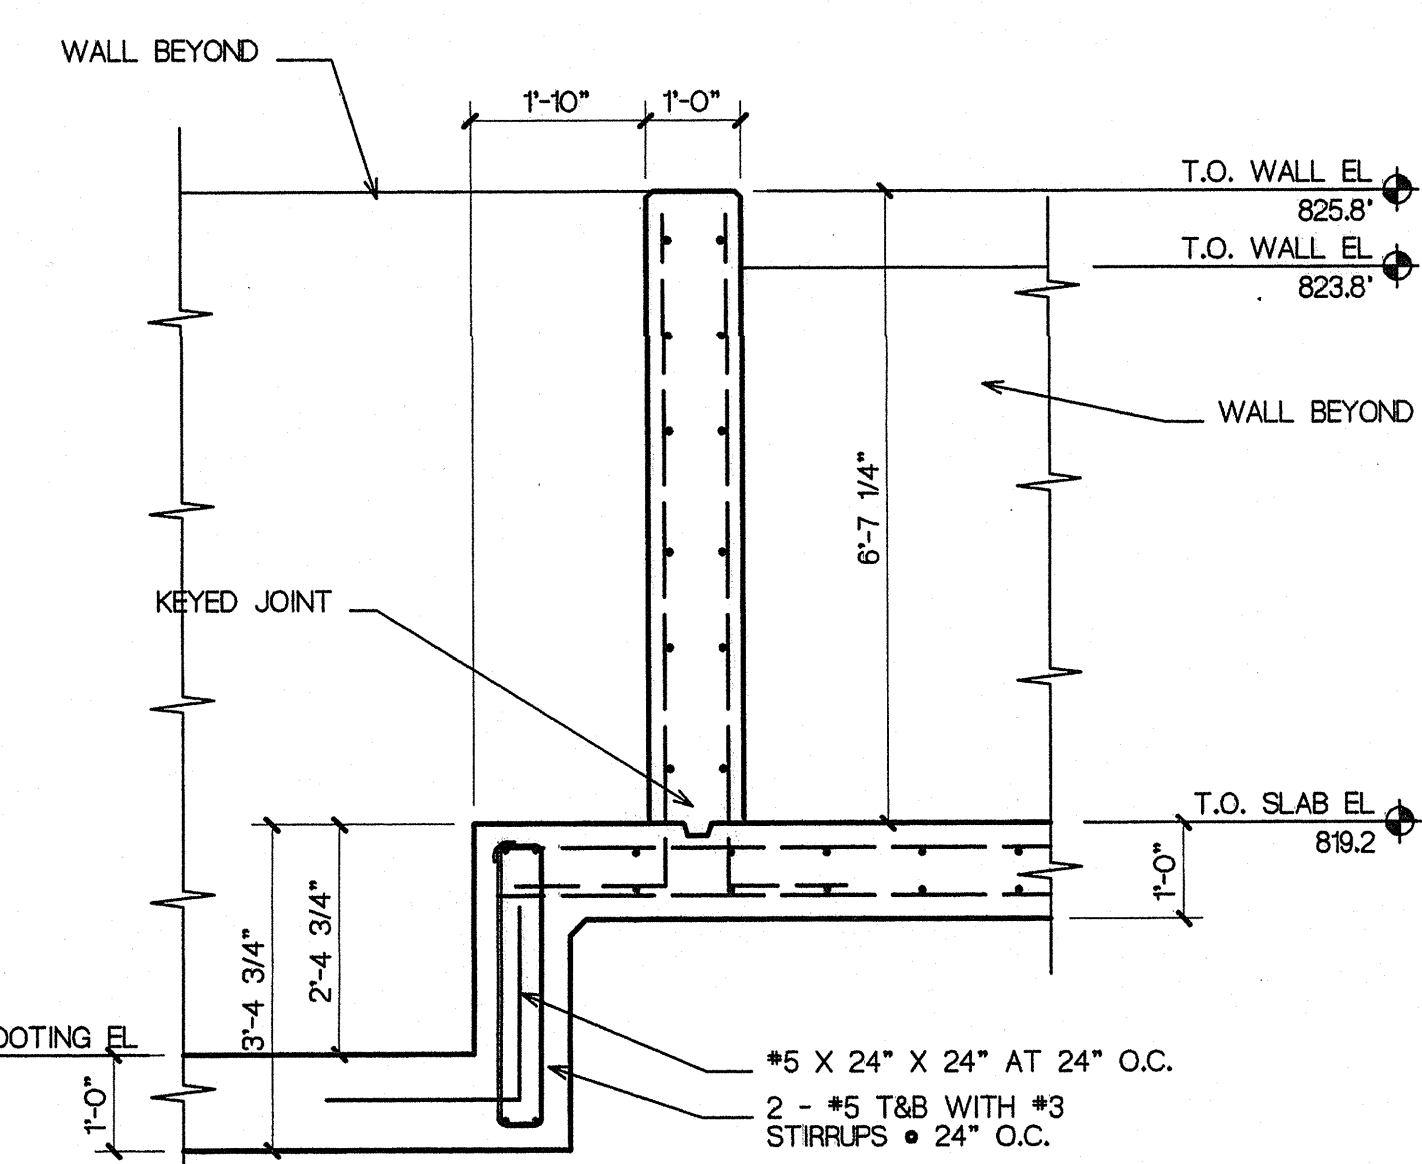


SECTION 5
SCALE: 3/4" = 1'-0"

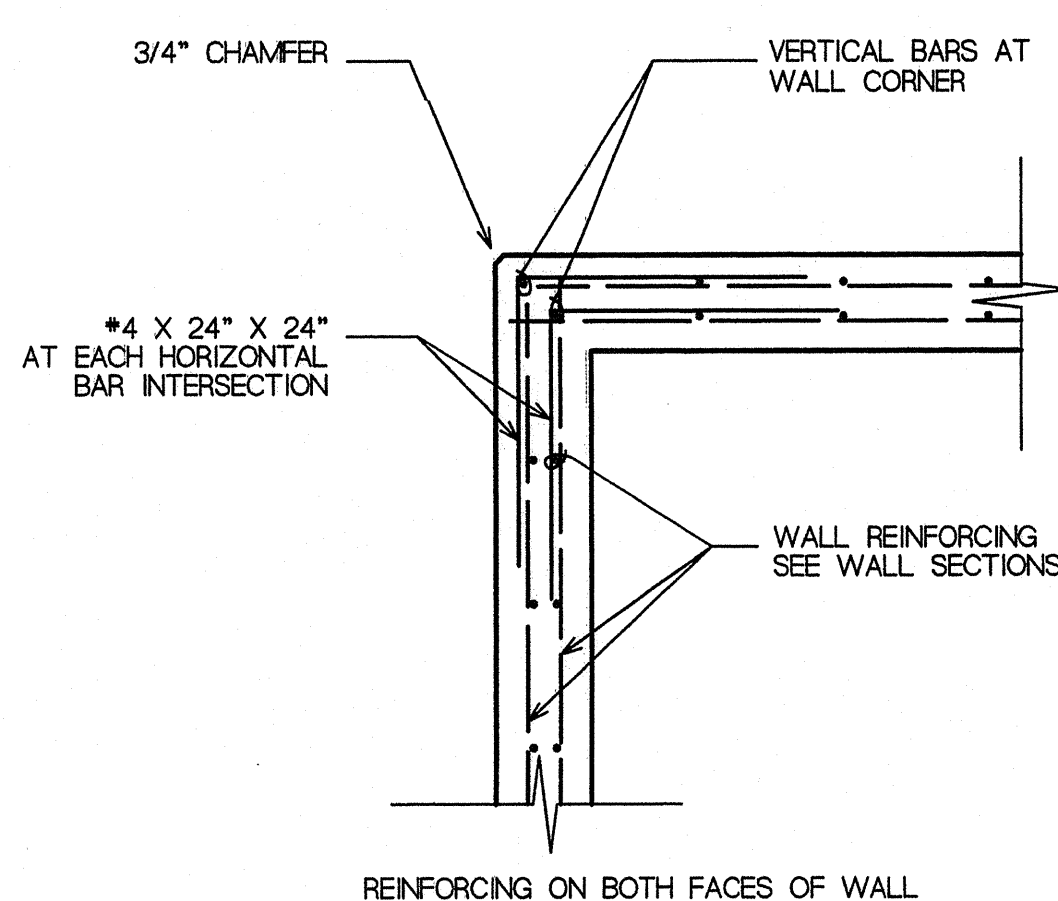


PLAN DETAIL AT WALL CORNER 6
SCALE: 3/4" = 1'-0"

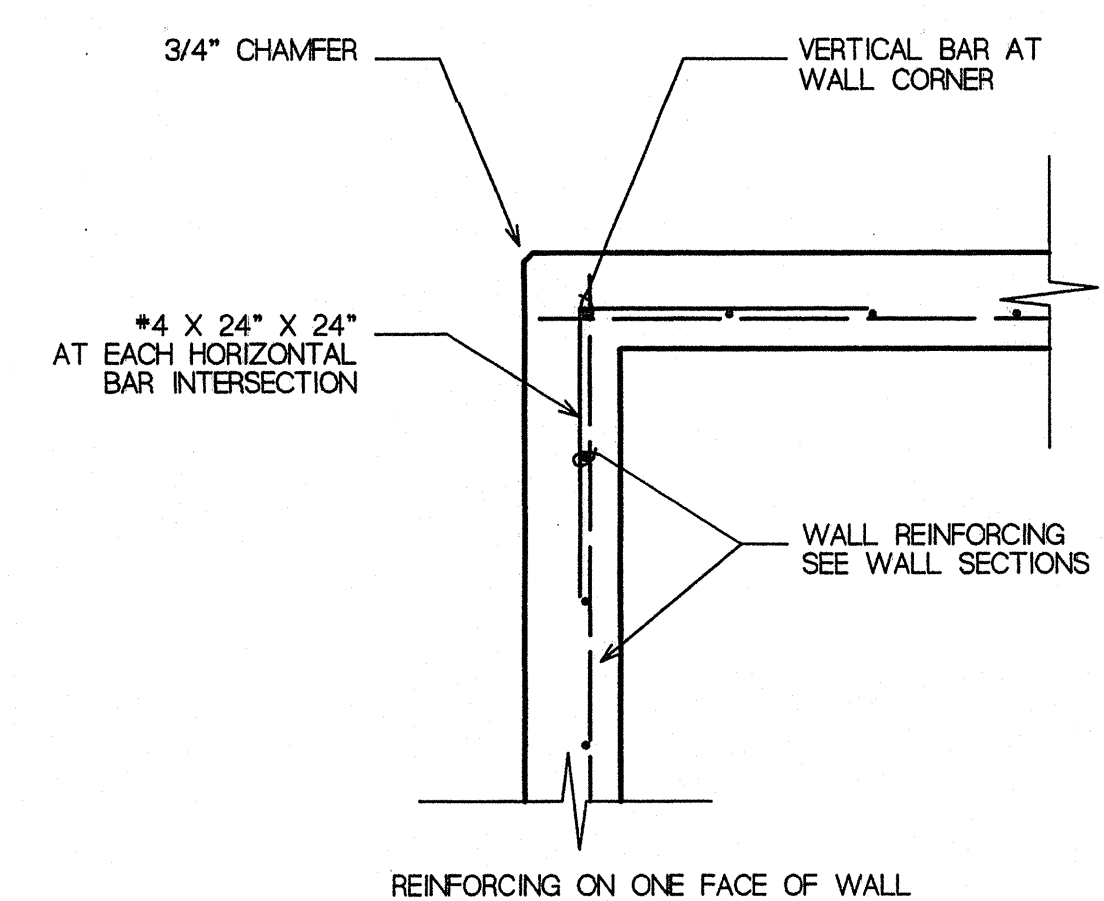


PLAN DETAIL AT WALL CORNER 7
SCALE: 3/4" = 1'-0"

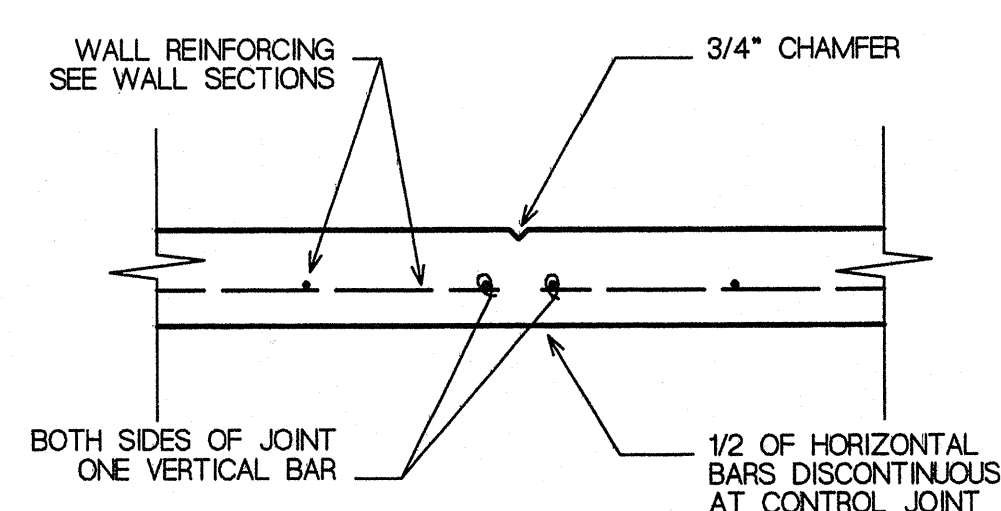


CONTROL JOINT 8
SCALE: 3/4" = 1'-0"

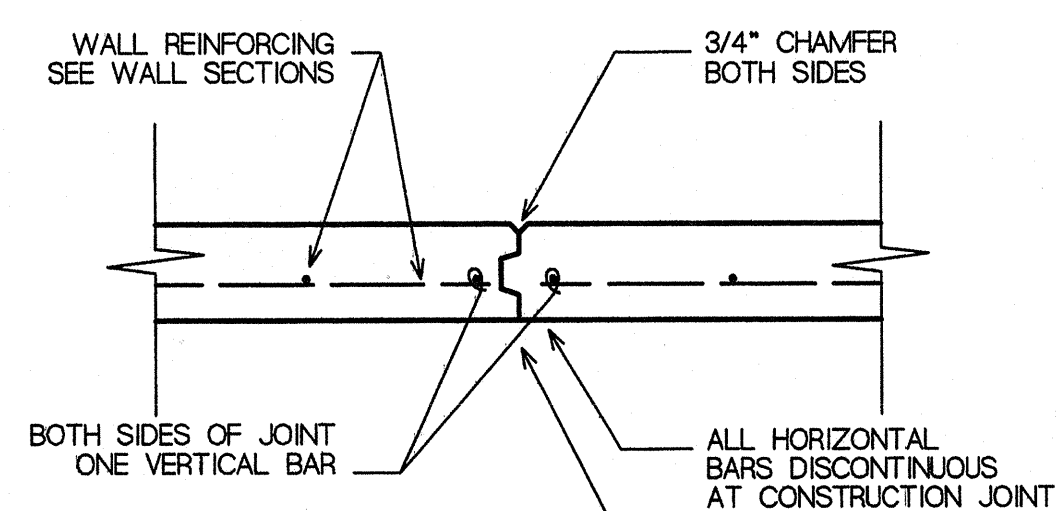


CONSTRUCTION JOINT 9
SCALE: 3/4" = 1'-0"

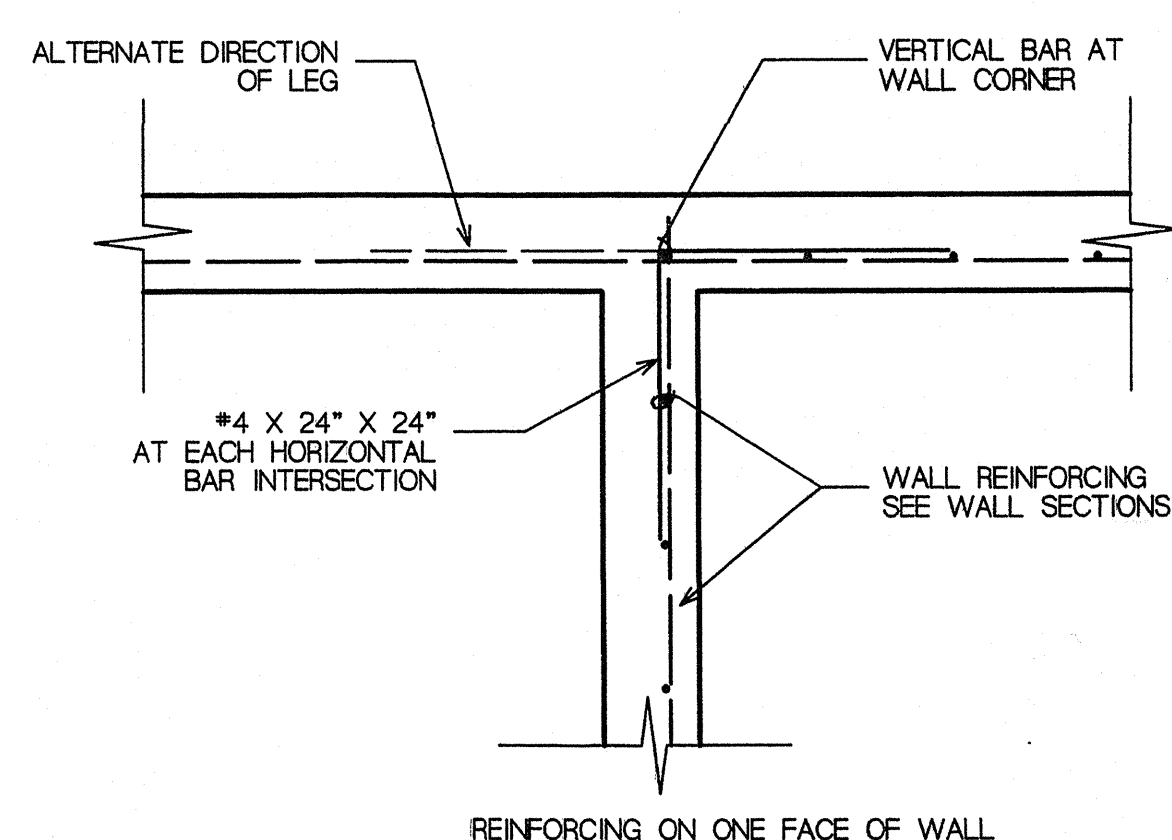

PLAN DETAIL AT WALL INTERSECTION 10
SCALE: 3/4" = 1'-0"

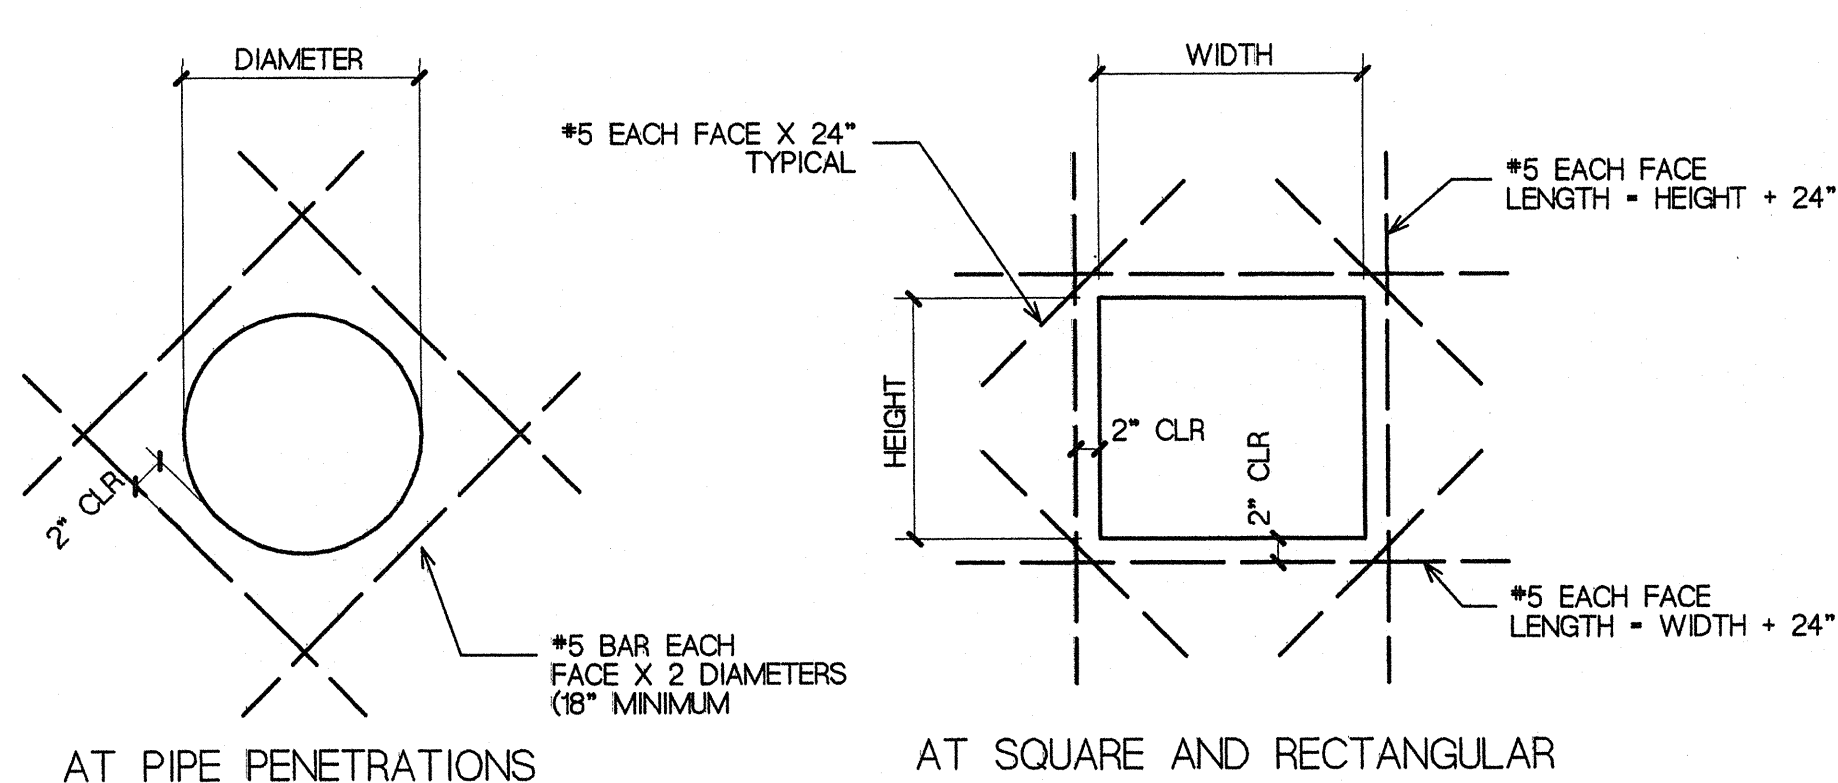


TYPICAL DETAILS AT WALL PENETRATIONS 11
SCALE: 3/4" = 1'-0"

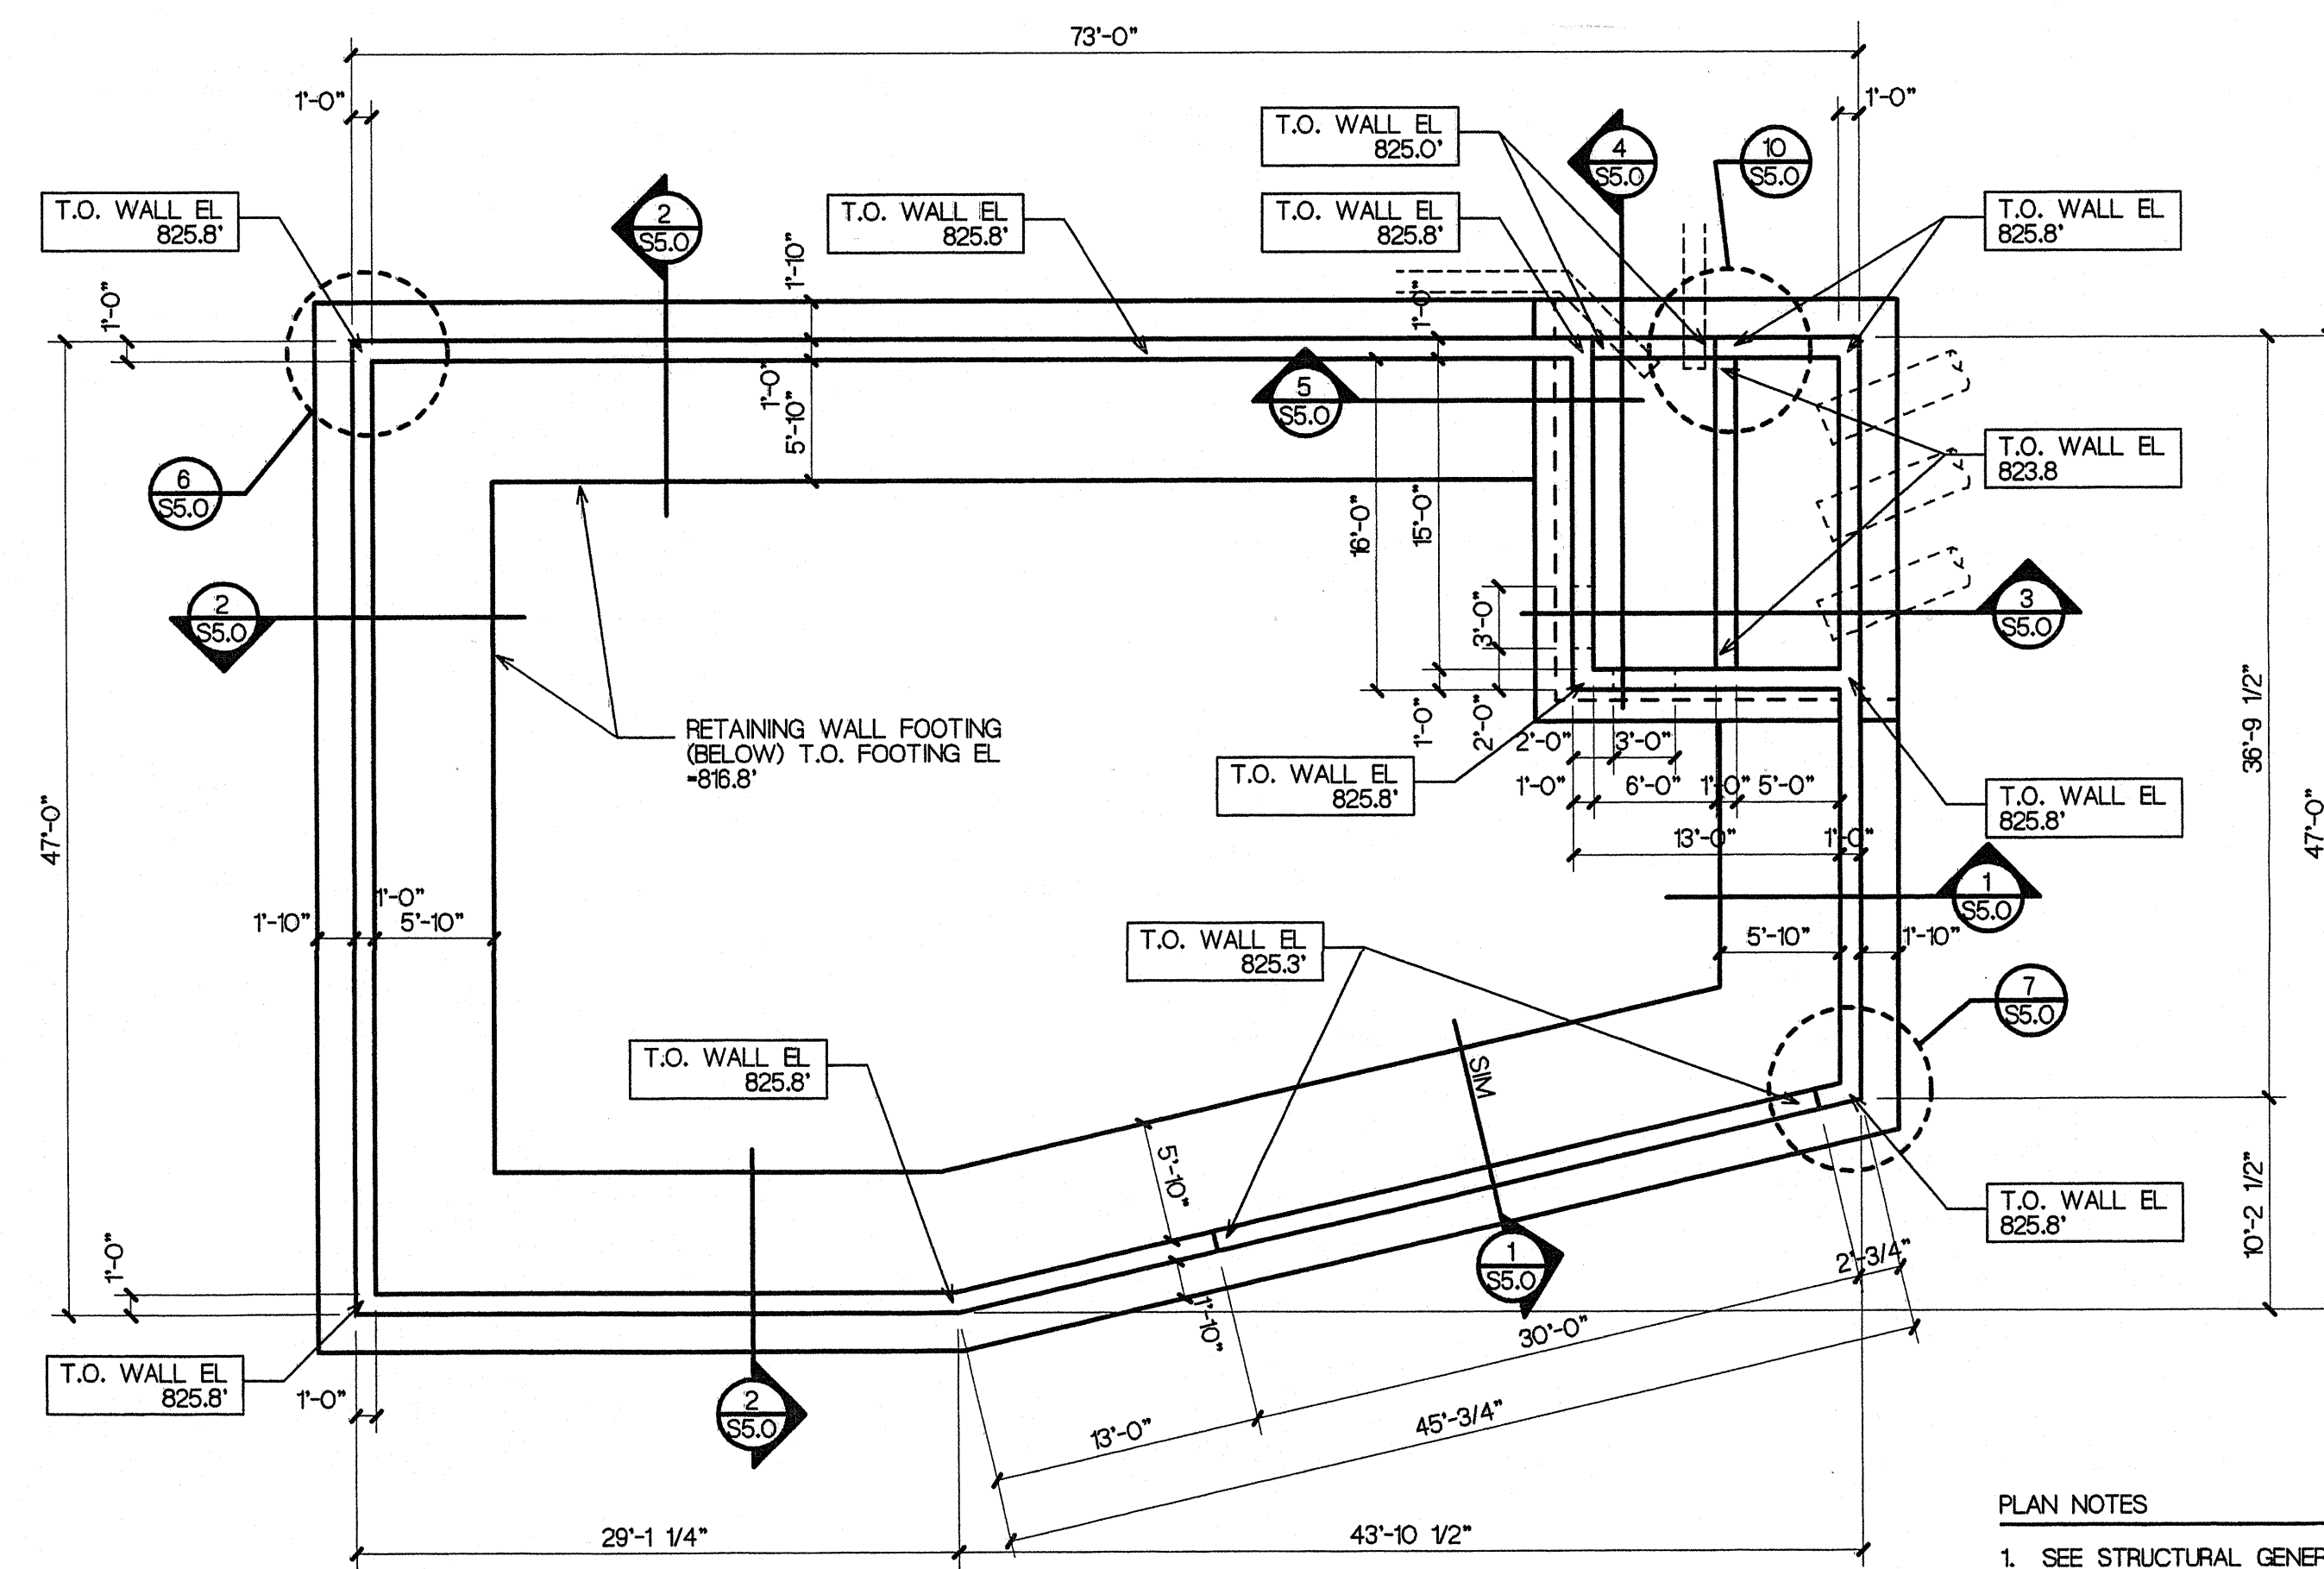

SEDIMENTATION/FILTRATION POND PLAN

SCALE: 1/8" = 1'-0"


- PLAN NOTES
- SEE STRUCTURAL GENERAL NOTES SHEET S1.0
 - FOR DESIGN PURPOSES, MAXIMUM WATER ELEVATION = 825.8'
 - PROVIDE CONTROL JOINTS IN WALLS AT A MAXIMUM OF 12 FEET. SEE DETAIL 8 THIS SHEET
 - WHERE WALL CONSTRUCTION JOINTS ARE NEEDED, SEE DETAIL 9 THIS SHEET

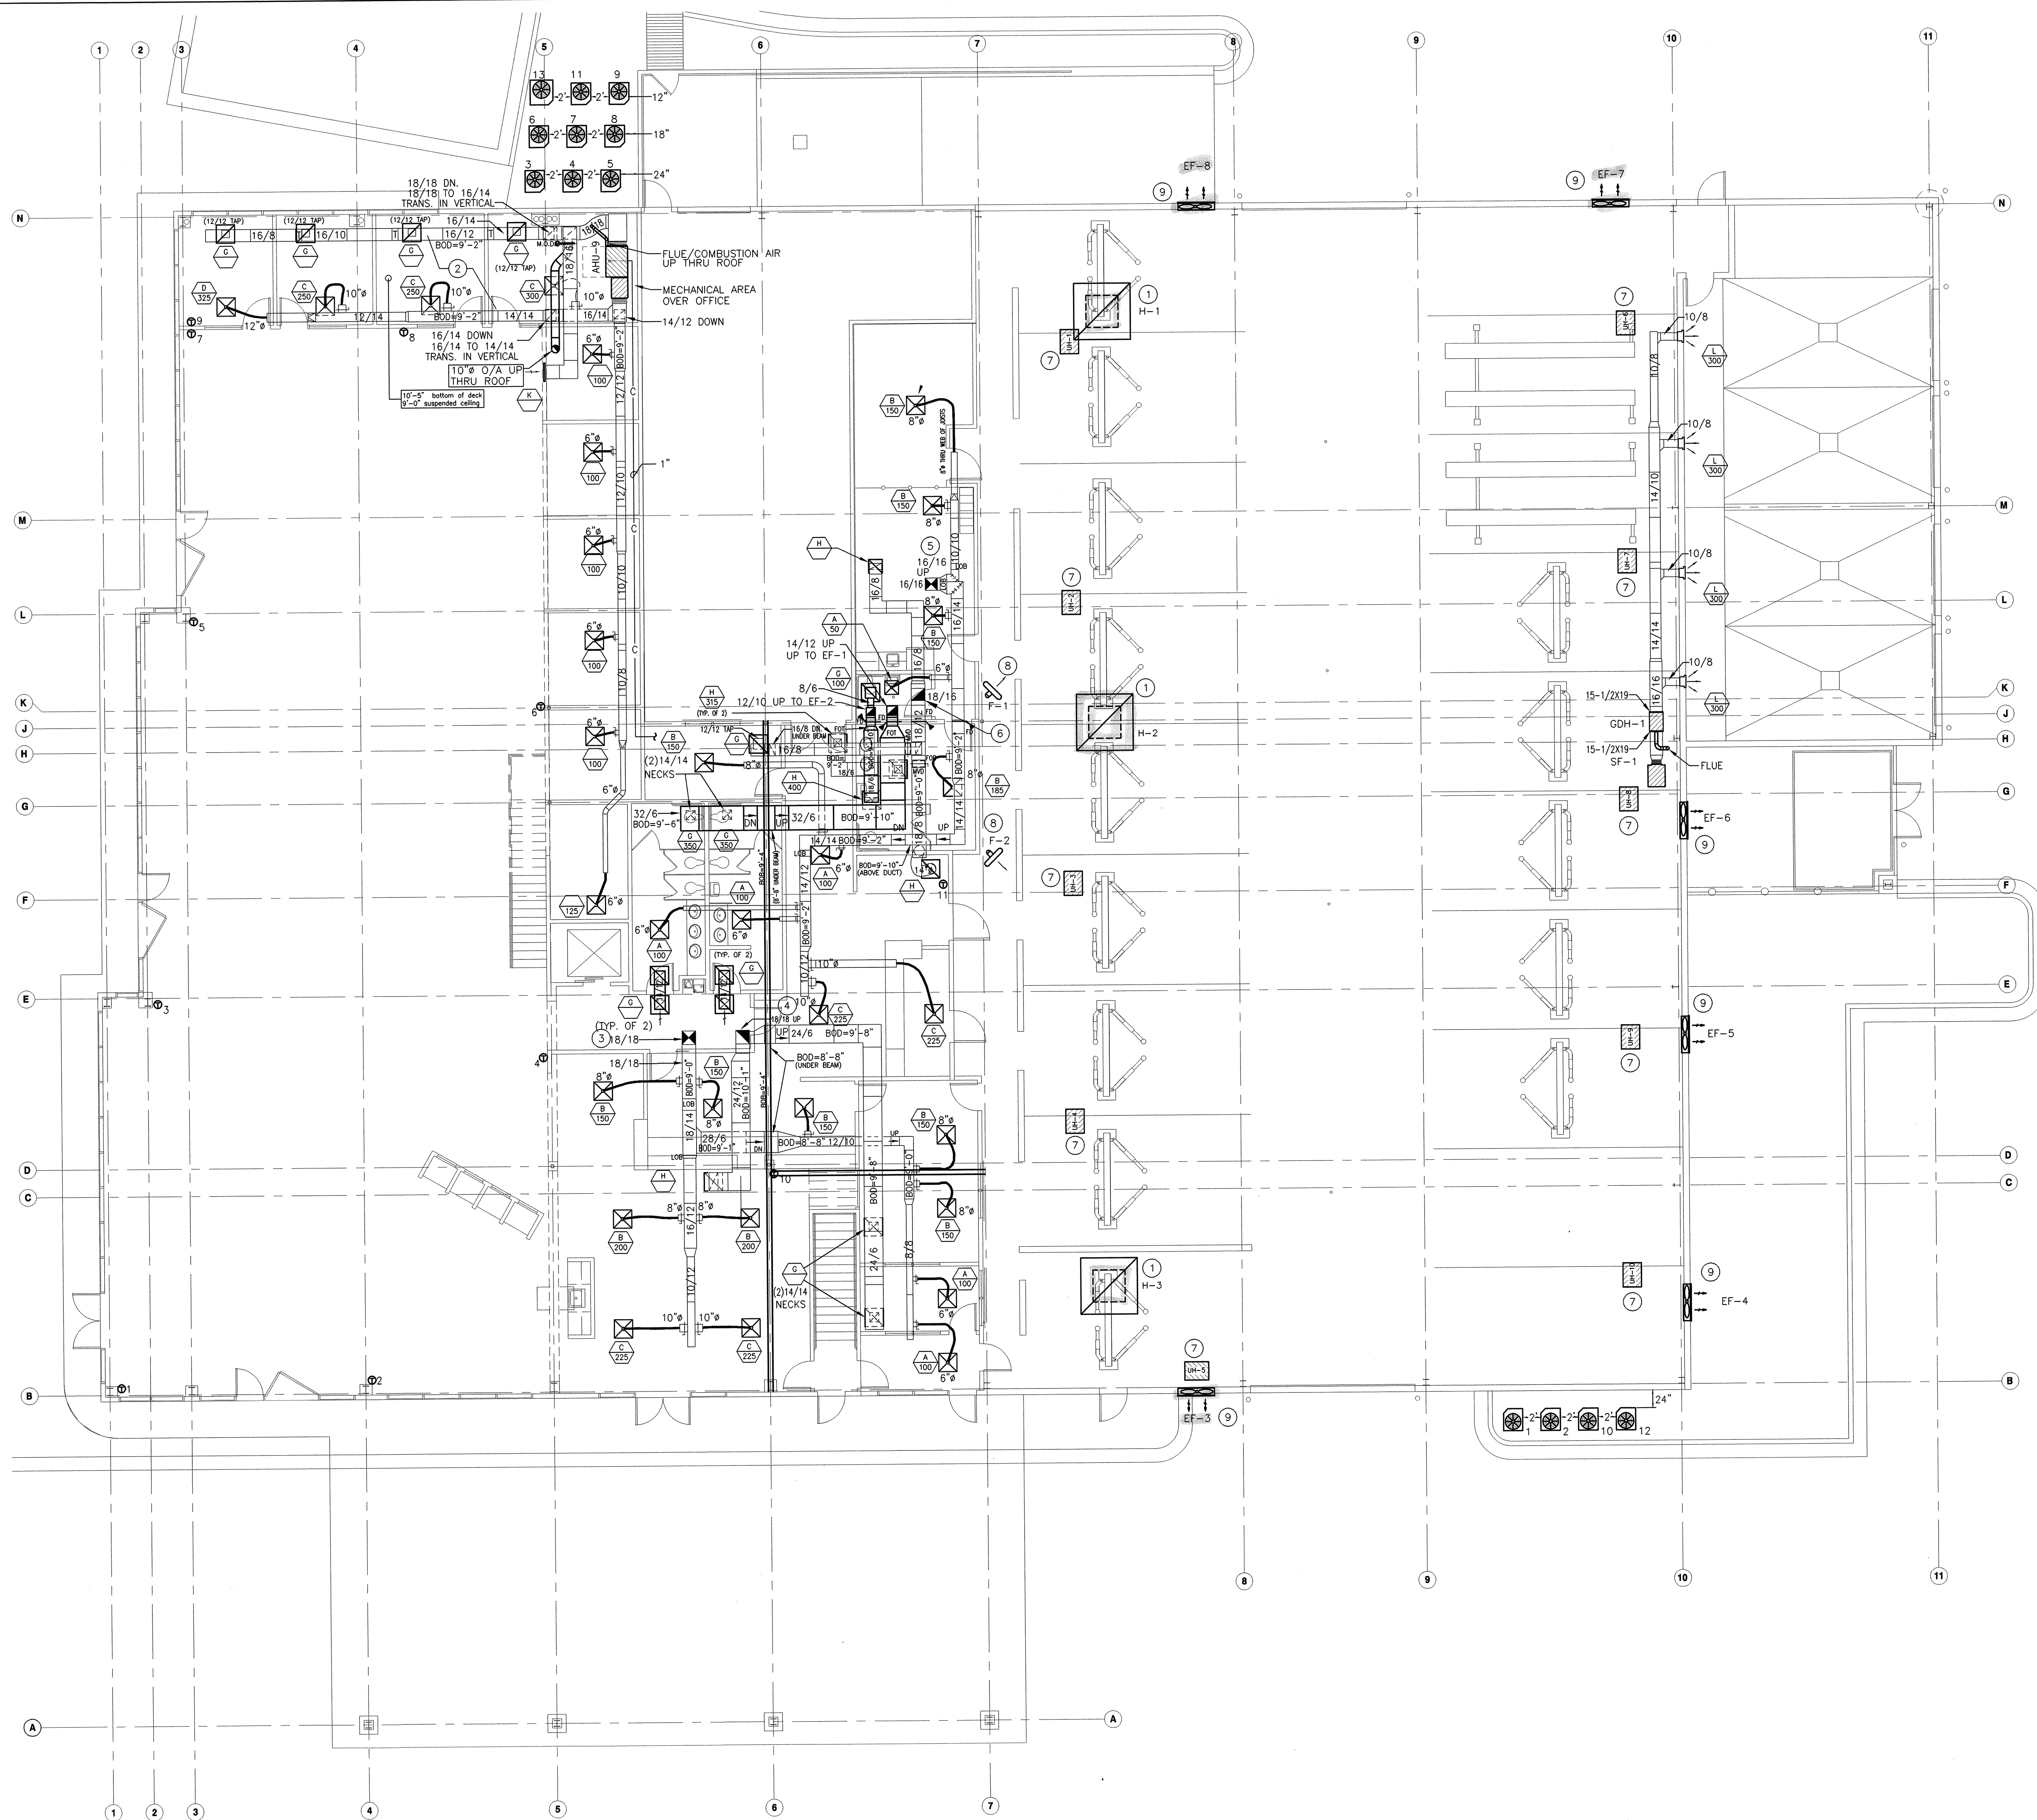

KEYED NOTES

THESE NOTES APPLY TO THIS SHEET ONLY

- 1 AIR INTAKE HOODS (H-1 THRU H-3) 12,000 CFM EA @ 0.1" WC. GREENHECK "FABRA-HOOD," OR EQUAL.
- 2 ROUTE DUCT IN PLENUM SPACE ABOVE OFFICE. SUSPENDED CEILING.
- 3 SUPPLY AIR DUCT UP TO AHU-10 ON SECOND FLOOR.
- 4 RETURN AIR DUCT UP TO AHU-10 ON SECOND FLOOR.
- 5 SUPPLY AIR DUCT UP TO AHU-11 ON SECOND FLOOR MECHANICAL DECK.
- 6 RETURN AIR DUCT UP TO AHU-11 ON SECOND FLOOR MECHANICAL DECK.
- 7 MOUNT INFRARED HEATERS BETWEEN JOISTS SO THAT HEAT IS NOT DIRECTED ON CAR HOODS. MOUNT AT MANUFACTURER'S RECOMMENDATIONS ON HEIGHT.
- 8 MOUNT F-1 AND F-2 EIGHT (8) FT. ABOVE FINISHED FLOOR.
- 9 MOUNT FAN IN WALL AS HIGH AS POSSIBLE.

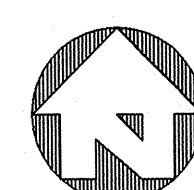

01 FIRST FLOOR — H.V.A.C. PLAN
SCALE: 1/8" = 1'-0"


SHOP OUTSIDE AIR

FLOOR AREA: 10,000 FT²
AVG HT: 20FT
VOLUME: 200,000 FT³
AC/H: 10 MINIMUM
EF-3 THRU EF-8: 36,000 CFM TOTAL

AN AUTOMOTIVE DEALERSHIP

ROGER BEASLEY VOLVO

INTERSTATE HIGHWAY 35 SOUTH
GEORGETOWN, TEXAS

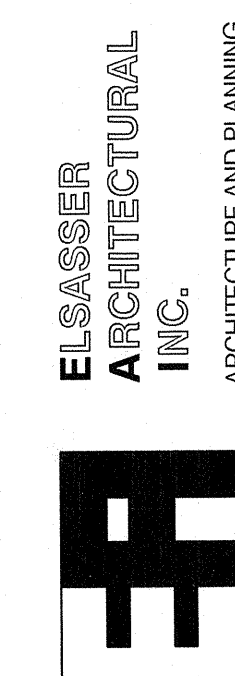

ELSSASSER
ARCHITECTURAL
INC.
ARCHITECTURE AND PLANNING
P.O. BOX 533 GEORGETOWN, TX 78627
(512) 890-5333 FAX (512) 890-2618 www.eahs.com

CONSULTANT SEAL:

MECHANICAL
TECHNICAL
SERVICES, L.P.
COMFORT USA
SYSTEMS
A Comfort Systems USA Company

DATE: 28, July 2003

Preliminary Plan
Not For Construction


REVISION DATE:

SHOP
DRAWING

PROJECT NO.
M-Tech #2406

SHEET NO.

M1.0

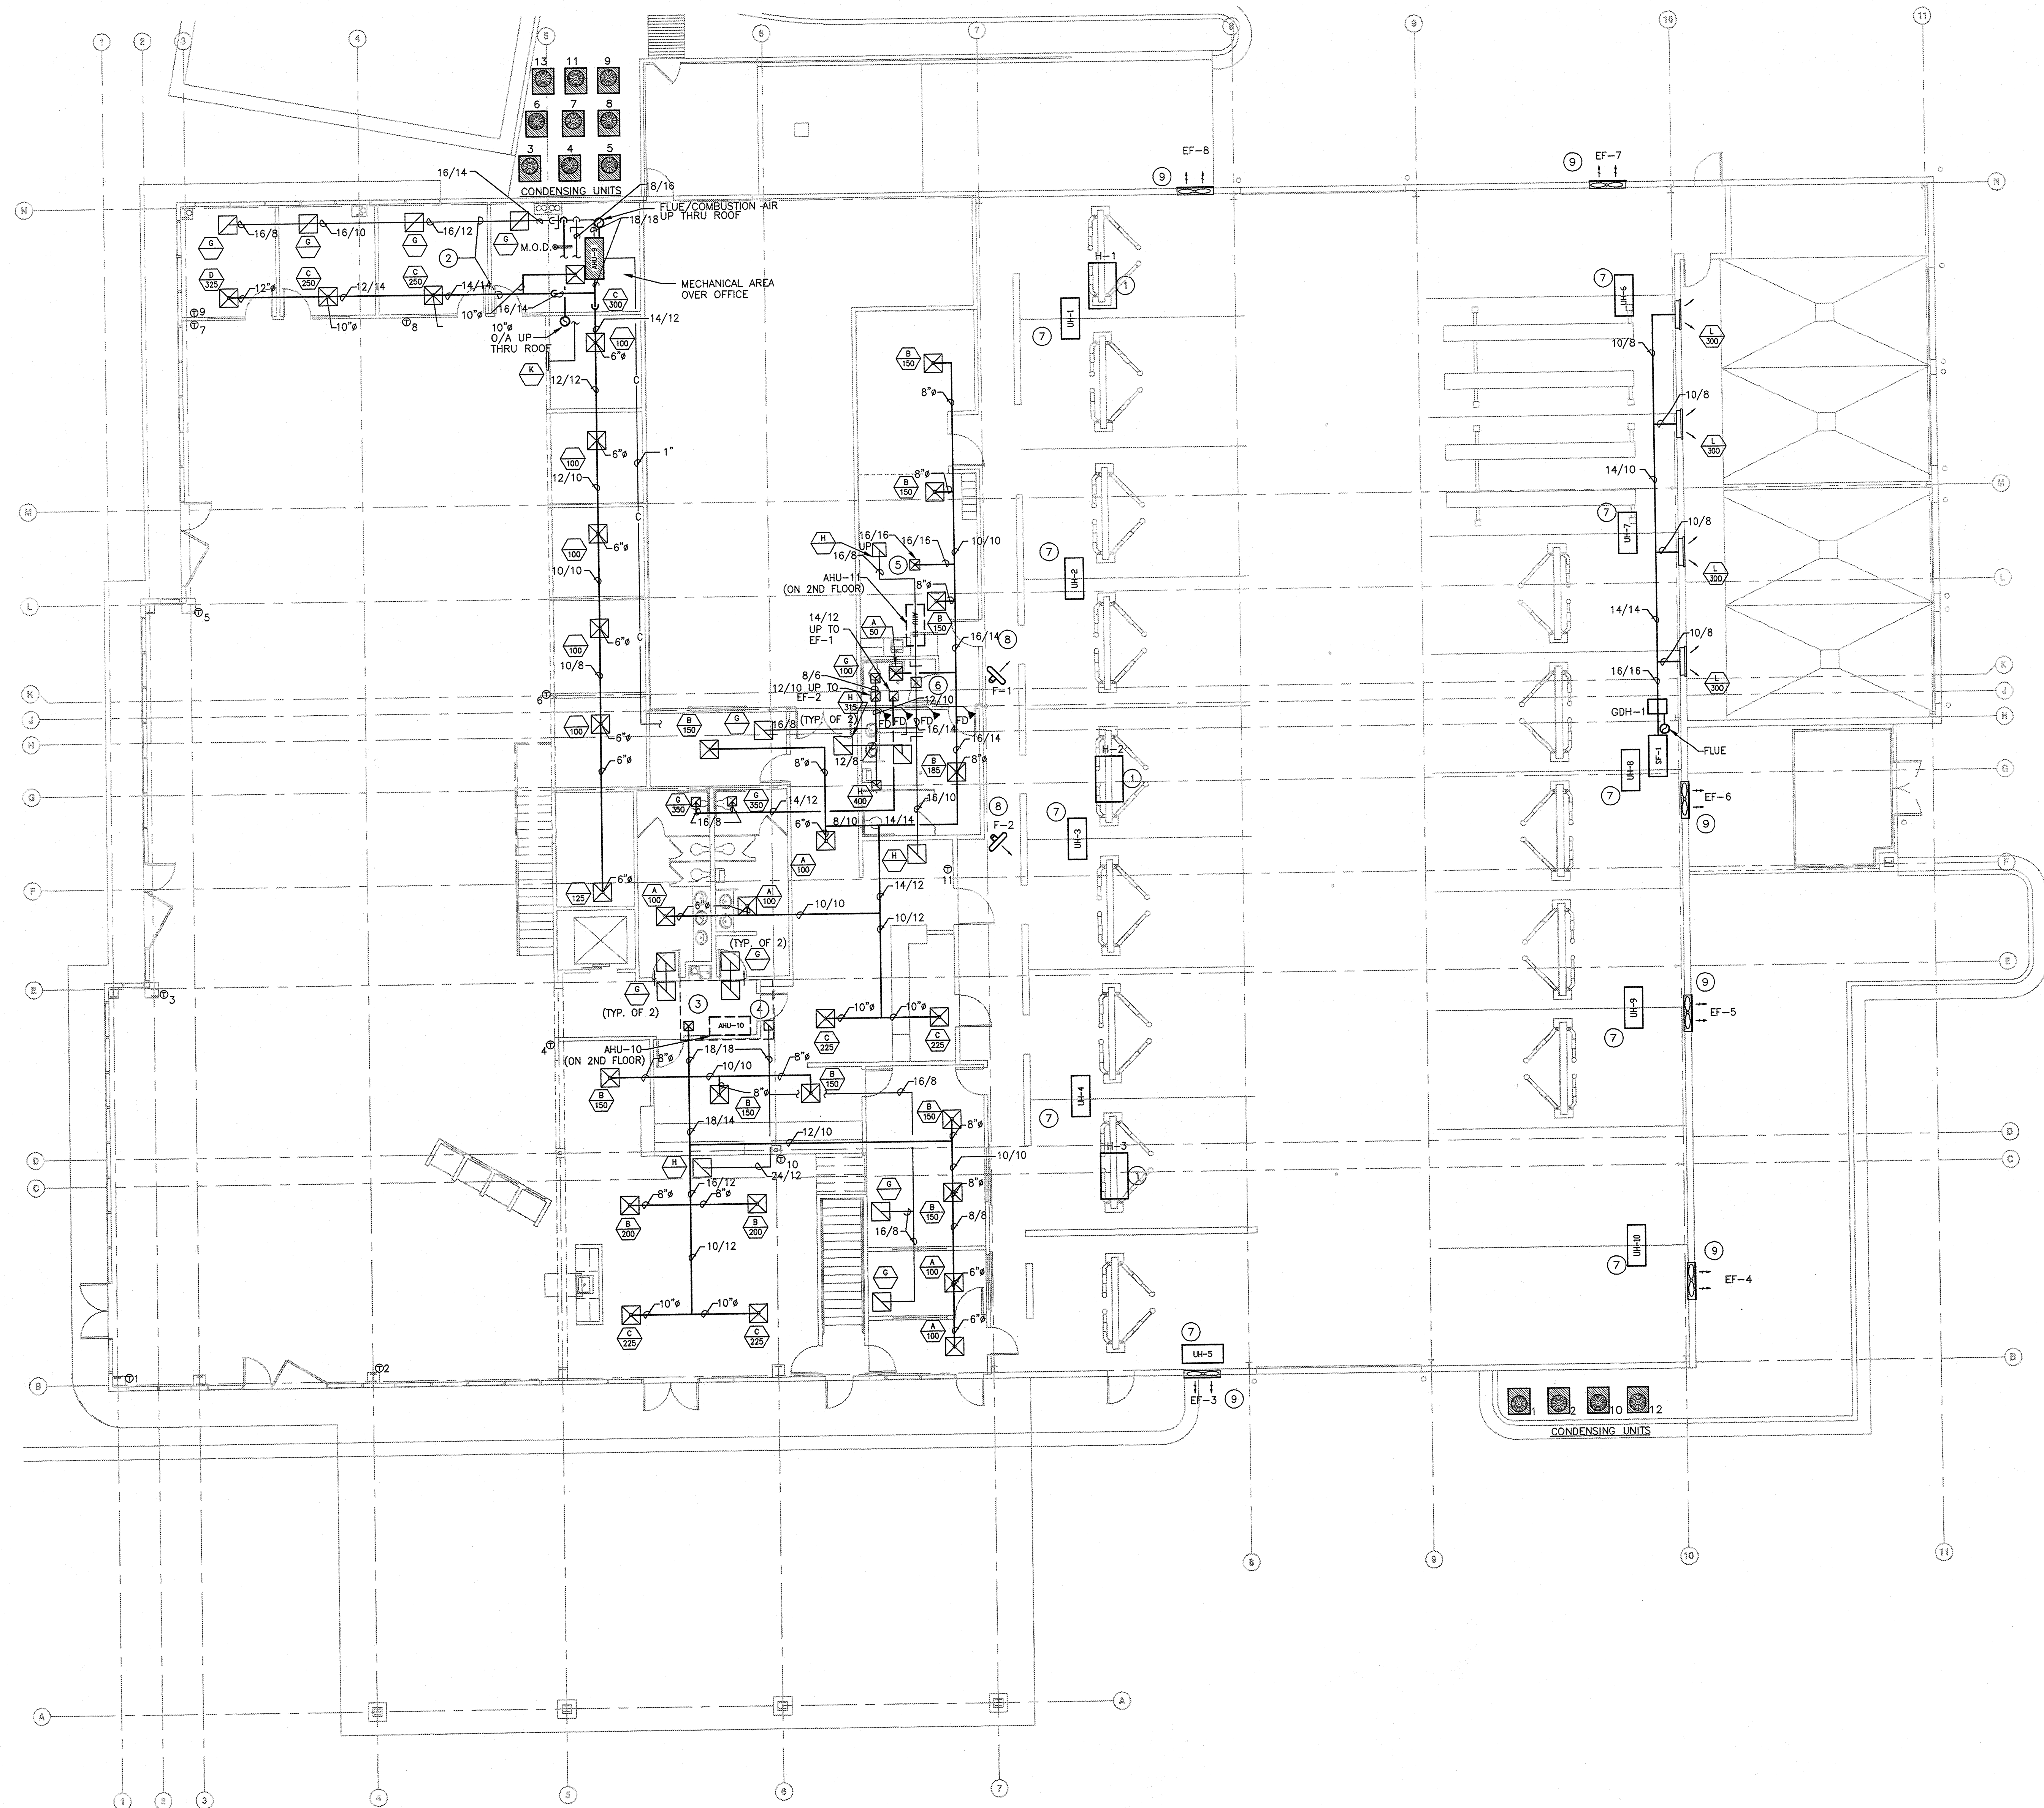


KEYED NOTES

THESE NOTES APPLY TO THIS SHEET ONLY

- 1 AIR INTAKE HOODS (H-1 THRU H-3) 12,000 CFM EA @ 0.1" WC. GREENHECK "FABRA-HOOD," OR EQUAL.
- 2 ROUTE DUCT IN PLENUM SPACE ABOVE OFFICE SUSPENDED CEILING.
- 3 SUPPLY AIR DUCT UP TO AHU-10 ON SECOND FLOOR.
- 4 RETURN AIR DUCT UP TO AHU-10 ON SECOND FLOOR.
- 5 SUPPLY AIR DUCT UP TO AHU-12 ON SECOND FLOOR MECHANICAL DECK.
- 6 RETURN AIR DUCT UP TO AHU-12 ON SECOND FLOOR MECHANICAL DECK.
- 7 MOUNT INFRARED HEATERS BETWEEN JOISTS SO THAT HEAT IS NOT DIRECTED ON CAR HOODS. MOUNT AT MANUFACTURER'S RECOMMENDATIONS ON HEIGHT.
- 8 MOUNT F-1 AND F-2 EIGHT (8) FT. ABOVE FINISHED FLOOR.
- 9 MOUNT FAN IN WALL AS HIGH AS POSSIBLE.

SHOP OUTSIDE AIR

FLOOR AREA: 10,000 FT²
 AVG HT: 20FT
 VOLUME: 200,000 FT³
 AC/H: 10 MINIMUM
 EF-3 THRU EF-8: 36,000 CFM TOTAL

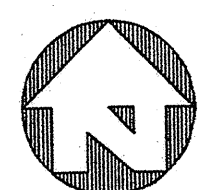

01 FIRST FLOOR - H.V.A.C. PLAN
 SCALE: 1/8" = 1'-0"

**MYERS &
 ASSOCIATES**

This document, the ideas and designs incorporated herein are and shall remain the property of Myers & Associates. These documents are not to be used or altered, in whole or in part, for other than the original intended use, nor are they to be assigned to any third party without written permission from Myers & Associates. ©


M & A Job no.: 01-016

AN AUTOMOTIVE DEALERSHIP

ROGER BEASLEY VOLVO


INTERSTATE HIGHWAY 35 SOUTH
 GEORGETOWN, TEXAS

**ELASSER
 ARCHITECTURAL
 INC.**

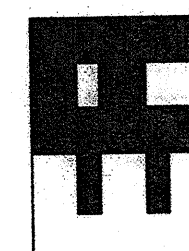

ARCHITECTURE AND PLANNING
 KENNETH L. GABRIEL
 P.O. BOX 833 GEORGETOWN, TX 78627
 (512) 890-5353 FAX (512) 890-2818 www.ea-h.com

CONSULTANT SEAL:

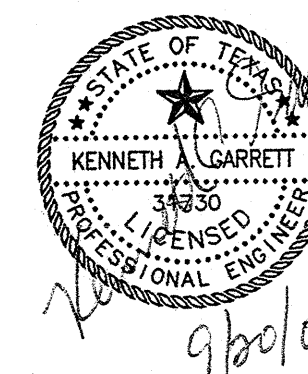

DATE: 04/20/02

REVISION DATE:

PROJECT NO.
 020008

SHEET NO.

M1.0




KEYED NOTES

THESE NOTES APPLY TO THIS SHEET ONLY

1. FLUES TO BE 10'-0" MINIMUM FROM OUTSIDE AIR INTAKE.
2. AIR INTAKE/COMBUSTION AIR HOOD, 10,000 CFM @ 0.1" WC. GREENHECK "FABRA HOOD" OR EQUAL.
3. INSTALL BACKDRAFT DAMPER IN RELIEF DUCT. SET COUNTER BALANCE @ 0.1" WC.
4. ROUTE CONDENSATE DRAIN TO INDIRECT WASTE RECEPTOR.

SEQUENCE OF OPERATIONS

1. MOTOR OPERATED DAMPERS IN OUTSIDE AIR DUCT OPEN WHEN AIR HANDLER SUPPLY BLOWER OPERATES, CLOSES WHEN AHU BLOWER OFF.

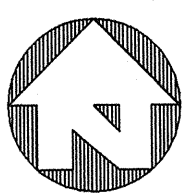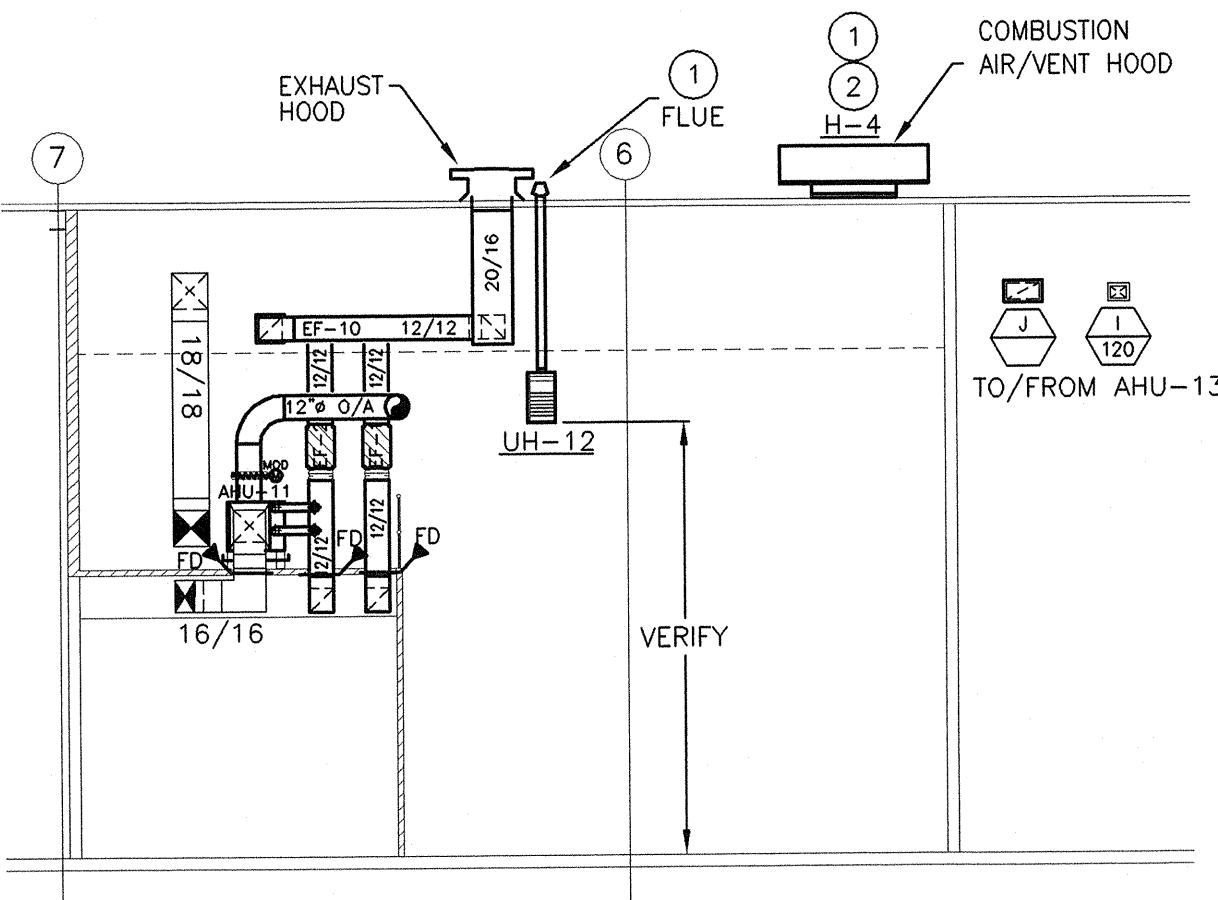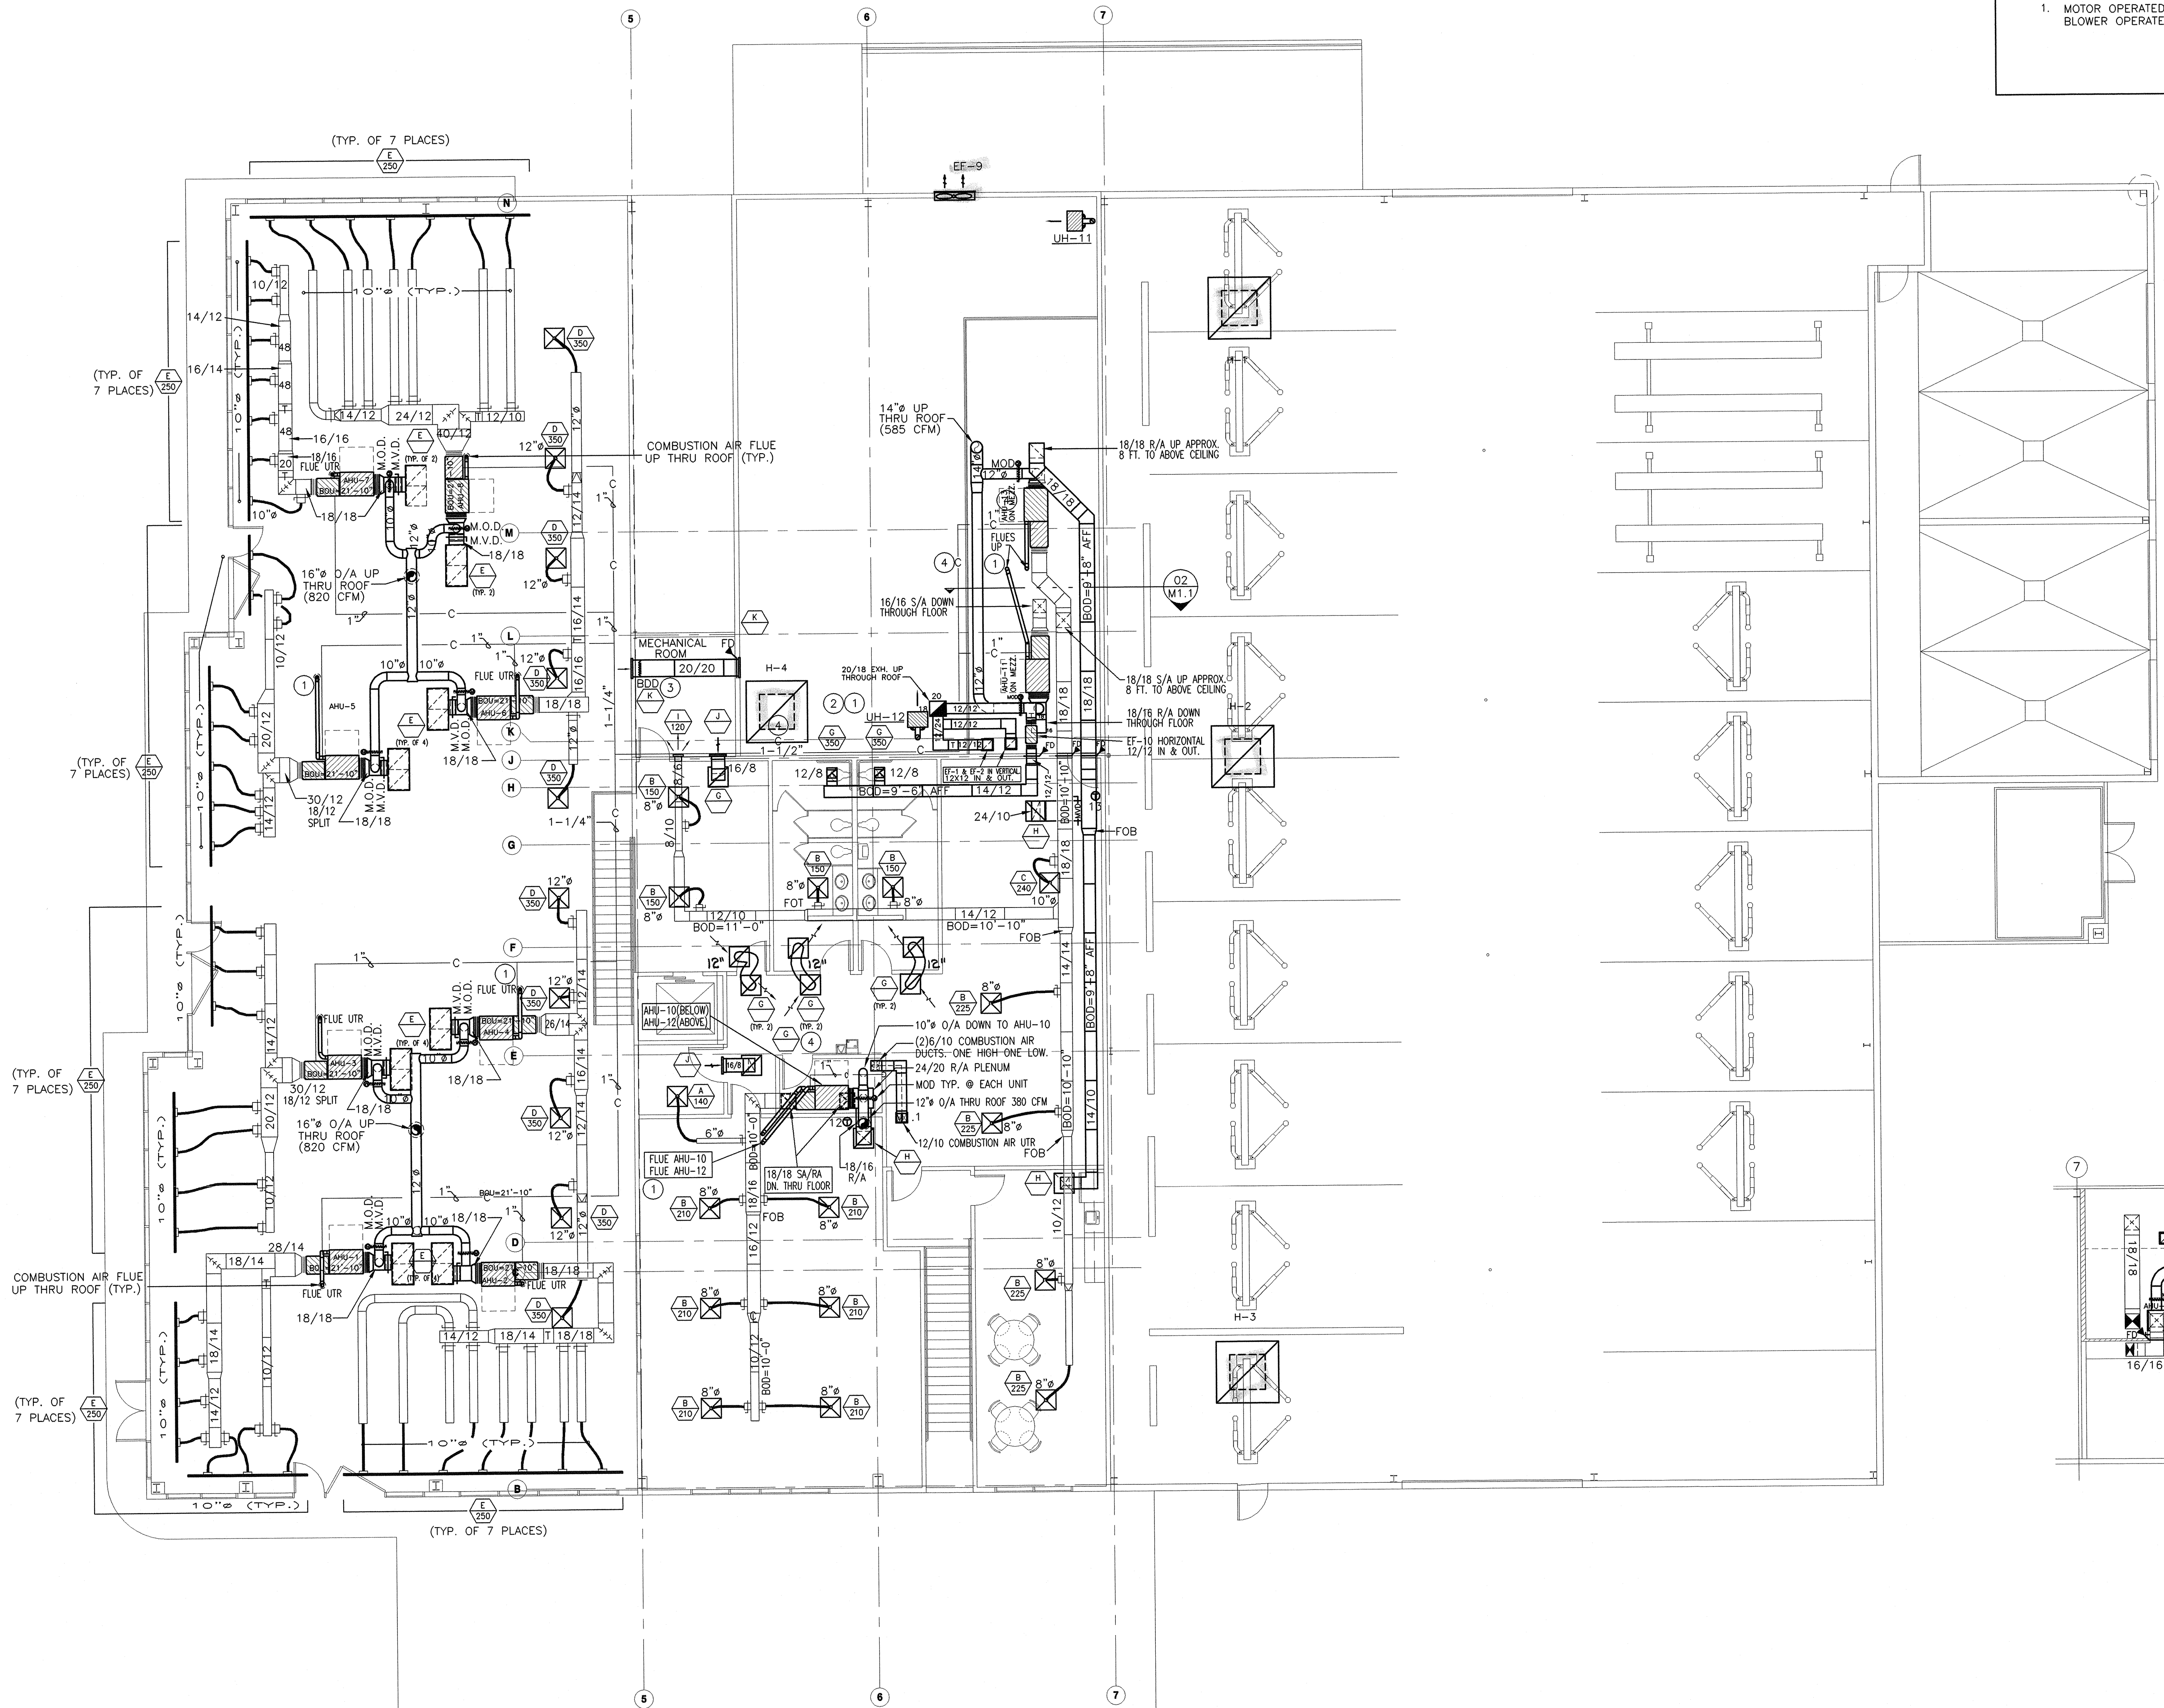


01 SECOND FLOOR - H.V.A.C. PLAN
SCALE: 1/8" = 1'-0"

AN AUTOMOTIVE DEALERSHIP

ROGER BEASLEY VOLVO

INTERSTATE HIGHWAY 35 SOUTH
GEORGETOWN, TEXAS

ELISSAER
ARCHITECTURAL
INC.

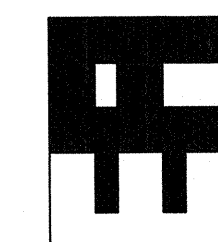

ARCHITECTURE AND PLANNING
P.O. BOX 833 GEORGETOWN, TX 78627
(512) 530-5555 FAX (512) 530-2818 www.elisaer.com

CONSULTANT SEAL:

MECHANICAL
TECHNICAL
SERVICES, L.P.
COMFORT USA
SYSTEMS
A Comfort Systems USA Company

DATE: 28, July 2003

Preliminary Plan
Not For Construction

REVISION DATE:



11/19/02

SHOP
DRAWING

PROJECT NO.
M-Tech #2406

SHEET NO.

M1.1

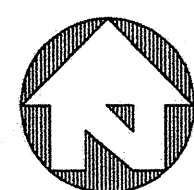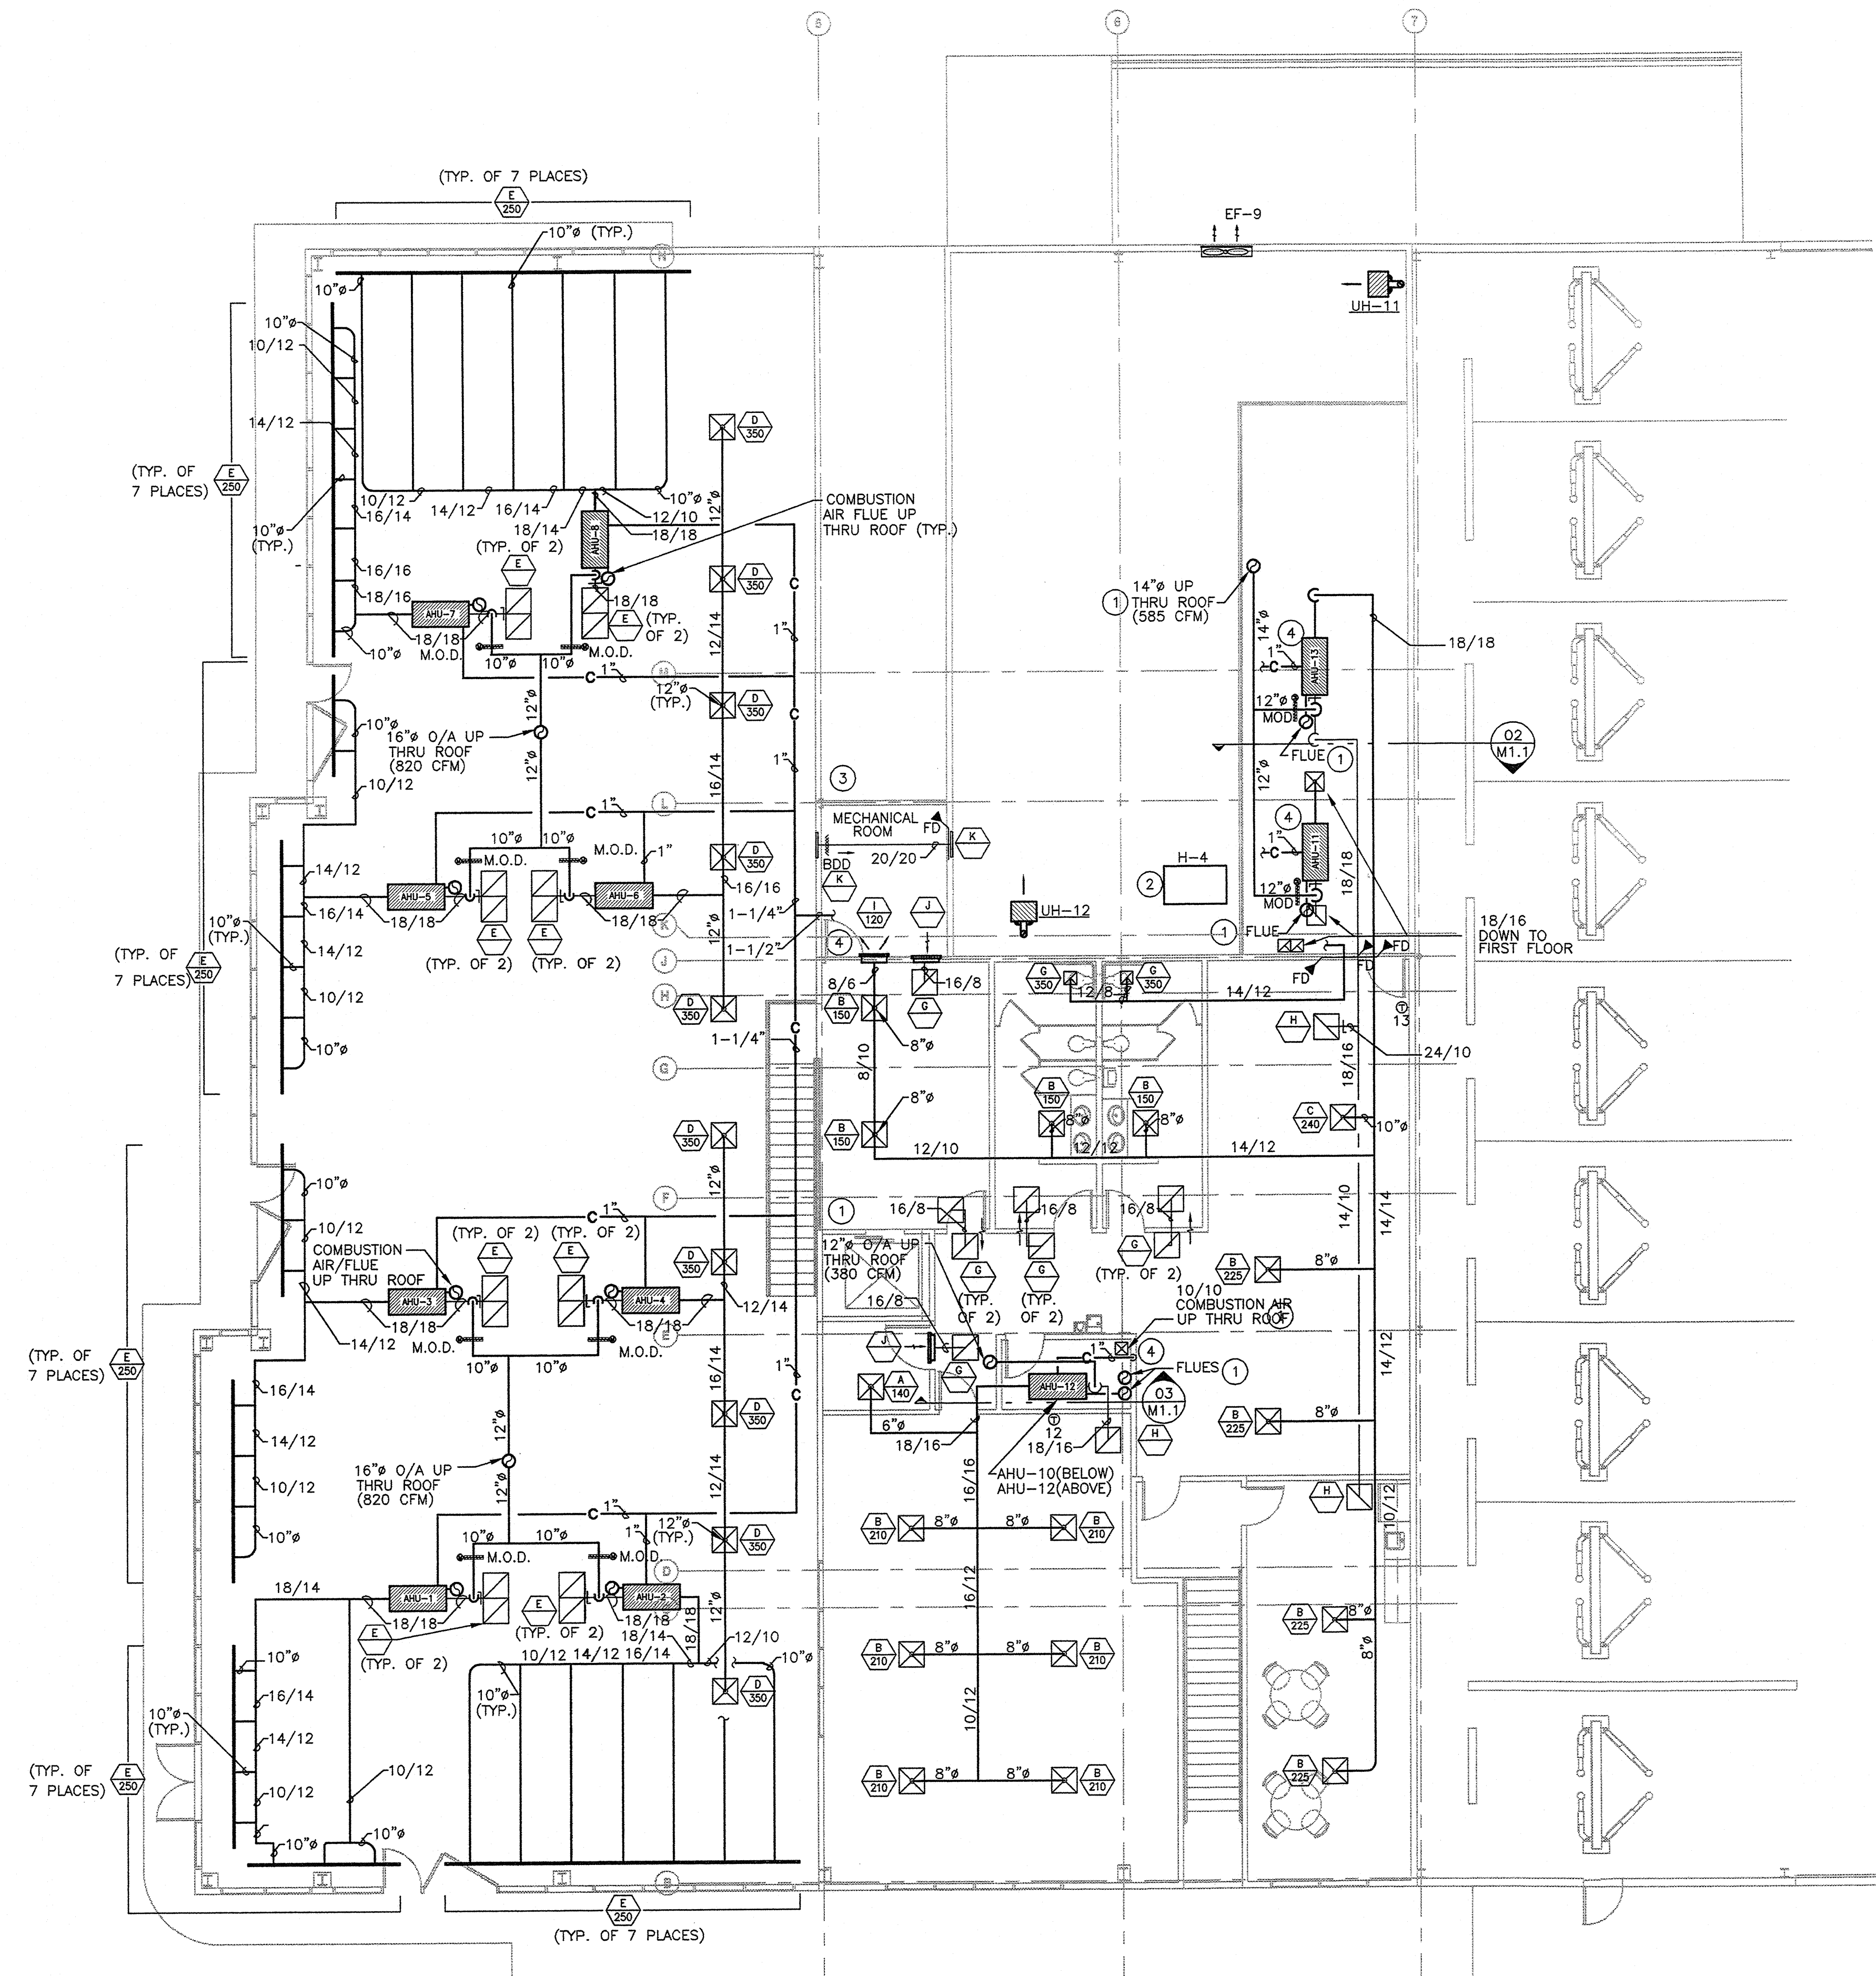

01 SECOND FLOOR - H.V.A.C. PLAN
SCALE: 1/8" = 1'-0"


KEYED NOTES

THESE NOTES APPLY TO THIS SHEET ONLY


- ① FLUES TO BE 10'-0" MINIMUM FROM OUTSIDE AIR INTAKE.
- ② AIR INTAKE/COMBUSTION AIR HOOD, 10,000 CFM @ 0.1" WC. GREENHECK "FABRA HOOD" OR EQUAL.
- ③ INSTALL BACKDRAFT DAMPER IN RELIEF DUCT. SET COUNTER BALANCE @ 0.1" WC.
- ④ ROUTE CONDENSATE DRAIN TO INDIRECT WASTE RECEPTOR.

SEQUENCE OF OPERATIONS

1. MOTOR OPERATED DAMPERS IN OUTSIDE AIR DUCT OPEN WHEN AIR HANDLER SUPPLY BLOWER OPERATES, CLOSES WHEN AHU BLOWER OFF.

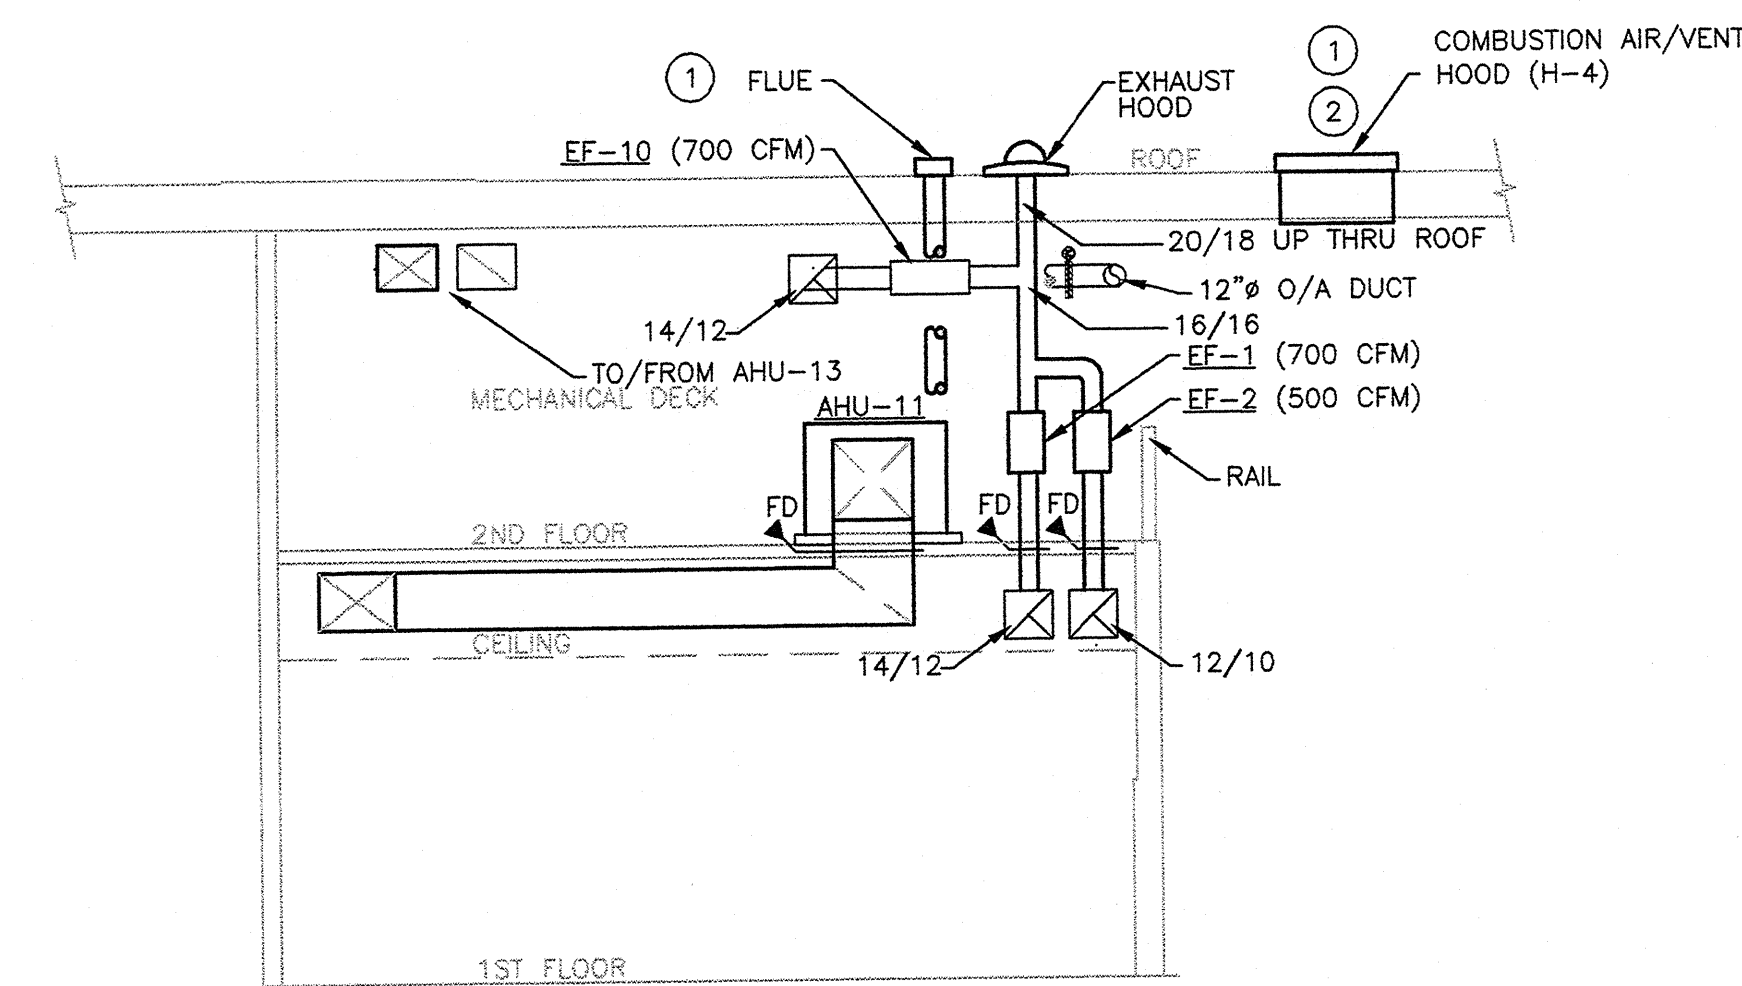

02 SECTION
SCALE: N.T.S.

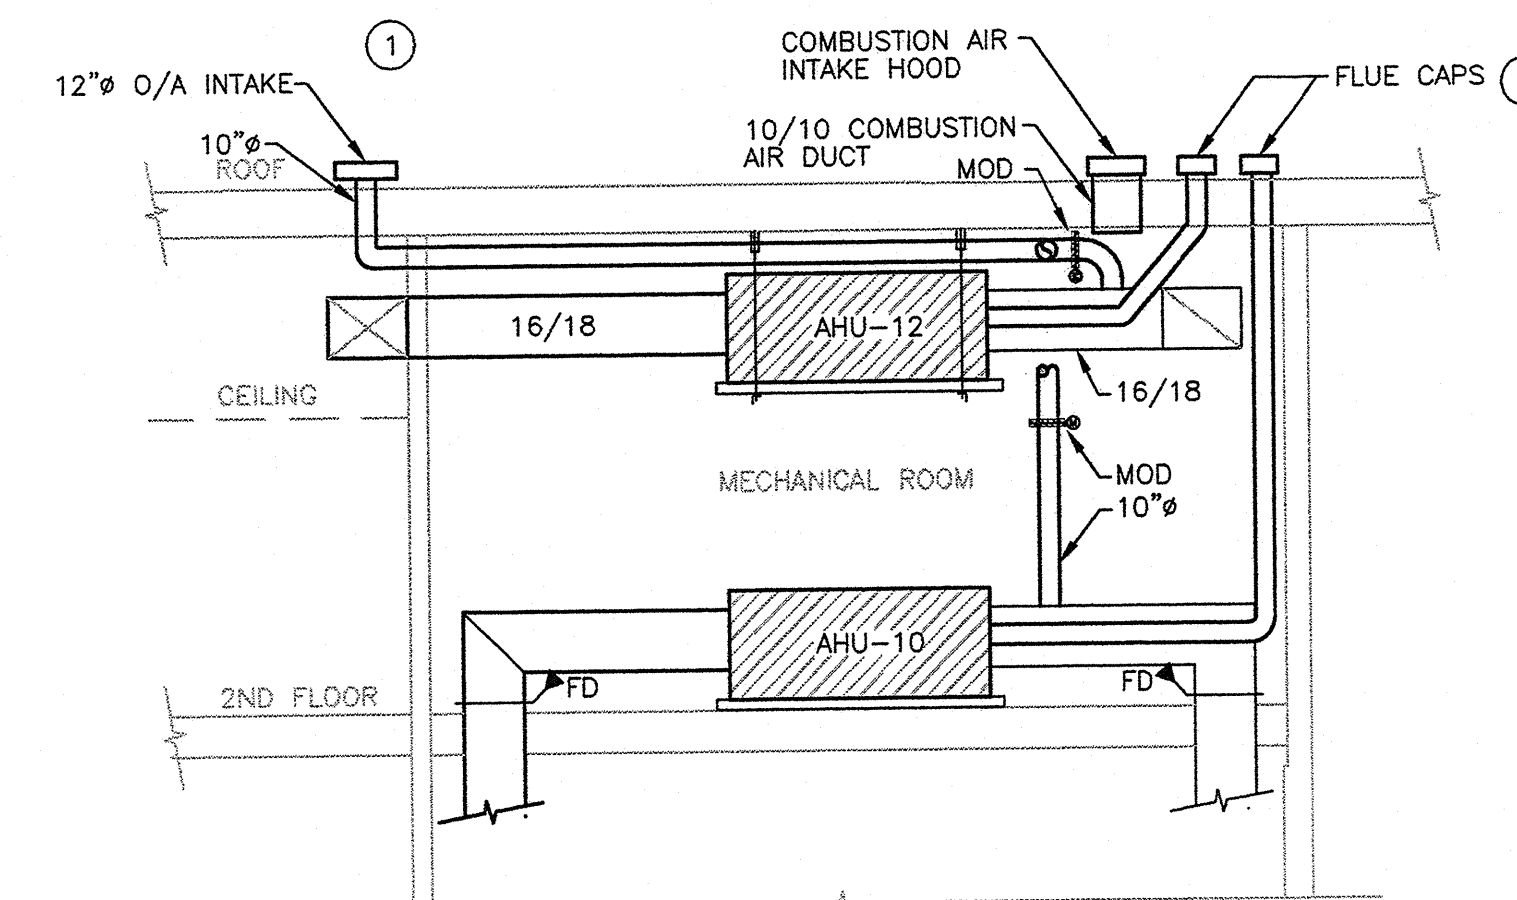

03 AHU-10/12-SECTION
SCALE: N.T.S.

**MYERS &
ASSOCIATES**

This document, the ideas and designs incorporated herein are and shall remain the property of Myers & Associates. These documents are not to be used or altered, in whole or in part, for other than the original intended use, nor are they to be assigned to any third party without written permission from Myers & Associates. ©

M & A Job no.: 01-016


AN AUTOMOTIVE DEALERSHIP

ROGER BEASLEY VOLVO

INTERSTATE HIGHWAY 35 SOUTH
GEORGETOWN, TEXAS

**ELSASSER
ARCHITECTURAL
INC.**
ARCHITECTURE AND PLANNING
P.O. BOX 533 GEORGETOWN, TX 78627
619 850-5553 FAX (619) 850-2618 www.elsa-h.com

CONSULTANT SEAL:

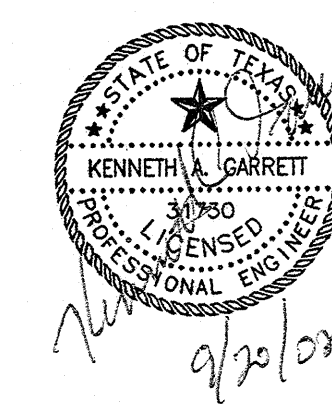

DATE: 04/20/02

REVISION DATE:

PROJECT NO.
020008

SHEET NO.

M1.1

AIR HANDLING UNIT SCHEDULE (GAS FURNACE)																						
MARK	MANUFACTURER AND MODEL NUMBER		SERVICE	TYPE	OUTSIDE AIR (CFM)	SUPPLY FAN PERFORMANCE					FURNACE			COOLING COIL							REMARKS	
						CFM	ESP	MAX FAN RPM	BHP	HP	ELEC. SVC.	FUEL TYPE	INPUT / CFH	OUTPUT/ BTUH	EADB/EAWB	LADB/LAWB	TOTAL MBH	SENS. MBH	MCA	MOCp		WEIGHT
AHU-1	TRANE	TUX120C960D-TXC049C4HPD	SHOWROOM	HORIZ./SPLIT	205	1750	0.75			1.00	115V/1ø	NAT. GAS	120	112,000	79.0 / 64.5	55.0 / 54.9	39,900	36,000	14.5	20.0	200	1,2,3,5,6,7
AHU-2	TRANE	TUX120C960D-TXC049C4HPD	SHOWROOM	HORIZ./SPLIT	205	1750	0.75			1.00	115V/1ø	NAT. GAS	120	112,000	79.0 / 64.5	55.0 / 54.9	39,900	36,000	14.5	20.0	200	1,2,3,5,6,7
AHU-3	TRANE	TUX120C960D-TXC049C4HPD	SHOWROOM	HORIZ./SPLIT	205	1750	0.75			1.00	115V/1ø	NAT. GAS	120	112,000	79.0 / 64.5	55.0 / 54.9	39,900	36,000	14.5	20.0	200	1,2,3,5,6,7
AHU-4	TRANE	TUX120C960D-TXC049C4HPD	SHOWROOM	HORIZ./SPLIT	205	1750	0.75			1.00	115V/1ø	NAT. GAS	120	112,000	79.0 / 64.5	55.0 / 54.9	39,900	36,000	14.5	20.0	200	1,2,3,5,6,7
AHU-5	TRANE	TUX120C960D-TXC049C4HPD	SHOWROOM	HORIZ./SPLIT	205	1750	0.75			1.00	115V/1ø	NAT. GAS	120	112,000	79.0 / 64.5	55.0 / 54.9	39,900	36,000	14.5	20.0	200	1,2,3,5,6,7
AHU-6	TRANE	TUX120C960D-TXC049C4HPD	SHOWROOM	HORIZ./SPLIT	205	1750	0.75			1.00	115V/1ø	NAT. GAS	120	112,000	79.0 / 64.5	55.0 / 54.9	39,900	36,000	14.5	20.0	200	1,2,3,5,6,7
AHU-7	TRANE	TUX120C960D-TXC049C4HPD	SHOWROOM	HORIZ./SPLIT	205	1750	0.75			1.00	115V/1ø	NAT. GAS	120	112,000	79.0 / 64.5	55.0 / 54.9	39,900	36,000	14.5	20.0	200	1,2,3,5,6,7
AHU-8	TRANE	TUX120C960D-TXC049C4HPD	SHOWROOM	HORIZ./SPLIT	205	1750	0.75			1.00	115V/1ø	NAT. GAS	120	112,000	79.0 / 64.5	55.0 / 54.9	39,900	36,000	14.5	20.0	200	1,2,3,5,6,7
AHU-9	TRANE	TUX120C960D-TXC049C4HPD	SHOWROOM	HORIZ./SPLIT	205	1750	0.75			1.00	115V/1ø	NAT. GAS	120	112,000	79.0 / 64.5	55.0 / 54.9	39,900	36,000	14.5	20.0	200	1,2,3,5,6,7
AHU-10	TRANE	TUD140C960K-TXC060C5HPC	SERVICE (1ST FLR)	HORIZ./SPLIT	240	1800	1.00			1.50	208V/1ø	NAT. GAS	160	130,000	78.9 / 64.5	55.0 / 54.4	41,600	35,600	15.0	20.0	250	2,3,4,7
AHU-11	TRANE	TUD140C960K-TXC049C4HPD	PARTS/BREAK (1ST FLR)	HORIZ./SPLIT	265	1400	1.00			1.50	208V/1ø	NAT. GAS	160	130,000	80.1 / 66.0	56.0 / 55.5	33,400	27,200	9.0	20.0	130	2,3,4,7
AHU-12	TRANE	TUX080C960D-TXC036C4HPC	G. MGR / CONF (2ND FLR)	HORIZ./SPLIT	140	1000	0.60			0.75	115V/1ø	NAT. GAS	80	75,000	78.6 / 64.6	55.0 / 54.4	25,000	21,000	9.0	20.0	130	2,3,4,5,7
AHU-13	TRANE	TUD140C960K-TXC060C5HPC	OFF / RR (2ND FLR)	HORIZ./SPLIT	320	1860	1.00			1.50	208V/1ø	NAT. GAS	160	130,000	79.5 / 65.2	55.0 / 54.3	51,800	42,800	15.0	20.0	250	2,3,4,7

- REMARKS:
1. PROVIDE WITHOUT FILTER.

2. PROVIDE HORIZONTAL CONFIGURATION.

3. PROVIDE WITH VIBRATION ISOLATORS.

4. PROVIDE FLAT FILTER.

5. PROVIDE 2-SPEED BLOWER.

6. PROVIDE SMOKE DETECTORS IN SUPPLY DUCT. TIE TO FIRE ALARM SYSTEM.

7. PROVIDE LIQUID LINE SOLENOID VALVE AT AHU THAT OPENS WHEN COMPRESSOR STARTS.

CONDENSING UNIT SCHEDULE- AIR CONDITIONING														
MARK	SERVICE	COOLING CAPACITY MBH	MINIMUM SEER	AMBIENT TEMP. *F	COMPRESSOR DATA			FAN DATA		MCA	MOCp	REFRIG.	MANUFACTURER MODEL NUMBER	REMARKS
					(V/PH/Hz)	LRA	RLA	(V/PH/Hz)	FLA					
CU-1	SHOWROOM	46.6	10.8	105	208/1Ø	135	25.7		0.7	32.8	50	R-22	TRANE 2T1B0048A100	1
CU-2	SHOWROOM	46.6	10.8	105	208/1Ø	135	25.7		0.7	32.8	50	R-22	TRANE 2T1B0048A100	1
CU-3	SHOWROOM	46.6	10.8	105	208/1Ø	135	25.7		0.7	32.8	50	R-22	TRANE 2T1B0048A100	1
CU-4	SHOWROOM	46.6	10.8	105	208/1Ø	135	25.7		0.7	32.8	50	R-22	TRANE 2T1B0048A100	1
CU-5	SHOWROOM	46.6	10.8	105	208/1Ø	135	25.7		0.7	32.8	50	R-22	TRANE 2T1B0048A100	1
CU-6	SHOWROOM	46.6	10.8	105	208/1Ø	135	25.7		0.7	32.8	50	R-22	TRANE 2T1B0048A100	1
CU-7	SHOWROOM	46.6	10.8	105	208/1Ø	135	25.7		0.7	32.8	50	R-22	TRANE 2T1B0048A100	1
CU-8	SHOWROOM	46.6	10.8	105	208/1Ø	135	25.7		0.7	32.8	50	R-22	TRANE 2T1B0048A100	1
CU-9	SHOWROOM	46.6	10.8	105	208/1Ø	135	25.7		0.7	32.8	50	R-22	TRANE 2T1B0048A100	1
CU-10	SERVICE (1ST FLR)	57.5	12.0	105	208/1Ø	169	28.8		1.3	37.4	60	R-22	TRANE 2T1B0042A100	1
CU-11	PARTS/BREAK (1ST FLR)	42.5	12.0	105	208/1Ø	115	19.9		0.7	26.2	45	R-22	TRANE 2T1B0042A100	1
CU-12	G. MGR / CONF (2ND FLR)	29.4	11.0	105	208/1Ø	65	11.7		0.5	15.3	25	R-22	TRANE 2T1B0030A100	1
CU-13	OFF / RR (2ND FLR)	57.5	12.0	105	208/1Ø	169	28.8		1.3	37.4	60	R-22	TRANE 2T1B0060A100	

- NOTES:
1. PROVIDE 2-SPEED COMPRESSOR.

FAN SCHEDULE													
MARK	PERFORMANCE						ELECTRICAL				WEIGHT	MANUFACTURER AND MODEL NUMBER	REMARKS
	SERVICE	TYPE	LOCATION	CFM	ESP	RPM	BHP	MOTOR HP	RPM	SERVICE			
EF-1	SHOWROOM R/R	CENTRIFUGAL	INLINE	700	1.00	2,376	0.36	1/2	3450	115V/1ø	125	COOK #80SQN-B	1,3,5
EF-2	SERVICE R/R	CENTRIFUGAL	INLINE	500	1.00	2,040	0.24	1/2	3450	115V/1ø	125	COOK #70SQN-B	1,3,5
EF-3	SERVICE BAY	PROPELLER	WALL	6,000	0.25	732		1/2		115V/1ø		COOK #30XMW	3,4
EF-4	SERVICE BAY	PROPELLER	WALL	6,000	0.25	732		1/2		115V/1ø		COOK #30XMW	3,4
EF-5	SERVICE BAY	PROPELLER	WALL	6,000	0.25	732		1/2		115V/1ø		COOK #30XMW	3,4
EF-6	SERVICE BAY	PROPELLER	WALL	6,000	0.25	732		1/2		115V/1ø		COOK #30XMW	3,4
EF-7	SERVICE BAY	PROPELLER	WALL	6,000	0.25	732		1/2		115V/1ø		COOK #30XMW	3,4
EF-8	SERVICE BAY	PROPELLER	WALL	6,000	0.25	732		1/2		115V/1ø		COOK #30XMW	3,4
EF-9	PARTS STORAGE	PROPELLER	WALL	10,000	0.25	454		3/4		115V/1ø		COOK #42XMW	3,4
F-1,F-2	SERVICE BAY	PROPELLER	COLUMN	6,900	0.00	1140	0.28	1/3	1140	115V/1ø	240	Redd-i, Inc. MCD30 ~ 1/3	2,6
SF-1	WASH BAYS	CENTRIFUGAL	CABINET	1,200	0.75	1430	0.32	1/2		115V/1ø	80	COOK #SDB-120	3,5
EF-10	2ND FLR. R/R	CENTRIFUGAL	INLINE	700	1.00	2376	0.36	1/2	3450	115V/1ø	125	COOK #80SQN-B	1,3,5

- REMARKS:
1. FURNISH WITH BACKDRAFT DAMPERS.

2. DIRECT DRIVE

3. BELT DRIVE

4. PROVIDE WITH GRAVITY SHUTTER, MOUNTING FRAME FOR FLUSH MOUNT ON EXTERIOR AND GUARD.

5. PROVIDE RUBBER-IN-SHEAR VIBRATION ISOLATORS

6. FURNISH WITH STEEL COLUMN SWIVEL MOUNT.

GAS DUCT HEATER SCHEDULE											
MARK	TYPE	SERVICE	CFM	DUCT SIZE	S.P.	FUEL TYPE	TEMP. RISE	INPUT (BTUH)	OUTPUT (BTUH)	FLUE SIZE	MANUFACTURER MODEL NO.
GDH-1	DUCT FURNACE	WASH. BAYS	1200	15-1/2 X 19	0.3	NAT. GAS	60°F	100,000	80,000	4"	STERLING QVED100A2N2AA100

REMARKS:

OUTSIDE AIR CALCULATION					
AREA SERVED	ZONE	SQUARE FEET	CFM/FT2	REQ'D O/A	ACTUAL O/A
SHOWROOM/VEH. MGR	1 & 4	6047	0.30	1818	1845
SERVICE	2	1695	0.14	240	240
PARTS/BREAK	3	1880	0.14	265	265
GEN. MGR/CONFERENCE	5	1026	0.14	140	140
OFFICE	6	2288	0.14	320	320

EXHAUST AIR CALCULATION					
AREA SERVED	SQUARE FEET	CFM/FT2	REQ'D EXH. CFM	SUPPLIED EXH. CFM	
1ST FL. RESTROOM	336	2.0	672	700	
2ND FL. RESTROOM	336	2.0	672	700	
SHOP MENS RESTROOM	182	2.0	364	400	
SHOP WOMENS RESTROOM	40	2.0	80	100	

AIR DEVICE SCHEDULE											
MARK	NECK SIZE	FRAME SIZE	FRAME TYPE	VOLUME DAMPER	SUPPLY	RETURN	EXHAUST	REMARKS		FLEX.	
A	6"ø	24 X 24	LAY-IN	●	●			TITUS TDC			
B	8"ø	24 X 24	LAY-IN	●	●			TITUS TDC			
C	10"ø	24 X 24	LAY-IN	●	●			TITUS TDC			
D	12"ø	24 X 24	LAY-IN	●	●			TITUS TDC			
E	10"ø	3-3/4"	SLOT	●	●			TITUS ML-38 MPI-38 INSUL. PLENUM			
F	22 X 22	24 X 24	LAY-IN			●		TITUS 50FF			
G	14 X 14	24 X 24	LAY-IN			●		TITUS 50F			
H	22 X 22	24 X 24	LAY-IN			●		TITUS 50F			
I	8 X 6	10 X 8	SIDEWALL	●	●			TITUS 300RS			
J	8 X 16	10 X 18	SIDEWALL			●		TITUS 50F			
K	18 X 16	20 X 18	SIDEWALL			●		TITUS 50F			
L	10 X 6	12 X 8	SIDEWALL	●	●			TITUS 50F			

- NOTES:
1. COORDINATE EXACT LOCATION OF DIFFUSERS WITH ARCHITECTURAL REFLECTED CEILING PLAN.

2. ALL SUPPLY DIFFUSERS SHALL BE 4-WAY THROW UNLESS NOTED OTHERWISE.

3. ALL FLEX SHALL BE SIZED AS SCHEDULED UNLESS NOTED OTHERWISE.

4. ALL DIFFUSERS SHALL BE OFF-WHITE UNLESS NOTED OTHERWISE.

5. VERIFY FRAME TYPE WITH ACTUAL CEILING TYPE PRIOR TO PURCHASE OF AIR DEVICES.

6. ALL VOLUME DAMPERS SHALL BE OPPOSED BLADE TYPE.

GENERAL NOTES

- A. THE CONTRACTOR IS TO VISIT THE SITE PRIOR TO BID TO FAMILIARIZE HIMSELF WITH ALL CONDITIONS AS THEY EXIST. SUBMISSION OF BID INDICATES THE CONTRACTOR'S UNDERSTANDING OF EXISTING CONDITIONS AND HIS WILLINGNESS TO WORK WITH THESE CONDITIONS. NO ADDITIONAL TIME OR MONEY WILL BE ALLOTTED DUE TO LACK OF COORDINATION WITH EXISTING CONDITIONS OR OTHER TRADES.

B. ALL WORK SHALL COMPLY WITH THE APPLICABLE LOCAL, STATE, & FEDERAL CODES AND ORDINANCES. FOLLOW RECOMMENDED PRACTICES AS SET DOWN BY ASME, SMACNA, ASHRAE, NFPA, UNIFORM BUILDING CODE, UNIFORM MECHANICAL CODE, UNIFORM PLUMBING CODE, NATIONAL ELECTRICAL CODE, AGA AND OSHA, AS THEY APPLY TO THIS PROJECT, EXCEPT IN CASES WHERE STATUTES GOVERN.

C. ALL CONTRACTORS SHALL COORDINATE THROUGH THE PROJECT CONSTRUCTION MANAGER.

D. PROVIDE P-TRAP AT EACH UNIT PER THE MANUFACTURER'S RECOMMENDATIONS. ROUTE NEW CONDENSATE DRAIN LINE FROM EACH UNIT TO THE NEAREST DEEP SEAL TRAP ABOVE CEILING OR NEAREST CODE APPROVED POINT OF DISCHARGE. MECHANICAL AND PLUMBING CONTRACTORS ARE TO COORDINATE LOCATION. CONDENSATE PIPING IS TO BE TYPE "M" COPPER WITH WROUGHT COPPER FITTINGS AND INSULATED WITH 3/4" ARMAFLEX TYPE AP. GLUE ALL JOINTS. PROVIDE CLEANOUT PLUG AT END OF EACH MAIN RUN. SLOPE ALL PIPING TO DRAIN AT MINIMUM 1/8" PER FOOT. DRAINS SHALL BE SIZED IN ACCORDANCE WITH EQUIP. CAPACITIES. RE: SPECIFICATIONS. *MINIMUM SIZE OF DRAIN SHALL NOT BE SMALLER THAN DRAIN OUTLET SIZE FOR UNIT

E. ALL DUCT DIMENSIONS SHOWN ARE CLEAR INSIDE DIMENSIONS.

F. TRANSITION FROM DUCT SIZE SHOWN TO EQUIPMENT. ALLOW FOR CLEARANCE BETWEEN STRUCTURAL JOISTS.

G. PROVIDE FLEXIBLE CONNECTIONS AT ALL SUPPLY AND RETURN DUCTS FROM UNITS.

H. TRANSITION FROM EXHAUST DUCT SIZE TO ROOF OPENING SIZE FOR HOODS AND EXHAUST FANS.

I. PROVIDE HEAVY DUTY LOCKABLE PLASTIC THERMOSTAT COVERS.

J. CONFIRM LOCATION & MOUNTING HEIGHT OF EACH THERMOSTAT WITH OWNER PRIOR TO INSTALLATION.

K. COORDINATE PLACEMENT AND SUPPORTS FOR ALL EQUIPMENT WITH STRUCTURAL ENGINEER DURING STRUCTURAL SHOP DRAWING PHASE.

L. BEFORE ANY CUTTING OR TRENCHING OPERATIONS BEGIN, VERIFY WITH OWNER'S REPRESENTATIVE UTILITY COMPANIES AND OTHER INTERESTED PARTIES THAT ALL AVAILABLE INFORMATION HAS BEEN PROVIDED CONCERNING EXISTING UTILITY LOCATION. VERIFY LOCATIONS GIVEN. CONTACT ARCHITECT UPON UNCOVERING UNKNOWN UTILITIES FOR FURTHER DIRECTION. INDICATE ALL UNCOVERED UTILITIES ON RECORD DRAWINGS. COORDINATE ALL UTILITY TIE-INS WITH OWNER.

M. COORDINATE LOCATION OF ALL EQUIPMENT, AIR DEVICES, ETC... WITH ALL OTHER TRADES.

N. FIRE SEAL AROUND ALL PIPING AT PENETRATIONS THROUGH FIRE WALLS, CEILINGS AND TUNNELS. RE: SPECIFICATIONS.

O. INSTALL CLEAN SET OF FILTERS THROUGHOUT AT COMPLETION OF PROJECT.


P. MAINTAIN A MINIMUM OF 30" CLEAR ON ACCESS SIDE OF ALL UNITS.
- R. THE CONTRACTORS SHALL COORDINATE DUCT, PIPING, CONDUIT AND EQUIPMENT SUPPORTS WITH RATED CEILING INSTALLATION PRIOR TO INSTALLATION ON BOTTOM OF STRUCTURE. SEAL ALL PENETRATIONS TO MAINTAIN THE INTEGRITY OF THE FIRE ASSEMBLY.

S. PROVIDE ENGRAVED LABELS FOR ALL EQUIPMENT. LABEL ALL THERMOSTATS TO CORRESPONDING EQUIPMENT NUMBER.


T. THE MECHANICAL CONTRACTOR IS TO COORDINATE THE ELECTRICAL CHARACTERISTICS OF ALL EQUIPMENT WITH THE ELECTRICAL CONTRACTOR PRIOR TO ELECTRICAL ROUGH-IN. NO ADDITIONAL TIME OR MONEY WILL BE ALLOTTED DUE TO LACK OF COORDINATION.

U. THE CONTRACTOR IS TO DEMONSTRATE OPERATION OF A/C UNITS, EXHAUST FANS, AND ALL OTHER MECHANICAL EQUIPMENT AND SYSTEMS TO MAINTENANCE PERSONNEL UPON COMPLETION OF THE PROJECT. THE CONTRACTOR SHALL SUBMIT THREE (3) SETS OF SPARE PARTS LISTS, MANUALS AND OPERATING PROCEDURES FOR ALL EQUIPMENT TO PERSONNEL AT THE TIME OF DEMONSTRATION. PROVIDE OWNER WITH A TYPED LIST OF ALL NEW AND EXISTING EQUIPMENT, INDICATING MANUFACTURER, MODEL NUMBER, SERIAL NUMBER, VOLTAGE, PHASE, EVAPORATOR HP, CONDENSATE FAN HP, ETC.


V. PROVIDE RIGID

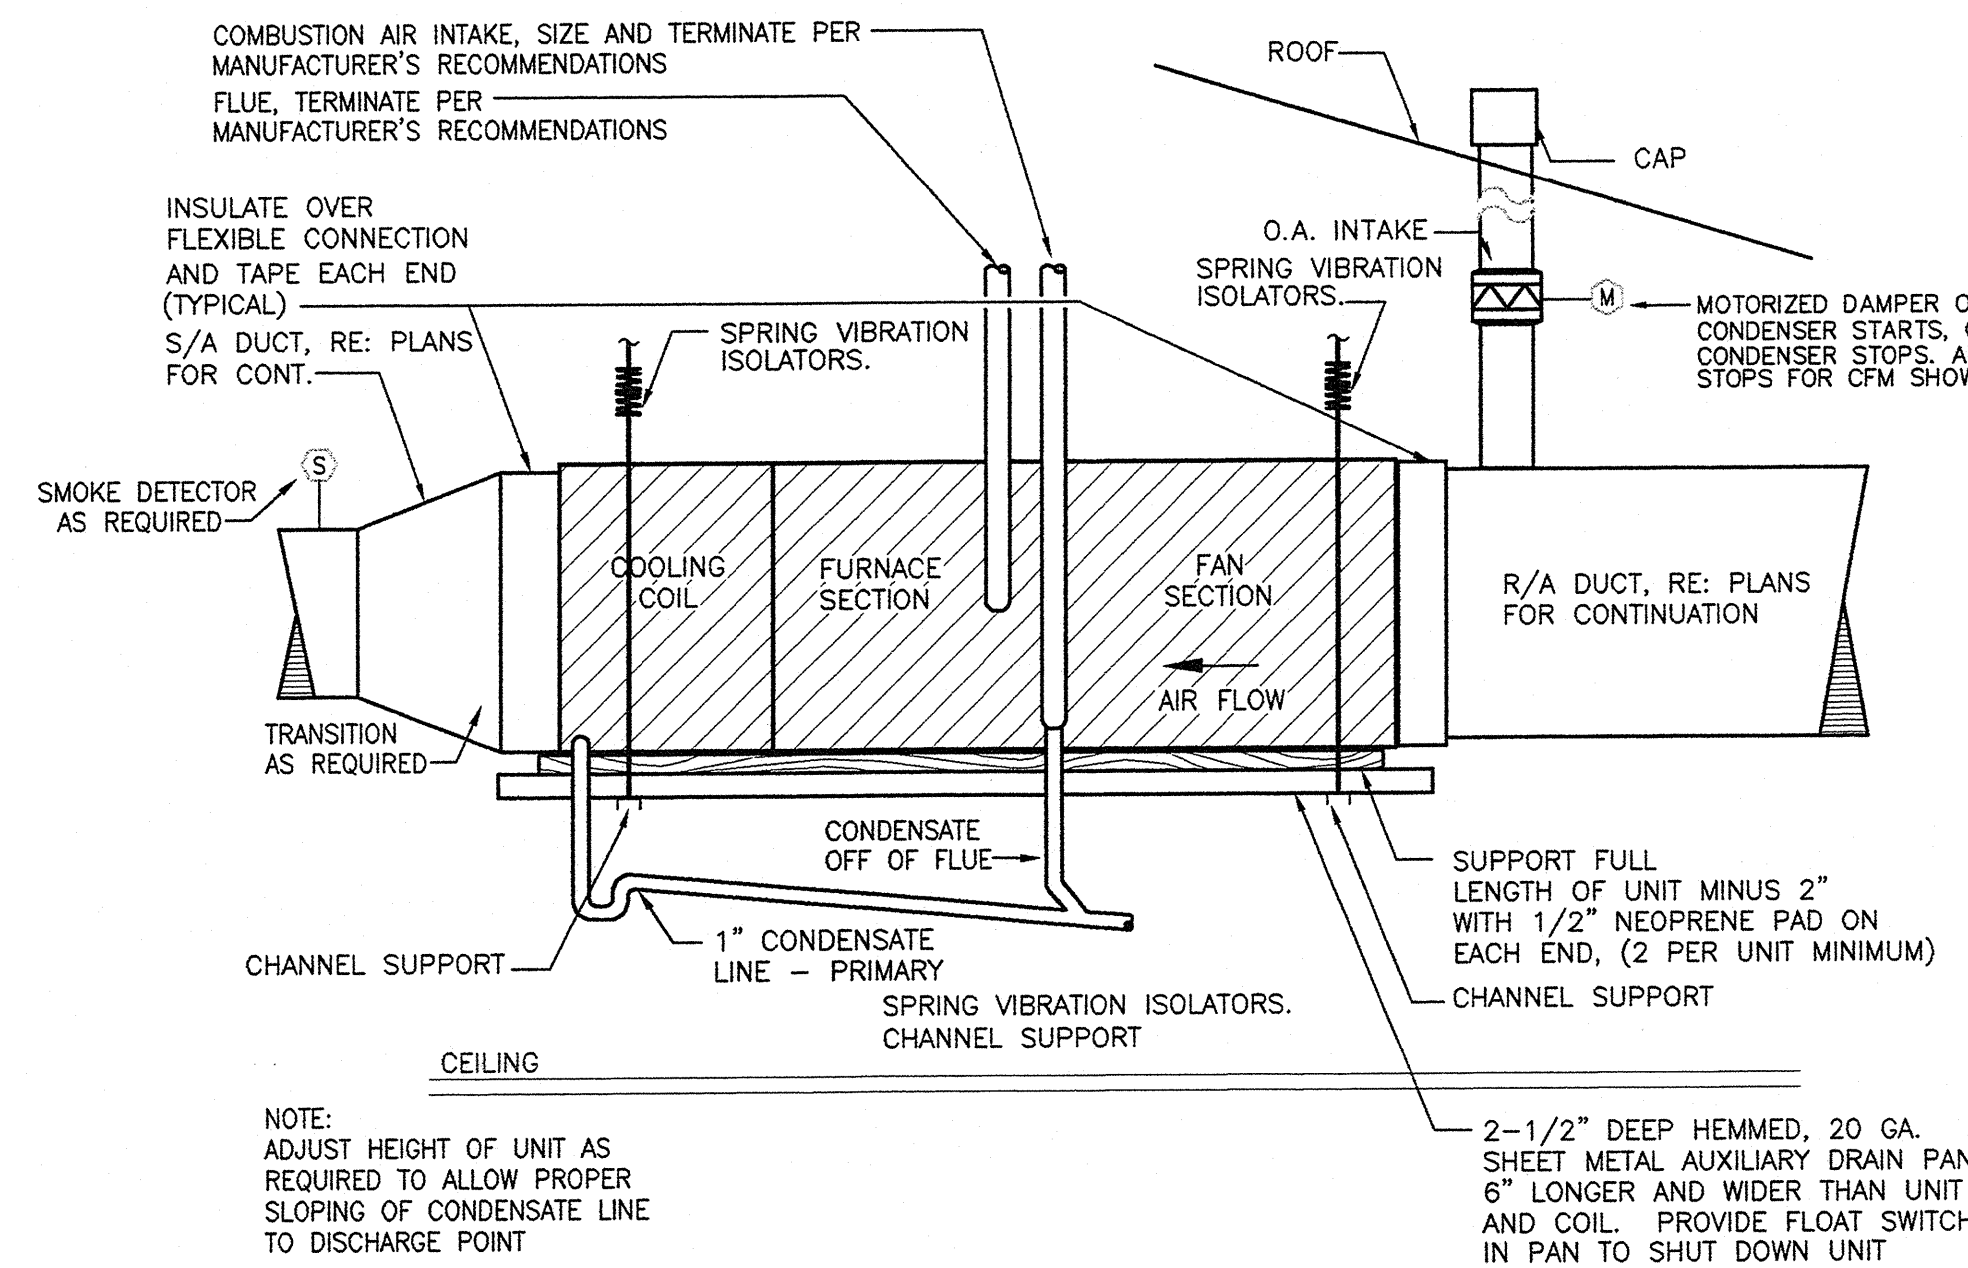


01 HORIZONTAL AHU/FURNACE DETAIL
SCALE: N.T.S.

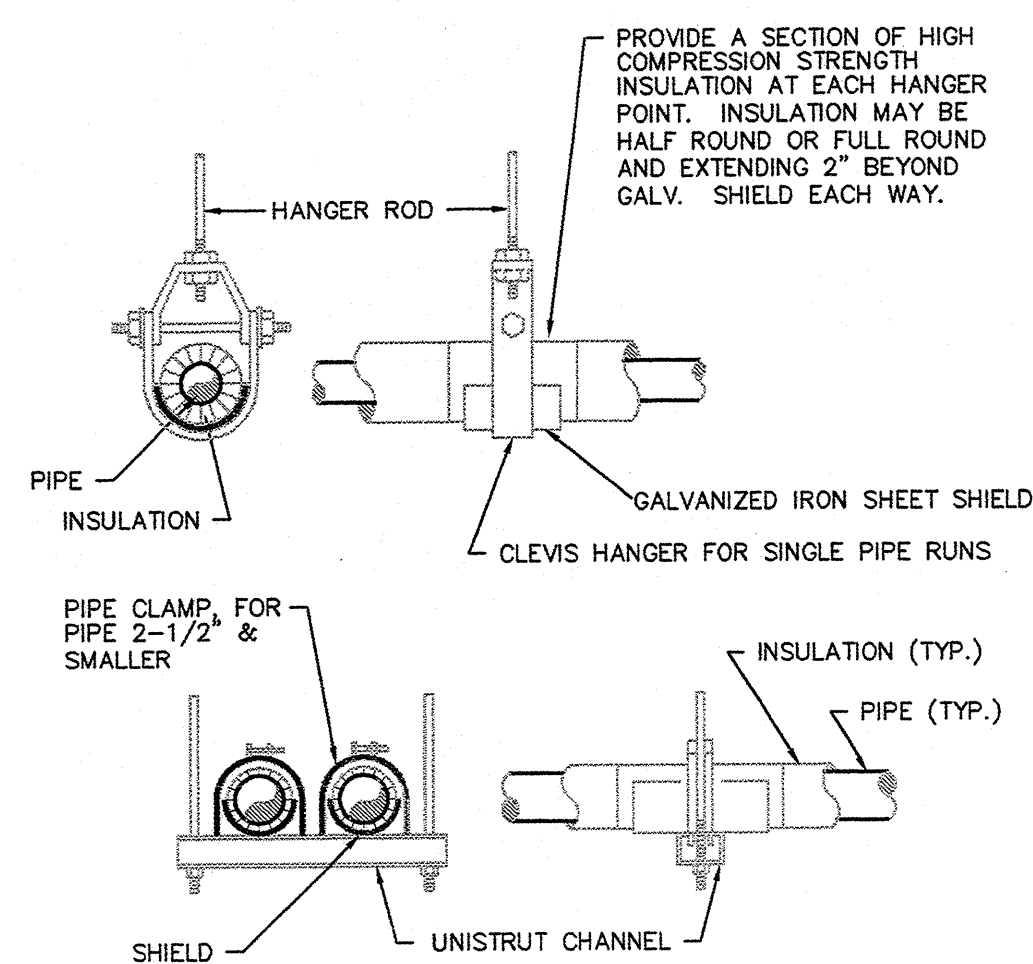


04 PIPING HANGERS AND SUPPORTS
SCALE: N.T.S.

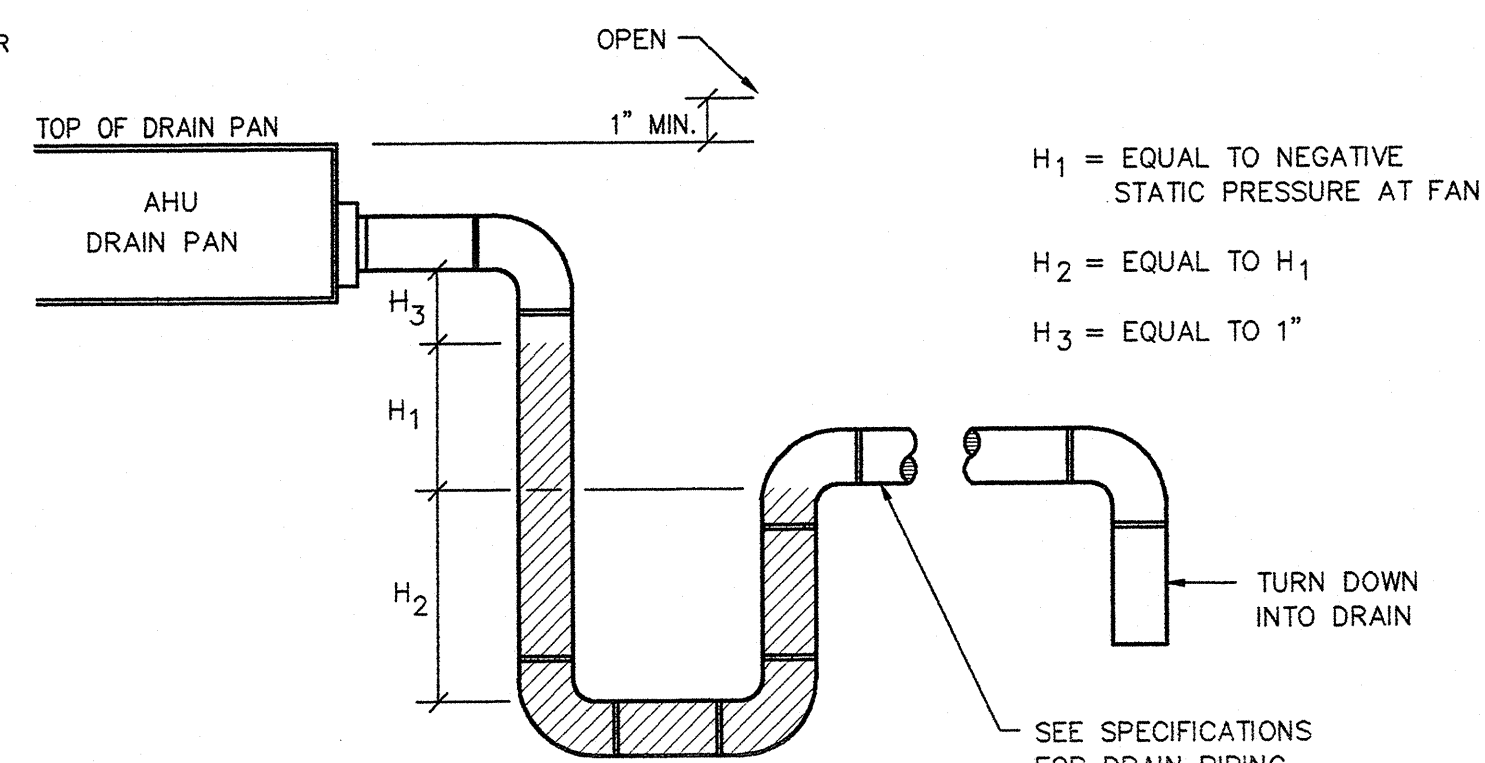


02 DRAW-THRU COND. DRAIN DETAIL
SCALE: N.T.S.

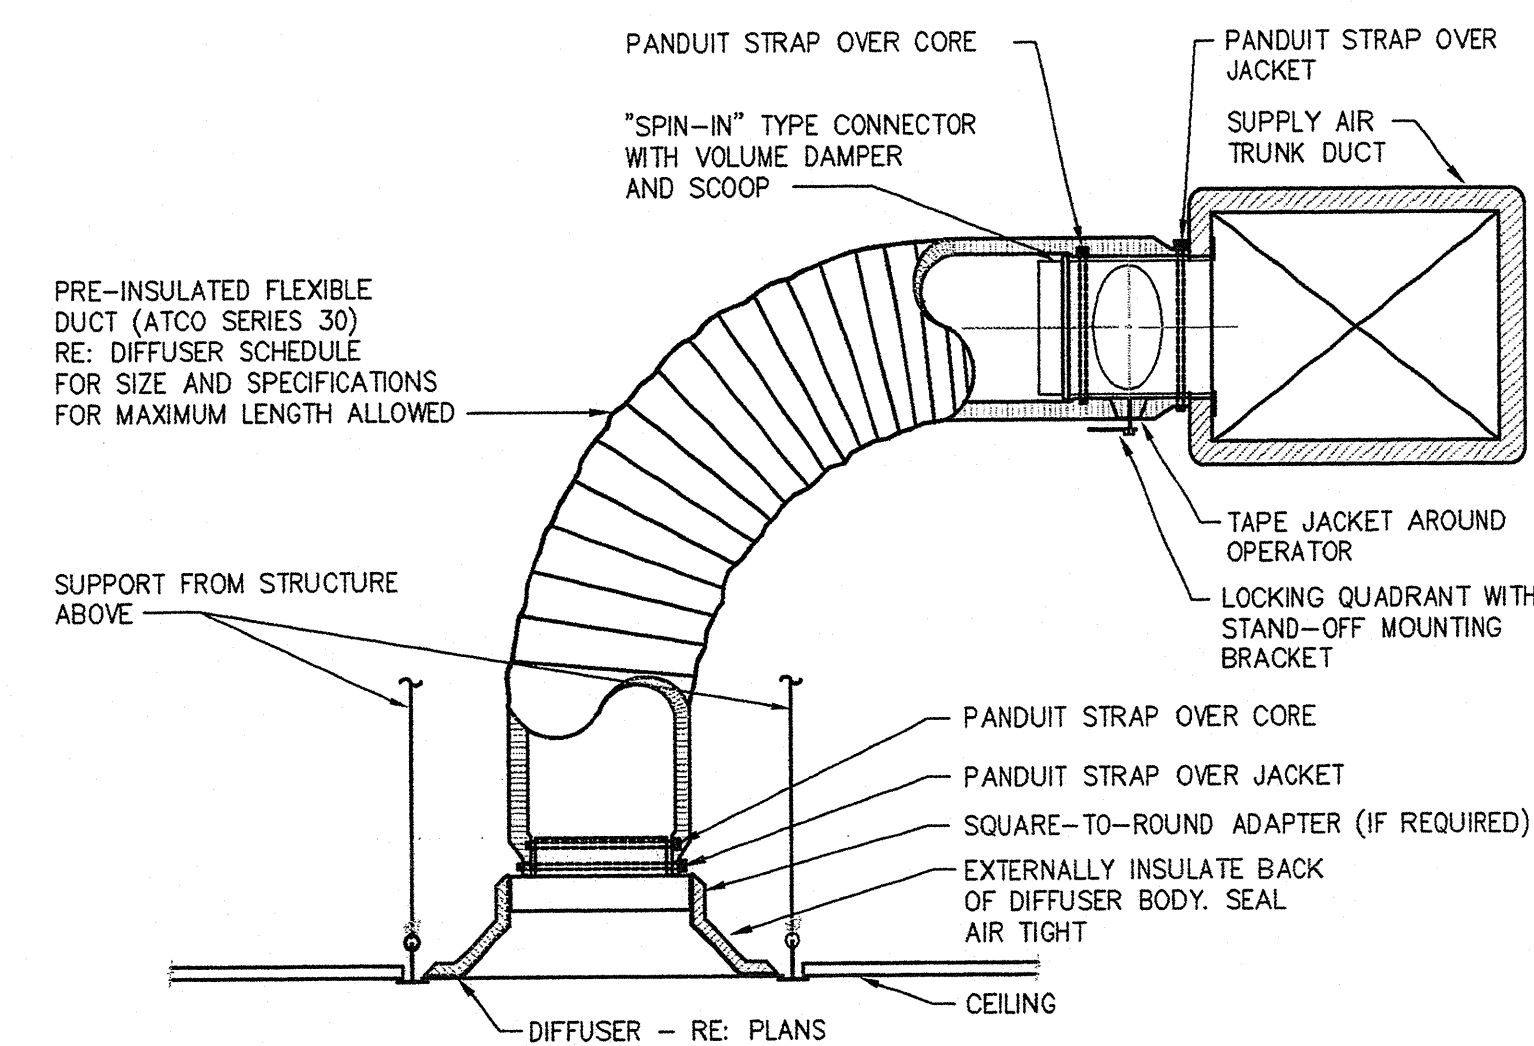

03 CEILING DIFFUSER DETAIL
SCALE: N.T.S.

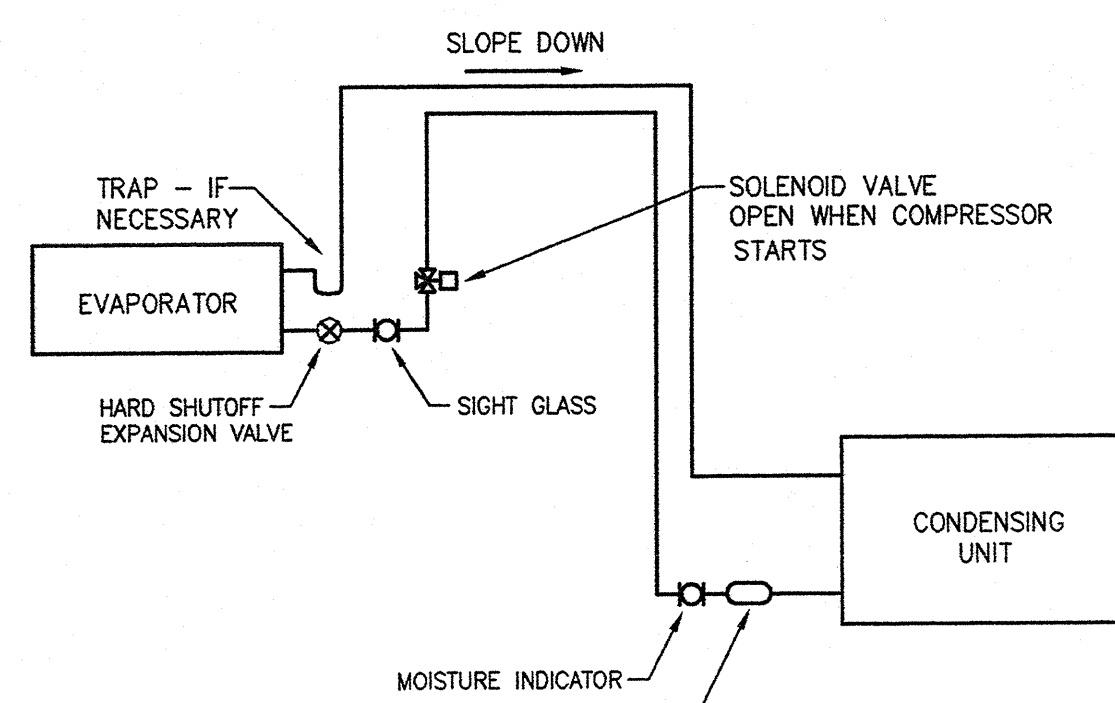

05 REFRIGERANT PIPING DETAIL
SCALE: N.T.S.

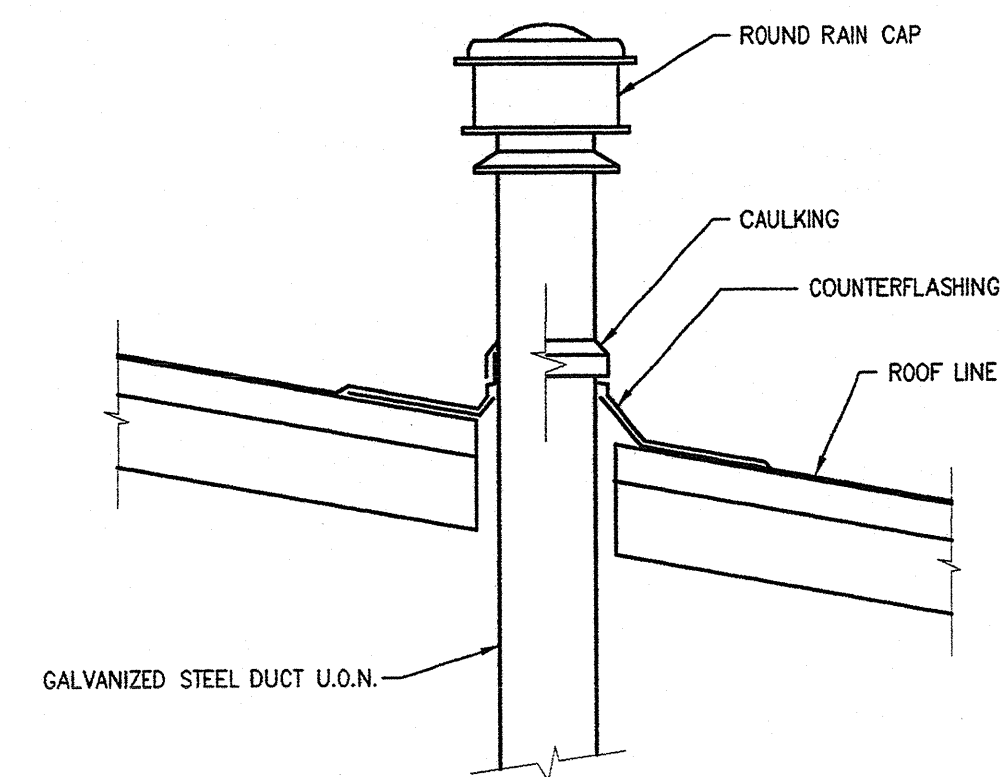

06 EXHAUST VENT/O.A. INTAKE DETAIL
SCALE: N.T.S.

GENERAL NOTES

A. THE CONTRACTOR IS TO VISIT THE SITE PRIOR TO BID TO FAMILIARIZE HIMSELF WITH ALL CONDITIONS AS THEY EXIST. SUBMISSION OF BID INDICATES THE CONTRACTOR'S UNDERSTANDING OF EXISTING CONDITIONS AND HIS WILLINGNESS TO WORK WITH THESE CONDITIONS. NO ADDITIONAL TIME OR MONEY WILL BE ALLOTTED DUE TO LACK OF COORDINATION WITH EXISTING CONDITIONS OR OTHER TRADES. B. ALL WORK SHALL COMPLY WITH THE APPLICABLE LOCAL, STATE, & FEDERAL CODES AND ORDINANCES. FOLLOW RECOMMENDED PRACTICES AS SET DOWN BY ASME, SMACNA, ASHRAE, NFPA, UNIFORM BUILDING CODE, UNIFORM MECHANICAL CODE, UNIFORM PLUMBING CODE, NATIONAL ELECTRICAL CODE, AGA AND OSHA, AS THEY APPLY TO THIS PROJECT, EXCEPT IN CASES WHERE STATUTES GOVERN. C. ALL CONTRACTORS SHALL COORDINATE THROUGH THE PROJECT CONSTRUCTION MANAGER. D. PROVIDE P-TRAP AT EACH UNIT PER THE MANUFACTURER'S RECOMMENDATIONS. ROUTE NEW CONDENSATE DRAIN LINE FROM EACH UNIT TO THE NEAREST DEEP SEAL TRAP ABOVE CEILING OR NEAREST CODE APPROVED POINT OF DISCHARGE. MECHANICAL AND PLUMBING CONTRACTORS ARE TO COORDINATE LOCATION. CONDENSATE PIPING IS TO BE TYPE "M" COPPER WITH WROUGHT COPPER FITTINGS AND INSULATED WITH 3/4" ARMAFLEX TYPE AP. GLUE ALL JOINTS. PROVIDE CLEANOUT PLUG AT END OF EACH MAIN RUN. SLOPE ALL PIPING TO DRAIN AT MINIMUM 1/8" PER FOOT. DRAINS SHALL BE SIZED IN ACCORDANCE WITH EQUIP. CAPACITIES. RE: SPECIFICATIONS. *MINIMUM SIZE OF DRAIN SHALL NOT BE SMALLER THAN DRAIN OUTLET SIZE FOR UNIT E. ALL DUCT DIMENSIONS SHOWN ARE CLEAR INSIDE DIMENSIONS. F. TRANSITION FROM DUCT SIZE SHOWN TO EQUIPMENT. ALLOW FOR CLEARANCE BETWEEN STRUCTURAL JOISTS. G. PROVIDE FLEXIBLE CONNECTIONS AT ALL SUPPLY AND RETURN DUCTS FROM UNITS. H. TRANSITION FROM EXHAUST DUCT SIZE TO ROOF OPENING SIZE FOR HOODS AND EXHAUST FANS. I. PROVIDE HEAVY DUTY LOCKABLE PLASTIC THERMOSTAT COVERS. J. CONFIRM LOCATION & MOUNTING HEIGHT OF EACH THERMOSTAT WITH OWNER PRIOR TO INSTALLATION. K. COORDINATE PLACEMENT AND SUPPORTS FOR ALL EQUIPMENT WITH STRUCTURAL ENGINEER DURING STRUCTURAL SHOP DRAWING PHASE. L. BEFORE ANY CUTTING OR TRENCHING OPERATIONS BEGIN, VERIFY WITH OWNER'S REPRESENTATIVE UTILITY COMPANIES AND OTHER INTERESTED PARTIES THAT ALL AVAILABLE INFORMATION HAS BEEN PROVIDED CONCERNING EXISTING UTILITY LOCATION. VERIFY LOCATIONS GIVEN. CONTACT ARCHITECT UPON UNCOVERING UNKNOWN UTILITIES FOR FURTHER DIRECTION. INDICATE ALL UNCOVERED UTILITIES ON RECORD DRAWINGS. COORDINATE ALL UTILITY TIE-INS WITH OWNER. M. COORDINATE LOCATION OF ALL EQUIPMENT, AIR DEVICES, ECT... WITH ALL OTHER TRADES. N. FIRE SEAL AROUND ALL PIPING AT PENETRATIONS THROUGH FIRE WALLS, CEILINGS AND TUNNELS. RE: SPECIFICATIONS. O. INSTALL CLEAN SET OF FILTERS THROUGHOUT AT COMPLETION OF PROJECT. P. MAINTAIN A MINIMUM OF 30" CLEAR ON ACCESS SIDE OF ALL UNITS.	R. THE CONTRACTORS SHALL COORDINATE DUCT, PIPING, CONDUIT AND EQUIPMENT SUPPORTS WITH RATED CEILING INSTALLATION PRIOR TO INSTALLATION ON BOTTOM OF STRUCTURE. SEAL ALL PENETRATIONS TO MAINTAIN THE INTEGRITY OF THE FIRE ASSEMBLY. S. PROVIDE ENGRAVED LABELS FOR ALL EQUIPMENT. LABEL ALL THERMOSTATS TO CORRESPONDING EQUIPMENT NUMBER. T. THE MECHANICAL CONTRACTOR IS TO COORDINATE THE ELECTRICAL CHARACTERISTICS OF ALL EQUIPMENT WITH THE ELECTRICAL CONTRACTOR PRIOR TO ELECTRICAL RUN-IN. NO ADDITIONAL TIME OR MONEY WILL BE ALLOTTED DUE TO LACK OF COORDINATION. U. THE CONTRACTOR IS TO DEMONSTRATE OPERATION OF A/C UNITS, EXHAUST FANS, AND ALL OTHER MECHANICAL EQUIPMENT AND SYSTEMS TO MAINTENANCE PERSONNEL UPON COMPLETION OF THE PROJECT. THE CONTRACTOR SHALL SUBMIT THREE (3) SETS OF SPARE PARTS LISTS, MANUALS AND OPERATING PROCEDURES FOR ALL EQUIPMENT TO PERSONNEL AT THE TIME OF DEMONSTRATION. PROVIDE OWNER WITH A TYPED LIST OF ALL NEW AND EXISTING EQUIPMENT, INDICATING MANUFACTURER, MODEL NUMBER, SERIAL NUMBER, VOLTAGE, PHASE, EVAPORATOR HP, CONDENSATE FAN HP, ETC. V. PROVIDE RIGID ROUND SHEETMETAL DUCTWORK FOR DIFFUSER RUN-OUTS GREATER THAN 5 FEET. ALL RIGID ROUND DUCTWORK IS TO BE EXTERNALLY INSULATED. PROVIDE ATCO SERIES 36 OR APPROVED EQUAL FLEXIBLE DUCTWORK. W. FIELD LOCATION AND ROUTE ALL EXHAUST FANS AND EXHAUST DUCTS THAT ARE NOT CLEARLY SHOWN IN THE DRAWINGS. X. ALL DUCTWORK SHALL BE GALVANIZED STEEL WITH 2" EXTERNAL BLANKET WRAP INSULATION. Y. WHERE A BRANCH DUCT IS SHOWN TO CONNECT TO A TRUNK DUCT OF EQUAL DEPTH OR SMALLER, THE BRANCH DUCT SHALL CONNECT TO THE TOP OR BOTTOM OF THE TRUNK DUCT OR A RECTANGULAR TAP WITH EXTRACTOR AND V.D. OF EQUAL GROSS SECTIONAL AREA SHALL BE MADE WITH A TRANSITION. AT CONTRACTORS OPTION, THE TRUNK DUCT MAY BE REVISED IF REVIEWED AND APPROVED BY THE ENGINEER. Z. COMFORT BALANCE ALL HVAC SYSTEMS TO OBTAIN +/- 2 DEGF. VARIATION THROUGHOUT THE SPACE BALANCE IN ACCORDANCE WITH NEBB. CALIBRATE ALL THERMOSTATS. AA. THE DRAWINGS ARE DIAGRAMMATIC ONLY AND SHALL NOT BE SCALED. THE CONTRACTOR IS RESPONSIBLE FOR COORDINATING WITH ALL OTHER TRADES AND WITH EXISTING CONDITIONS. THE CONTRACTOR SHALL NOT INSTALL OR FABRICATE ANY WORK SHOWN UNTIL ALL SUCH WORK IS FULLY COORDINATED. NOT ALL OFFSETS AND FITTINGS ARE SHOWN. PROVIDE OFFSETS AND FITTINGS AS REQUIRED BY FIELD CONDITIONS AT NO ADDITIONAL COSTS TO THE OWNER. BB. GUARANTEE WORK FOR ONE (1) YEAR FROM THE DATE OF FINAL ACCEPTANCE OF THE PROJECT AND DURING THAT PERIOD MAKE GOOD ANY FAULTS OR IMPERFECTIONS THAT MAY ARISE DUE TO DEFECTS OR OMISSIONS IN MATERIALS WORKMANSHIP. CC. SYMBOLS SHOWN ARE ILLUSTRATIVE IN NATURE AND ARE PROVIDED ONLY FOR USE AS REFERENCE. DD. CONTRACTOR TO VERIFY ALL REQUIRED FLOOR/CEILING AND WALL PENETRATIONS. COORDINATE ALL PENETRATIONS WITH ARCHITECT AND STRUCTURAL ENGINEER. EE. CONTRACTOR TO FIELD COORDINATE ALL DUCT SIZES AND LOCATIONS. CONTRACTOR TO INSTALL EQUIVALENT SIZES AND ALTERNATE ROUTINGS WHERE NECESSARY FOR PROPER FIT AND FUNCTION.
---	--

OUTSIDE AIR CALCULATION					
AREA SERVED	ZONE	SQUARE FEET	CFM/FT2	REQ'D O/A	ACTUAL O/A
SHOWROOM /VEH. MGR	1 & 4	6047	0.30	1818	1845
SERVICE	2	1695	0.14	240	240
PARTS/BREAK	3	1880	0.14	265	265
GEN. MGR/CONFERENCE	5	1026	0.14	140	140
OFFICE	6	2288	0.14	320	320

[illegible]

HVAC LEGEND		
SYMBOL	ABB.	DESCRIPTION
	TSTAT	THERMOSTAT/CONTROL DEVICE 48" AFF
		REMOTE TEMPERATURE SENSOR
		HUMIDISTAT 48" AFF
		FIRESTAT
		SMOKE DETECTOR
		SMOKE DETECTOR TEST SWITCH
		VENTILATION SWITCH 48" AFF
		CONDENSATE DRAIN
		AUXILIARY DRAIN
		REFRIGERANT SUCTION
		REFRIGERANT LIQUID
		REFRIGERANT HOT GAS
		CHILLED WATER SUPPLY
		CHILLED WATER RETURN
		CONDENSER WATER SUPPLY
		CONDENSER WATER RETURN
		HOT WATER SUPPLY
		HOT WATER RETURN
		STEAM 5 PSIG
		STEAM CONDENSATE
		PUMPED STEAM CONDENSATE
		RELIEF
		DRAIN
		VENT
		COMPRESSED AIR 100 PSIG
		BLOCK VALVE
		BALANCING VALVE
		CHECK VALVE
		RELIEF VALVE
		RELIEF VALVE
		HOSE BIBB


M & A job no.: Q1-016

AN AUTOMOTIVE DEALERSHIP

ROGER BEASLEY VOLVO


STATE HIGHWAY 35 SOUTH
GEORGETOWN, TEXAS

**ELSASSER
ARCHITECTURAL**

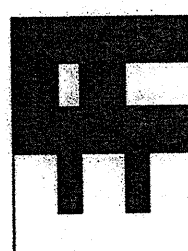

P.O. BOX 833 GEORGETOWN, TX 78627
(512) 890-5353 FAX (512) 890-2618 www.gael-tx.com

CONSULTANT SEAL:

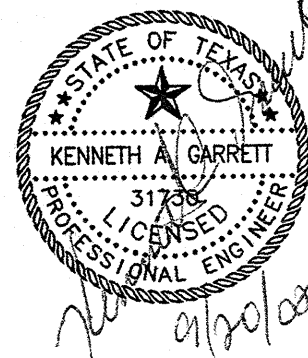

DATE: 09/20/02

REVISION DATE:

PROJECT NO. 020008

SHEET NO.

M2.1

AIR HANDLING UNIT SCHEDULE (GAS FURNACE)																						
MARK	MANUFACTURER AND MODEL NUMBER	SERVICE	TYPE	OUTSIDE AIR (CFM)	SUPPLY FAN PERFORMANCE					FURNACE			COOLING COIL								REMARKS	
					CFM	ESP	MAX FAN RPM	BHP	HP	ELEC. SVC.	FUEL TYPE	INPUT / CFH	OUTPUT/ BTUH	EADB/EAWB	LADB/LAWB	TOTAL MBH	SENS. MBH	MCA	MOCP	WEIGHT		
AHU-1	YORK P1XDD20V11201	SHOWROOM	HORIZ./SPLIT	205	1750	0.75			1.00	115V/1ø	NAT. GAS	120	112,000	79.0 / 64.5	55.0 / 54.9	39,900	36,000	14.5	20.0	200	1,2,3,5,6,7	
AHU-2	YORK P1XDD20V11201	SHOWROOM	HORIZ./SPLIT	205	1750	0.75			1.00	115V/1ø	NAT. GAS	120	112,000	79.0 / 64.5	55.0 / 54.9	39,900	36,000	14.5	20.0	200	1,2,3,5,6,7	
AHU-3	YORK P1XDD20V11201	SHOWROOM	HORIZ./SPLIT	205	1750	0.75			1.00	115V/1ø	NAT. GAS	120	112,000	79.0 / 64.5	55.0 / 54.9	39,900	36,000	14.5	20.0	200	1,2,3,5,6,7	
AHU-4	YORK P1XDD20V11201	SHOWROOM	HORIZ./SPLIT	205	1750	0.75			1.00	115V/1ø	NAT. GAS	120	112,000	79.0 / 64.5	55.0 / 54.9	39,900	36,000	14.5	20.0	200	1,2,3,5,6,7	
AHU-5	YORK P1XDD20V11201	SHOWROOM	HORIZ./SPLIT	205	1750	0.75			1.00	115V/1ø	NAT. GAS	120	112,000	79.0 / 64.5	55.0 / 54.9	39,900	36,000	14.5	20.0	200	1,2,3,5,6,7	
AHU-6	YORK P1XDD20V11201	SHOWROOM	HORIZ./SPLIT	205	1750	0.75			1.00	115V/1ø	NAT. GAS	120	112,000	79.0 / 64.5	55.0 / 54.9	39,900	36,000	14.5	20.0	200	1,2,3,5,6,7	
AHU-7	YORK P1XDD20V11201	SHOWROOM	HORIZ./SPLIT	205	1750	0.75			1.00	115V/1ø	NAT. GAS	120	112,000	79.0 / 64.5	55.0 / 54.9	39,900	36,000	14.5	20.0	200	1,2,3,5,6,7	
AHU-8	YORK P1XDD20V11201	SHOWROOM	HORIZ./SPLIT	205	1750	0.75			1.00	115V/1ø	NAT. GAS	120	112,000	79.0 / 64.5	55.0 / 54.9	39,900	36,000	14.5	20.0	200	1,2,3,5,6,7	
AHU-9	YORK P1XDD20V11201	SHOWROOM	HORIZ./SPLIT	205	1750	0.75			1.00	115V/1ø	NAT. GAS	120	112,000	79.0 / 64.5	55.0 / 54.9	39,900	36,000	14.5	20.0	200	1,2,3,5,6,7	
AHU-10	YORK PHUE30N13006	SERVICE (1ST FLR)	HORIZ./SPLIT	240	1800	1.00			1.50	208V/1ø	NAT. GAS	160	130,000	78.9 / 64.5	55.0 / 54.4	41,600	35,600	15.0	20.0	250	2,3,4,7	
AHU-11	YORK PHUE30N13006	PARTS/BREAK (1ST FLR)	HORIZ./SPLIT	265	1400	1.00			1.50	208V/1ø	NAT. GAS	160	130,000	80.1 / 66.0	56.0 / 55.5	33,400	27,200	9.0	20.0	130	2,3,4,7	
AHU-12	YORK P1XDB12V0751	G. MGR / CONF (2ND FLR)	HORIZ./SPLIT	140	1000	0.60			0.75	115V/1ø	NAT. GAS	80	75,000	78.6 / 64.6	55.0 / 54.4	25,000	21,000	9.0	20.0	130	2,3,4,5,7	
AHU-13	YORK PHUE30N13006	OFF / RR (2ND FLR)	HORIZ./SPLIT	320	1860	1.00			1.50	208V/1ø	NAT. GAS	160	130,000	79.5 / 65.2	55.0 / 54.3	51,800	42,800	15.0	20.0	250	2,3,4,7	

- REMARKS:
1. PROVIDE WITHOUT FILTER.
 2. PROVIDE HORIZONTAL CONFIGURATION.
 3. PROVIDE WITH VIBRATION ISOLATORS.
 4. PROVIDE FLAT FILTER
 5. PROVIDE 2-SPEED BLOWER.
 6. PROVIDE SMOKE DETECTORS IN SUPPLY DUCT. TIE TO FIRE ALARM SYSTEM.
 7. PROVIDE LIQUID LINE SOLENOID VALVE AT AHU THAT OPENS WHEN COMPRESSOR STARTS.

CONDENSING UNIT SCHEDULE- AIR CONDITIONING													
MARK	SERVICE	COOLING CAPACITY MBH	MINIMUM SEER	AMBIENT TEMP. °F	COMPRESSOR DATA			FAN DATA		MCA	MOCP	MANUFACTURER MODEL NUMBER	REMARKS
					(V/PH/Hz)	LRA	RLA	(V/PH/Hz)	FLA				
CU-1	SHOWROOM	46.6	10.8	105	208/1ø	135	25.7		0.7	32.8	50	YORK HTS048 / GFD 048	1
CU-2	SHOWROOM	46.6	10.8	105	208/1ø	135	25.7		0.7	32.8	50	YORK HTS048 / GFD 048	1
CU-3	SHOWROOM	46.6	10.8	105	208/1ø	135	25.7		0.7	32.8	50	YORK HTS048 / GFD 048	1
CU-4	SHOWROOM	46.6	10.8	105	208/1ø	135	25.7		0.7	32.8	50	YORK HTS048 / GFD 048	1
CU-5	SHOWROOM	46.6	10.8	105	208/1ø	135	25.7		0.7	32.8	50	YORK HTS048 / GFD 048	1
CU-6	SHOWROOM	46.6	10.8	105	208/1ø	135	25.7		0.7	32.8	50	YORK HTS048 / GFD 048	1
CU-7	SHOWROOM	46.6	10.8	105	208/1ø	135	25.7		0.7	32.8	50	YORK HTS048 / GFD 048	1
CU-8	SHOWROOM	46.6	10.8	105	208/1ø	135	25.7		0.7	32.8	50	YORK HTS048 / GFD 048	1
CU-9	SHOWROOM	46.6	10.8	105	208/1ø	135	25.7		0.7	32.8	50	YORK HTS048 / GFD 048	1
CU-10	SERVICE (1ST FLR)	57.5	12.0	105	208/1ø	169	28.8		1.3	37.4	60	YORK HRC060 / GFD 060	
CU-11	PARTS/BREAK (1ST FLR)	42.5	12.0	105	208/1ø	115	19.9		0.7	26.2	45	YORK HRC042 / GFD 048	
CU-12	G. MGR / CONF (2ND FLR)	29.4	11.0	105	208/1ø	65	11.7		0.5	15.3	25	YORK HTS030 / GFD 036	1
CU-13	OFF / RR (2ND FLR)	57.5	12.0	105	208/1ø	169	28.8		1.3	37.4	60	YORK HRC060 / GFD 061	

- NOTES:
1. PROVIDE 2-SPEED COMPRESSOR.

FAN SCHEDULE														
MARK	PERFORMANCE						ELECTRICAL				WEIGHT	MANUFACTURER AND MODEL NUMBER		REMARKS
	SERVICE	TYPE	LOCATION	CFM	ESP	RPM	BHP	MOTOR HP	RPM	SERVICE				
EF-1	SHOWROOM R/R	CENTRIFUGAL	INLINE	700	1.00	2,376	0.36	1/2	3450	115V/1ø	125	COOK #SQN-B80	1,3,5	
EF-2	SERVICE R/R	CENTRIFUGAL	INLINE	500	1.00	2,040	0.24	1/2	3450	115V/1ø	125	COOK #SQN-B80	1,3,5	
EF-3	SERVICE BAY	PROPELLER	WALL	6,000	0.25	732		1/2		115V/1ø		COOK #30XMW	3,4	
EF-4	SERVICE BAY	PROPELLER	WALL	6,000	0.25	732		1/2		115V/1ø		COOK #30XMW	3,4	
EF-5	SERVICE BAY	PROPELLER	WALL	6,000	0.25	732		1/2		115V/1ø		COOK #30XMW	3,4	
EF-6	SERVICE BAY	PROPELLER	WALL	6,000	0.25	732		1/2		115V/1ø		COOK #30XMW	3,4	
EF-7	SERVICE BAY	PROPELLER	WALL	6,000	0.25	732		1/2		115V/1ø		COOK #30XMW	3,4	
EF-8	SERVICE BAY	PROPELLER	WALL	6,000	0.25	732		1/2		115V/1ø		COOK #30XMW	3,4	
EF-9	PARTS STORAGE	PROPELLER	WALL	10,000	0.25	454		3/4		115V/1ø		COOK #42XMW	3,4	
F-1,F-2	SERVICE BAY	PROPELLER	COLUMN	6,300	0.00	1140	0.28	1/4	1140	115V/1ø	240	GREENHECK MCY-30-206-B4	2,6	
SF-1	WASH BAYS	CENTRIFUGAL	CABINET	1,200	0.75	1430	0.32	1/2		115V/1ø	80	COOK #SDB-120	3,5	
EF-10	2ND FLR. R/R	CENTRIFUGAL	INLINE	700	1.00	2376	0.36	1/2	3450	115V/1ø	125	COOK #SQN-B80	1,3,5	

- REMARKS:
1. FURNISH WITH BACKDRAFT DAMPERS.
 2. DIRECT DRIVE
 3. BELT DRIVE
 4. PROVIDE WITH GRAVITY SHUTTER, MOUNTING FRAME FOR FLUSH MOUNT ON EXTERIOR AND GUARD.
 5. PROVIDE RUBBER-IN-SHEAR VIBRATION ISOLATORS
 6. FURNISH WITH STEEL COLUMN SWIVEL MOUNT.

GAS DUCT HEATER SCHEDULE												
MARK	TYPE	SERVICE	CFM	DUCT SIZE	S.P.	FUEL TYPE	TEMP. RISE	INPUT (BTUH)	OUTPUT (BTUH)	FLUE SIZE	MANUFACTURER MODEL NO.	REMARKS
GDH-1	DUCT FURNACE	WASH BAYS	1200	14 x 18	0.3	NAT. GAS	60°F	100,000	80,000	4"	REZNOR EEDU100	

REMARKS:

GAS UNIT HEATER SCHEDULE										
MARK	TYPE	INPUT (CFH)	OUTPUT (BTUH)	UNIT VOLTAGE	FAN DATA			VOLTAGE	MANUFACTURER / MODEL NO.	REMARKS
					CFM	HP				
UH-1	INFRARED	30	30,000	115V/1ø	N/A				REZNOR RIHN 30	2
UH-2	INFRARED	30	30,000	115V/1ø	N/A				REZNOR RIHN 30	2
UH-3	INFRARED	30	30,000	115V/1ø	N/A				REZNOR RIHN 30	2
UH-4	INFRARED	30	30,000	115V/1ø	N/A				REZNOR RIHN 30	2
UH-5	INFRARED	30	30,000	115V/1ø	N/A				REZNOR RIHN 30	2
UH-6	INFRARED	30	30,000	115V/1ø	N/A				REZNOR RIHN 30	2
UH-7	INFRARED	30	30,000	115V/1ø	N/A				REZNOR RIHN 30	2
UH-8	INFRARED	30	30,000	115V/1ø	N/A				REZNOR RIHN 30	2
UH-9	INFRARED	30	30,000	115V/1ø	N/A				REZNOR RIHN 30	2
UH-10	INFRARED	30	30,000	115V/1ø	N/A				REZNOR RIHN 30	2
UH-11	PROPELLER	50	40,000	115V/1ø	380	1/50	115/1		REZNOR F50	1
UH-12	PROPELLER	50	40,000	115V/1ø	380	1/50	115/1		REZNOR F50	1

1. PROVIDE THERMOSTAT MOUNTS ON UNIT.
2. PROVIDE WALL SWITCH TO TURN UNIT ON-OFF.

MYERS & ASSOCIATES


This document, the ideas and designs incorporated herein are and shall remain the property of Myers & Associates. These documents are not to be used or altered, in whole or in part, for other than the original intended use, nor are they to be assigned to any third party without written permission from Myers & Associates. ©

M & A job no.: 01-016

AN AUTOMOTIVE DEALERSHIP
ROGER BEASLEY VOLVO
INTERSTATE HIGHWAY 35 SOUTH
GEORGETOWN, TEXAS

ELASSER ARCHITECTURAL INC.

ARCHITECTURE AND PLANNING
P.O. BOX 883 GEORGETOWN, TX 78627
(512) 860-5583 FAX (512) 850-2818 www.eai-tx.com

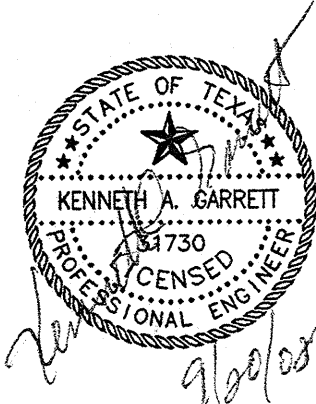
CONSULTANT SEAL:


DATE: 09/20/02

REVISION DATE:

PROJECT NO.
020008

SHEET NO.
M2.2

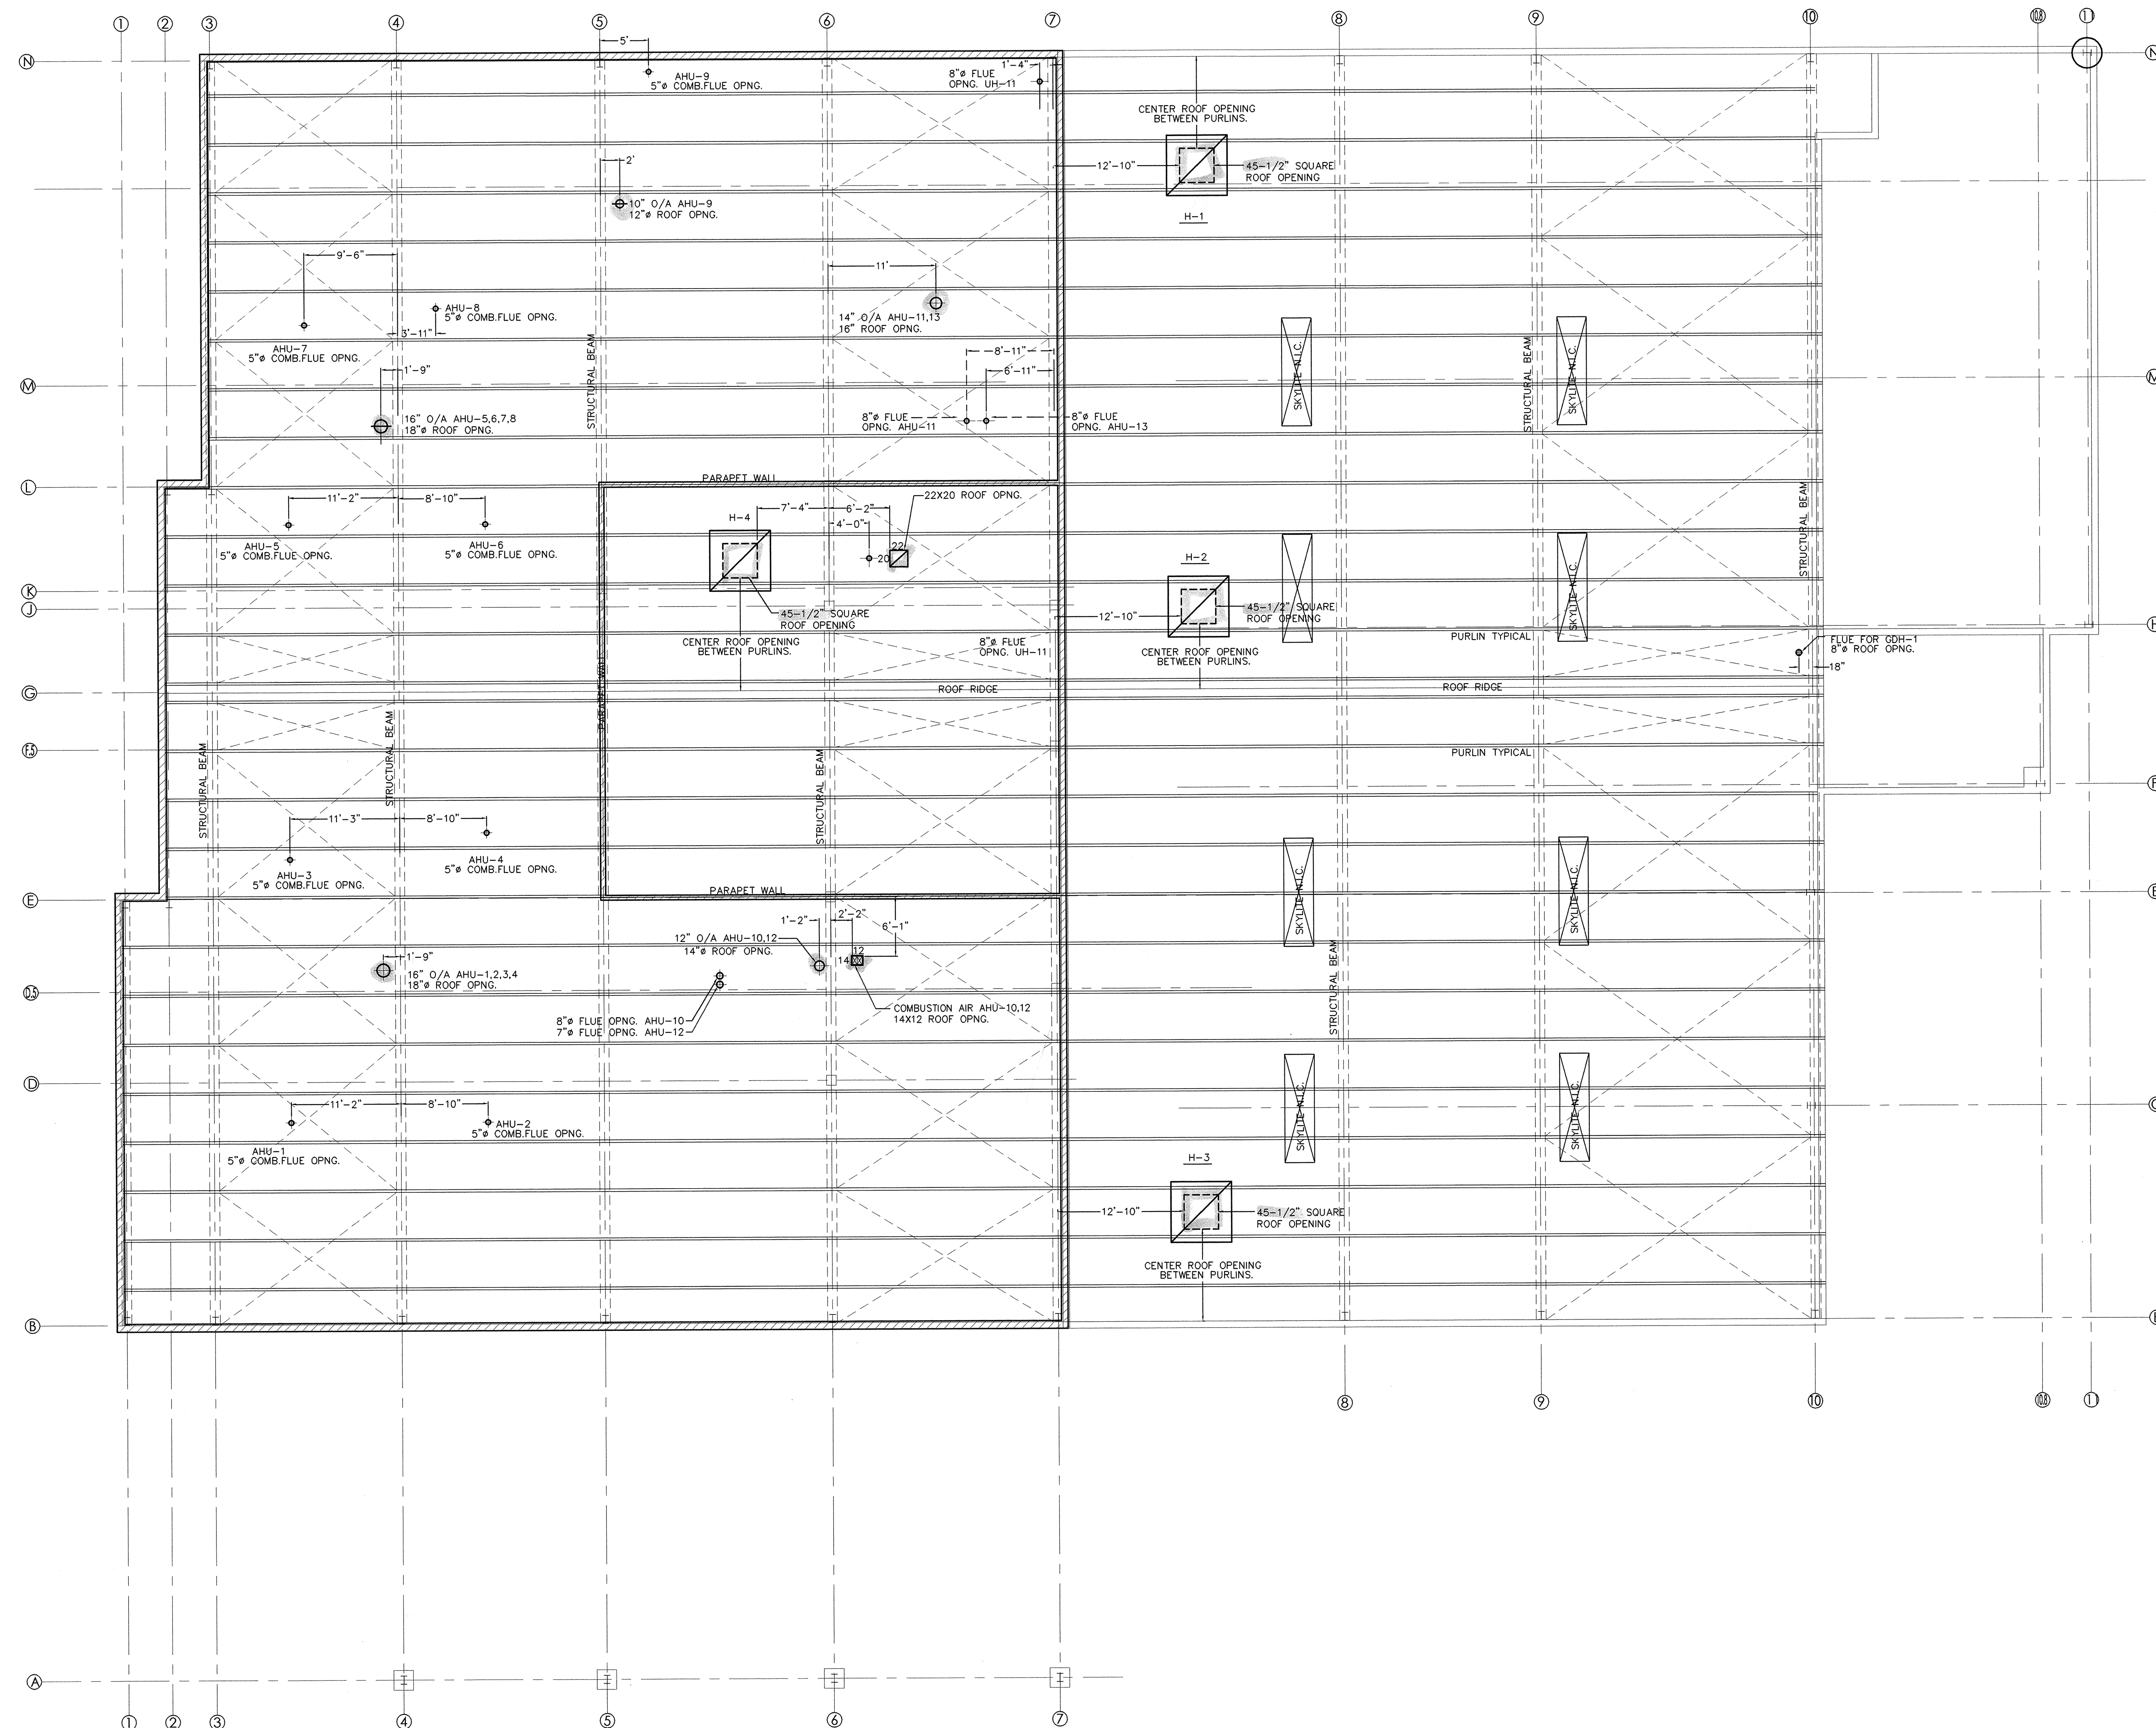

HVAC Roof Plan

scale: 1/8" = 1'-0"

NOTE: ALL FLUES TO BE A MINIMUM OF 10'-0" FROM OUTSIDE AIR INTAKES
 DIMENSIONS ARE FROM ϕ OF STEEL. VERIFY DISTANCES WITH
 RESPECT TO ROOFING MATERIAL ADJUST ACCORDINGLY ON SITE.
 ALL ROOF OPENINGS MUST FALL BETWEEN ROOF PURLINS
 MAINTAIN AT LEAST 5 FEET DISTANCE BETWEEN PARAPET WALL AND
 ANY ROOF PENETRATIONS.

AN AUTOMOTIVE DEALERSHIP
ROGER BEASLEY VOLVO

INTERSTATE HIGHWAY 35 SOUTH
 GEORGETOWN, TEXAS

EL SASSER
ARCHITECTURAL
INC.
 ARCHITECTURE AND PLANNING
 P.O. BOX 533 GEORGETOWN, TX 78627
 (512) 850-5553 FAX (512) 850-2618 www.eelb.com

CONSULTANT SEAL:

MECHANICAL
TECHNICAL
SERVICES, L.P.
COMFORT USA
 A Comfort Systems USA Company

DATE: 28, July 2003

Preliminary Plan
 Not For Construction

REVISION DATE:

SHD
DRAWING

PROJECT NO.
 M-Tech #2406


SHEET NO.

M3.0



KEYED NOTES

THESE NOTES APPLY TO THIS SHEET ONLY

- EXISTING PULL BOX FOR LIFT STATION POWER. RELOCATE AS REQUIRED. COORDINATE SITE CONDITIONS WITH CHRIS SKIDMORE WITH MCCORD ENGINEERING AT (979) 764-8356.
- JOINT TRENCH FOR ELECTRIC PRIMARY AND TELECOMMUNICATIONS WIRING. PROVIDE (3) 2" CONDUITS FOR ELECTRIC AND (2) 4" EMPTY CONDUITS FOR TELECOMMUNICATIONS. COORDINATE WITH CHRIS SKIDMORE FOR ELECTRIC UTILITY REQUIREMENTS. VERIZON FOR TELECOMMUNICATIONS AND TIME WARNER FOR CABLE REQUIREMENTS.
- (2) 4" CONDUITS TO SECOND FLOOR TELECOMMUNICATIONS ROOM. PROVIDE WITH LONG SWEEP ELBOWS.
- PAD MOUNT TRANSFORMER BY COMMUNITY OWNED UTILITIES.
- EXISTING COMMUNITY OWNED UTILITIES JUNCTION BOX.
- MONUMENT SIGN. COORDINATE WITH OWNER FOR EXACT REQUIREMENTS.
- ELECTRICAL SECONDARIES. REFER TO SWITCHBOARD "MSB" SCHEDULE FOR SIZING.

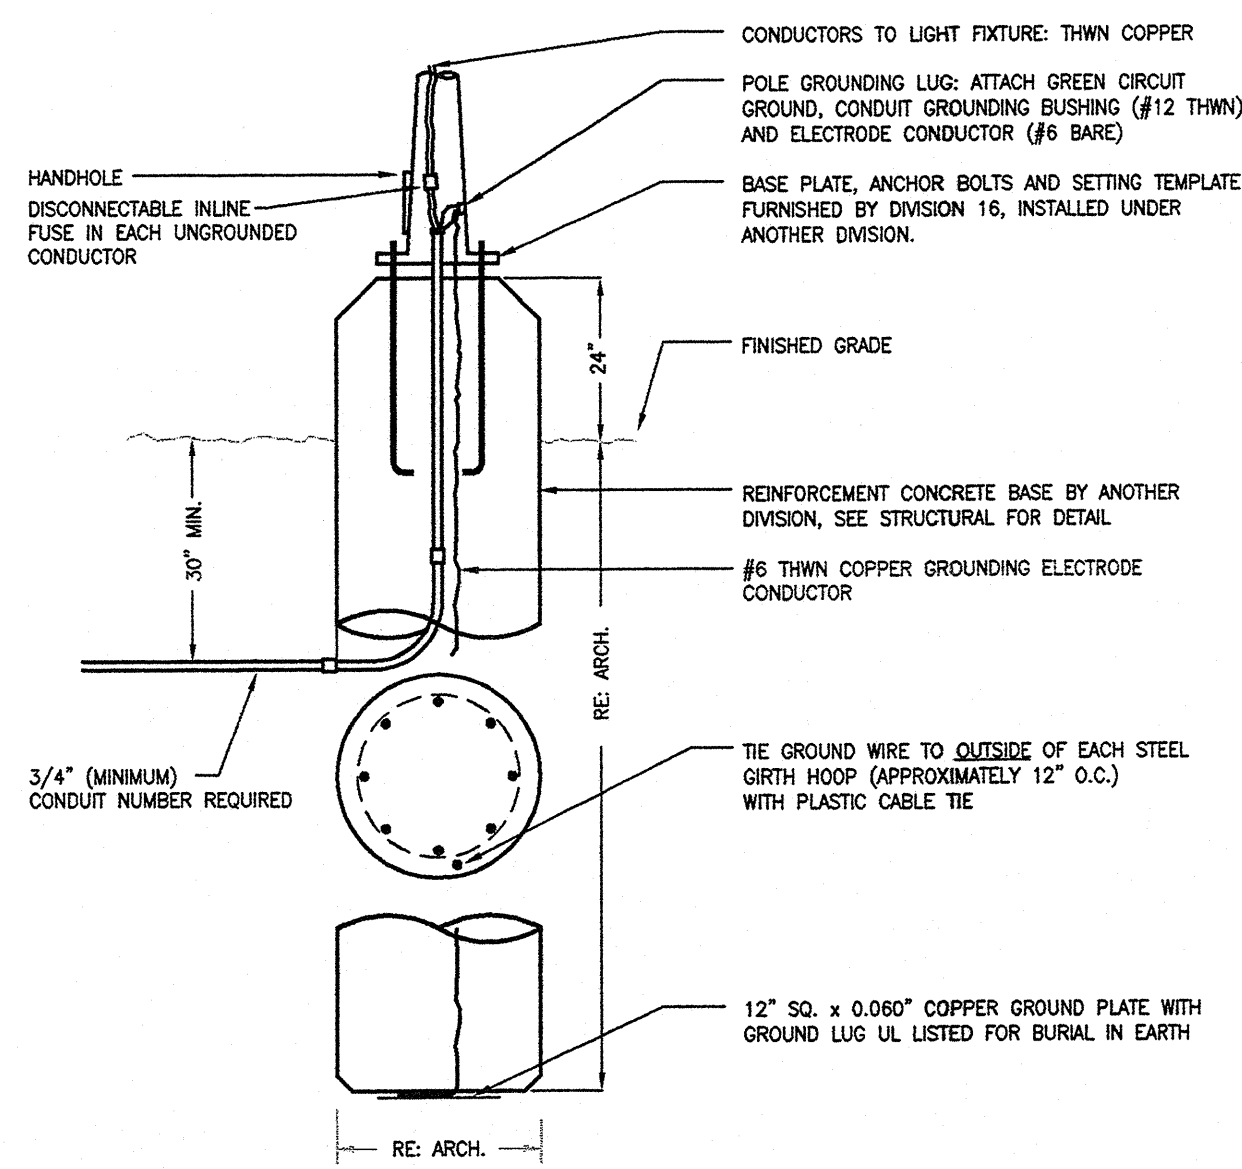

02 LIGHT POLE FOOTING - ELEC.
SCALE: NOT TO SCALE

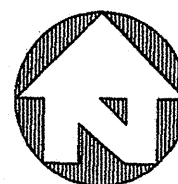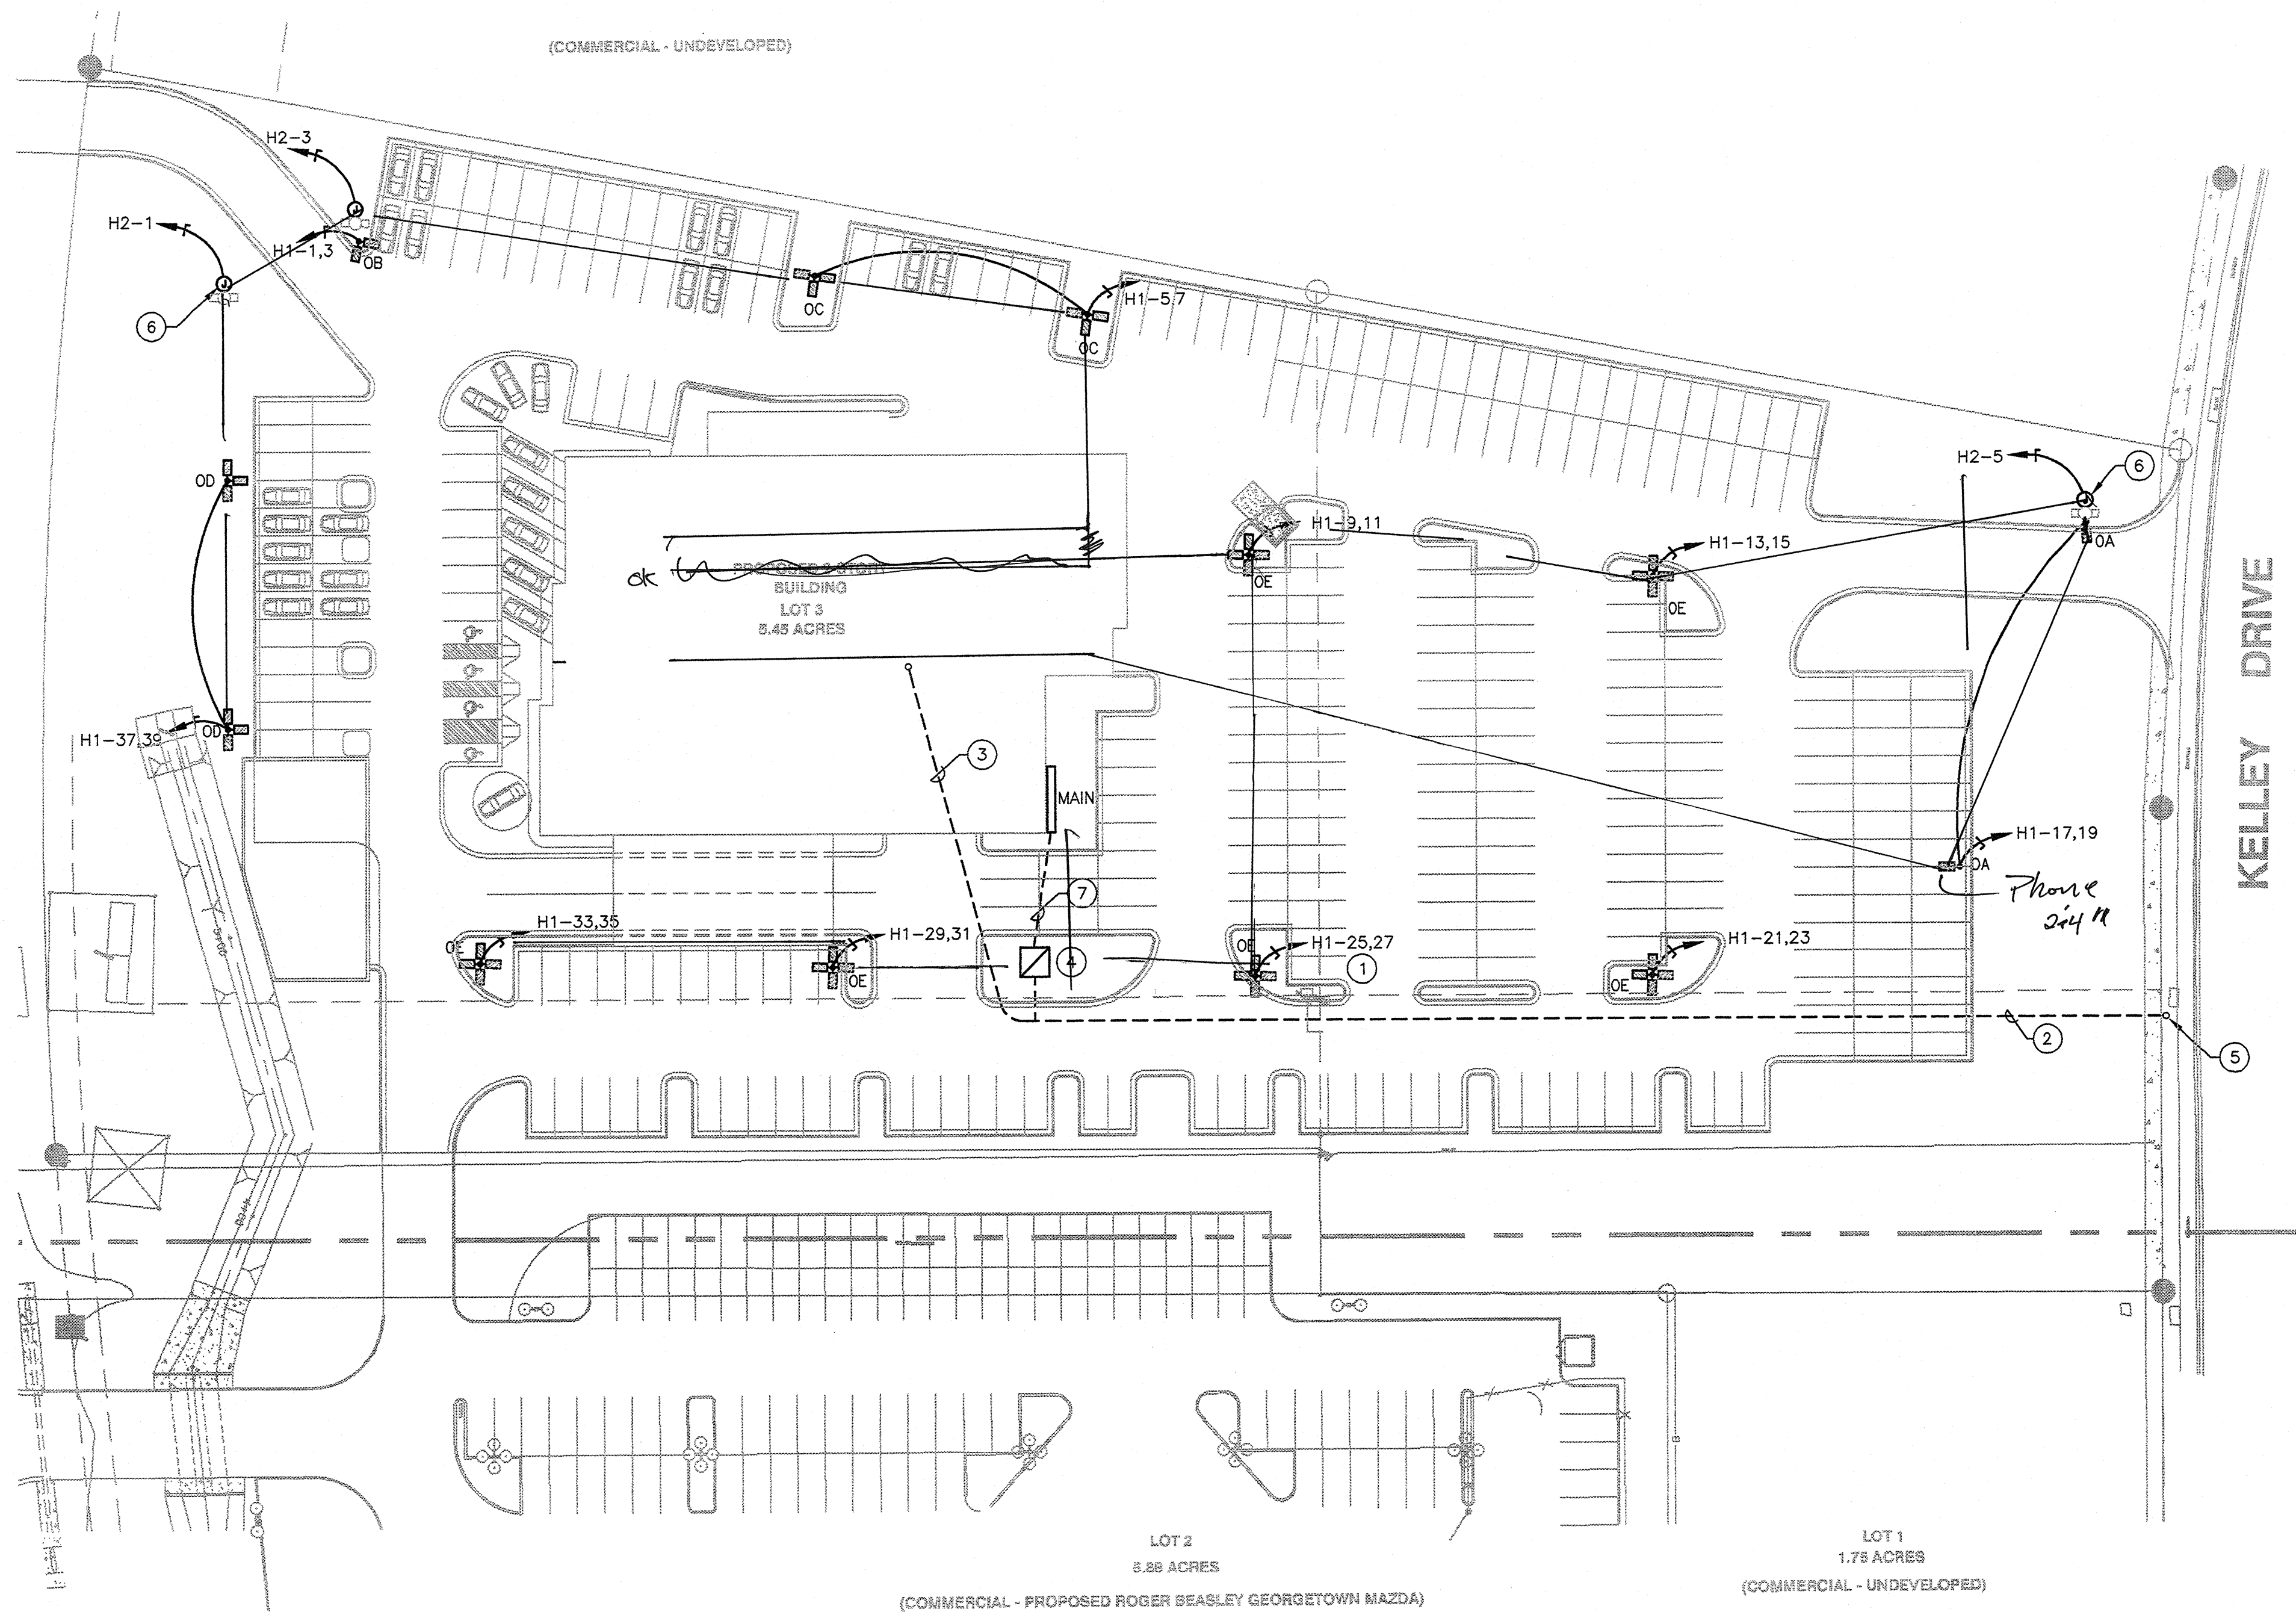

01 SITE PLAN - ELECTRICAL
SCALE: 1" = 40'

MYERS &
ASSOCIATES

This document, the ideas and designs incorporated herein are and shall remain the property of Myers & Associates. These documents are not to be used or altered, in whole or in part, for other than the original intended use, nor are they to be assigned to any third party without written permission from Myers & Associates. ©
M & A Job no.: 01-016


AN AUTOMOTIVE DEALERSHIP

ROGER BEASLEY VOLVO

INTERSTATE HIGHWAY 35 SOUTH
GEORGETOWN, TEXAS

ELASSER
ARCHITECTURAL
INC.
ARCHITECTURE AND PLANNING
P.O. BOX 458 GEORGETOWN, TX 78627
(512) 860-5555 FAX (512) 860-2816 www.ea-lv.com

CONSULTANT SEAL:

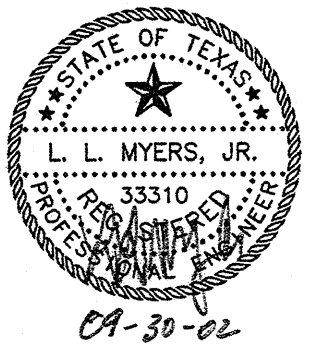

DATE: 04/30/02

REVISION DATE:

PROJECT NO.
020008



SHEET NO.

E1.0

KEYED NOTES

THESE NOTES APPLY TO THIS SHEET ONLY

- 1 PROVIDE WATTSTOPPER #W1-300-WH MOTION SENSOR. TYPICAL FOR ALL MOTION SENSORS.
- 2 STRIP FLUORESCENT FIXTURES TO BE HUNG ABOVE WORK BENCH. COORDINATE INSTALLATION WITH EQUIPMENT LOCATIONS.
- 3 VERIFY EXACT MOUNTING LOCATION FOR DOCK LIGHT WITH OWNER PRIOR TO ROUGH-IN.

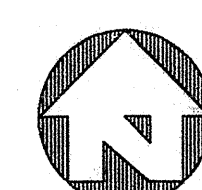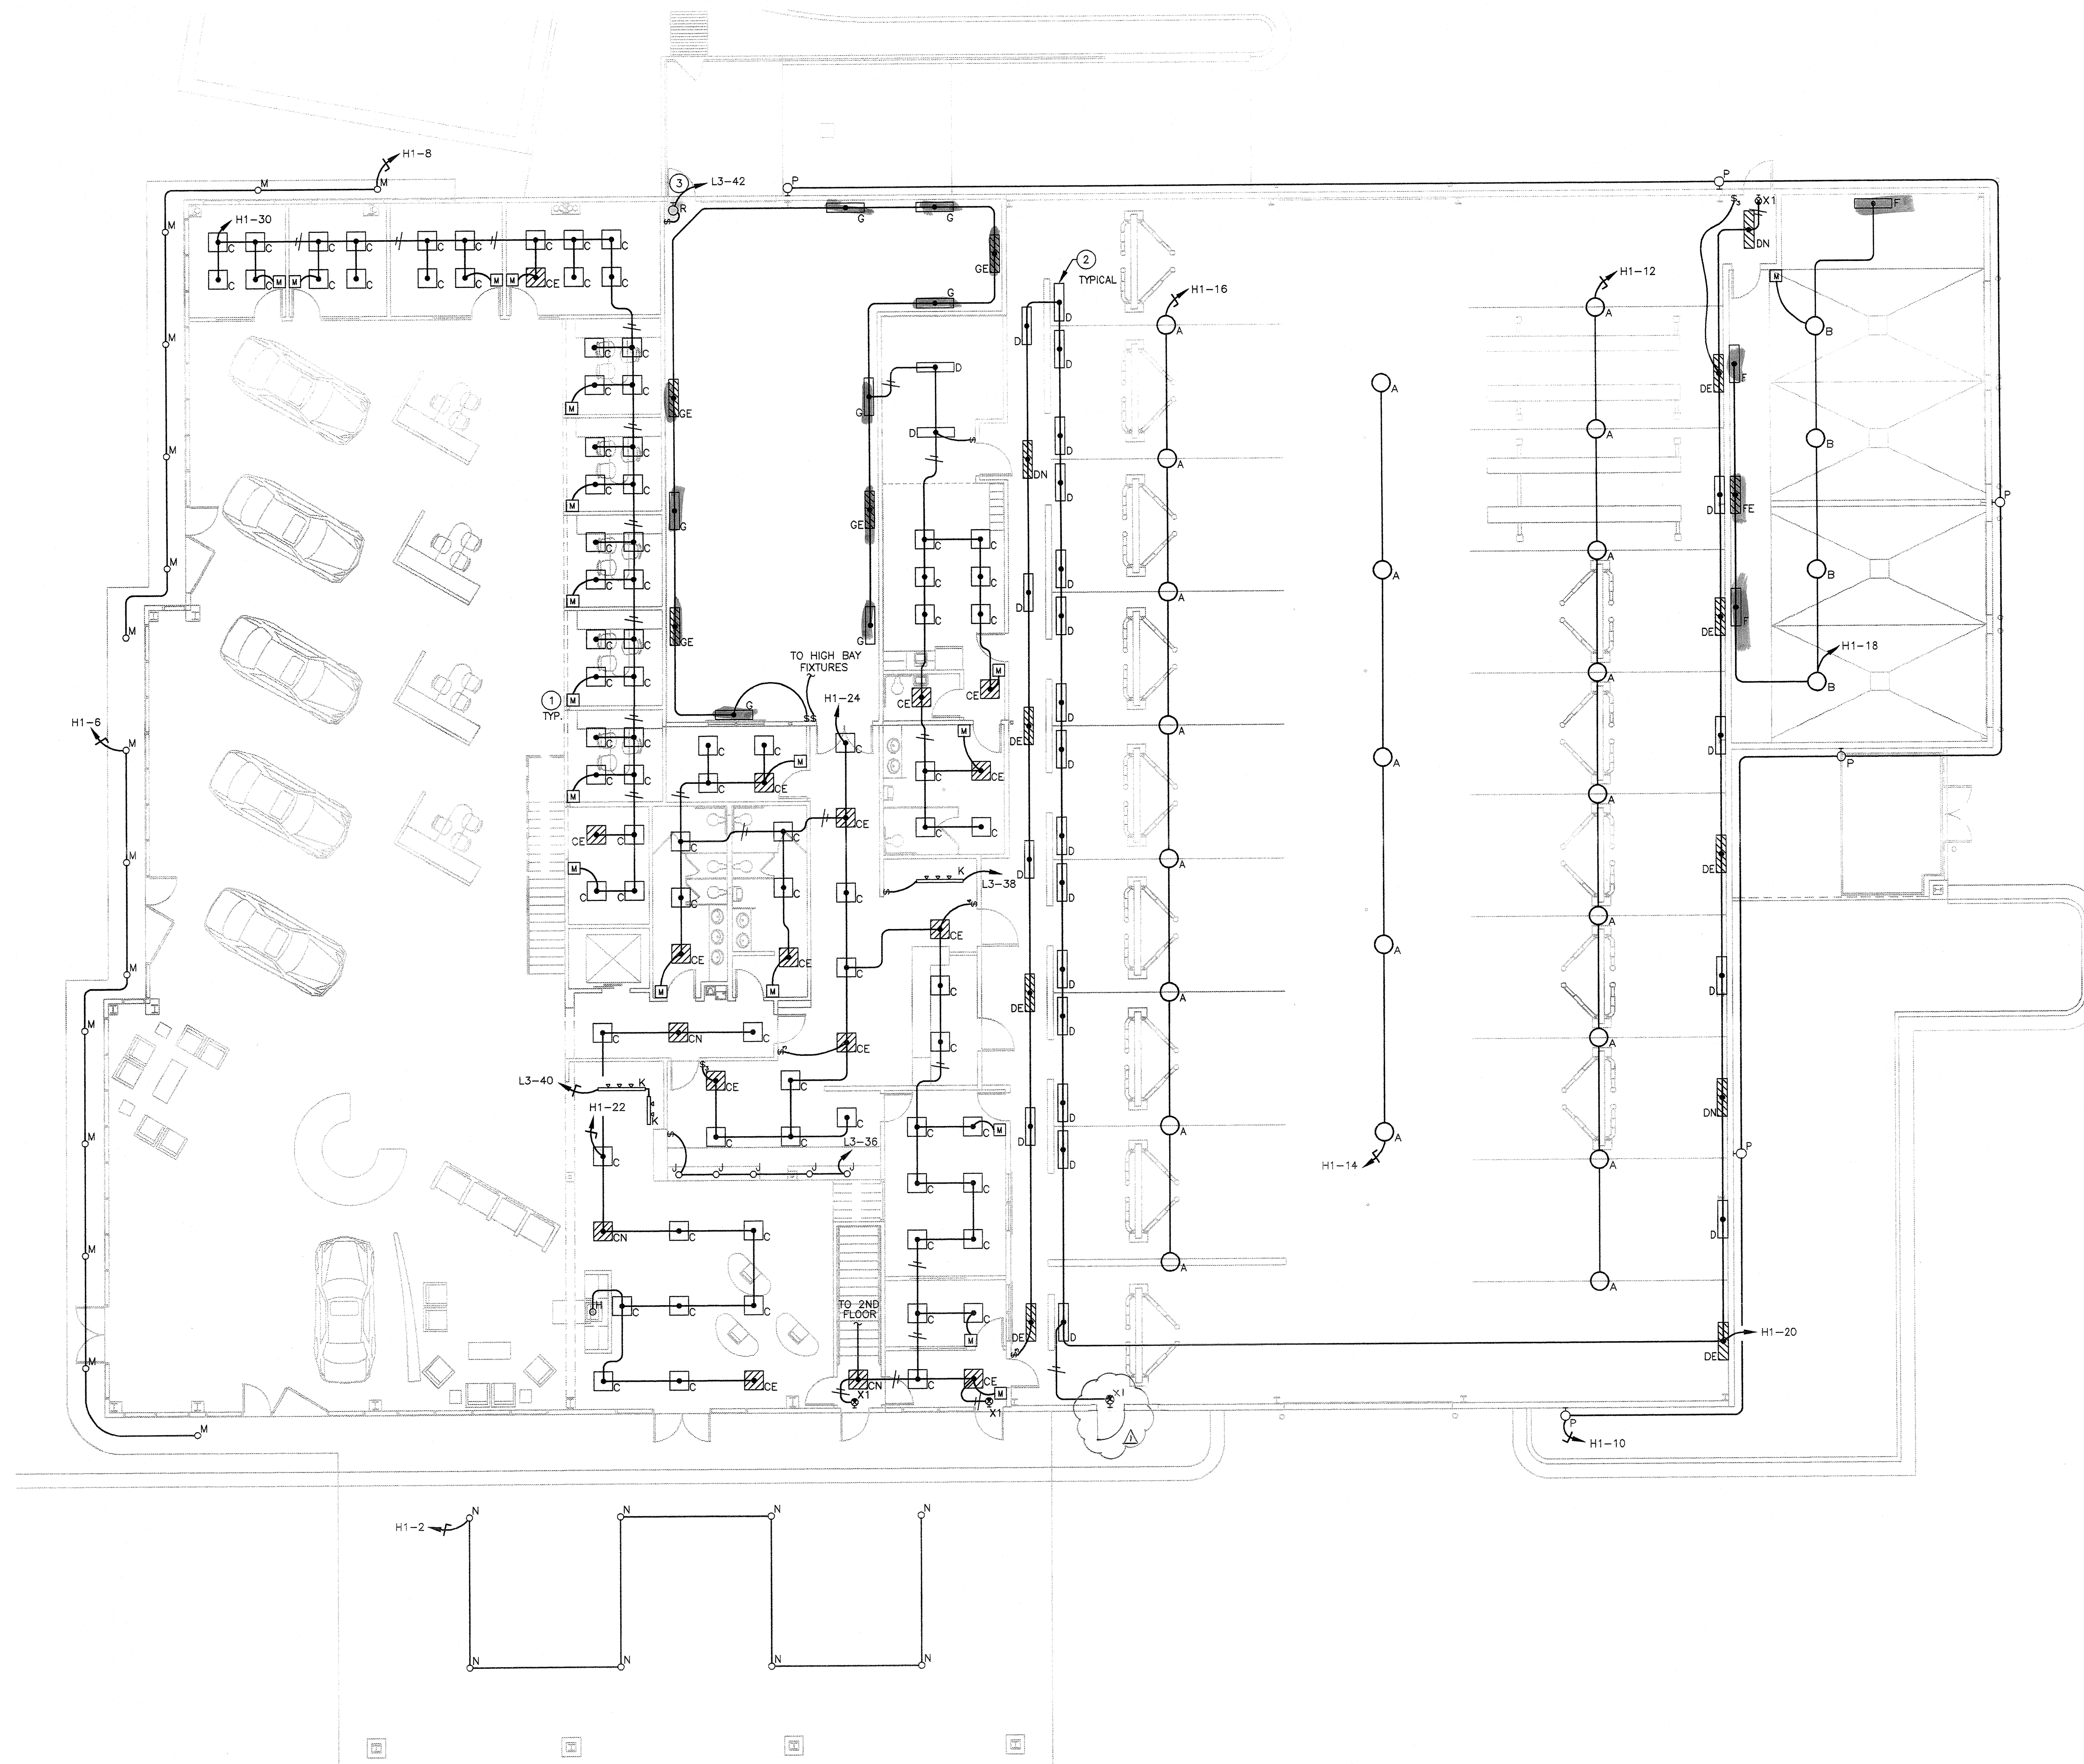

01 FIRST FLOOR - LIGHTING PLAN
SCALE: 1/8" = 1'-0"

**MYERS &
ASSOCIATES**


This document, the ideas and designs incorporated herein are and shall remain the property of Myers & Associates. These documents are not to be used or altered, in whole or in part, for other than the original intended use, nor are they to be assigned to any third party without written permission from Myers & Associates. ©

M & A Job no.: 01-016

AN AUTOMOTIVE DEALERSHIP
ROGER BEASLEY VOLVO
INTERSTATE HIGHWAY 35 SOUTH
GEORGETOWN, TEXAS

**ELASSER
ARCHITECTURAL
INC.**
ARCHITECTURE AND PLANNING
P.O. BOX 883 GEORGETOWN, TX 78627
(512) 863-3383 FAX (512) 863-2616 www.ea3.com

CONSULTANT SEAL:

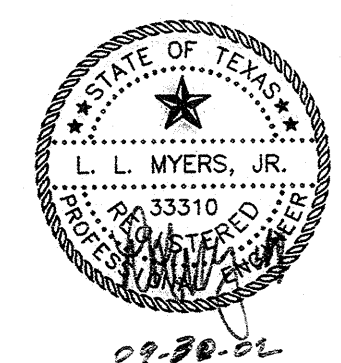

REVISIONS
NO. DESCRIPTION
1 REL. CHANGED DOOR
DATE: 04/30/02

REVISION DATE:
1 12-04-02

PROJECT NO.
020008



SHEET NO.

E2.0

KEYED NOTES

THESE NOTES APPLY TO THIS SHEET ONLY

- 1 PROVIDE WATTSTOPPER #W1-300-WH MOTION SENSOR. TYPICAL FOR ALL MOTION SENSORS.
- 2 STRIP FLUORESCENT FIXTURES TO BE HUNG ABOVE WORK BENCH. COORDINATE INSTALLATION WITH EQUIPMENT LOCATIONS.
- 3 VERIFY EXACT MOUNTING LOCATION FOR DOCK LIGHT WITH OWNER PRIOR TO ROUGH-IN.

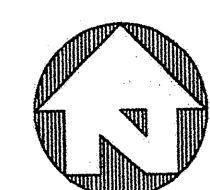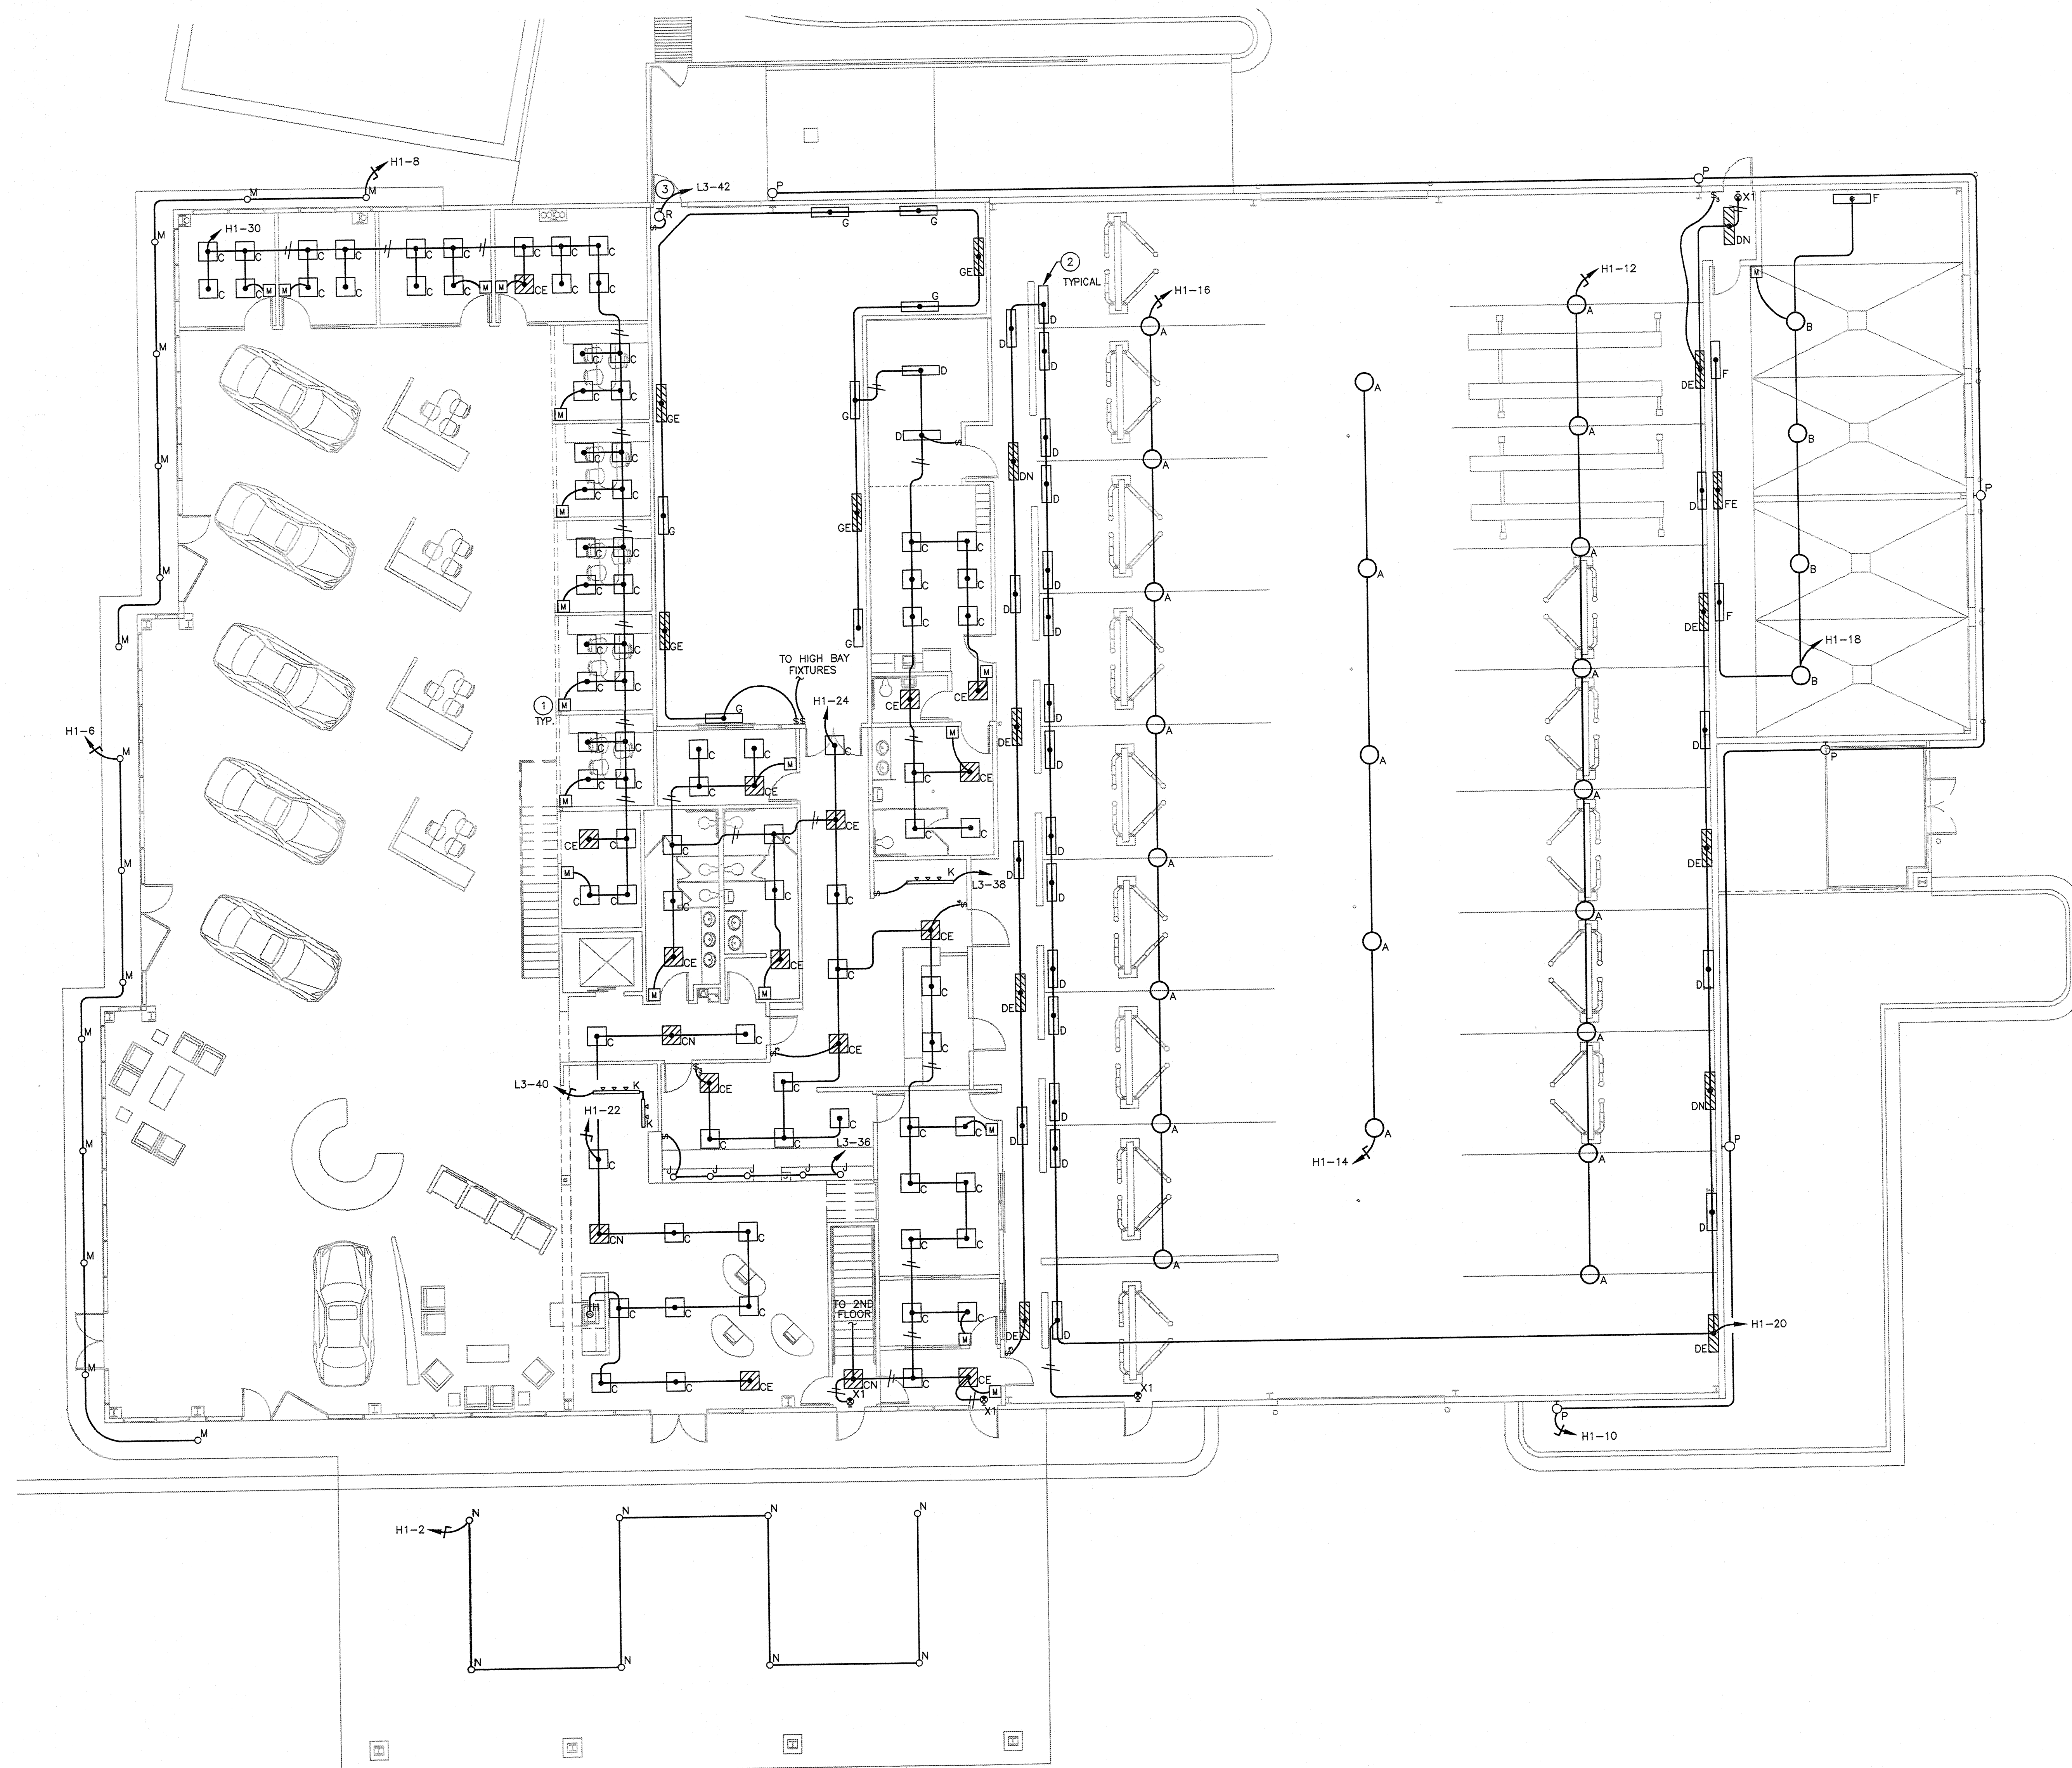

01 FIRST FLOOR - LIGHTING PLAN


SCALE: 1/8" = 1'-0"

AN AUTOMOTIVE DEALERSHIP

ROGER BEASLEY VOLVO


INTERSTATE HIGHWAY 35 SOUTH
GEORGETOWN, TEXAS

ELSASSER
ARCHITECTURAL
INC.

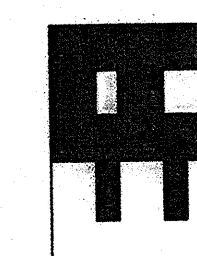

ARCHITECTURE AND PLANNING
P.O. BOX 833 GEORGETOWN, TX 78627
(512) 835-3333 FAX (512) 835-3316 www.elsa.com

CONSULTANT SEAL:

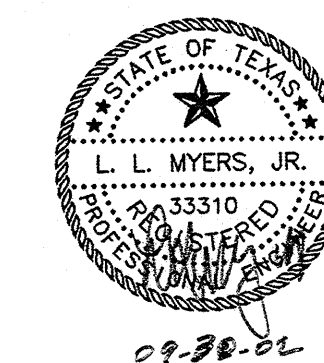



DATE: 09/30/02

SEE
REVISED

KEYED NOTES

THESE NOTES APPLY TO THIS SHEET ONLY

- 1 PROVIDE MANUAL ON/OFF SWITCH ADJACENT TO LIGHTING TIMECLOCK TO MANUALLY OVERRIDE CONTROLS FOR SHOWROOM DOWNLIGHTS.
- 2 COORDINATE LOCATION OF MOTION SENSOR WITH OWNER AND FURNITURE DESIGNER PRIOR TO INSTALLATION.
- 3 MOUNT LIGHT FIXTURE ABOVE AHU-7 MECHANICAL SPACE. MOUNT SWITCH ADJACENT TO ACCESS PANEL.

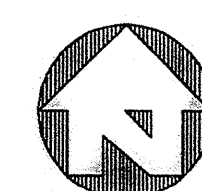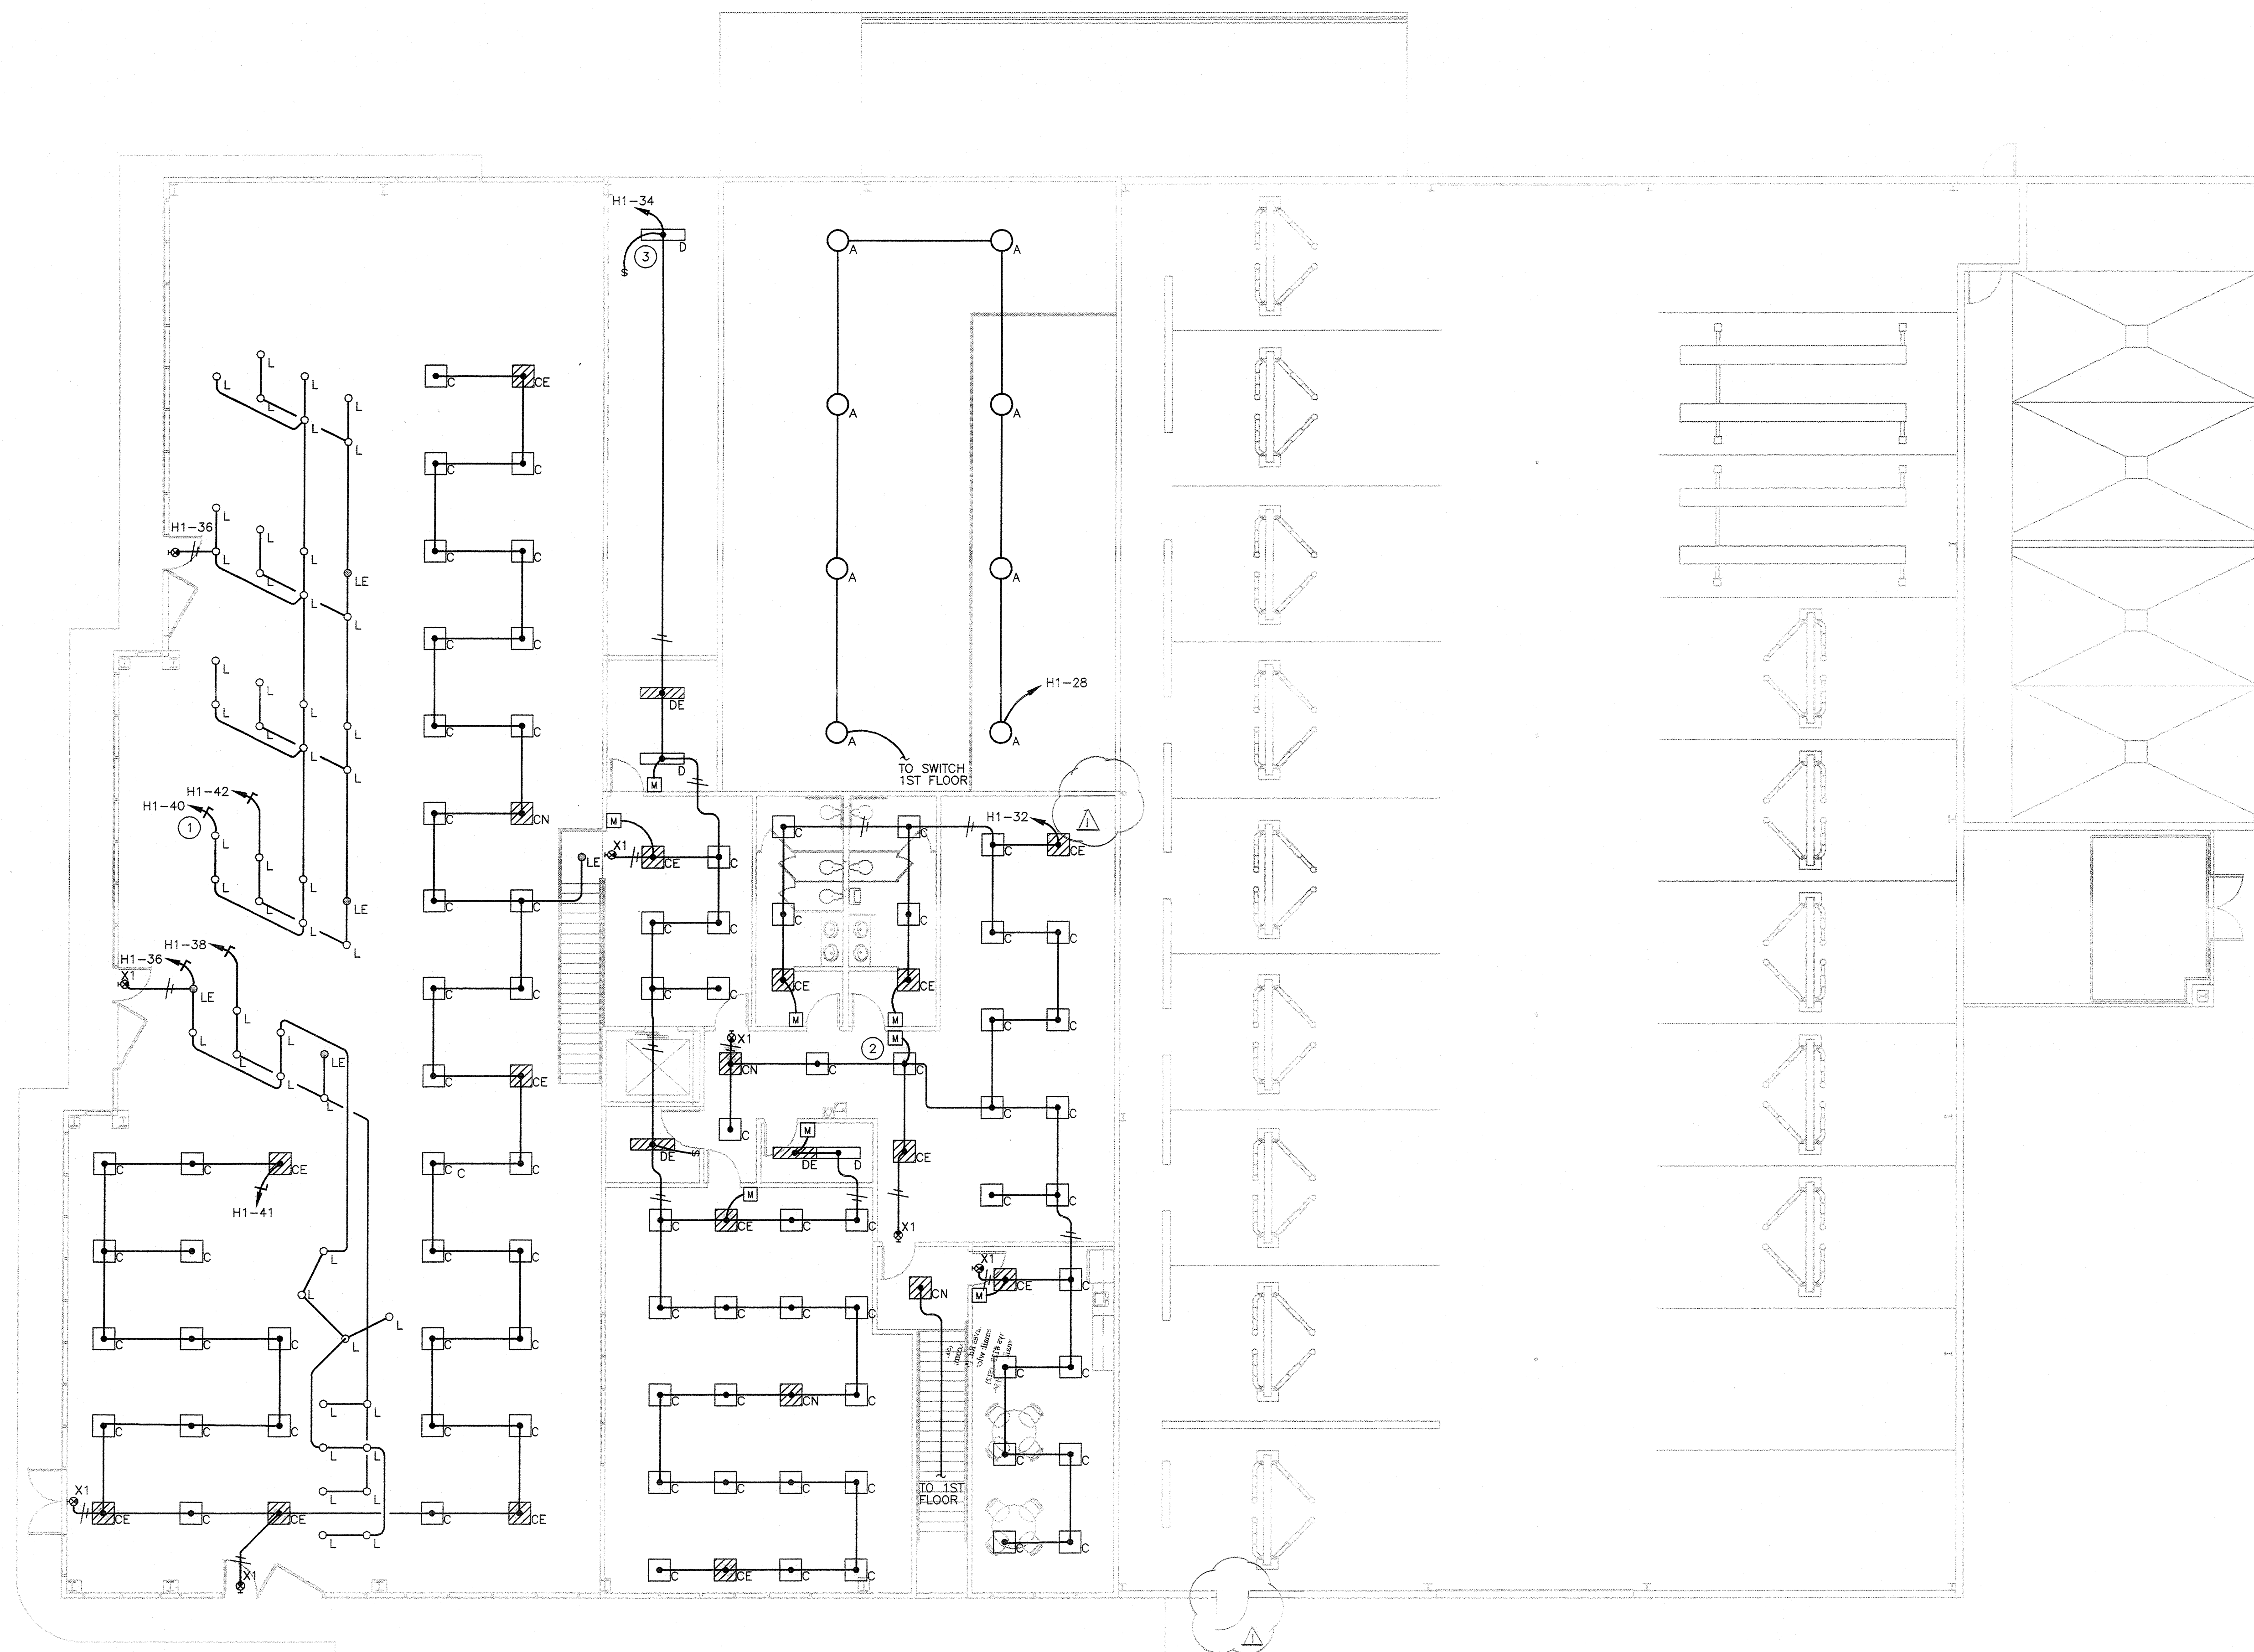

01 SECOND FLOOR - LIGHTING PLAN

SCALE: 1/8" = 1'-0"

**MYERS &
ASSOCIATES**

This document, the ideas and designs incorporated herein are and shall remain the property of Myers & Associates. These documents are not to be used or altered, in whole or in part, for other than the original intended use, nor are they to be assigned to any third party without written permission from Myers & Associates. ©


M & A Job no.: 01-016

AN AUTOMOTIVE DEALERSHIP

ROGER BEASLEY VOLVO


INTERSTATE HIGHWAY 35 SOUTH
GEORGETOWN, TEXAS

**ELSASSER
ARCHITECTURAL
INC.**

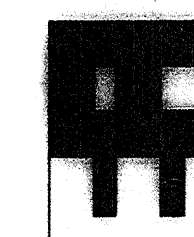

ARCHITECTURE AND PLANNING
P.O. BOX 883 GEORGETOWN, TX 78627
(612) 830-5553 FAX (612) 830-2518 www.eaii.com

CONSULTANT SEAL:

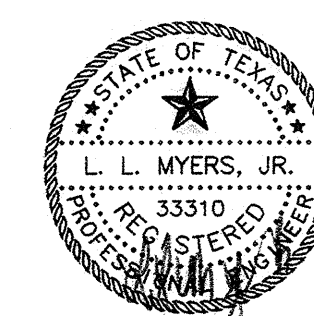

REVISIONS
NO. DESCRIPTION
1 RELOCATED DOWN
2 RE-PAVED DRIVE



DATE: 09/20/02

REVISION DATE:

PROJECT NO.
020008

SHEET NO.

E2.1

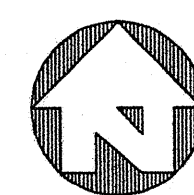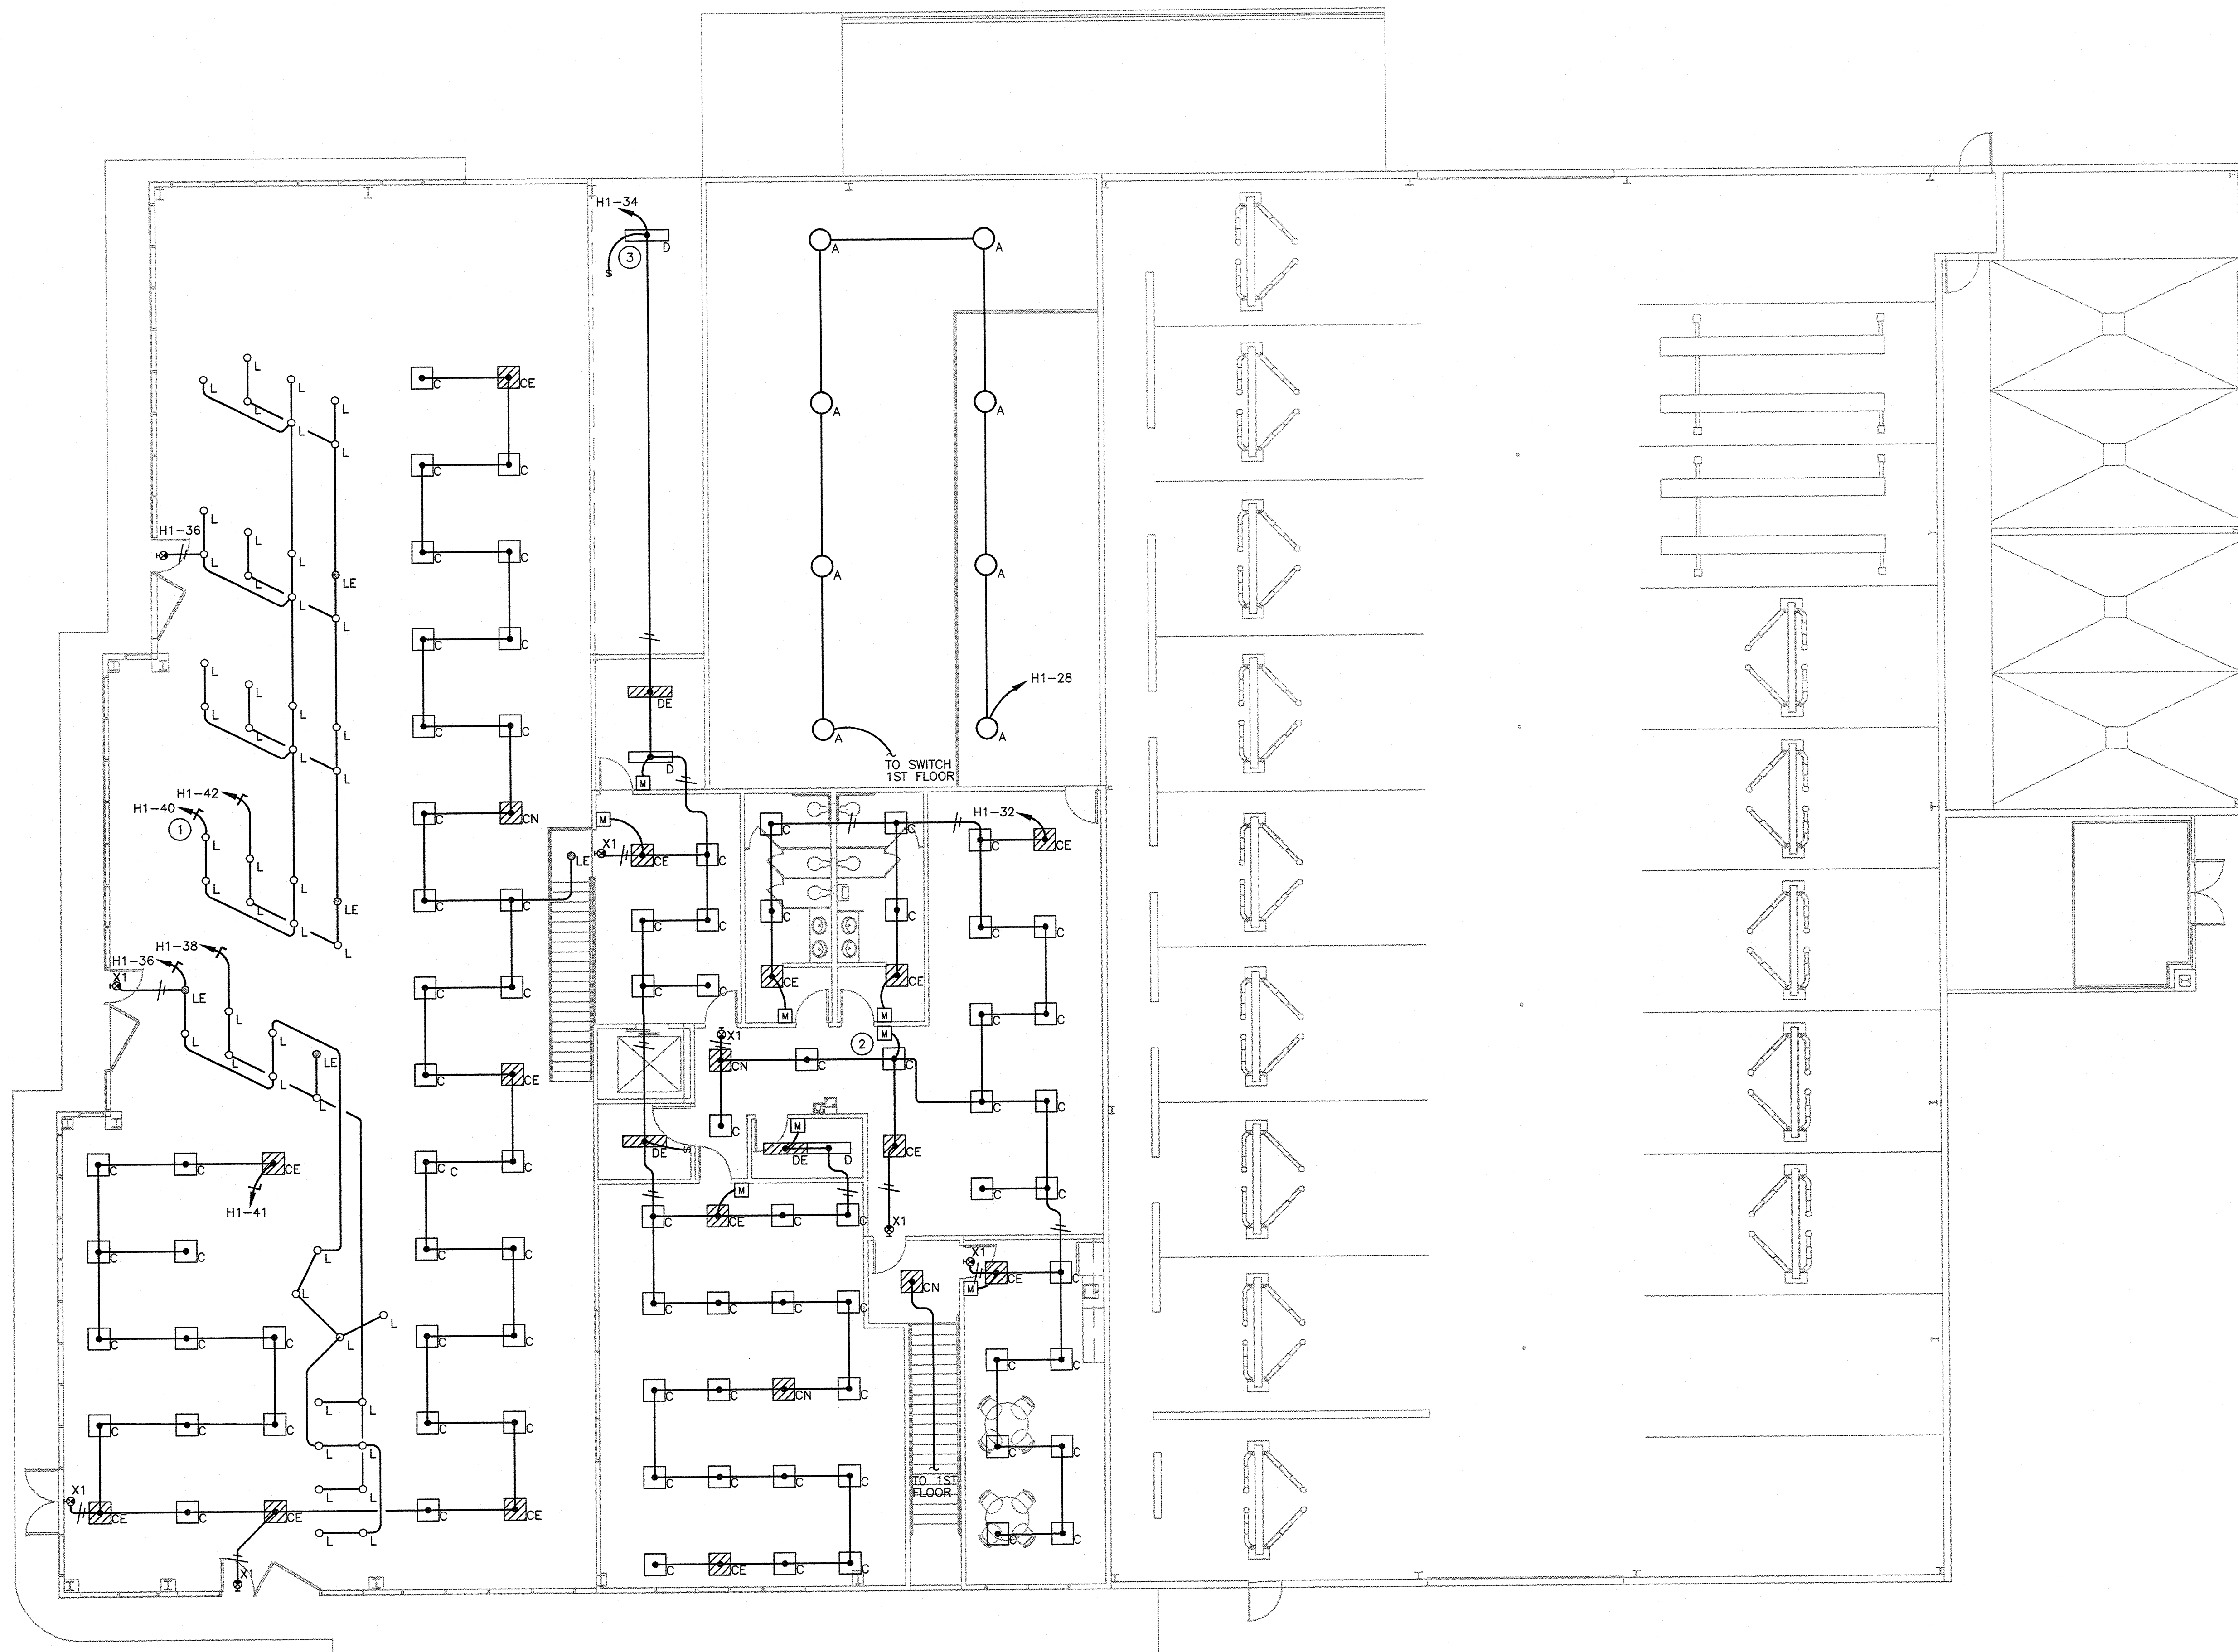

01 SECOND FLOOR - LIGHTING PLAN
SCALE: 1/8" = 1'-0"

KEYED NOTES

THESE NOTES APPLY TO THIS SHEET ONLY


- ① PROVIDE MANUAL ON/OFF SWITCH ADJACENT TO LIGHTING TIMECLOCK TO MANUALLY OVERRIDE CONTROLS FOR SHOWROOM DOWNLIGHTS.
- ② COORDINATE LOCATION OF MOTION SENSOR WITH OWNER AND FURNITURE DESIGNER PRIOR TO INSTALLATION.
- ③ MOUNT LIGHT FIXTURE ABOVE AHU-7 MECHANICAL SPACE. MOUNT SWITCH ADJACENT TO ACCESS PANEL.

AN AUTOMOTIVE DEALERSHIP


ROGER BEASLEY VOLVO

INTERSTATE HIGHWAY 35 SOUTH
GEORGETOWN, TEXAS

**ELSASSER
ARCHITECTURAL
INC.**
ARCHITECTURE AND PLANNING
P.O. BOX 833 GEORGETOWN, TX 78627
(817) 850-5353 FAX (817) 850-2818 www.elsa-h.com

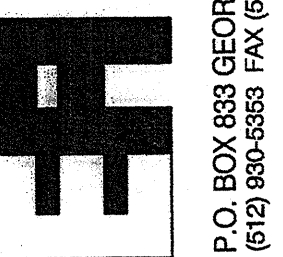

CONSULTANT SEAL:

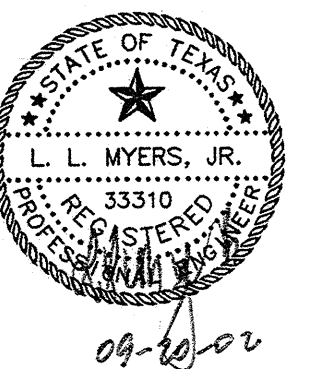

SEE
REVISION


KEYED NOTES

THESE NOTES APPLY TO THIS SHEET ONLY

- OWNER PROVIDED WASH BAY EQUIPMENT. VERIFY EXACT ELECTRICAL REQUIREMENTS PRIOR TO ANY WORK.
- OWNER PROVIDED AIR COMPRESSOR AND AIR DRYER. VERIFY EXACT REQUIREMENTS PRIOR TO ANY WORK.
- ALL SERVICE BAY SERVICE EQUIPMENT TO BE OWNER PROVIDED. COORDINATE EXACT ELECTRICAL REQUIREMENTS WITH OWNER PRIOR TO ANY WORK. ALL RECEPTACLES AND TELECOMMUNICATIONS DEVICES TO BE MOUNTED AT 42" AFF. PROVIDE CONDUIT WITH PULLSTRING FROM EACH TELECOMMUNICATIONS DEVICE TO TELEPHONE EQUIPMENT ROOM ON SECOND FLOOR.
- COORDINATE WITH OWNER FOR LOCATION OF "ON/OFF" SWITCH TO FAN.
- PROVIDE CONNECTION FOR TIRE MAINTENANCE EQUIPMENT TO BE PROVIDED BY OWNER. EQUIPMENT TO INCLUDE BUT NOT LIMITED TO TIRE CHANGER, WHEEL BALANCER, ALIGNMENT MACHINE, AND LASER ALIGNMENT MACHINE. COORDINATE WITH OWNER FOR EXACT EQUIPMENT REQUIREMENTS AND LOCATION. SHOWN IN THIS LOCATION FOR CLARITY ONLY.
- PROVIDE CONNECTION TO AUTOMATIC DOOR CLOSERS. COORDINATE WITH GENERAL CONTRACTOR AND FIRE ALARM CONTRACTOR FOR EXACT REQUIREMENTS.
- PROVIDE CONNECTION TO AUTOMATIC ROLL DOWN FIRE SHUTTERS. COORDINATE WITH GENERAL CONTRACTOR AND FIRE ALARM CONTRACTOR FOR EXACT REQUIREMENTS.
- CIRCUIT EXHAUST FANS EF-1 AND EF-2 THROUGH LIGHTING TIMECLOCK AND PROGRAM TO RUN DURING BUILDING OPERATIONAL HOURS.
- PROVIDE ON/OFF SWITCH FOR ALL EXHAUST FANS IN SHOP.
- PROVIDE ON/OFF SWITCH FOR SUPPLY FAN.
- PROVIDE 3/4" CONDUIT WITH PULLSTRING TO EACH FLOOR MOUNTED DATA/COMMUNICATIONS JUNCTION BOX. (TYPICAL)

FIRE ALARM NOTES

FIRE ALARM EQUIPMENT SHOWN IS DIAGRAMMATIC ONLY. CONTRACTOR TO PROVIDE COMPLETE SYSTEM DESIGNED BY A STATE LICENSED DESIGN PROFESSIONAL.

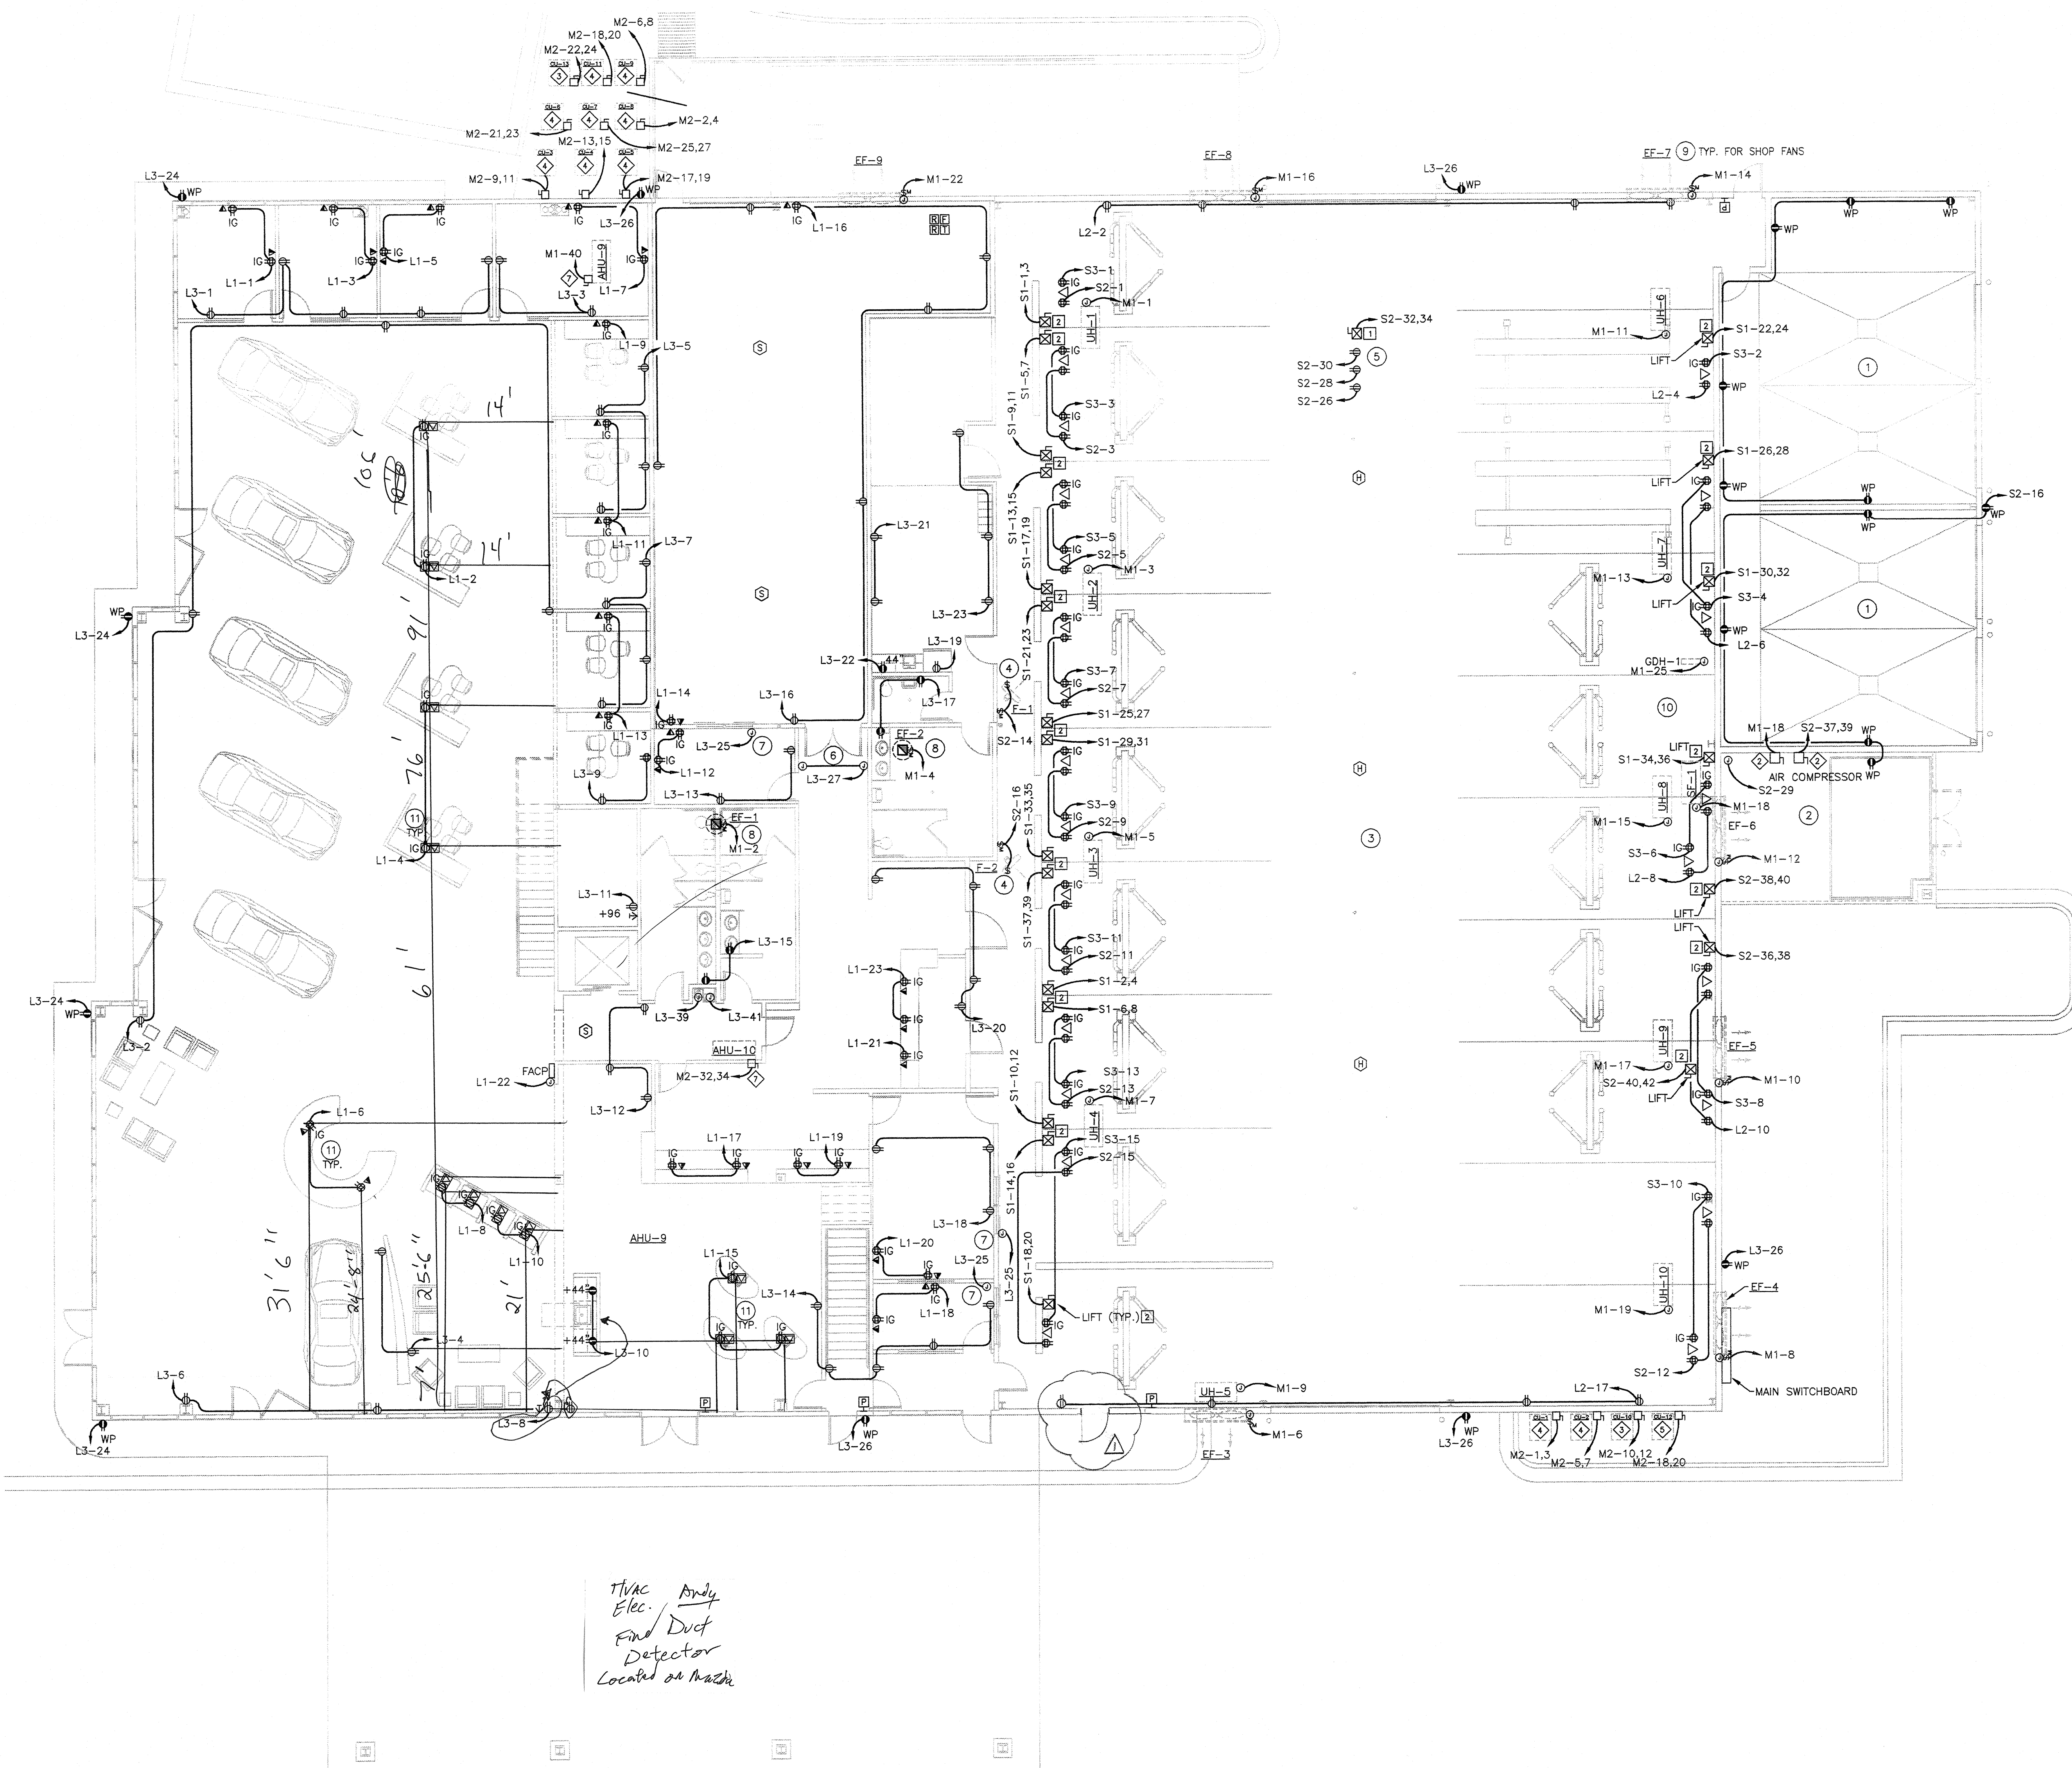

01 FIRST FLOOR - POWER PLAN
SCALE 1/8" = 1'-0"

MYERS & ASSOCIATES


This document, the ideas and designs incorporated herein are and shall remain the property of Myers & Associates. These documents are not to be used or altered, in whole or in part, for other than the original intended use, nor are they to be assigned to any third party without written permission from Myers & Associates. ©

M & A Job no.: 01-016

AN AUTOMOTIVE DEALERSHIP
ROGER BEASLEY VOLVO
INTERSTATE HIGHWAY 35 SOUTH
GEORGETOWN, TEXAS

ELSSASSER ARCHITECTURAL INC.
ARCHITECTURE AND PLANNING
P.O. BOX 689 GEORGETOWN, TX 78627
(512) 862-3359 FAX (512) 862-3818 www.esa.com

CONSULTANT SEAL:

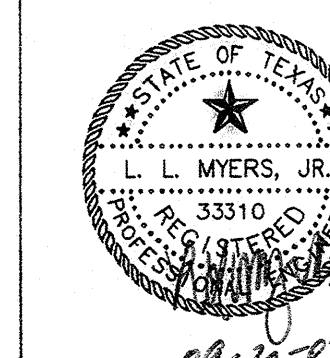


NO.	REVISIONS
1	RELINQUISH DESIGN
DATE: 09/20/02	

REVISION DATE:
1 12-04-02

PROJECT NO.
020008

SHEET NO.

E3.0

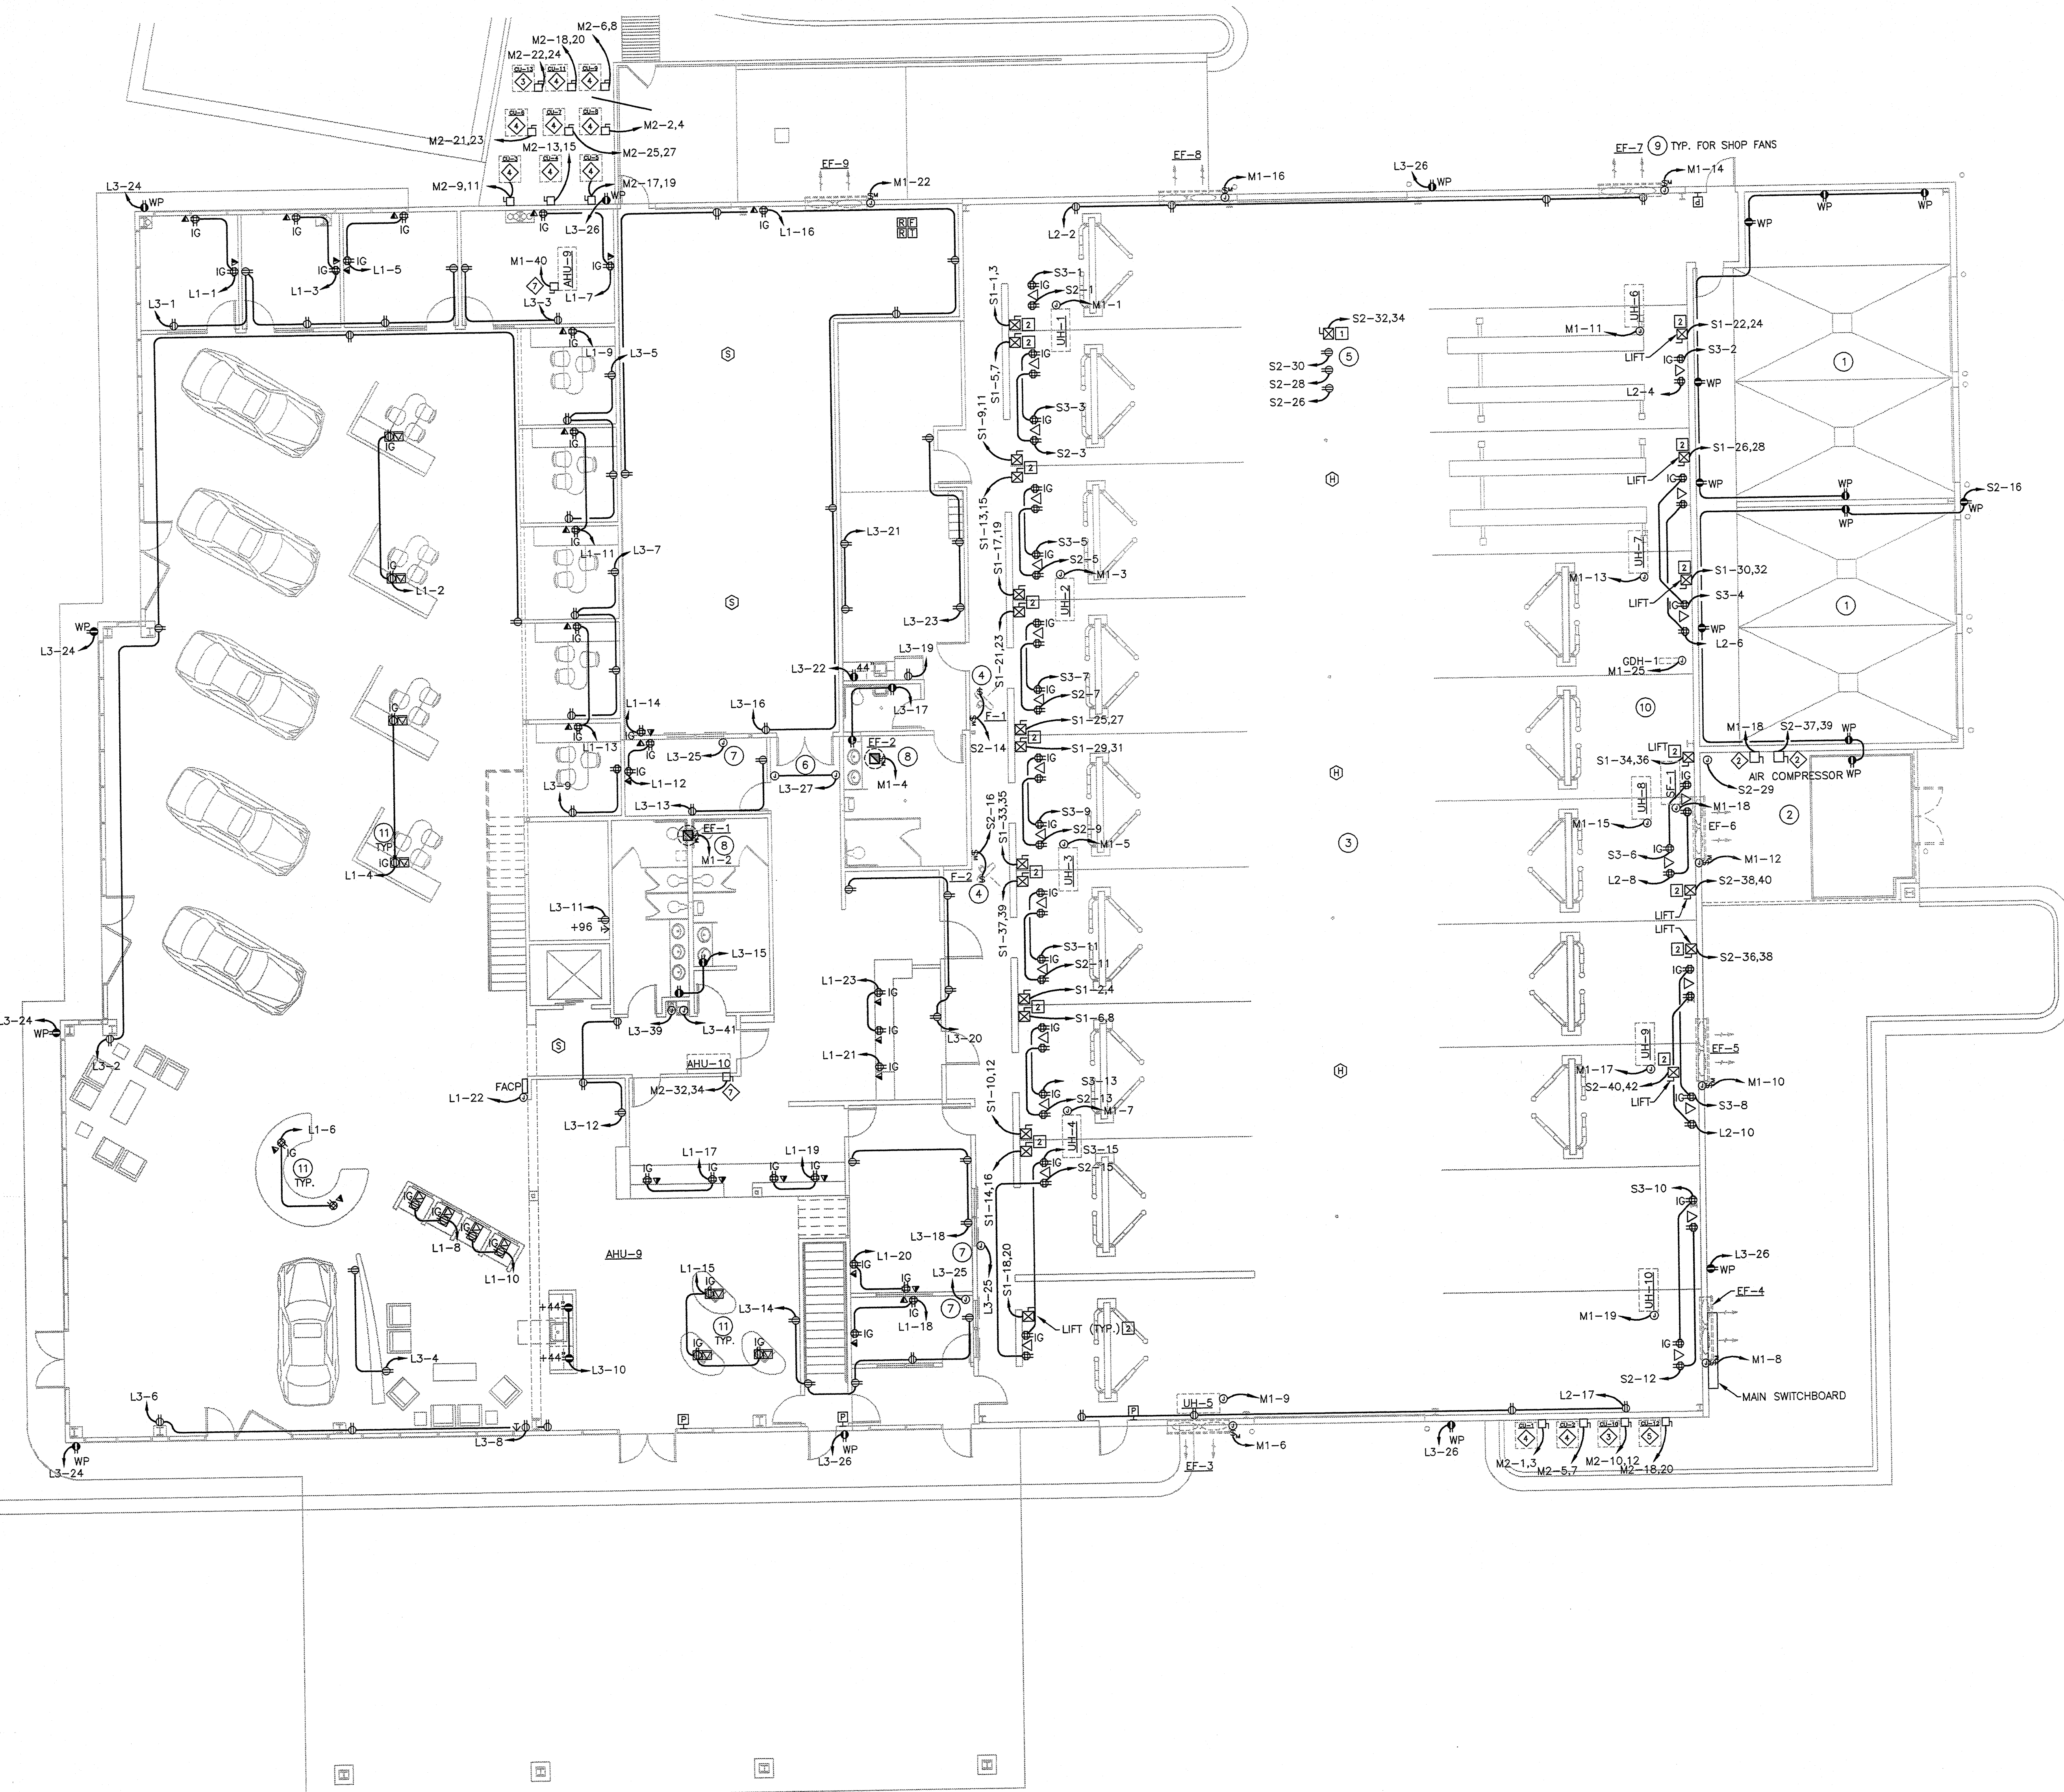

KEYED NOTES

THESE NOTES APPLY TO THIS SHEET ONLY

- OWNER PROVIDED WASH BAY EQUIPMENT. VERIFY EXACT ELECTRICAL REQUIREMENTS PRIOR TO ANY WORK.
- OWNER PROVIDED AIR COMPRESSOR AND AIR DRYER. VERIFY EXACT REQUIREMENTS PRIOR TO ANY WORK.
- ALL SERVICE BAY SERVICE EQUIPMENT TO BE OWNER PROVIDED. COORDINATE EXACT ELECTRICAL REQUIREMENTS WITH OWNER PRIOR TO ANY WORK. ALL RECEPTACLES AND TELECOMMUNICATIONS DEVICES TO BE MOUNTED AT 42" AFF. PROVIDE CONDUIT WITH PULLSTRING FROM EACH TELECOMMUNICATIONS DEVICE TO TELEPHONE EQUIPMENT ROOM ON SECOND FLOOR.
- COORDINATE WITH OWNER FOR LOCATION OF "ON/OFF" SWITCH TO FAN.
- PROVIDE CONNECTION FOR TIRE MAINTENANCE EQUIPMENT TO BE PROVIDED BY OWNER. EQUIPMENT TO INCLUDE BUT NOT LIMITED TO TIRE CHANGER, WHEEL BALANCER, ALIGNMENT MACHINE, AND LASER ALIGNMENT MACHINE. COORDINATE WITH OWNER FOR EXACT EQUIPMENT REQUIREMENTS AND LOCATION SHOWN IN THIS LOCATION FOR CLARITY ONLY.
- PROVIDE CONNECTION TO AUTOMATIC DOOR CLOSERS. COORDINATE WITH GENERAL CONTRACTOR AND FIRE ALARM CONTRACTOR FOR EXACT REQUIREMENTS.
- PROVIDE CONNECTION TO AUTOMATIC ROLL DOWN FIRE SHUTTERS. COORDINATE WITH GENERAL CONTRACTOR AND FIRE ALARM CONTRACTOR FOR EXACT REQUIREMENTS.
- CIRCUIT EXHAUST FANS EF-1 AND EF-2 THROUGH LIGHTING TIMECLOCK AND PROGRAM TO RUN DURING BUILDING OPERATIONAL HOURS.
- PROVIDE ON/OFF SWITCH FOR ALL EXHAUST FANS IN SHOP.
- PROVIDE ON/OFF SWITCH FOR SUPPLY FAN.
- PROVIDE 3/4" CONDUIT WITH PULLSTRING TO EACH FLOOR MOUNTED DATA/COMMUNICATIONS JUNCTION BOX. (TYPICAL)

FIRE ALARM NOTES

FIRE ALARM EQUIPMENT SHOWN IS DIAGRAMMATIC ONLY. CONTRACTOR TO PROVIDE COMPLETE SYSTEM DESIGNED BY A STATE LICENSED DESIGN PROFESSIONAL.


01 FIRST FLOOR - POWER PLAN
SCALE: 1/8" = 1'-0"


SEE
REVISION

AN AUTOMOTIVE DEALERSHIP
ROGER BEASLEY VOLVO
INTERSTATE HIGHWAY 35 SOUTH
GEORGETOWN, TEXAS

ELASSER ARCHITECTURAL INC.
ARCHITECTURE AND PLANNING
P.O. BOX 823 GEORGETOWN, TX 78627
(512) 866-3333 FAX (512) 866-2818 www.eah-inc.com

CONSULTANT SEAL:

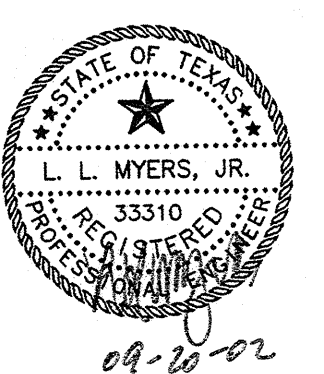

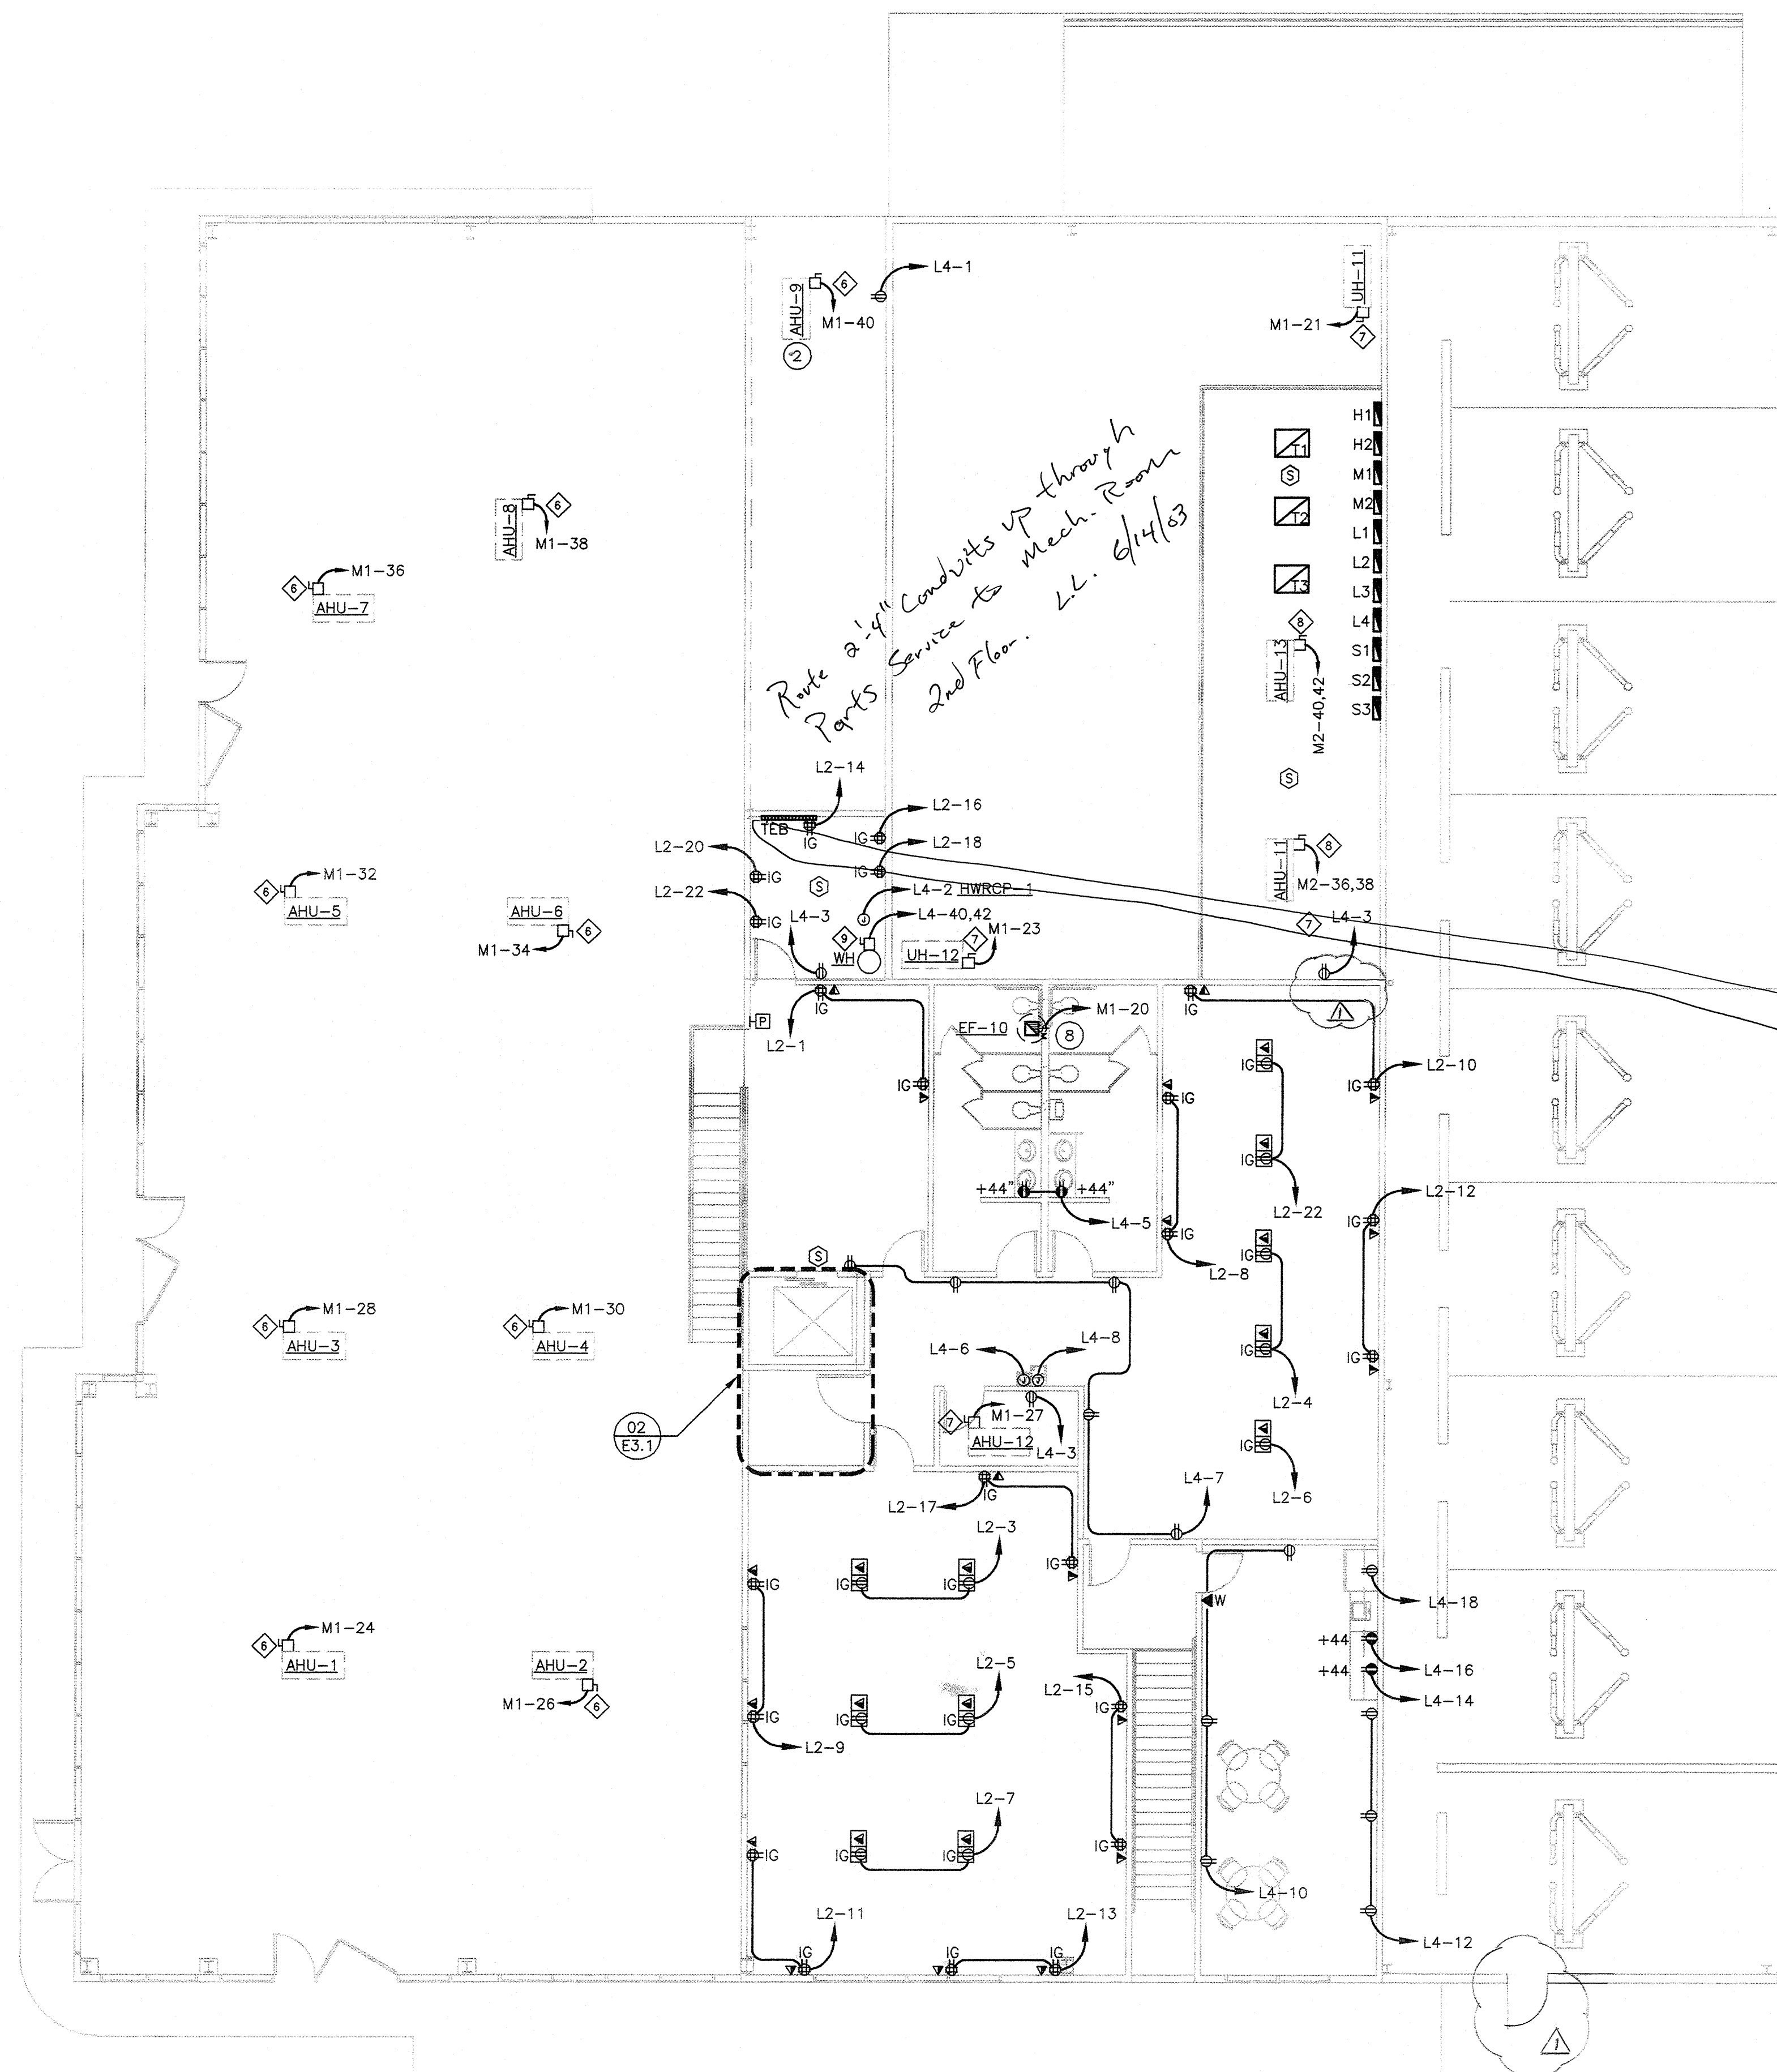

01 SECOND FLOOR - POWER PLAN
SCALE: 1/8" = 1'-0"


KEYED NOTES


THESE NOTES APPLY TO THIS SHEET ONLY.

1. WALL MOUNTED PHONE. VERIFY EXACT LOCATION WITH OWNER.
2. AHU-9 MOUNTED ABOVE CEILING. COORDINATE EXACT LOCATION WITH MECHANICAL CONTRACTOR. MOUNT RECEPTACLE AND DISCONNECT IN PLAIN SIGHT FROM ACCESS PANEL.
3. FOR CONNECTION TO ELEVATOR COMMUNICATIONS SYSTEM.
4. COORDINATE EXACT DISCONNECT REQUIREMENTS WITH ELEVATOR MANUFACTURER.
5. PROVIDE LOCKABLE, ENCLOSED CIRCUIT BREAKER, SQUARE D #002TR WITH ONE (1) 00120 CIRCUIT BREAKER FOR CONNECTION TO ELEVATOR CAB LIGHTS AND VENTILATION FAN.
6. THE MANUAL SWITCH FOR THE SUMP PUMP SHALL BE LOCATED ABOVE THE HOSE BIBS AND MARKED "SUMP PUMP". VERIFY EXACT LOCATION WITH ELEVATOR MANUFACTURER AND PLUMBING CONTRACTOR PRIOR TO ANY WORK.
7. MOUNT SMOKE AND HEAT DETECTORS AT TOP OF ELEVATOR SHAFT.
8. CIRCUIT EF-10 THROUGH LIGHTING TIMECLOCK AND PROGRAM TO RUN DURING BUILDING OPERATIONAL HOURS.

FIRE ALARM NOTES

FIRE ALARM EQUIPMENT SHOWN IS DIAGRAMMATIC ONLY. CONTRACTOR TO PROVIDE COMPLETE SYSTEM DESIGNED BY A STATE LICENSED DESIGN PROFESSIONAL.

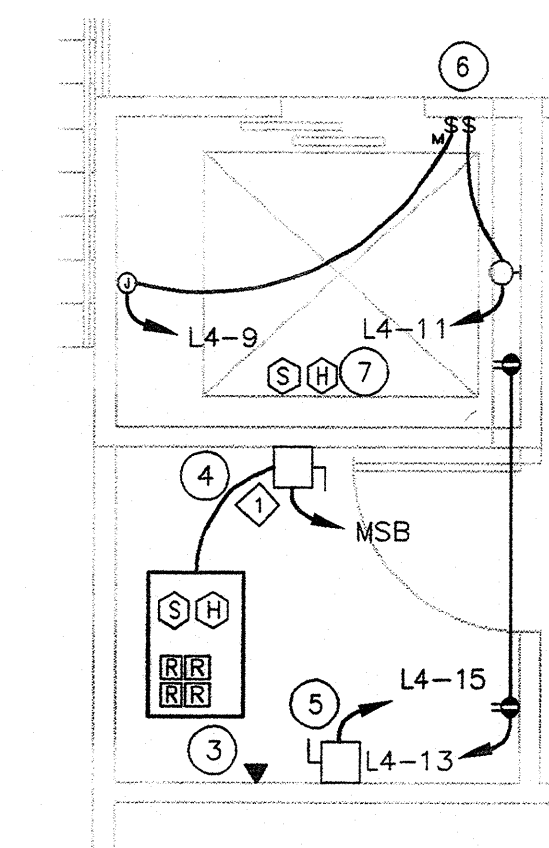

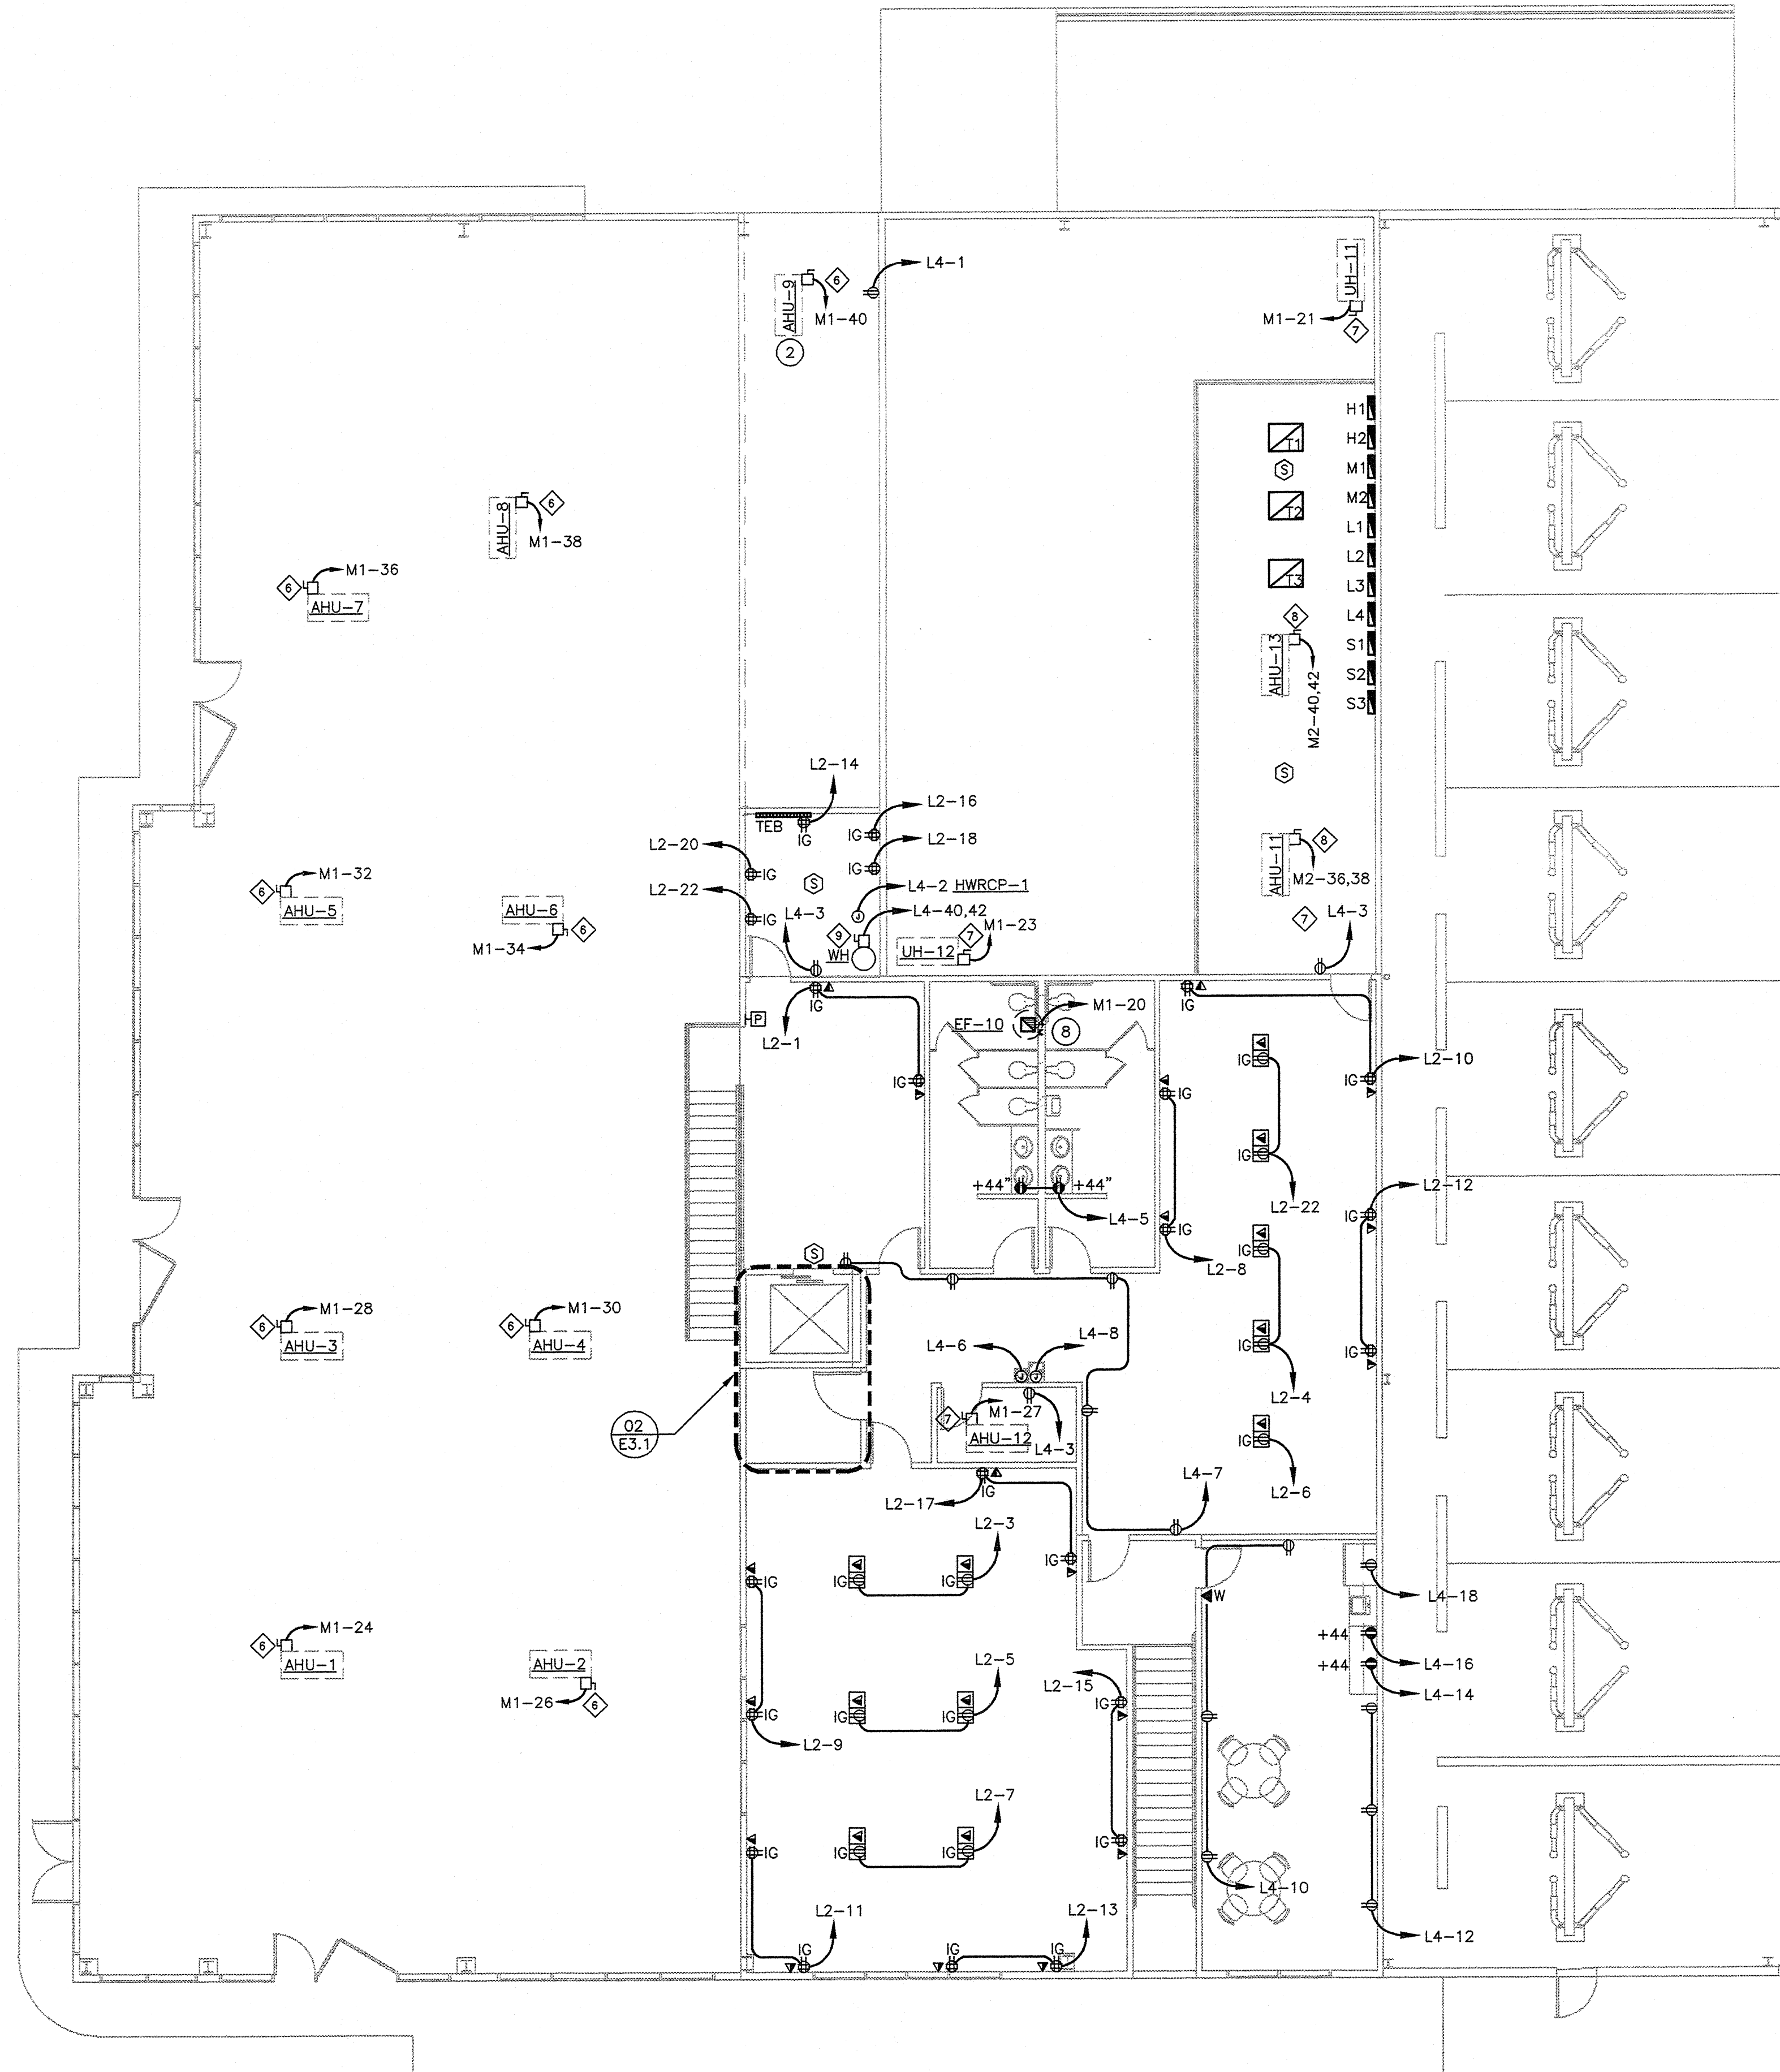

01 SECOND FLOOR - POWER PLAN
SCALE: 1/8" = 1'-0"


KEYED NOTES

THESE NOTES APPLY TO THIS SHEET ONLY

- ① WALL MOUNTED PHONE. VERIFY EXACT LOCATION WITH OWNER.
- ② AHU-9 MOUNTED ABOVE CEILING. COORDINATE EXACT LOCATION WITH MECHANICAL CONTRACTOR. MOUNT RECEPTACLE AND DISCONNECT IN PLAIN SIGHT FROM ACCESS PANEL.
- ③ FOR CONNECTION TO ELEVATOR COMMUNICATIONS SYSTEM.
- ④ COORDINATE EXACT DISCONNECT REQUIREMENTS WITH ELEVATOR MANUFACTURER.
- ⑤ PROVIDE LOCKABLE, ENCLOSED CIRCUIT BREAKER, SQUARE D #Q02TR WITH ONE (1) Q0120 CIRCUIT BREAKER FOR CONNECTION TO ELEVATOR CAB LIGHTS AND VENTILATION FAN.
- ⑥ THE MANUAL SWITCH FOR THE SUMP PUMP SHALL BE LOCATED ABOVE THE HOSE BIBS AND MARKED "SUMP PUMP". VERIFY EXACT LOCATION WITH ELEVATOR MANUFACTURER AND PLUMBING CONTRACTOR PRIOR TO ANY WORK.
- ⑦ MOUNT SMOKE AND HEAT DETECTORS AT TOP OF ELEVATOR SHAFT.
- ⑧ CIRCUIT EF-10 THROUGH LIGHTING TIMECLOCK AND PROGRAM TO RUN DURING BUILDING OPERATIONAL HOURS.

FIRE ALARM NOTES

FIRE ALARM EQUIPMENT SHOWN IS DIAGRAMMATIC ONLY. CONTRACTOR TO PROVIDE COMPLETE SYSTEM DESIGNED BY A STATE LICENSED DESIGN PROFESSIONAL.

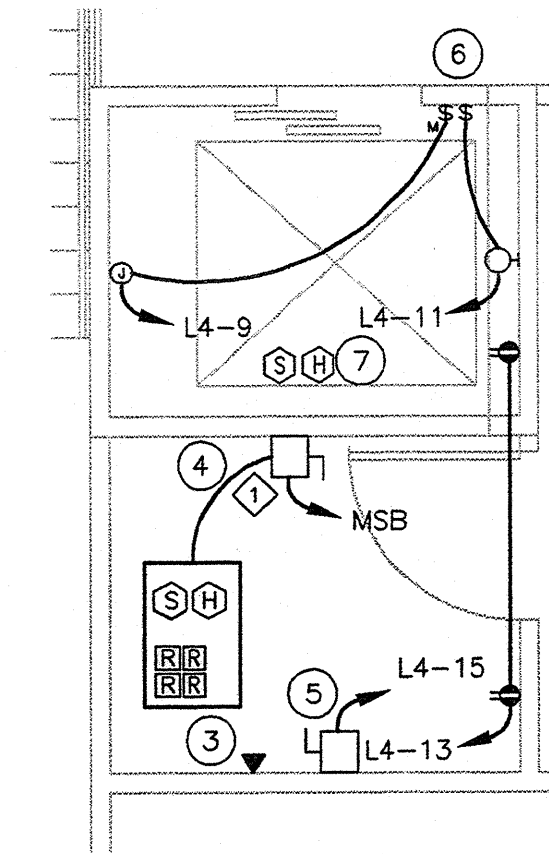


02 ENLARGED PLAN ELEVATOR/EQ. ROOMS
SCALE: 1/4" = 1'-0"

AN AUTOMOTIVE DEALERSHIP
ROGER BEASLEY VOLVO

INTERSTATE HIGHWAY 35 SOUTH
GEORGETOWN, TEXAS

**ELSASSER
ARCHITECTURAL
INC.**
ARCHITECTURE AND PLANNING
P.O. BOX 833 GEORGETOWN, TX 78627
(817) 880-5553 FAX (817) 880-2818 www.elsa-h.com

CONSULTANT SEAL:

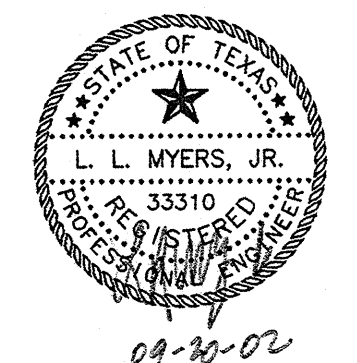

SEE
REVISION

GENERAL NOTES

- ALL ELECTRICAL WORK SHALL COMPLY WITH N.E.C. AND ALL LOCAL CODES.
- ALL GROUNDING SHALL BE PER N.E.C. AND LOCAL CODES.
- THE ELECTRICAL CONTRACTOR SHALL COORDINATE HIS WORK WITH OTHER TRADES TO AVOID CONFLICT AT THE SITE.
- THE ELECTRICAL CONTRACTOR SHALL VERIFY SIZES OF BREAKERS, FUSES, WIRES, ETC., FOR ALL EQUIPMENT PROVIDED AND REPORT DISCREPANCIES TO THE ENGINEER/ARCHITECT PRIOR TO MAKING CONNECTION.
- HOMERUNS SHALL BE COORDINATED WITH PANELBOARD SCHEDULES. ALL WIRING AND CONDUIT SHALL BE CONCEALED, EXCEPT IN ELECTRICAL ROOMS.
- ALL WIRING SHALL BE FREE OF SHORTS AND GROUNDS. NO WIRING SHALL BE LOCATED BEYOND THE PERMITTED AMPACITIES ALLOWED BY N.E.C.
- MINIMUM WIRE/CONDUIT SIZES, EXCEPT FOR CLASS 2 LOW VOLTAGE CIRCUITS, ARE #12 AWG COPPER IN 1/2" CONDUIT.
- THE ELECTRICAL CONTRACTOR SHALL PROVIDE ALL EQUIPMENT AND MATERIALS NECESSARY TO MAKE A COMPLETE AND WORKABLE JOB.
- CONFIRM THE EXACT LOCATION AND MOUNTING OF LIGHTING FIXTURES WITH ARCHITECT BEFORE ROUGH-IN.
- THE ELECTRICAL CONTRACTOR SHALL VERIFY ALL CONDITIONS AND DIMENSIONS IN FIELD PRIOR TO SUBMITTING BID.
- LABEL ALL CIRCUITS PROPERLY ON PANELBOARD INDEX.
- THE CONTRACTOR IS TO LAY OUT SERVICE ENTRANCE AND PANELS TO SCALE WITH ACTUAL GEAR TO BE INSTALLED TO ENSURE PROPER FIT AND CLEARANCES BEFORE INSTALLATION. NOTIFY ARCHITECT/ENGINEERS OF ANY DIMENSIONAL PROBLEMS.
- ALL RECEPTACLES SERVING ELECTRIC WATER COOLERS SHALL BE LOCATED AT A HEIGHT SO AS NOT TO BE VISIBLE AFTER INSTALLATION OF EWC. COORDINATE MOUNTING HEIGHT WITH EQUIPMENT BEING PROVIDED.
- ALL CONDUIT AND OR CONDUCTORS RUN EXPOSED AT STRUCTURE ABOVE SHALL BE ROUTED AS HIGH AS POSSIBLE NEAR DECK.
- ALL EXTERIOR LIGHTING SHALL BE HOODED OR SHIELDED FROM THE VIEW OF ADJACENT PROPERTY.

FIRE ALARM LEGEND

NOTE:
A. ALL SYMBOLS DO NOT NECESSARILY APPEAR ON THESE DRAWINGS

SYMBOL	DESCRIPTION	REMARKS
	FIRE ALARM CONTROL PANEL	
	SMOKE CONTROL PANEL	
	VESDA DETECTOR(S)	
	FIRE ALARM ANNUNCIATOR	
	FIREMAN'S TELEPHONE JACK, 48" AFF UON	
	SMOKE DETECTOR	
	DUCT SMOKE DETECTOR	
	FLOW SWITCH	
	HEAT DETECTOR	
	SUPPRESSION SYSTEM MONITOR	
	TAMPER SWITCH	
	VESDA PORT	
	CEILING SPEAKER	
	SHUT DOWN RELAY	
	DOOR HOLDER	
	STROBE ONLY ALARM, 80" AFF UON	
	FIRE ALARM MANUAL PULL STATION, 48" AFF UON	
	HORN/STROBE ALARM, 80" AFF UON	
	MINI-HORN/STROBE ALARM, 80" AFF UON	
	HORN (HIGH AMBIENT NOISE AREAS), 144" AFF UON	
	WEATHERPROOF HORN ONLY ALARM, 144" AFF UON	

TELECOMMUNICATION/DATA LEGEND

NOTE:
A. ALL SYMBOLS DO NOT NECESSARILY APPEAR ON THESE DRAWINGS

SYMBOL	DESCRIPTION
	TELEPHONE OUTLET, 16" AFF, JUNCTION BOX WITH 3/4" CONDUIT TO ABOVE CEILING, UON
	TELEPHONE OUTLET, FLOOR MOUNTED FLUSH WITH 3/4" CONDUIT ROUTED TO NEAREST WALL, UON
	PUBLIC PAY TELEPHONE OUTLET, 48" AFF, JUNCTION BOX WITH 3/4" CONDUIT TO ABOVE CEILING, UON
	COMBINATION TELEPHONE/DATA OUTLET, 16" AFF, JUNCTION BOX WITH 3/4" CONDUIT TO ABOVE CEILING, UON
	COMBINATION TELEPHONE/DATA OUTLET, FLOOR MOUNTED FLUSH WITH 3/4" CONDUIT ROUTED TO NEAREST WALL, UON
	DATA OUTLET, 16" AFF UON, JUNCTION BOX WITH 3/4" CONDUIT TO ABOVE CEILING, UON
	DATA OUTLET, FLOOR MOUNTED FLUSH WITH 3/4" CONDUIT ROUTED TO NEAREST WALL, UON
	TELEPHONE EQUIPMENT BOARD, 3/4" PAINTED PLYWOOD, 4'x8', UON

DEVICE LEGEND

NOTES:
A. ALL SYMBOLS DO NOT NECESSARILY APPEAR ON THESE DRAWINGS
B. ALL DEVICE PART NUMBERS ARE HUBBELL UNLESS OTHERWISE NOTED.

SYMBOL	DESCRIPTION	REMARKS
	SINGLE RECEPTACLE 20A/120V 16" AFF UON	5361-I
	DUPLEX RECEPTACLE 20A/120V 16" AFF UON	CR20-I
	DUPLEX RECEPTACLE 20A/120V 16" AFF UON WITH GROUND FAULT INTERRUPTER	GF5352-I
	DUPLEX RECEPTACLE 20A/120V 16" AFF UON WITH ISOLATED/INSULATED GROUND	IG5362-I
	FOURPLEX RECEPTACLE 20A/120V 16" AFF UON	(2) CR20-I
	CLOCK RECEPTACLE 120V 96" AFF UON	5235-I
	SPECIAL PURPOSE RECEPTACLE 16" AFF SEE PLANS FOR DETAILS	
	WEATHER-PROOF DUPLEX RECEPTACLE 20A/120V 18" AFF UON W/GFI	GF5352-I / WP26
	DUPLEX RECEPTACLE 20A/120V 16" AFF UON TAMPER RESISTANT	TR831
	DUPLEX RECEPTACLE, FLOOR MOUNTED	CR20-I, SC3091
	FOURPLEX RECEPTACLE, FLOOR MOUNTED	(2) CR15-I, SC3091
	SINGLE POLE SWITCH 20A, 48" AFF UON	CS120-I
	THREE-WAY SWITCH 20A, 48" AFF UON	CS320-I
	FOUR-WAY SWITCH 20A, 48" AFF UON	1224-I
	SINGLE POLE KEY OPERATED SWITCH 20A, 48" AFF UON	ARROW HART 1191/1187
	DIMMER SWITCH, 48" AFF UON, SEE PLANS FOR DETAILS	
	SWITCH WITH PILOT LIGHT, 48" AFF UON	1297-I
	TIMER SWITCH, 48" AFF UON	INTERMATIC FF60MH
	FAN SWITCH, 48" AFF UON	RF51
	MANUAL STARTER WITH THERMAL TRIP	
	PHOTOCELL	
	JUNCTION BOX	
	JUNCTION BOX, FLOOR MOUNTED	
	JUNCTION BOX, WALL MOUNTED	
	DISCONNECT SWITCH, REFER TO DISCONNECT SCHEDULE	
	COMBINATION STARTER/DISCONNECT SWITCH, REFER TO SCHEDULE	
	POWER CABLE PULL-BOX	
	RELAY	WATT STOPPER #S-120/217/347-E
	MOTION SENSOR, SEE PLANS FOR DETAILS	
	EQUIPMENT MOTOR	
	VARIABLE SPEED DRIVE	
	POWER AND/OR LIGHTING PANELBOARD, REFER TO SCHEDULES	
	SWITCHBOARD, REFER TO SWITCHBOARD SCHEDULE	
	TRANSFORMER, REFER TO TRANSFORMER SCHEDULE	
	HOMERUN (REFER TO PANEL SCHEDULES FOR CONDUIT/WIRING)	
	CIRCUIT ROUTED THRU CONTACTOR OR RELAY	
	UNDERGROUND ELECTRIC	
	UNDERGROUND TELEPHONE	
	OVERHEAD ELECTRIC	
	OVERHEAD TELEPHONE	
	CIRCUIT INDICATORS (HOT, NEUTRAL, GROUND, SWITCH/LEG)	

BRANCH CIRCUIT WIRE AND CONDUIT SCHEDULE

NOTE: USING THHN, EMT
C - CONDUIT G - GROUND IG - ISOLATED GROUND L - LINE OR PHASE N - NEUTRAL

MARK	WIRE AND CONDUIT	SYSTEM	MARK	WIRE AND CONDUIT	SYSTEM	MARK	WIRE AND CONDUIT	SYSTEM			
(1)	1#12, 1#12G, 1/2" C. LING	(29)	2#4, 3/4" C. LING	(57)	2#1/0, 1 1/4" C. LING	(1)	1#12, 1#12G, 1/2" C. LING	(29)	2#4, 3/4" C. LING	(57)	2#1/0, 1 1/4" C. LING
(2)	2#12, 1#12G, 1/2" C. LING	(30)	2#4, 1#8G, 1" C. LING	(58)	2#1/0, 1#6G, 1 1/4" C. LING	(2)	2#12, 1#12G, 1/2" C. LING	(30)	2#4, 1#8G, 1" C. LING	(58)	2#1/0, 1#6G, 1 1/4" C. LING
(3)	3#12, 1#12G, 1/2" C. LLL	(31)	2#4, 1#8G, 1" C. LLL	(59)	3#1/0, 1 1/4" C. LLL	(3)	3#12, 1#12G, 1/2" C. LLL	(31)	2#4, 1#8G, 1" C. LLL	(59)	3#1/0, 1 1/4" C. LLL
(4)	3#12, 1/2" C. LLL	(32)	3#4, 1" C. LLL	(60)	3#1/0, 1#6G, 1 1/2" C. LLL	(4)	3#12, 1/2" C. LLL	(32)	3#4, 1" C. LLL	(60)	3#1/0, 1#6G, 1 1/2" C. LLL
(5)	3#12, 1#12G, 1/2" C. LLLG	(33)	3#4, 1#8G, 1 1/4" C. LLLG	(61)	3#1/0, 1#6G, 1 1/2" C. LLLG	(5)	3#12, 1#12G, 1/2" C. LLLG	(33)	3#4, 1#8G, 1 1/4" C. LLLG	(61)	3#1/0, 1#6G, 1 1/2" C. LLLG
(6)	3#12, 1#12G, 1/2" C. LLLG	(34)	3#4, 1#8G, 1 1/4" C. LLLG	(62)	3#1/0, 1#6G, 1 1/2" C. LLLG	(6)	3#12, 1#12G, 1/2" C. LLLG	(34)	3#4, 1#8G, 1 1/4" C. LLLG	(62)	3#1/0, 1#6G, 1 1/2" C. LLLG
(7)	4#12, 1#12G, 1/2" C. LLLG	(35)	4#4, 1#8G, 1 1/4" C. LLLG	(63)	4#1/0, 1#6G, 2" C. LLLG	(7)	4#12, 1#12G, 1/2" C. LLLG	(35)	4#4, 1#8G, 1 1/4" C. LLLG	(63)	4#1/0, 1#6G, 2" C. LLLG
(8)	2#10, 3/4" C. LN	(36)	LN 2#3, 1" C. LN	(64)	2#2/0, 1 1/2" C. LN	(8)	2#10, 3/4" C. LN	(36)	LN 2#3, 1" C. LN	(64)	2#2/0, 1 1/2" C. LN
(25)	3#6, 1" C. LLL	(53)	3#1, 1 1/4" C. LLL	(81)	3#4/0, 2" C. LLL	(25)	3#6, 1" C. LLL	(53)	3#1, 1 1/4" C. LLL	(81)	3#4/0, 2" C. LLL
(26)	3#6, 1#10G, 1" C. LLLG	(54)	3#1, 1#6G, 1 1/2" C. LLLG	(82)	3#4/0, 1#4G, 2" C. LLLG	(26)	3#6, 1#10G, 1" C. LLLG	(54)	3#1, 1#6G, 1 1/2" C. LLLG	(82)	3#4/0, 1#4G, 2" C. LLLG
(27)	3#6, 1#10G, 1" C. LLLG	(55)	3#1, 1#6G, 1 1/2" C. LLLG	(83)	3#4/0, 1#4G, 2" C. LLLG	(27)	3#6, 1#10G, 1" C. LLLG	(55)	3#1, 1#6G, 1 1/2" C. LLLG	(83)	3#4/0, 1#4G, 2" C. LLLG
(28)	4#6, 1#10G, 1" C. LLLG	(56)	4#1, 1#6G, 2" C. LLLG	(84)	4#4/0, 1#4G, 2 1/2" C. LLLG	(28)	4#6, 1#10G, 1" C. LLLG	(56)	4#1, 1#6G, 2" C. LLLG	(84)	4#4/0, 1#4G, 2 1/2" C. LLLG

LIGHT FIXTURE SCHEDULE

GENERAL NOTES:
A. CONFIRM CEILING TYPE AND CONSTRUCTION PRIOR TO ORDERING LIGHT FIXTURE.
B. COORDINATE EXACT LOCATION AND MOUNTING HEIGHT OF WALL MOUNTED LIGHT FIXTURES WITH ARCHITECT PRIOR TO ROUGH-IN.
C. REFER TO ARCHITECTURAL REFLECTIVE CEILING PLAN FOR EXACT LOCATION OF LIGHT FIXTURE.
D. CONFIRM FINISH WITH ARCHITECT PRIOR TO ORDERING LIGHT FIXTURES.
E. 'E' DESIGNATION ADJACENT TO LIGHTING FIXTURE TYPE INDICATES FIXTURE SHALL BE PROVIDED WITH EMERGENCY BATTERY PACK UNIT (BODINE 890 OR EQUAL). LIGHT FIXTURE SHALL BE SWITCHED. BATTERY PACK SHALL BE UNSWITCHED.
F. 'N' DESIGNATION ADJACENT TO LIGHTING FIXTURE TYPE INDICATES FIXTURE SHALL BE UNSWITCHED TO OPERATE 24 HOURS DAILY.

MARK	MANUFACTURER'S CATALOG NUMBER	LAMPS NO./TYPE/WATTS	FIXTURE VOLTS/WATTS	DESCRIPTION AND COMMENTS
A	HUBBELL BL-400H8-BI-WH	1/MH 400W/U	277/450	14" INDUSTRIAL HIGH-BAY WITH SPUN ALUMINUM REFLECTOR WITH UP-LIGHT COMPONENT. WHITE FINISHED HOUSING.
B	HUBBELL BL-400H8-LM-WH	1/MH 400W/U	277/450	28" INDUSTRIAL LOW-BAY FIXTURE WITH SPUN ALUMINUM REFLECTOR AND ACRYLIC REFRACTOR. WHITE FINISH HOUSING AND REFLECTOR.
C	HE WILLIAMS U36-022-232U-335-EB2-277V	2/F32T8SPX35	277/65	2'x2' PARABOLIC LAY-IN FIXTURE WITH 8-CELLS, AND ELECTRONIC BALLAST. SILVER FINISHED LOUVER. WHITE HOUSING FINISH.
D	HE WILLIAMS 80-4-232-WG11-EB2-277V	2/F32T8SPX35	277/65	4' INDUSTRIAL FLUORESCENT FIXTURE WITH ELECTRONIC BALLAST AND WIRE GUARD. WHITE FINISHED REFLECTOR, HOUSING AND WIRE GUARD.
F	HE WILLIAMS 92-4-232-A-EB2-277V	2/F32T8SPX35	277/65	4' VAPORTITE INDUSTRIAL FLUORESCENT FIXTURE WITH 2-LAMPS, ELECTRONIC BALLAST AND FIBERGLASS HOUSING. WET LOCATION LISTED.
G	HE WILLIAMS 28-4-232-A-CT-EB2-277V	2/F32T8SPX35	277/65	4' WALL MOUNT FLUORESCENT FIXTURE WITH SOLID TOP, .125" ACRYLIC LENS AND ELECTRONIC BALLAST. WHITE FINISH.
H	INFINITY PXR0-132T-EB-SG	1/CF32T1TSPX35	277/35	6" COMPACT FLUORESCENT DOWNLIGHT WITH SATIN-GLOW REFLECTOR AND ELECTRONIC BALLAST.
J	INFINITY DR45-SG	1/50W MR16/NFL	120/50	4.5" LOW-VOLTAGE DOWNLIGHT WITH INTEGRAL TRANSFORMER AND SATIN-GLOW, SELF-FLANGED REFLECTOR.
K	PRESCOLITE (1)TS8-WH, (1)TS10-WH, (6)TV104-WH	6/250W PAR38	120/1500	8' SINGLE CIRCUIT TRACK WITH (6) FLAT BACK CYLINDER TYPE FIXTURE. WHITE FINISH. VERIFY EXACT MOUNTING CONFIGURATION PRIOR TO ORDER. PROVIDE PENDANTS AND ADDITIONAL LENGTH TRACK AND FIXTURES AS REQUIRED.
L	INFINITY MH10-175-SG	1/175W MH/ED28/MOG	277/210	10" RECESSED DOWNLIGHT WITH SATIN-GLOW FINISHED REFLECTOR. CLEAR TEMPERED GLASS SHIELD AND DUAL-TAP BALLAST.
M	INFINITY MH13-250-SG	1/250W MH/ED28/MOG	277/300	13" RECESSED DOWNLIGHT WITH SATIN-GLOW FINISHED REFLECTOR. CLEAR TEMPERED GLASS SHIELD AND DUAL-TAP BALLAST.
N	LUMARK MH13-400-SG	1/400W MH/ED28/MOG	277/450	13" RECESSED DOWNLIGHT WITH SATIN-GLOW FINISHED REFLECTOR. CLEAR TEMPERED GLASS SHIELD AND DUAL-TAP BALLAST.
P	KIM WD1803/250MH277/WH-P	1/250W MH/ED28/MOG	277/300	WALL MOUNTED AREA LIGHT WITH CAST ALUMINUM HOUSING. TYPE III DISTRIBUTION AND FULL CUT-OFF DOWNLIGHT. WHITE FINISH.
R	PHOENIX DL-INC-LH/DL-42-ARM	1/300W PAR38	120/300	WALL MOUNT DOCK LIGHT WITH 42" ARM AND INCANDESCENT LIGHT HEAD.
X1	DUAL LITE LUXRW	INCLUDED	120/10	UNIVERSAL MOUNT EXIT SIGN WITH RED LED LETTERS. NICKEL CADMIUM BACK-UP BATTERY, AND WHITE POLYCARBONATE HOUSING.
OA	SPAULDING (5)CVM-PM-M400-B-480-DBZ 20-SQS-407-SGL-DBZ	1/MH 400W/U	480/450	SINGLE MOUNT 400W METAL HALIDE SHOEBOX FIXTURE WITH TYPE II DISTRIBUTION. ARM MOUNTED ON A 20" STRAIGHT SQUARE STEEL POLE. DARK BRONZE FINISH.
OB	SPAULDING (2)CVM-PM-M400-N-480-DBZ 20-SQS-407-DBL-90-DBZ	2/MH 400W/U	480/900	DUAL MOUNT 400W METAL HALIDE SHOEBOX FIXTURES WITH TYPE II DISTRIBUTION. ARM MOUNTED ON A 20" STRAIGHT SQUARE STEEL POLE. DARK BRONZE FINISH.
OC	SPAULDING (5)CVM-PM-M400-B-480-DBZ 20-SQS-407-TPL-DBZ	3/MH 400W/U	480/1350	TRIPLE MOUNT 400W METAL HALIDE SHOEBOX FIXTURES WITH TYPE III DISTRIBUTION. ARM MOUNTED ON A 20" STRAIGHT SQUARE STEEL POLE. DARK BRONZE FINISH.
OD	SPAULDING (5)CVM-PM-M400-N-480-DBZ 20-SQS-407-TPL-DBZ	3/MH 400W/U	480/1350	TRIPLE MOUNT 400W METAL HALIDE SHOEBOX FIXTURES WITH TYPE IV DISTRIBUTION. ARM MOUNTED ON A 20" STRAIGHT SQUARE STEEL POLE. DARK BRONZE FINISH.
OE	SPAULDING (4)CVM-PM-M400-N-480-DBZ 20-SQS-407-QUAD-DBZ	4/MH 400W/U	480/1800	QUAD MOUNT 400W METAL HALIDE SHOEBOX FIXTURES WITH TYPE IV DISTRIBUTION. ARM MOUNTED ON A 20" STRAIGHT SQUARE STEEL POLE. DARK BRONZE FINISH.

MISCELLANEOUS LEGEND

NOTE:
A. ALL SYMBOLS DO NOT NECESSARILY APPEAR ON THESE DRAWINGS

PANEL "H1"		LOCATION: ELECTRIC MEZZ.		BUS 225 AMPS		277/480 VOLTS, 3 PHASE 4 WIRES			
22 K RMS SYM AMPERES		MLO 225 AMPS		SURFACE MOUNTED		NEMA 1 ENCLOSURE			
LIGHTING LOAD:		70.7 x 1.25 = 88.4		+ RECEPT. LOAD:		0.0			
+ POWER LOAD:		0.0		EQUAL TOTAL CONNECTED LOAD OF:		88.4 KW			
DIVIDED BY 0.9 P.F. =		98.1 KVA		DIVIDED BY (480 VOLTS x 1.73) =		x 1000 =			
TOTAL AMPS:		116 AMPS		FEEDER SIZE: #4/0 & 1#4 GND. IN 2 1/2" CONDUIT					
REMARKS:									
OKT	LOAD DESCRIPTION	WIRE/ CONDUIT	POWER LOAD LTS RECP PWR	C/B	C/B	POWER LOAD LTS RECP PWR	WIRE/ CONDUIT	LOAD DESCRIPTION	OKT
1	LIGHTING-PARKING	10 0.9	20/2	20/1	3.6	2	2	LIGHTING-CANOPY	2
3	"	"	"	"	"	"	"	SPARE	4
5	LIGHTING-PARKING	10 2.7	20/2	20/1	2.2	2	2	LIGHTING-FACADE FR.	6
7	"	"	"	"	"	"	"	LIGHTING-FACADE NO.	8
9	LIGHTING-PARKING	10 1.8	20/2	20/1	1.9	2	2	LIGHTING-EXT. WALLS	10
11	"	"	"	"	"	"	"	LIGHTING-SHOP	12
13	LIGHTING-PARKING	10 1.8	20/2	20/1	2.3	2	2	LIGHTING-SHOP	14
15	"	"	"	"	"	"	"	LIGHTING-SHOP	16
17	LIGHTING-PARKING	10 0.9	20/2	20/1	2.0	2	2	LIGHTING-WASH BAYS	18
19	"	"	"	"	"	"	"	LIGHTING-SHOP	20
21	LIGHTING-PARKING	10 1.8	20/2	20/1	0.9	2	2	LIGHTING-SERVICE	22
23	"	"	"	"	"	"	"	LIGHTING-PARTS DESK	24
25	LIGHTING-PARKING	10 1.8	20/2	20/1	1.6	2	2	LIGHTING-BREAK ROOM	26
27	"	"	"	"	"	"	"	LIGHTING-PARTS STOR.	28
29	LIGHTING-PARKING	10 1.8	20/2	20/1	2.7	2	2	LIGHTING-OFFICES	30
31	"	"	"	"	"	"	"	LIGHTING-2ND FL. OFF	32
33	LIGHTING-PARKING	10 1.8	20/2	20/1	2.0	2	2	LIGHTING-2ND FL. CONF.	34
35	"	"	"	"	"	"	"	LIGHTING-SHOWROOM	36
37	LIGHTING-PARKING	10 2.7	20/2	20/1	1.7	2	2	LIGHTING-SHOWROOM	38
39	"	"	"	"	"	"	"	LIGHTING-SHOWROOM	40
41	LIGHTING-SHOWROOM	2 2.8	20/1	20/1	3.4	2	2	LIGHTING-SHOWROOM	42

1. REFER TO BRANCH CIRCUIT WIRE AND CONDUIT SCHEDULE FOR WIRE AND CONDUIT SIZING.

* REFER TO BRANCH CIRCUIT WIRE AND CONDUIT SCHEDULE FOR WIRE AND CONDUIT SIZING.

PANEL "H2"

LOCATION: ELECTRIC MEZZ.

BUS 225 AMPS

277/480 VOLTS, 3 PHASE 4 WIRES

12 K RMS SYM AMPERES

MLO 225 AMPS

SURFACE MOUNTED

NEMA 1 ENCLOSURE

LIGHTING LOAD: 4.5 x 1.25 = 5.6 + RECEPT. LOAD: 0.0

+ POWER LOAD: 0.0

EQUAL TOTAL CONNECTED LOAD OF: 5.6 KW

DIVIDED BY 0.9 P.F. = 6.2 KVA

DIVIDED BY (480 VOLTS x 1.73) x 1000 =

TOTAL AMPS: 8 AMPS

FEEDER SIZE: #4/0 & 1#4 GND. IN 2 1/2" CONDUIT

REMARKS:

OKT	LOAD DESCRIPTION	WIRE/ CONDUIT	POWER LOAD			C/B	C/B	POWER LOAD			WIRE/ CONDUIT	LOAD DESCRIPTION	OKT
			LTS	RECP	PWR			LTS	RECP	PWR			
1	MONUMENT SIGN	2 1.5	20/1			20/1							2
3	MONUMENT SIGN	2 1.5	20/1			20/1							4
5	MONUMENT SIGN	2 1.5	20/1			20/1							6
7	"	"	20/1			20/1							8
9	"	"	20/1			20/1							10
11	"	"	20/1			20/1							12
13	"	"	20/1			20/1							14
15	"	"	20/1			20/1							16
17	"	"	20/1			20/1							18
19	"	"	20/1			20/1							20
21	"	"	20/1			20/1							22
23	"	"	20/1			20/1							24
25	"	"	20/1			20/1							26
27	"	"	20/1			20/1							28
29	"	"	20/1			20/1							30
31	"	"	20/1			20/1							32
33	"	"	20/1			20/1							34
35	"	"	20/1			20/1							36
37	"	"	20/1			20/1							38
39	"	"	20/1			20/1							40
41	"	"	20/1			20/1							42

POWER TO REMAIN: GROUND WIRE AND CONDUIT. CONDUIT SIZING TO REMAIN. CONDUIT SIZING

* REFER TO BRANCH CIRCUIT WIRE AND CONDUIT SCHEDULE FOR WIRE AND CONDUIT SIZING.

PANEL "H"		LOCATION: ELECTRIC MEZZ.		BUS 225 AMPS		120/208 VOLTS, 3 PHASE 4 WIRES				
10 K RMS SYM AMPERES		MCO 225 AMPS		SURFACE MOUNTED		NEMA 1 ENCLOSURE				
LIGHTING LOAD:		0.0 x 1.25 = 0.0		+ RECEPT. LOAD:		0.0				
+ POWER LOAD:		38.9		EQUAL TOTAL CONNECTED LOAD OF:		43 KW				
DIVIDED BY 0.9 P.F. =		43 KVA		DIVIDED BY (208 VOLTS x 1.73) =		x 1000 =				
TOTAL AMPS:		120 AMPS		FEEDER SIZE: #4/0 & 1#4 GND. IN 2 1/2" CONDUIT						
REMARKS:										
OKT	LOAD DESCRIPTION	WIRE/ CONDUIT	POWER LOAD		C/B	C/B	POWER LOAD	WIRE/ CONDUIT	LOAD DESCRIPTION	OKT
			LTS	RECP	PWR		LTS	RECP	PWR	
1	UHV-1	2	0.8		20/1	20/1	1.2	2	EF-1	2
3	UHV-2	2	0.8		20/1	20/1	1.2	2	EF-2	4
5	UHV-3	2	0.8		20/1	20/1	1.2	2	EF-3	6
7	UHV-4	2	0.8		20/1	20/1	1.2	2	EF-4	8
9	UHV-5	2	0.8		20/1	20/1	1.2	2	EF-5	10
11	UHV-6	2	0.8		20/1	20/1	1.2	2	EF-6	12
13	UHV-7	2	0.8		20/1	20/1	1.2	2	EF-7	14
15	UHV-8	2	0.8		20/1	20/1	1.2	2	EF-8	16
17	UHV-9	2	0.8		20/1	20/1	1.2	2	EF-9	18
19	UHV-10	2	0.8		20/1	20/1	1.2	2	EF-10	20
21	UHV-11	2	0.3		20/1	30/1	1.7	9	EF-11	22
23	UHV-12	2	0.3		20/1	30/1	1.7	9	AHU-1	24
25	GDH-1	2	0.3		20/1	30/1	1.7	9	AHU-2	26
27	AHU-12	2	1.0		20/1	30/1	1.7	9	AHU-3	28
29	SPARE				20/1	30/1	1.7	9	AHU-4	30
31	SPARE				20/1	30/1	1.7	9	AHU-5	32
33	SPARE				20/1	30/1	1.7	9	AHU-6	34
35	SPARE				20/1	30/1	1.7	9	AHU-7	36
37	SPARE				20/1	30/1	1.7	9	AHU-8	38
39	SPARE				20/1	30/1	1.7	9	AHU-9	40
41	SPARE				20/1	30/1			SPARE	42


* REFER TO BRANCH CIRCUIT WIRE AND CONDUIT SCHEDULE FOR WIRE AND CONDUIT SIZING.

PANEL "H2"		LOCATION: ELECTRIC MEZZ.		BUS 400 AMPS		120/208 VOLTS, 3 PHASE 4 WIRES			
10 K RMS SYM AMPERES		MCS 400 AMPS		SURFACE MOUNTED		NEMA 1 ENCLOSURE			
LIGHTING LOAD:		0.0 x 1.25 = 0.0		+ RECEPT. LOAD:		0.0			
+ POWER LOAD:		93.8		EQUAL TOTAL CONNECTED LOAD OF:		104 KW			
DIVIDED BY 0.9 P.F. =		104 KVA		DIVIDED BY (208 VOLTS x 1.73) =		x 1000 =			
TOTAL AMPS:		289 AMPS		FEEDER SIZE: #500 KCMIL & 1#3 GND. IN 3 1/2" CONDUIT					
REMARKS:									
OKT	LOAD DESCRIPTION	WIRE/ CONDUIT	POWER LOAD LTS RECP PWR	C/B	C/B	POWER LOAD LTS RECP PWR	WIRE/ CONDUIT	LOAD DESCRIPTION	OKT
1	CU-1	17	6.8 50/2	50/2		6.8 17	CU-8	2	4
3	"	"	"	"	"	"	"	"	6
5	CU-2	17	6.8 50/2	50/2		6.8 17	CU-9	8	10
7	"	"	"	"	"	"	"	"	12
9	CU-3	17	6.8 50/2	50/2		7.8 24	CU-10	14	16
11	"	"	"	"	"	"	"	"	18
13	CU-4	17	6.8 50/2	50/2		5.5 17	CU-11	20	22
15	"	"	"	"	"	"	"	"	24
17	CU-5	17	6.8 50/2	50/2		3.2 10	CU-12	26	28
19	"	"	"	"	"	"	"	"	30
21	CU-6	17	6.8 50/2	50/2		7.8 24	CU-13	32	34
23	"	"	"	"	"	"	"	"	36
25	CU-7	17	6.8 50/2	20/1				SPARE	38
27	"	"	"	20/1				SPARE	40
29	SPARE			20/2				SPARE	42
31	"			20/2		3.1 3	AHU-10	32	34
33	SPARE			20/2				SPARE	36
35	"					1.9 3	AHU-11	38	40
37	SPARE			20/1		"	"	SPARE	42
39	SPARE			20/1		3.1 3	AHU-13	40	42
41	SPARE			20/1		"	"	SPARE	44


* REFER TO BRANCH CIRCUIT WIRE AND CONDUIT SCHEDULE FOR WIRE AND CONDUIT SIZING.

PANEL "S1"		LOCATION: ELECTRIC MEZZ.		BUS 225 AMPS		120/208 VOLTS, 3 PHASE 4 WIRES			
10 K RMS SYM AMPERES		MCB 225 AMPS		SURFACE MOUNTED		NEMA 1 ENCLOSURE			
LIGHTING LOAD:		0.0 x 1.25 = 0.0		+ RECEPT. LOAD:		0.0			
+ POWER LOAD:		50.0		EQUAL TOTAL CONNECTED LOAD OF:		50 KW			
DIVIDED BY 0.9 P.F. =		56 KVA		DIVIDED BY (208 VOLTS x 1.73) =		x 1000 =			
TOTAL AMPS:		154 AMPS							
FEEDER SIZE: #4/0 & 1#4 GND. IN 2 1/2" CONDUIT									
REMARKS:									
OKT	LOAD DESCRIPTION	WIRE/ CONDUIT	POWER LOAD LTS RECP PWR	C/B	C/B	POWER LOAD LTS RECP PWR	WIRE/ CONDUIT	LOAD DESCRIPTION	OKT
1	2-POST LIFT	10	2.5	30/2	30/2	2.5	10	2-POST LIFT	2
3	"	"	"	"	"	"	"	"	4
5	2-POST LIFT	10	2.5	30/2	30/2	2.5	10	2-POST LIFT	6
7	"	"	"	"	"	"	"	"	8
9	2-POST LIFT	10	2.5	30/2	30/2	2.5	10	2-POST LIFT	10
11	"	"	"	"	"	"	"	"	12
13	2-POST LIFT	10	2.5	30/2	30/2	2.5	10	2-POST LIFT	14
15	"	"	"	"	"	"	"	"	16
17	2-POST LIFT	10	2.5	30/2	30/2	2.5	10	2-POST LIFT	18
19	"	"	"	"	"	"	"	"	20
21	2-POST LIFT	10	2.5	30/2	30/2	2.5	10	4-POST LIFT	22
23	"	"	"	"	"	"	"	"	24
25	2-POST LIFT	10	2.5	30/2	30/2	2.5	10	4-POST LIFT	26
27	"	"	"	"	"	"	"	"	28
29	2-POST LIFT	10	2.5	30/2	30/2	2.5	10	2-POST LIFT	30
31	"	"	"	"	"	"	"	"	32
33	2-POST LIFT	10	2.5	30/2	30/2	2.5	10	2-POST LIFT	34
35	"	"	"	"	"	"	"	"	36
37	2-POST LIFT	10	2.5	30/2	30/2	2.5	10	2-POST LIFT	38
39	"	"	"	"	"	"	"	"	40
41	SPARE	"	"	20/1	20/1	"	"	SPARE	42

* REFER TO BRANCH CIRCUIT WIRE AND CONDUIT SCHEDULE FOR WIRE AND CONDUIT SIZING.

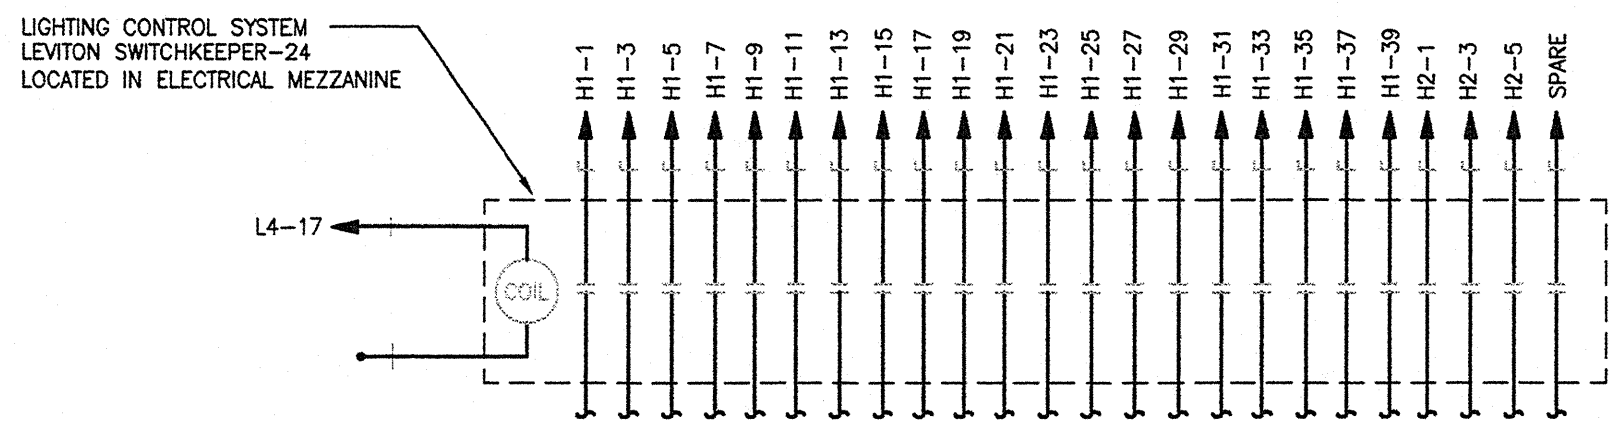

01 PARKING LIGHTING CONTROL DIAGRAM
NOT TO SCALE

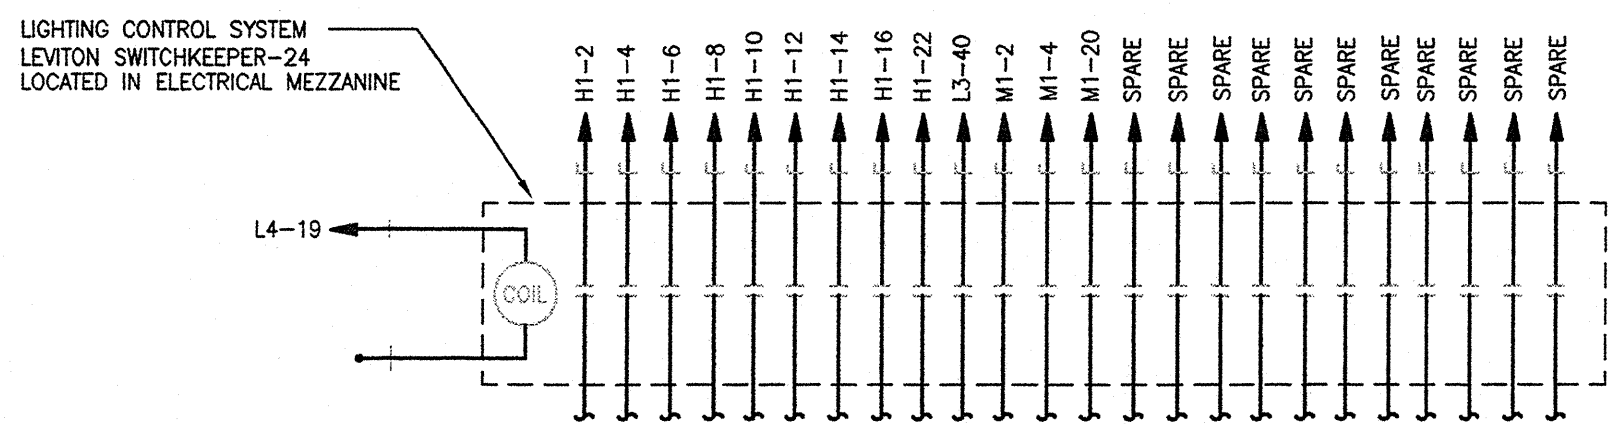


02 BUILDING LIGHTING CONTROL DIAGRAM
NOT TO SCALE

DISCONNECT SWITCH SCHEDULE											
REMARKS: COORDINATE FINAL FUSE SIZES WITH EQUIPMENT BEING PROVIDED											
MARK	VOLTAGE		AMPERES RATING				POLES	ENCL	FUSES		REMARKS
	120	240	15	30	60	100			FUSE SIZE	FUSE CLASS	
1	X	X	X	X	X	X	3	NEMA 1	30A	RKS	ELEVATOR
2	X	X	X	X	X	X	3	NEMA 1	30A	RKS	AIR COMPRESSOR
3	X	X	X	X	X	X	3	NEMA 1	30A	RKS	CU-10 & 13
4	X	X	X	X	X	X	3	NEMA 1	30A	RKS	CU-1,2,3,4,5,6,7,8,9 & 11
5	X	X	X	X	X	X	3	NEMA 1	30A	RKS	CU-12
6	X	X	X	X	X	X	3	NEMA 1	30A	RKS	AHU-1,2,3,4,5,6,7,8 & 9
7	X	X	X	X	X	X	3	NEMA 1	20A	RKS	AHU-12
8	X	X	X	X	X	X	3	NEMA 1	20A	RKS	AHU-10,11 & 13
9	X	X	X	X	X	X	3	NEMA 1	30A	RKS	WH-1

TRANSFORMER SCHEDULE											
REMARKS: A. COORDINATE WALL HUNG AND/OR TRAPEZE HUNG TRANSFORMERS WITH STRUCTURAL ENGINEER AND ARCHITECT FOR BLOCKING AND STRUCTURAL SUPPORT. B. PLACE ON 3 1/2" HOUSEKEEPING PAD, COORDINATE WITH CONCRETE WORK.											
MARK	PRIMARY VOLTAGE		KVA RATING				SECONDARY VOLTAGE		ENCL	MOUNTING	REMARKS
	240	277	15	30	45	75	120 / 240	120 / 208			
T1	X	X	X	X	X	X	X	X	NEMA 1	SUSPENDED	PANELS-L1,L2,L3,L4,S3
T2	X	X	X	X	X	X	X	X	NEMA 1	FLOOR	PANELS-M1,S1,S2
T3	X	X	X	X	X	X	X	X	NEMA 1	FLOOR	PANEL-M2

ELECTRICAL LOAD ANALYSIS	
NOTES:	
1. LIGHTING LOAD: A. LIGHTING LOAD: 101.7 KW x 1.25	= 127.1 KW
2. RECEPTACLE LOAD: A. 60.5 KW - 10 KW= 50.5 KW x 50% = 25.3 KW + 10 KW	= 35.3 KW
3. EQUIPMENT LOAD: A. A/C B. HEAT C. SHOP EQUIPMENT D. ELEVATOR E. MISCELLANEOUS	= 123.6 KW = 8.9 KW = 73.8 KW = 22.5 KW = 15.0 KW
4. KITCHEN LOAD: A. KW x 100 % DEMAND FACTOR (NEC 220-20)	= 0.0 KW
5. 25% OF LARGEST MOTOR:	= 5.6 KW
6. TOTAL CONNECTED LOAD (KW):	= 411.8 KW
7. TOTAL CONNECTED LOAD: 411.8 KW DIVIDE BY .9 PF = 457.5 KVA	
8. FUTURE LOAD: 114.4 KVA + TOTAL CONNECTED LOAD: 457.5 KVA	= 571.9 KVA
9. TOTAL AMP LOAD OF: 689 AMPS AT 480 VOLT, 3 PHASE, 4 WIRE	
REMARKS: 800 AMP, 277/480 VOLT, 3 PHASE, 4 WIRE SERVICE	

COMBINATION STARTER/DISCONNECT SWITCH SCHEDULE											
REMARKS: COORDINATE FINAL FUSE SIZES WITH EQUIPMENT BEING PROVIDED											
MARK	VOLTAGE		AMPERES RATING				POLES	ENCL	FUSES		REMARKS
	120	240	15	30	60	100			FUSE SIZE	FUSE CLASS	
1	X	X	X	X	X	X	3	NEMA 1	30A	RKS	ALIGNMENT MACHINE
2	X	X	X	X	X	X	3	NEMA 1	30A	RKS	CAR LIFTS

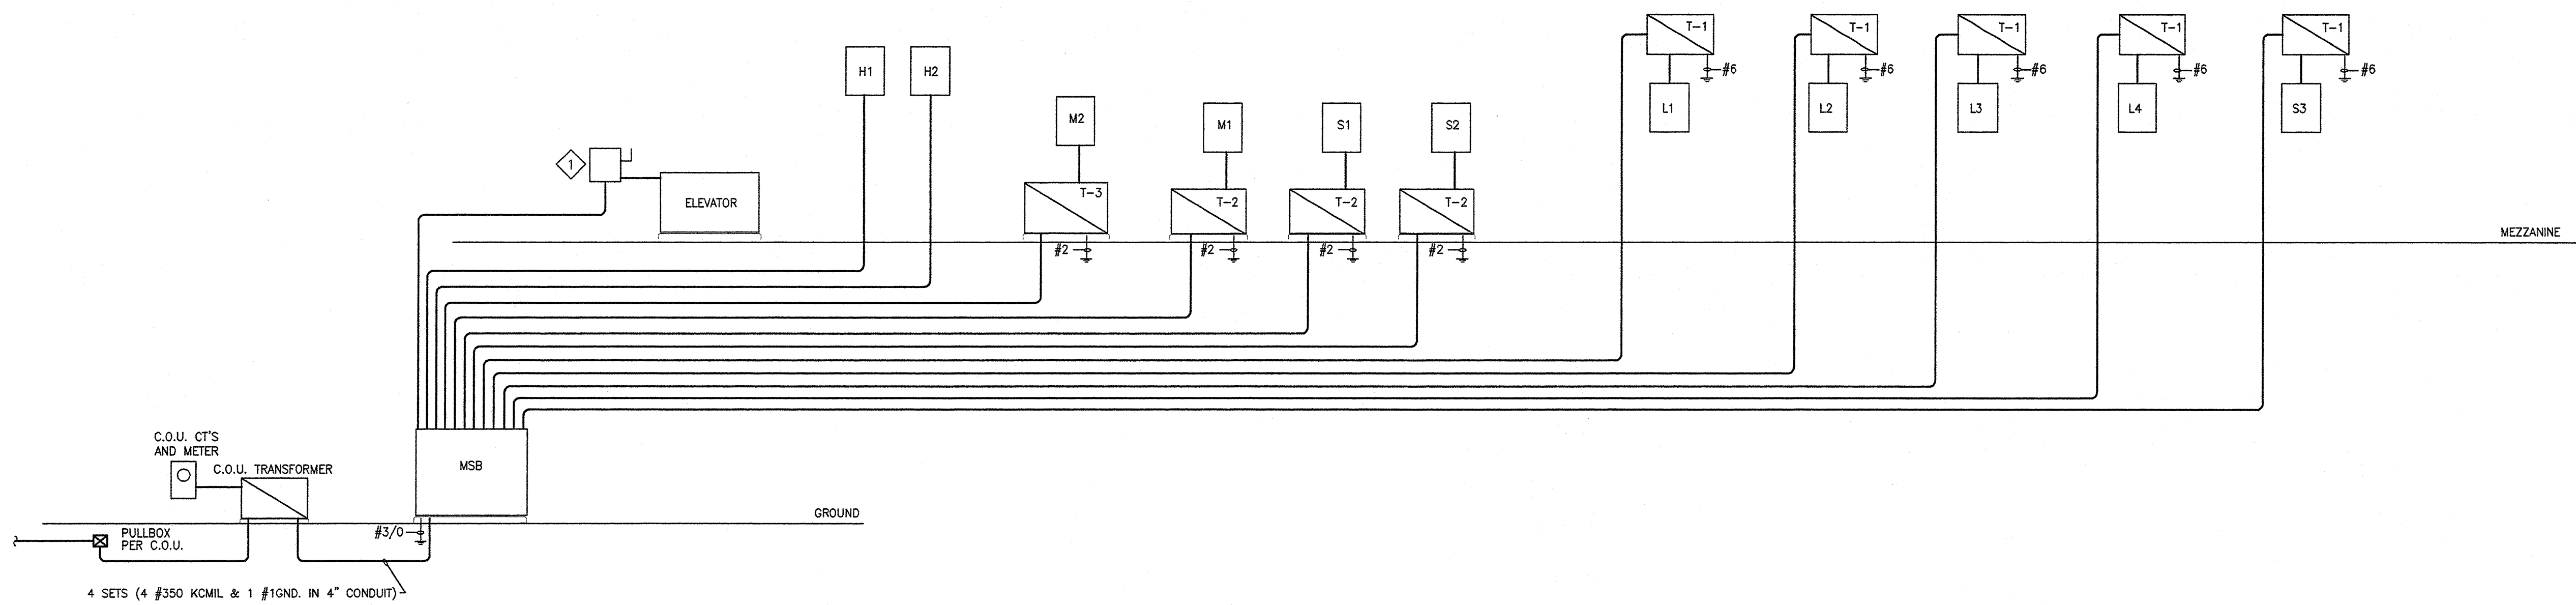

03 ELECTRICAL RISER DIAGRAM
NOT TO SCALE

MYERS & ASSOCIATES

This document, the ideas and designs incorporated herein are and shall remain the property of Myers & Associates. These documents are not to be used or altered, in whole or in part, for other than the original intended use, nor are they to be assigned to any third party without written permission from Myers & Associates. ©


M & A job no.: 01-016

AN AUTOMOTIVE DEALERSHIP
ROGER BEASLEY VOLVO

INTERSTATE HIGHWAY 35 SOUTH
GEORGETOWN, TEXAS

ELASSER ARCHITECTURAL INC.
ARCHITECTURE AND PLANNING
P.O. BOX 883 GEORGETOWN, TX 78627
(972) 890-5583 FAX (972) 890-2616 www.eal-bv.com

CONSULTANT SEAL:

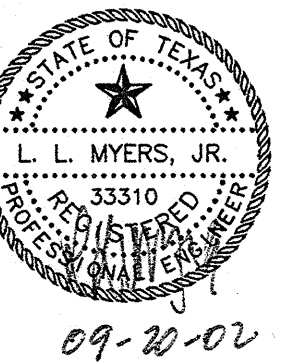


DATE: 04/20/02

REVISION DATE:


PROJECT NO.
020008

SHEET NO.

E4.2

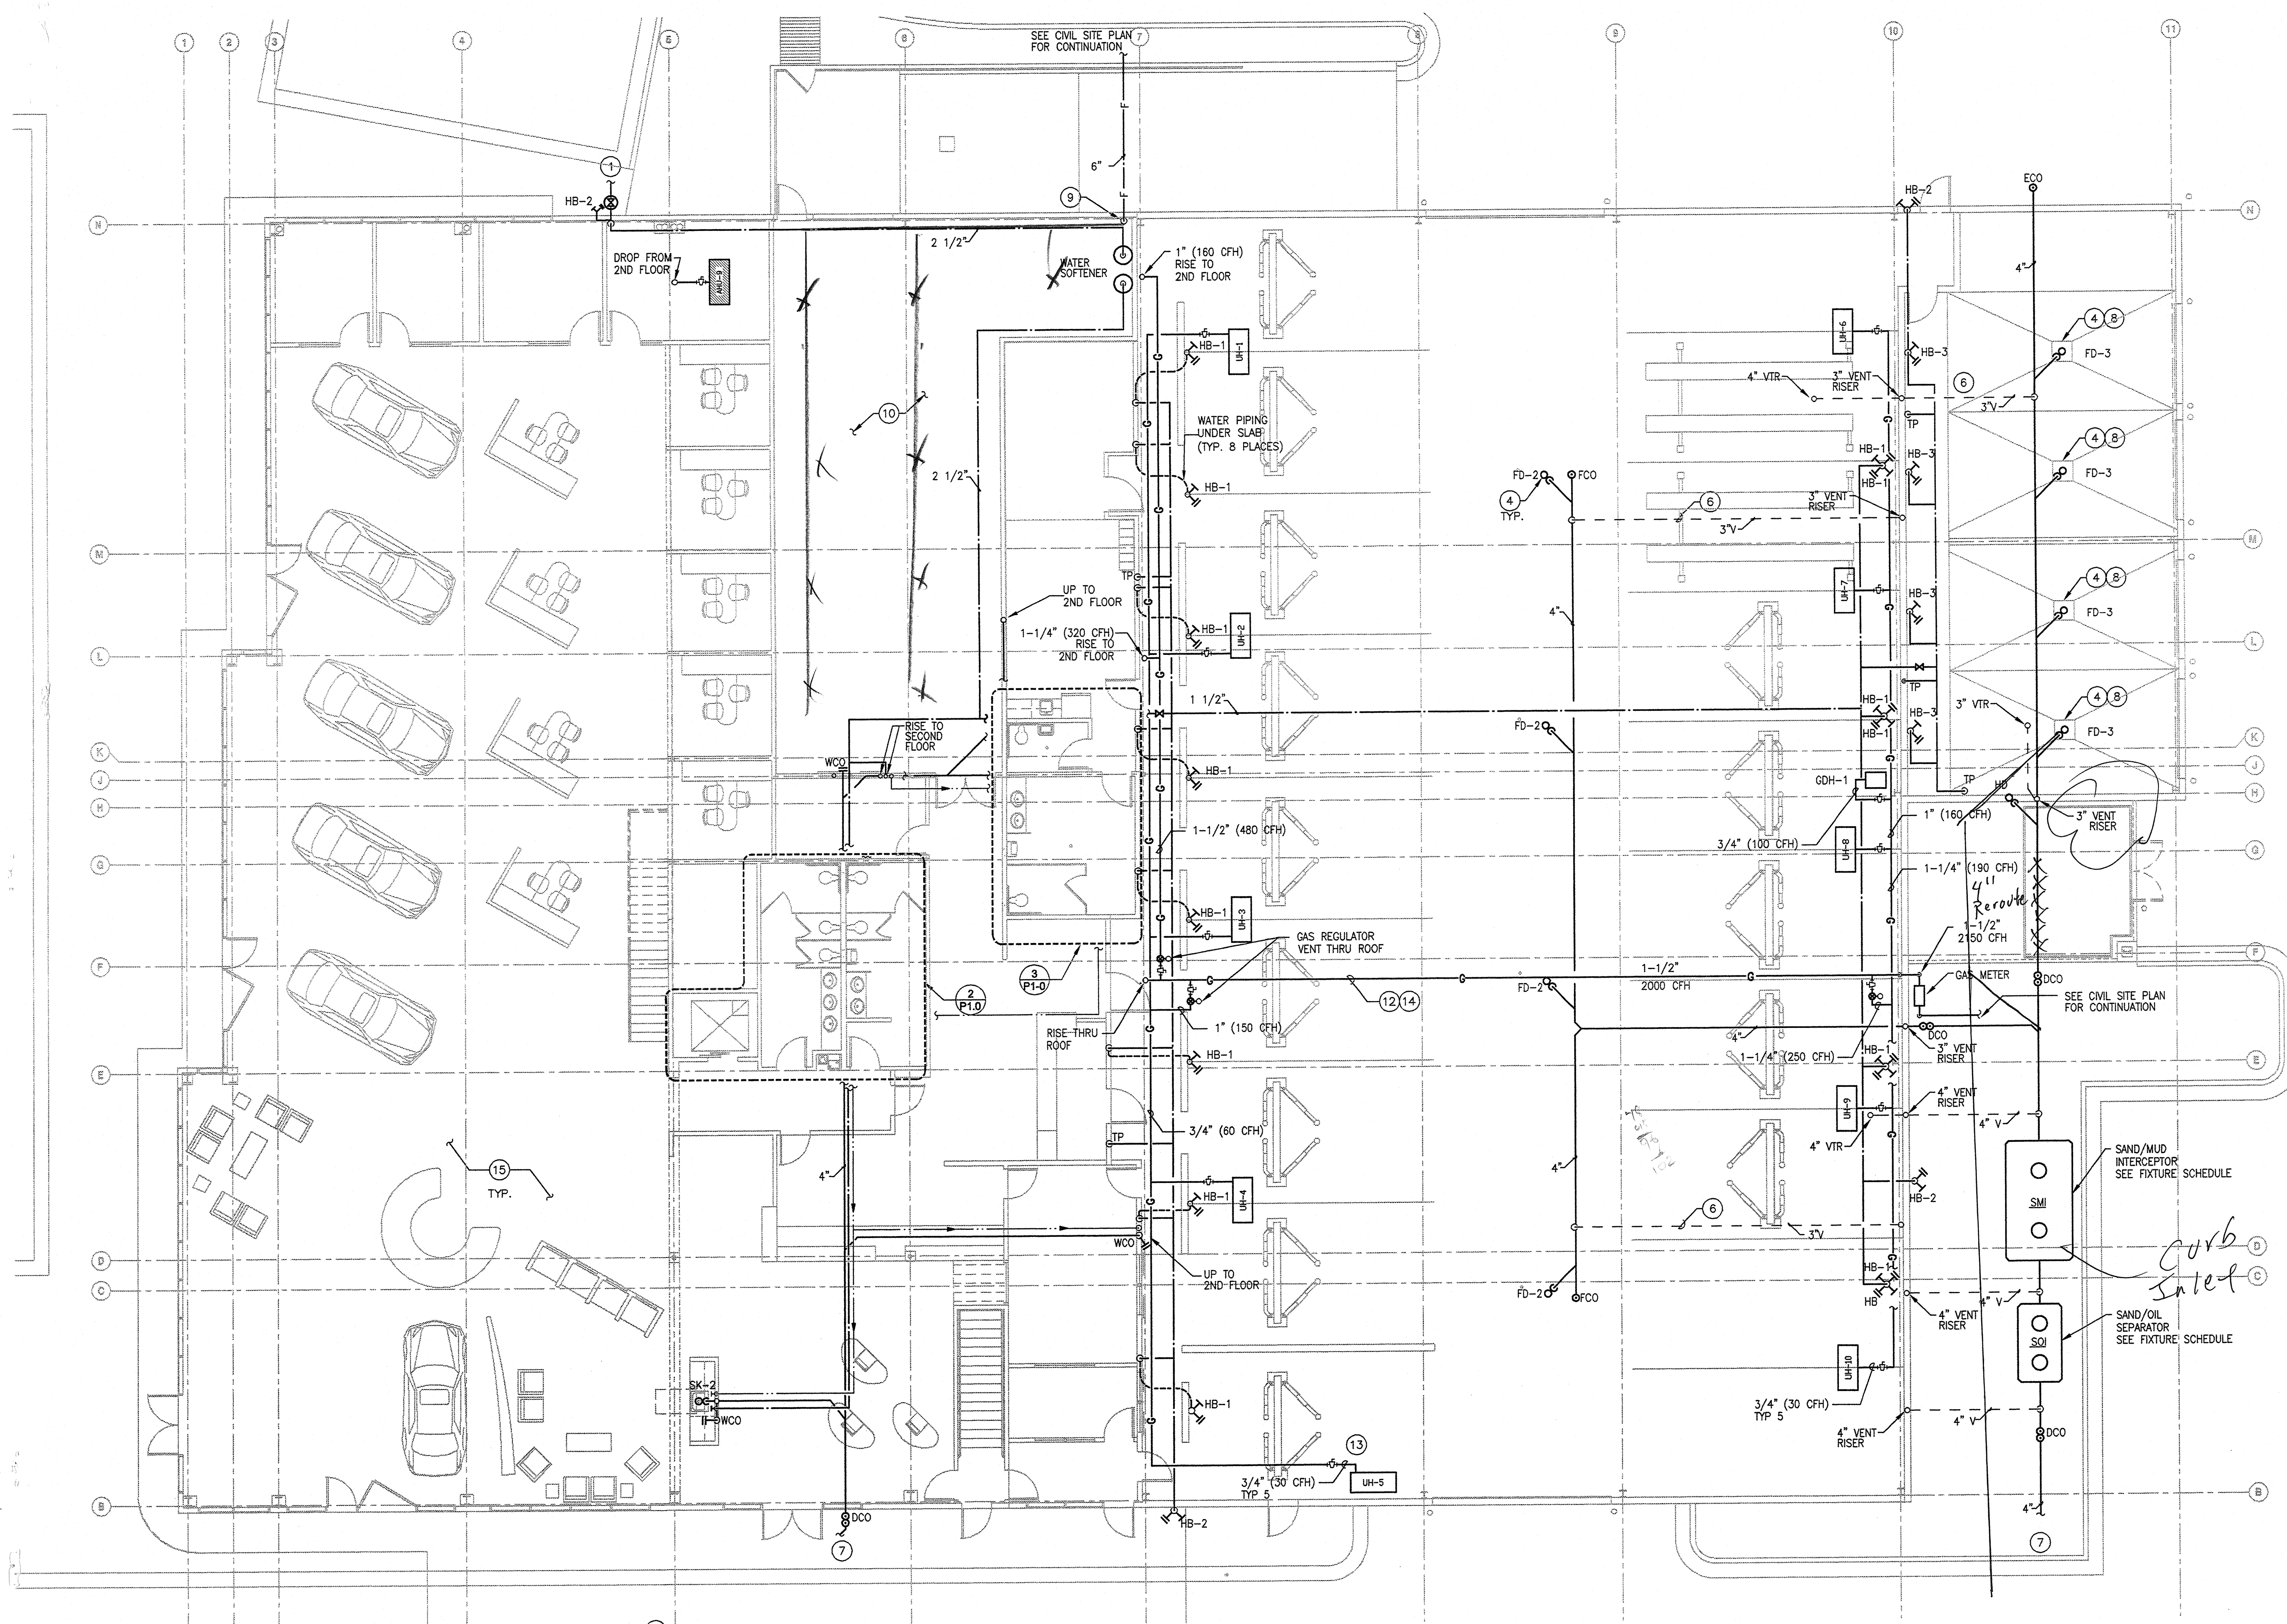

01 FIRST FLOOR - PLUMBING PLAN
SCALE: 1/8" = 1'-0"

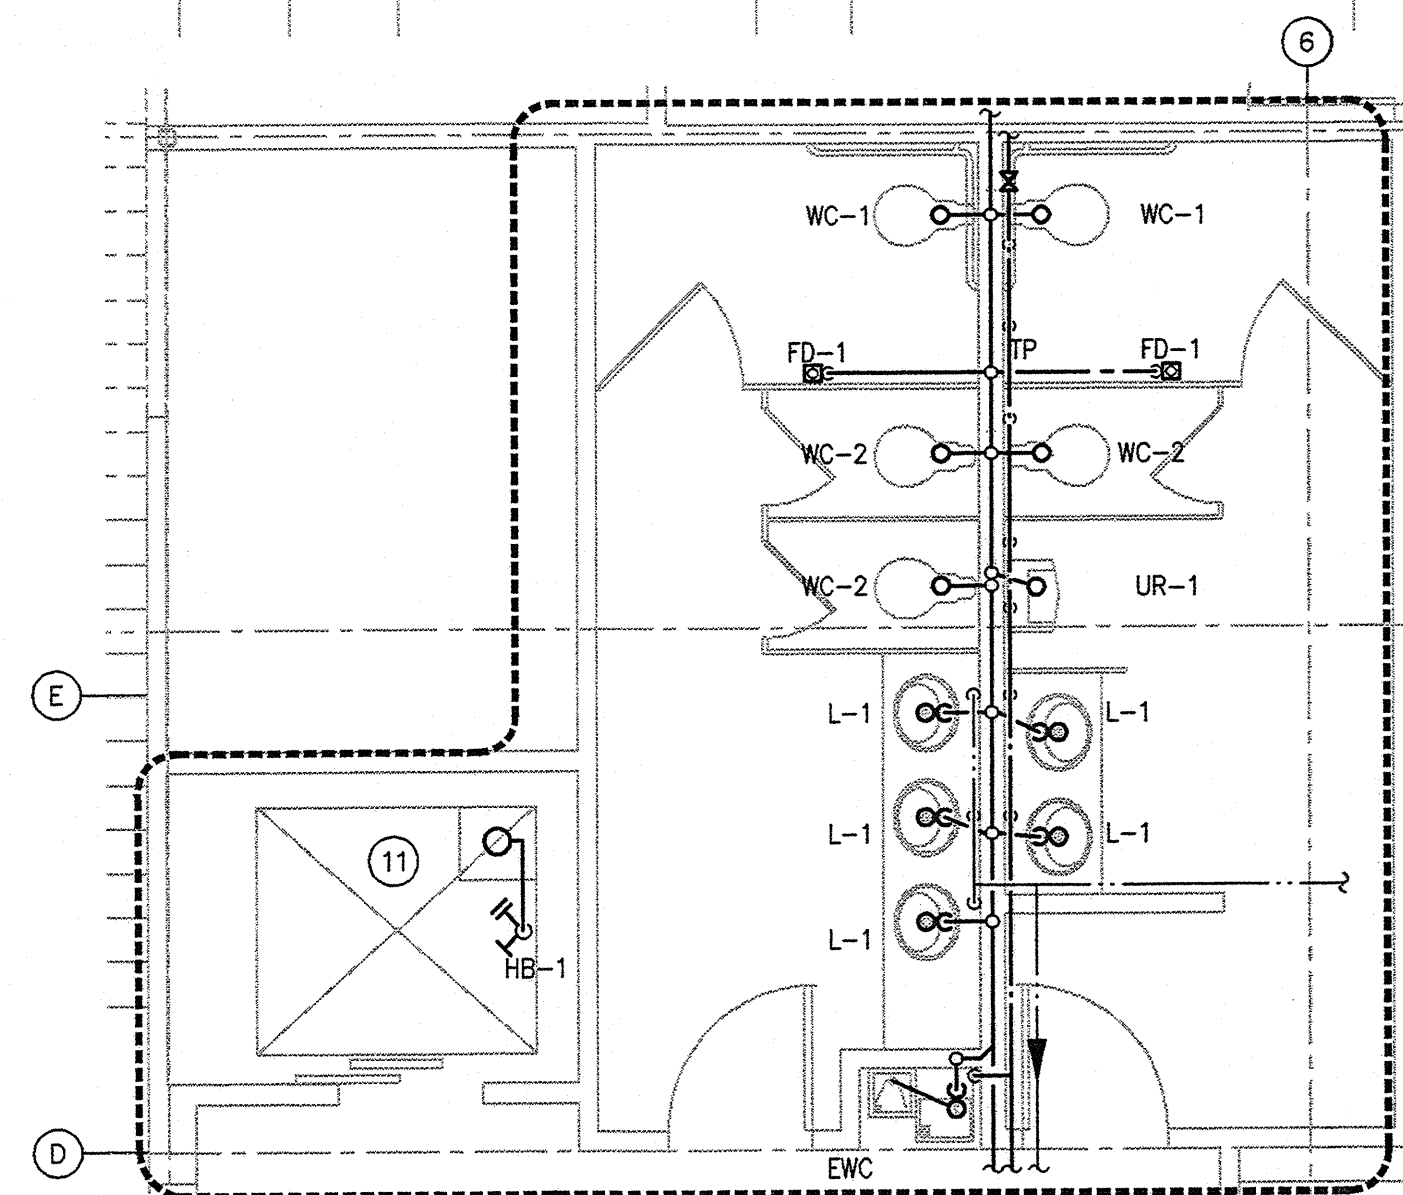

02 FIRST FLOOR - ENLARGED PLUMBING PLAN
SCALE: 1/4" = 1'-0"

GENERAL NOTES


THESE NOTES APPLY TO THIS SHEET ONLY

1. PLUMBING CONTRACTOR TO PROVIDE AND INSTALL ALL PLUMBING FIXTURES AS SCHEDULED.
2. COORDINATE WITH MECHANICAL CONTRACTOR TO ENSURE MINIMUM 10' HORIZONTAL CLEARANCE BETWEEN VENTS, EXHAUST OUTLETS, AND OUTSIDE AIR INTAKES.
3. COORDINATE WITH ROOFING CONTRACTOR TO PROVIDE AND INSTALL FLASHING FOR VENT PIPING IN ACCORDANCE WITH EQUIPMENT MANUFACTURER'S AND ROOF MANUFACTURER'S RECOMMENDATIONS.
4. COORDINATE WITH ARCHITECTURAL AND STRUCTURAL PLANS TO AVOID INTERFERENCE OF WASTE AND VENT PIPING WITH STRUCTURAL COLUMNS AND FOOTINGS.
5. REFER TO FIXTURE SCHEDULE, SHEET P2.3 AND PLUMBING DETAILS, SHEET P2.2 FOR MORE INFORMATION.

KEYED NOTES

THESE NOTES APPLY TO THIS SHEET ONLY

1. EXTEND NEW WATER LINE INTO BUILDING FROM STUB PROVIDED BY CIVIL SITE UTILITY CONTRACTOR. PROVIDE GATE VALVE IN VALVE BOX. ROUTE WATER PIPING VERTICALLY INSIDE OF EXTERIOR WALL AND THEN HORIZONTALLY IN OVERHEAD STRUCTURE AS HIGH AS POSSIBLE. COORDINATE WITH CIVIL SITE UTILITY CONTRACTOR FOR EXACT LOCATION OF NEW WATER SERVICE ENTRANCE.
2. ROUTE HOT AND COLD WATER LINES ABOVE CEILING AND DROP TO ALL FIXTURES. INSULATE ALL HOT AND COLD WATER LINES. COORDINATE WITH STRUCTURAL AND MECHANICAL CONTRACTORS TO AVOID INTERFERENCE.
3. CONNECT WASTE WATER PIPING TO SANITARY SEWER STUB PROVIDED BY CIVIL SITE UTILITY CONTRACTOR. REFER TO CIVIL SITE UTILITY PLAN FOR EXACT LOCATION OF CONNECTION POINT.
4. PROVIDE TRAP PRIMER AND 1/2" TRAP PRIMER LINE TO ALL FLOOR DRAINS AND HUB DRAINS.
5. PROVIDE PLUMBING ROUGH-IN, WALL BOX, AND MAKE FINAL CONNECTIONS TO ICE MAKER OF REFRIGERATOR PROVIDED BY OWNER.
6. HORIZONTAL VENT BELOW SLAB.
7. REFER TO CIVIL SITE PLAN FOR CONTINUATION.
8. CATCH BASIN WITH TRAFFIC RATED GRATE (BY OTHERS).
9. LOCATION OF 6" FIRE SPRINKLER RISER. REFER TO DETAIL 10, SHEET P2-2.
10. INSTALL FIRE SPRINKLER SYSTEM IN PARTS STORAGE AREA PER NFPA13. CONFIRM ALL REQUIREMENTS WITH CITY OF GEORGETOWN.
11. PROVIDE SUMP PUMP IN ELEVATOR PIT. REFER TO FIXTURE SCHEDULE AND DETAIL 02, SHEET P1.0. VERIFY PUMP LOCATION AND PIPE ROUTING WITH ELEVATOR EQUIPMENT INSTALLER.
12. HIGH PRESSURE (SPS) GAS LINE SIZED PER STANDARD PLUMBING CODE BASED ON 400' FROM METER TO FURTHEST LOW PRESSURE REGULATOR.
13. LOW PRESSURE (7 IN MC) GAS LINE SIZED PER STANDARD PLUMBING CODE BASED ON 100' FROM LOW PRESSURE REGULATOR TO FURTHEST GAS APPLIANCE.
14. ROUTE GAS LINE AS HIGH AS POSSIBLE.
15. REFER TO ARCHITECTURAL FOR ALL ROOF DRAIN PIPING. ALL PIPING TO BE BY PLUMBER.

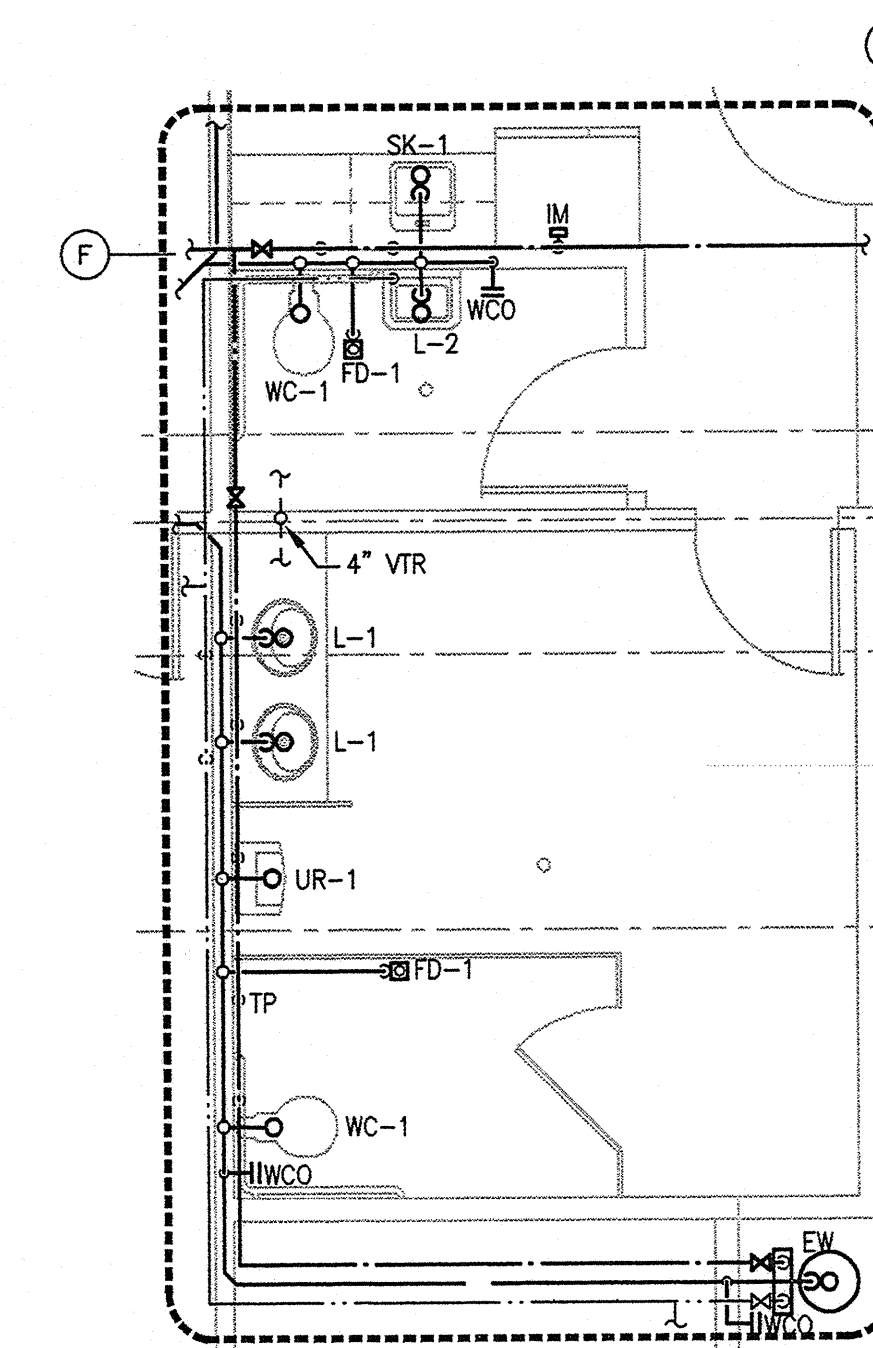

03 FIRST FLOOR - ENLARGED PLUMBING PLAN
SCALE: 1/4" = 1'-0"

MYERS & ASSOCIATES

This document, the ideas and designs incorporated herein are and shall remain the property of Myers & Associates. These documents are not to be used or altered, in whole or in part, for other than the original intended use, nor are they to be assigned to any third party without written permission from Myers & Associates. ©


M & A Job no.: 01-016

AN AUTOMOTIVE DEALERSHIP

ROGER BEASLEY VOLVO


INTERSTATE HIGHWAY 35 SOUTH
GEORGETOWN, TEXAS

ELASSER ARCHITECTURAL INC.

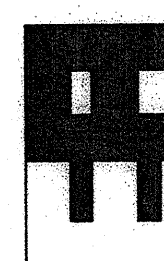

ARCHITECTURE AND PLANNING
P.O. BOX 833 GEORGETOWN, TX 78627
(512) 860-5353 FAX (512) 860-2818 www.eai-ll.com

CONSULTANT SEAL:

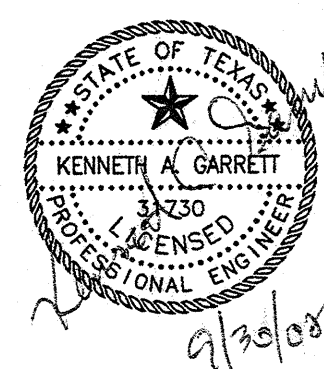

DATE: 04/30/02

REVISION DATE:

PROJECT NO.
020008

SHEET NO.

P1.0

GENERAL NOTES

THESE NOTES APPLY TO THIS SHEET ONLY

1. PLUMBING CONTRACTOR TO PROVIDE AND INSTALL ALL PLUMBING FIXTURES AS SCHEDULED.
2. COORDINATE WITH MECHANICAL CONTRACTOR TO ENSURE MINIMUM 10' HORIZONTAL CLEARANCE BETWEEN VENTS AND OUTSIDE AIR INTAKES.
3. COORDINATE WITH ROOFING CONTRACTOR TO PROVIDE AND INSTALL FLASHING FOR VENT PIPING IN ACCORDANCE WITH EQUIPMENT MANUFACTURER'S AND ROOF MANUFACTURER'S RECOMMENDATIONS.
4. COORDINATE WITH ARCHITECTURAL AND STRUCTURAL PLANS TO AVOID INTERFERENCE OF WASTE AND VENT PIPING WITH STRUCTURAL COLUMNS AND FOOTINGS.
5. REFER TO PLUMBING FIXTURES SCHEDULE SHEET P2.3 AND PLUMBING DETAILS SHEET P2.2 FOR MORE INFORMATION.

KEYED NOTES


THESE NOTES APPLY TO THIS SHEET ONLY

1. ROUTE HOT AND COLD WATER LINES ABOVE CEILING AND DROP TO ALL FIXTURES. INSULATE ALL HOT AND COLD WATER LINES. COORDINATE WITH STRUCTURAL AND MECHANICAL CONTRACTORS TO AVOID INTERFERENCE.
2. PROVIDE TRAP PRIMER AND 1/2" TRAP PRIMER LINE TO ALL FLOOR DRAINS AND HUB DRAINS.
3. PROVIDE WATER HEATER ON 4" CONCRETE HOUSE KEEPING PAD IN MECHANICAL ROOM.
4. HIGH PRESSURE (5PSI) GAS LINE SIZED PER STANDARD PLUMBING CODE BASED ON 400' FROM METER TO FURTHEST LOW PRESSURE REGULATOR.
5. LOW PRESSURE (7 IN MC) GAS LINE SIZED PER STANDARD PLUMBING CODE BASED ON 100' FROM LOW PRESSURE REGULATOR TO FURTHEST GAS APPLIANCE.

AN AUTOMOTIVE DEALERSHIP
ROGER BEASLEY VOLVO
INTERSTATE HIGHWAY 35 SOUTH
GEORGETOWN, TEXAS

ELSASSER
ARCHITECTURAL
INC.
ARCHITECTURE AND PLANNING
P.O. BOX 688 GEORGETOWN, TX 78627
(512) 865-6888 FAX (512) 865-6916 www.elsa.com

CONSULTANT SEAL:

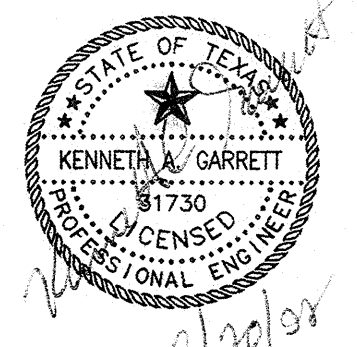

REVISIONS
NO. DESCRIPTION
1 REMOVED DOOR
1 REMOVED FLOOR
DATE: 04/20/02

REVISION DATE:
1 12-04-02

PROJECT NO.
020008

SHEET NO.
P1.1

MYERS &
ASSOCIATES
This document, the ideas and designs incorporated herein are and shall remain the property of Myers & Associates. These documents are not to be used or altered, in whole or in part, for other than the original intended use, nor are they to be assigned to any third party without written permission from Myers & Associates. ©
M & A job no.: 01-016

01 SECOND FLOOR - PLUMBING PLAN
SCALE: 1/8" = 1'-0"



02 SECOND FLOOR - ENLARGED PLUMBING PLAN
SCALE: 1/4" = 1'-0"

GENERAL NOTES
THESE NOTES APPLY TO THIS SHEET ONLY

1. PLUMBING CONTRACTOR TO PROVIDE AND INSTALL ALL PLUMBING FIXTURES AS SCHEDULED.
2. COORDINATE WITH MECHANICAL CONTRACTOR TO ENSURE MINIMUM 10' HORIZONTAL CLEARANCE BETWEEN VENTS, AND OUTSIDE AIR INTAKES.
3. COORDINATE WITH ROOFING CONTRACTOR TO PROVIDE AND INSTALL FLASHING FOR VENT PIPING IN ACCORDANCE WITH EQUIPMENT MANUFACTURER'S AND ROOF MANUFACTURER'S RECOMMENDATIONS.
4. COORDINATE WITH ARCHITECTURAL AND STRUCTURAL PLANS TO AVOID INTERFERENCE OF WASTE AND VENT PIPING WITH STRUCTURAL COLUMNS AND FOOTINGS.
5. REFER TO PLUMBING FIXTURES SCHEDULE SHEET P2.3 AND PLUMBING DETAILS SHEET P2.2 FOR MORE INFORMATION.

KEYED NOTES
THESE NOTES APPLY TO THIS SHEET ONLY

- ① ROUTE HOT AND COLD WATER LINES ABOVE CEILING AND DROP TO ALL FIXTURES. INSULATE ALL HOT AND COLD WATER LINES. COORDINATE WITH STRUCTURAL AND MECHANICAL CONTRACTORS TO AVOID INTERFERENCE.
- ② PROVIDE TRAP PRIMER AND 1/2" TRAP PRIMER LINE TO ALL FLOOR DRAINS AND HUB DRAINS.
- ③ PROVIDE WATER HEATER ON 4" CONCRETE HOUSE KEEPING PAD IN MECHANICAL ROOM.
- ④ HIGH PRESSURE (5PSI) GAS LINE SIZED PER STANDARD PLUMBING CODE BASED ON 400' FROM METER TO FURTHEST LOW PRESSURE REGULATOR.
- ⑤ LOW PRESSURE (7 IN MC) GAS LINE SIZED PER STANDARD PLUMBING CODE BASED ON 100' FROM LOW PRESSURE REGULATOR TO FURTHEST GAS APPLIANCE.

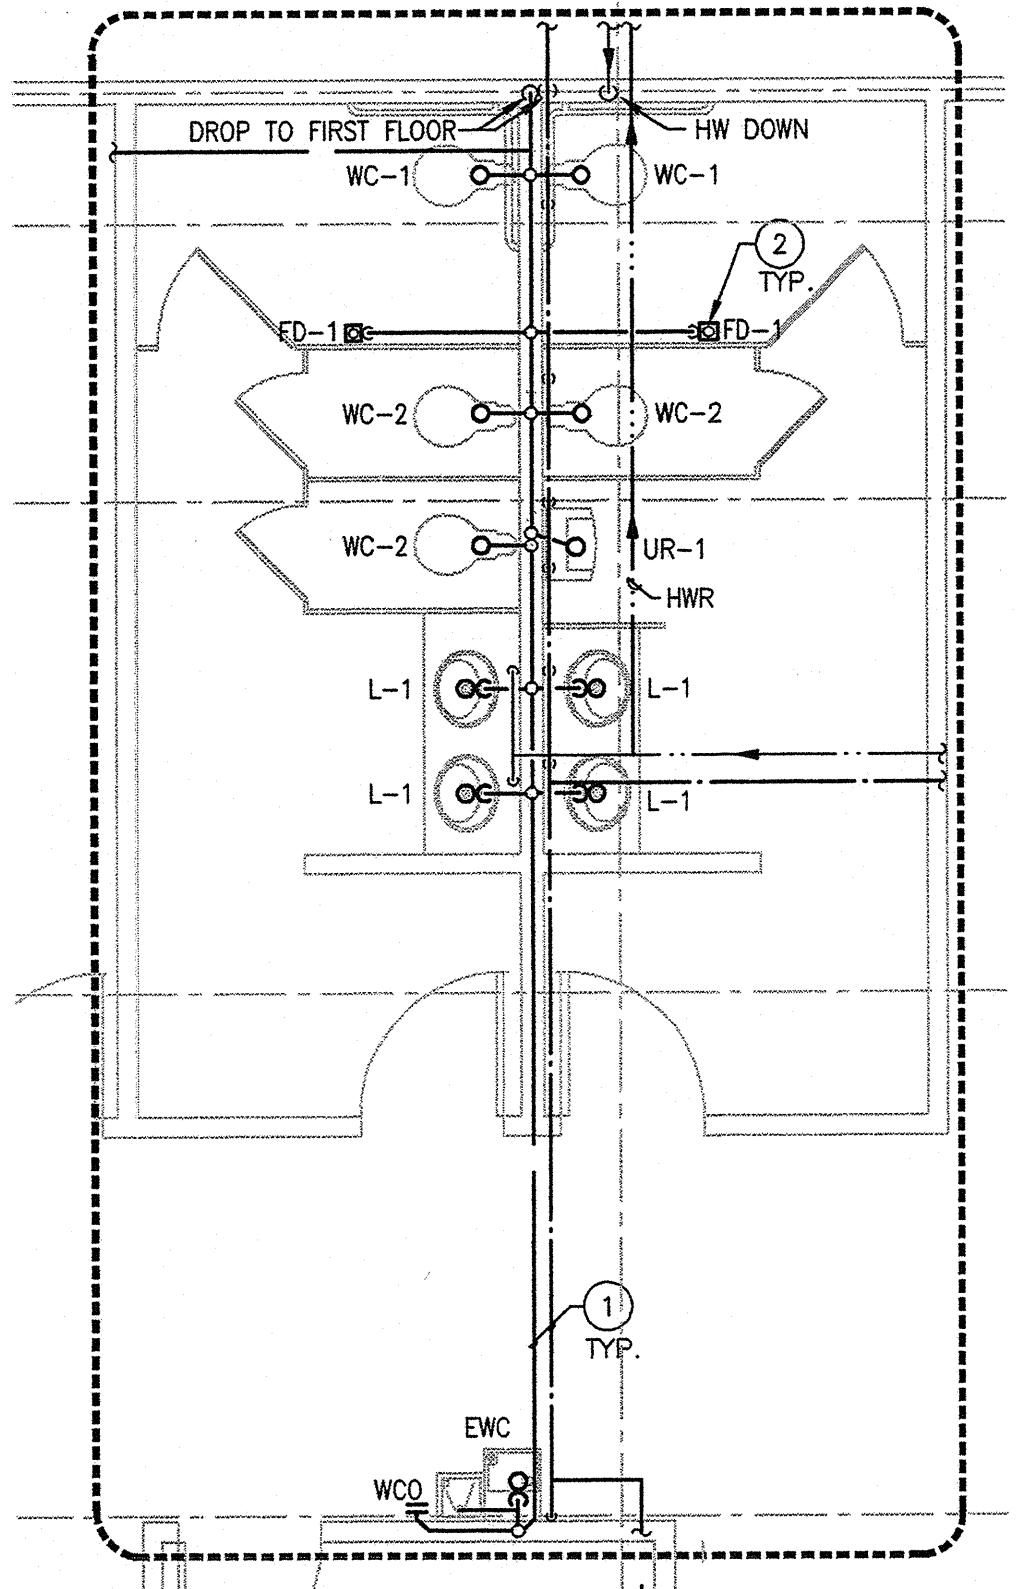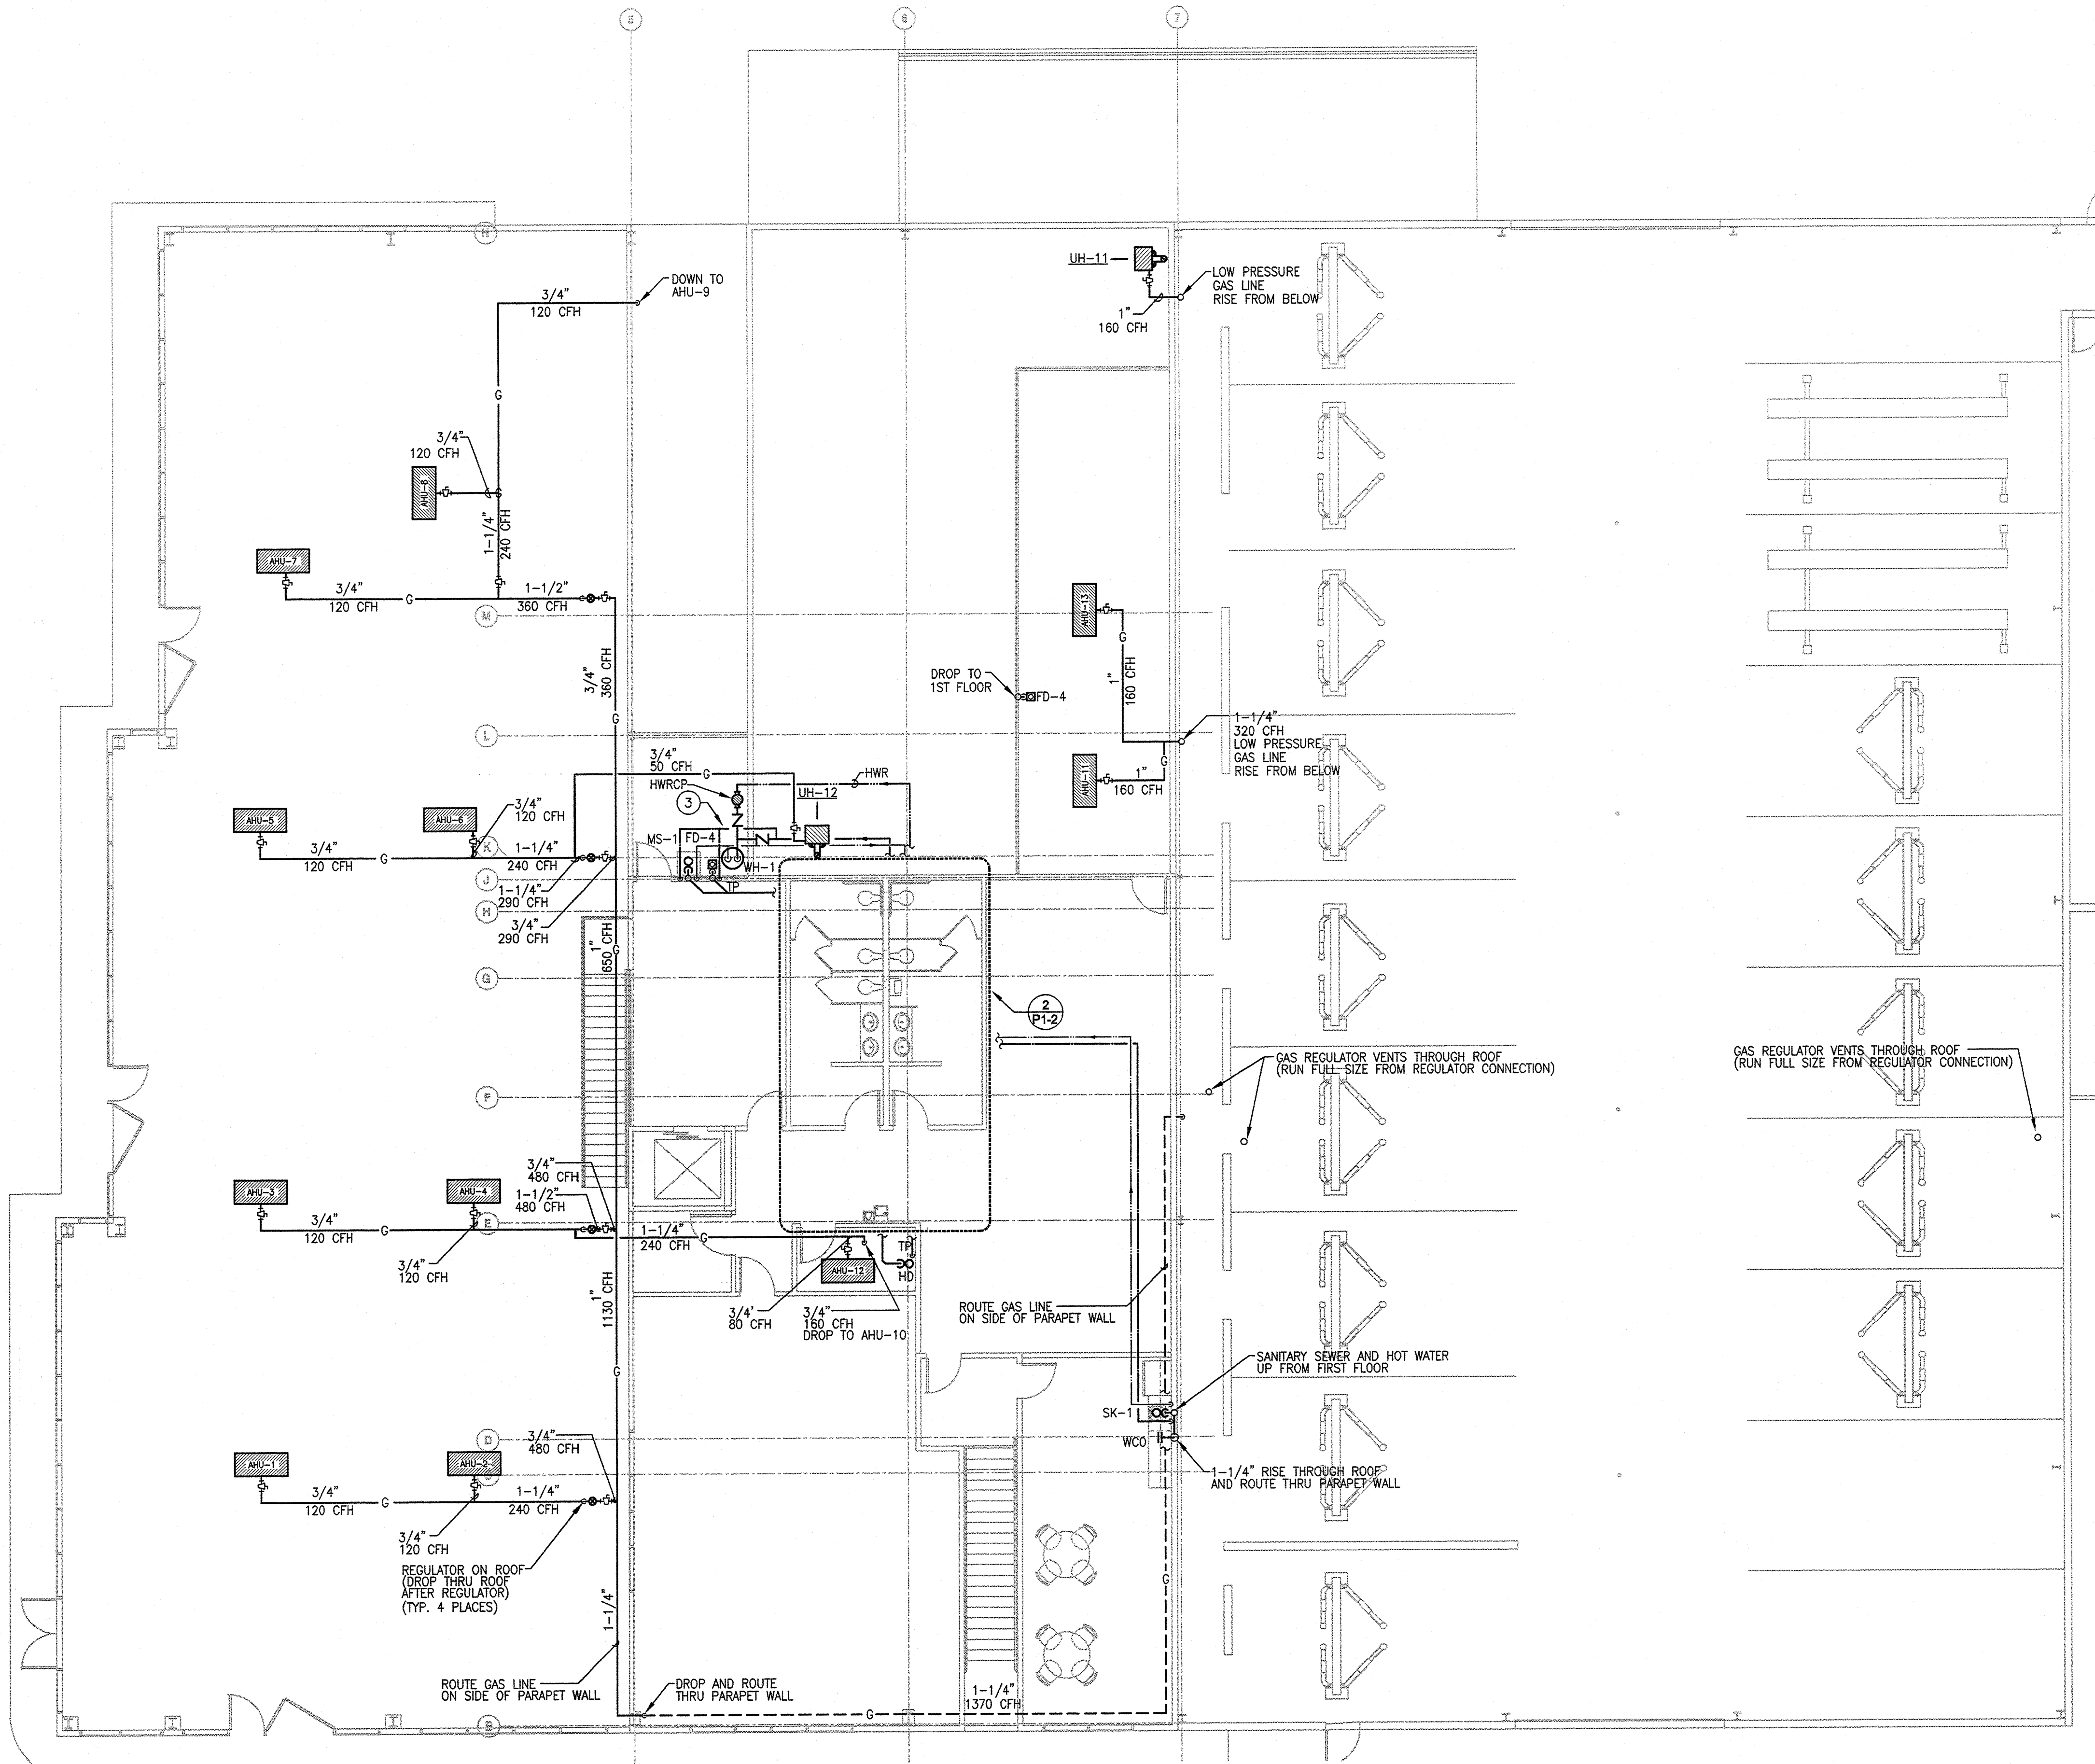

01 SECOND FLOOR - PLUMBING PLAN
SCALE: 1/8" = 1'-0"


02 SECOND FLOOR - ENLARGED PLUMBING PLAN
SCALE: 1/4" = 1'-0"


SEE
REVISION

AN AUTOMOTIVE DEALERSHIP
ROGER BEASLEY VOLVO
INTERSTATE HIGHWAY 35 SOUTH
GEORGETOWN, TEXAS

ELASSER ARCHITECTURAL INC.
ARCHITECTURE AND PLANNING
P.O. BOX 588 GEORGETOWN, TX 78627
(512) 882-5553 FAX (512) 882-5515 www.elsa-h.com

CONSULTANT SEAL:

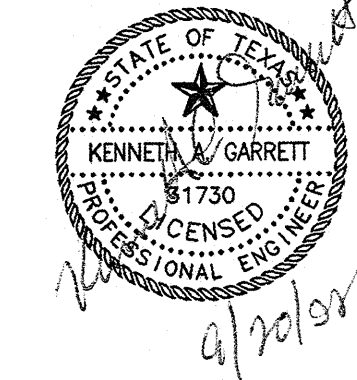

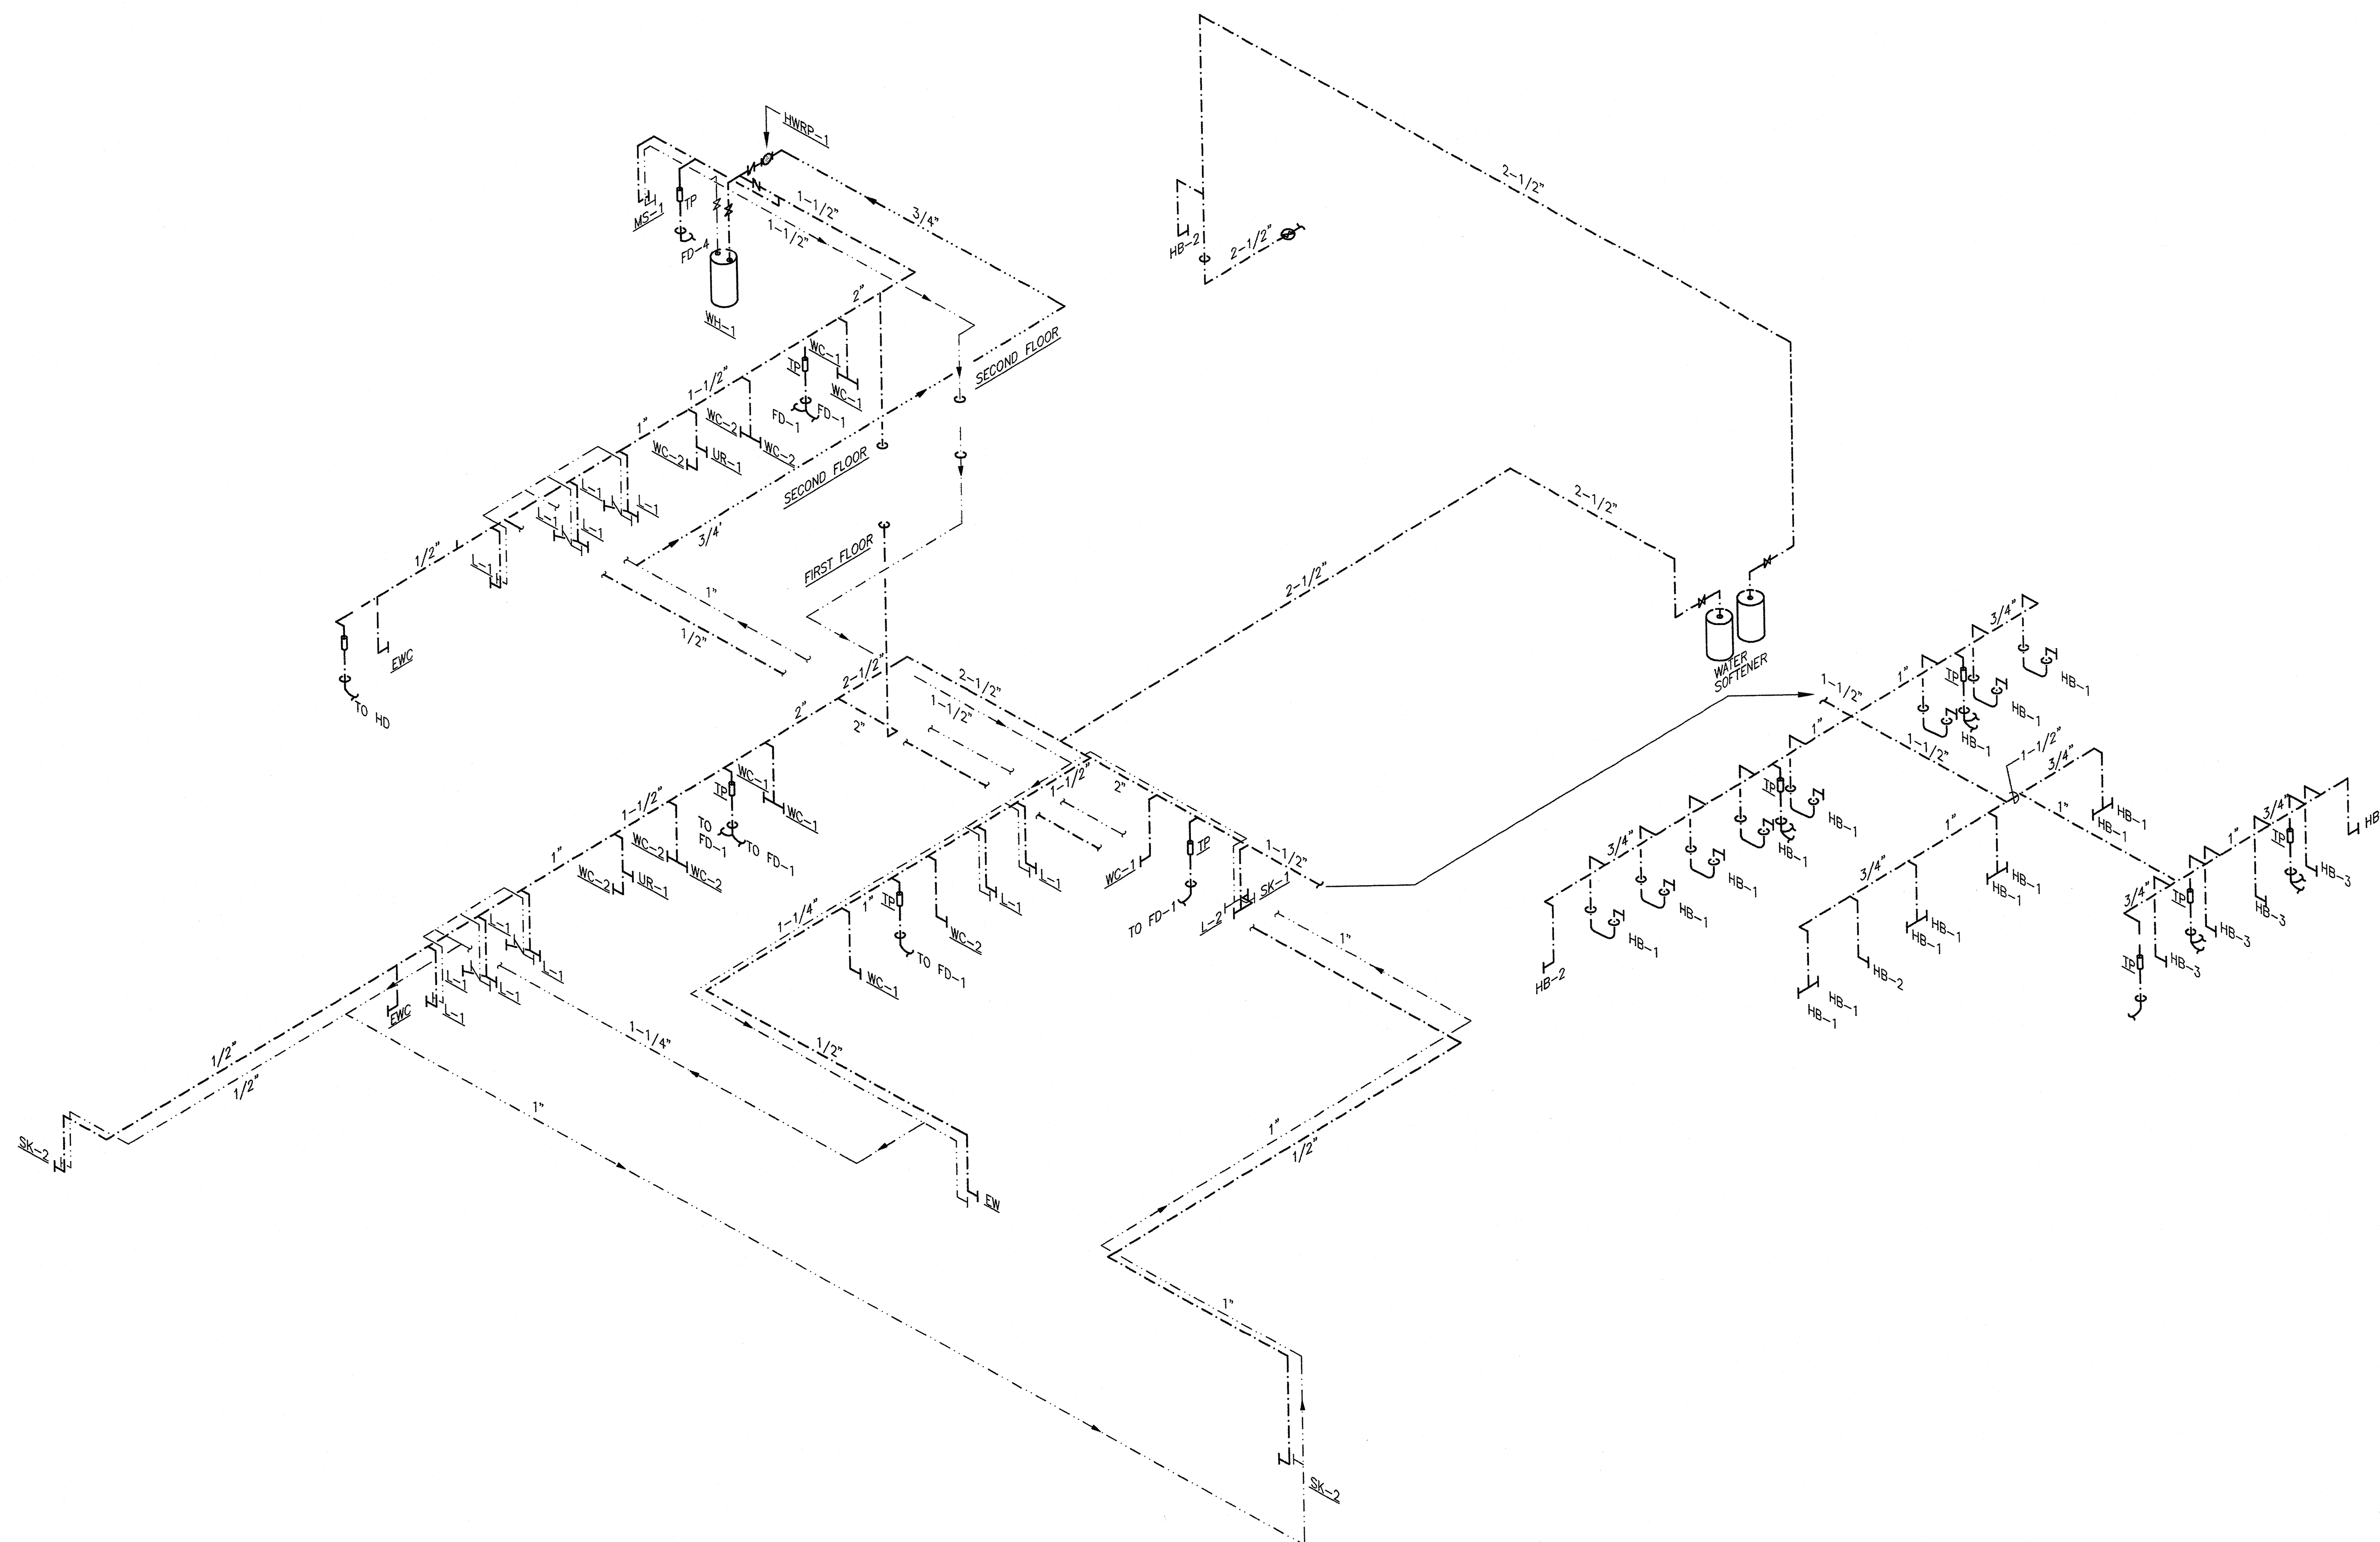

01 HOT AND COLD WATER ISOMETRIC

SCALE: NOT TO SCALE

**MYERS &
ASSOCIATES**

This document, the ideas and designs incorporated herein are and shall remain the property of Myers & Associates. These documents are not to be used or altered, in whole or in part, for other than the original intended use, nor are they to be assigned to any third party without written permission from Myers & Associates. ©

M & A Job no.: 01-016

AN AUTOMOTIVE DEALERSHIP


ROGER BEASLEY VOLVO

INTERSTATE HIGHWAY 35 SOUTH
GEORGETOWN, TEXAS

**ELSASSER
ARCHITECTURAL
INC.**

ARCHITECTURE AND PLANNING
P.O. BOX 833 GEORGETOWN, TX 78627
(512) 566-0353 FAX (512) 566-5516 www.elsa.com

CONSULTANT SEAL:

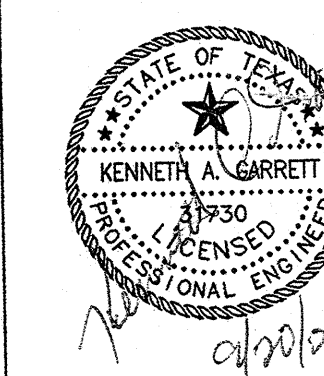


DATE: 09/20/02

REVISION DATE:


PROJECT NO.
020008

SHEET NO.


P2.1

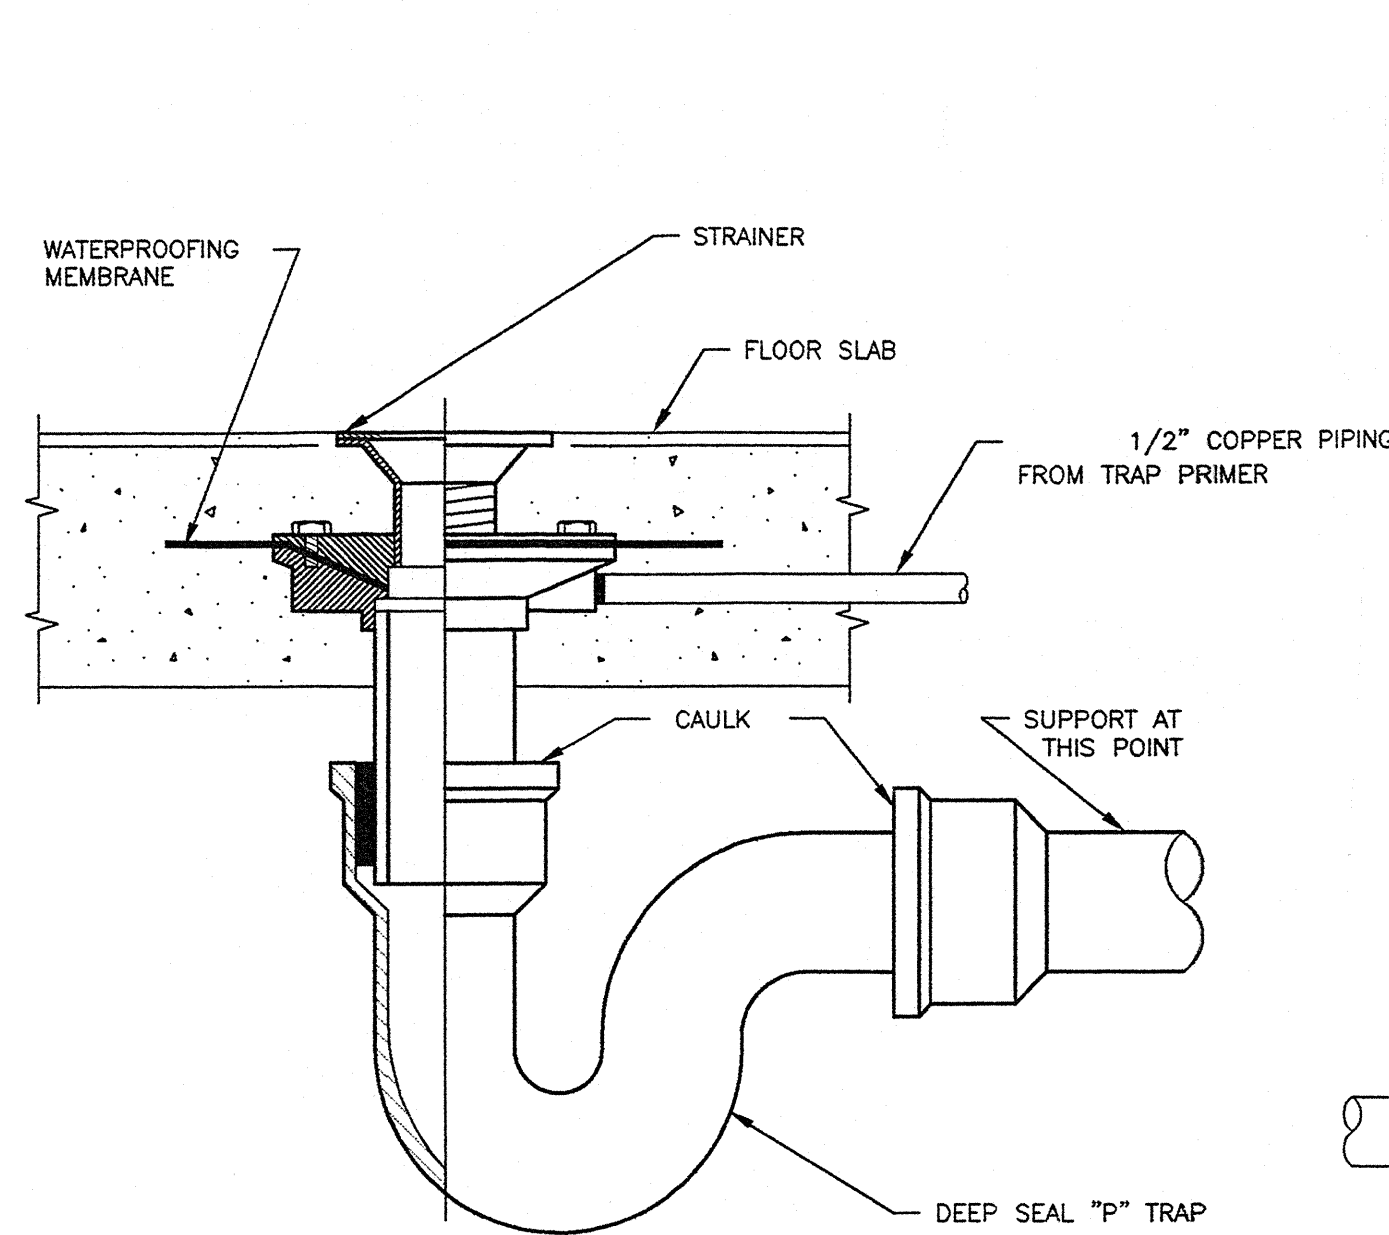


01 FLOOR DRAIN DETAIL
SCALE: NOT TO SCALE

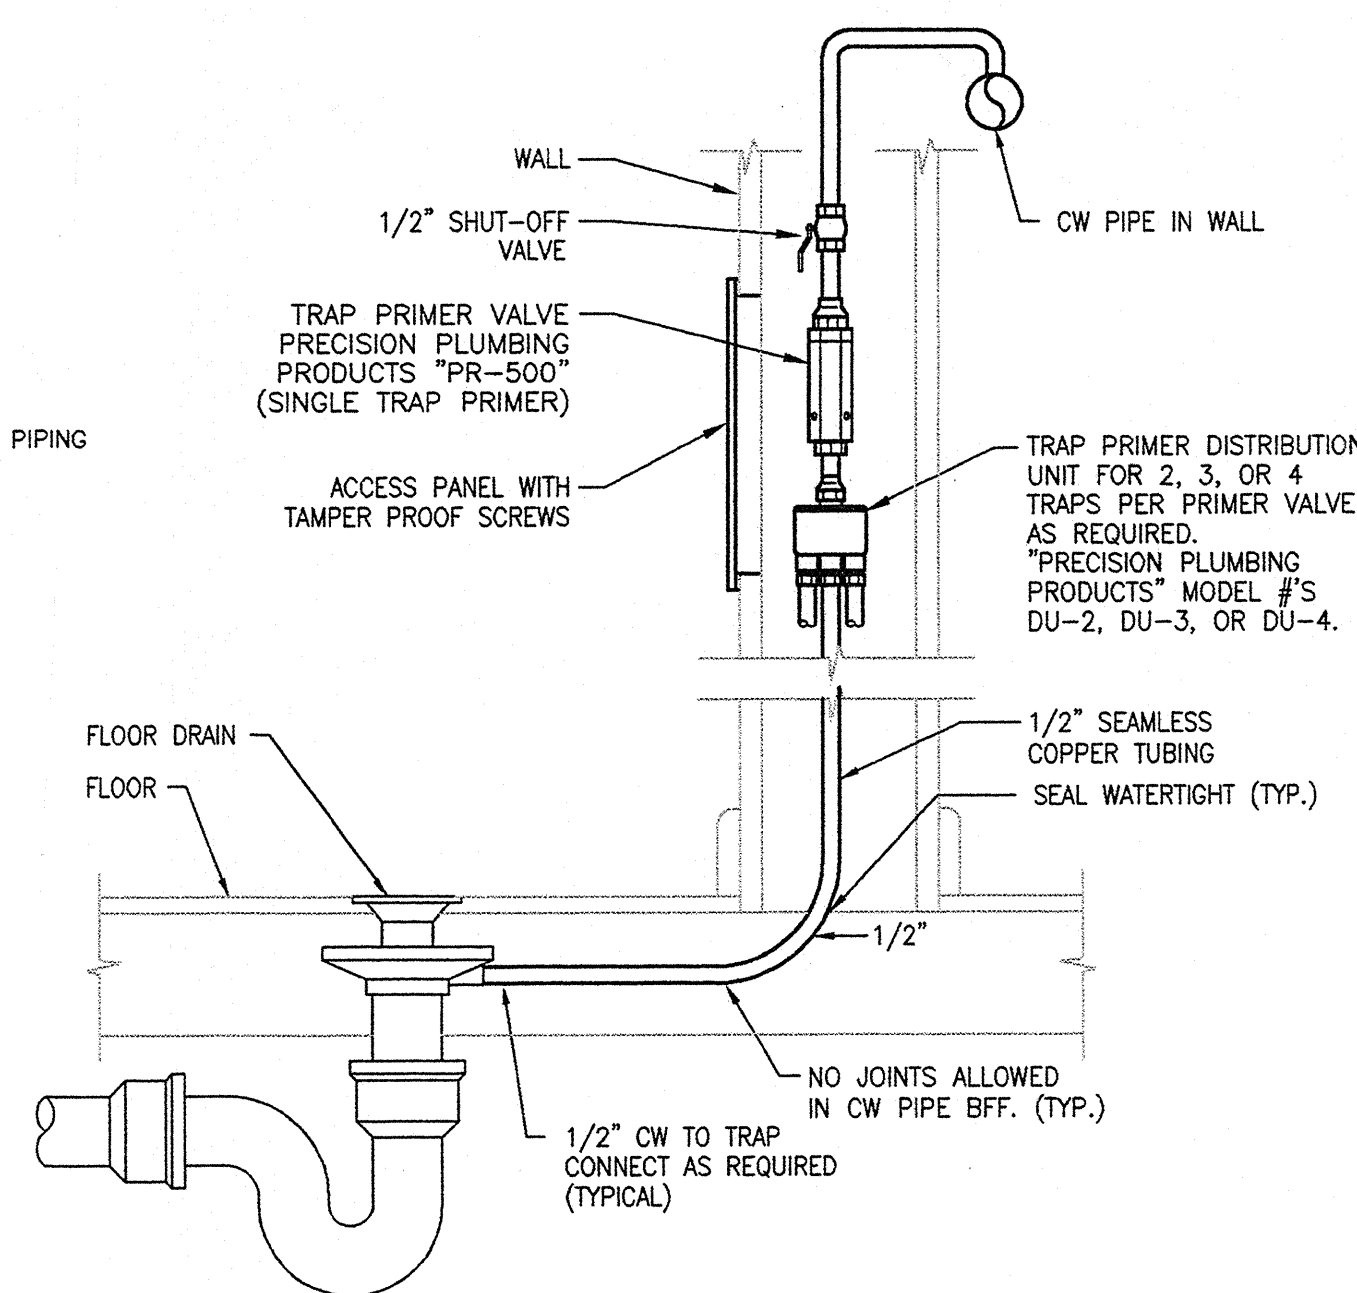


02 MULTIPLE TRAP - PRIMER DETAIL
SCALE: NOT TO SCALE

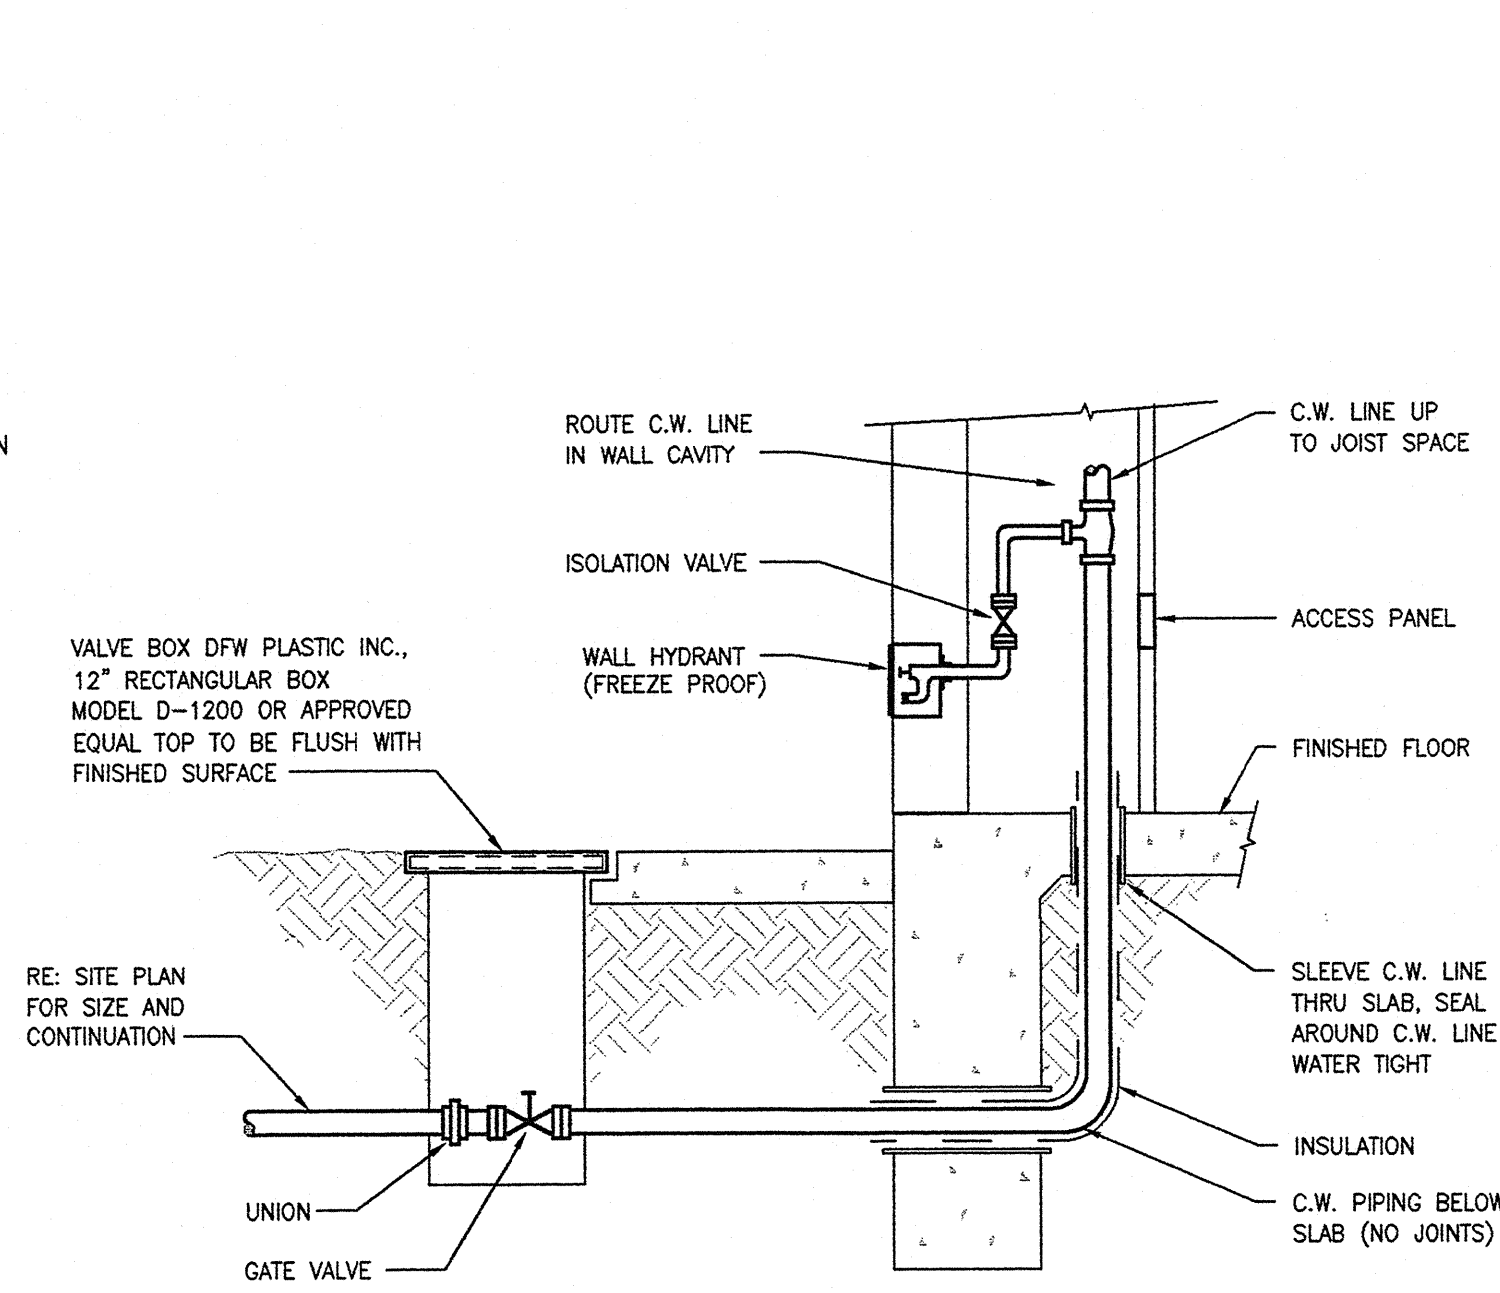


03 C.W. BUILDING ENTRY DETAIL
SCALE: NOT TO SCALE

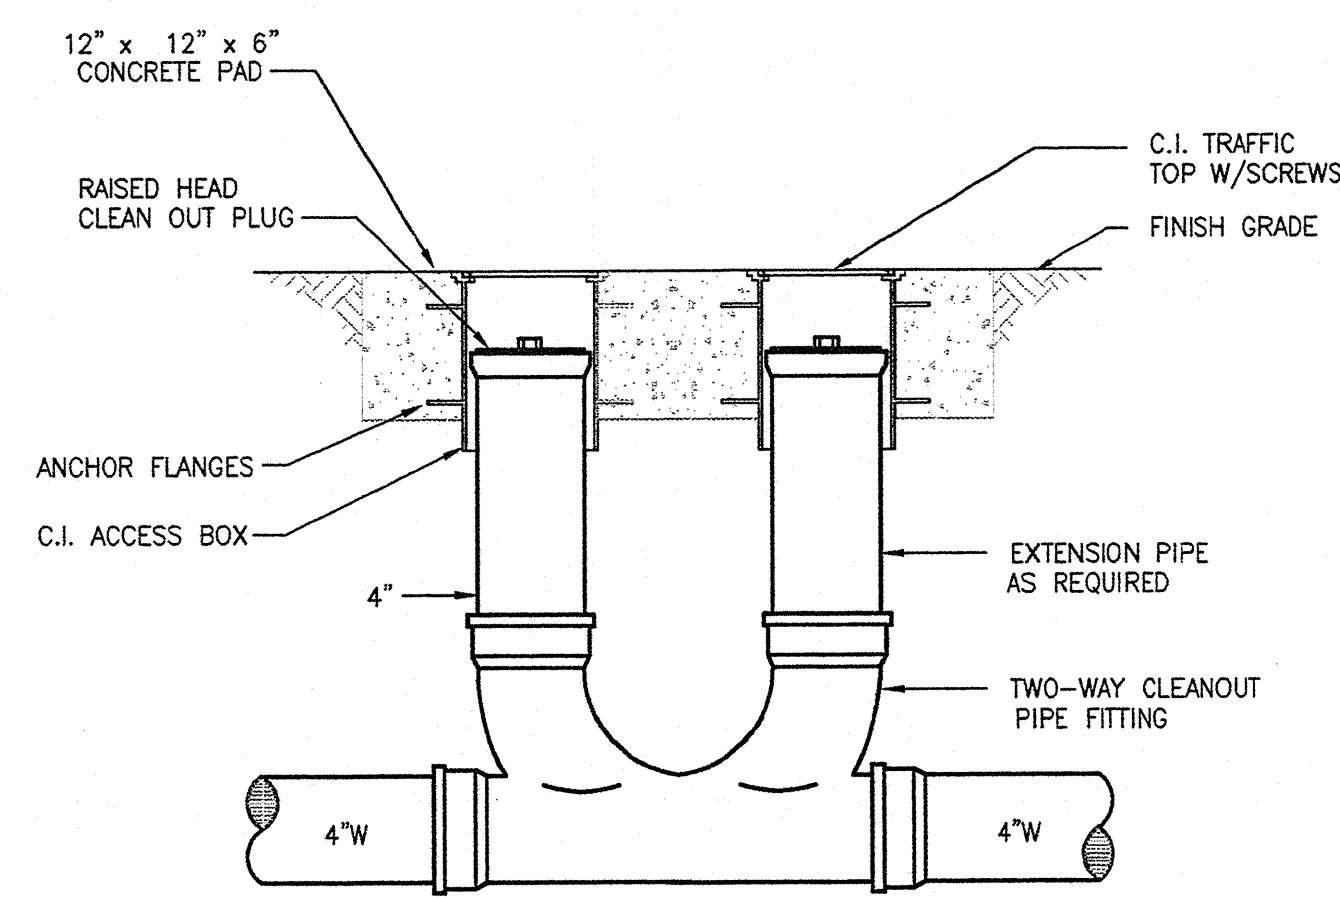


04 DOUBLE CLEAN OUT DETAIL
SCALE: NOT TO SCALE

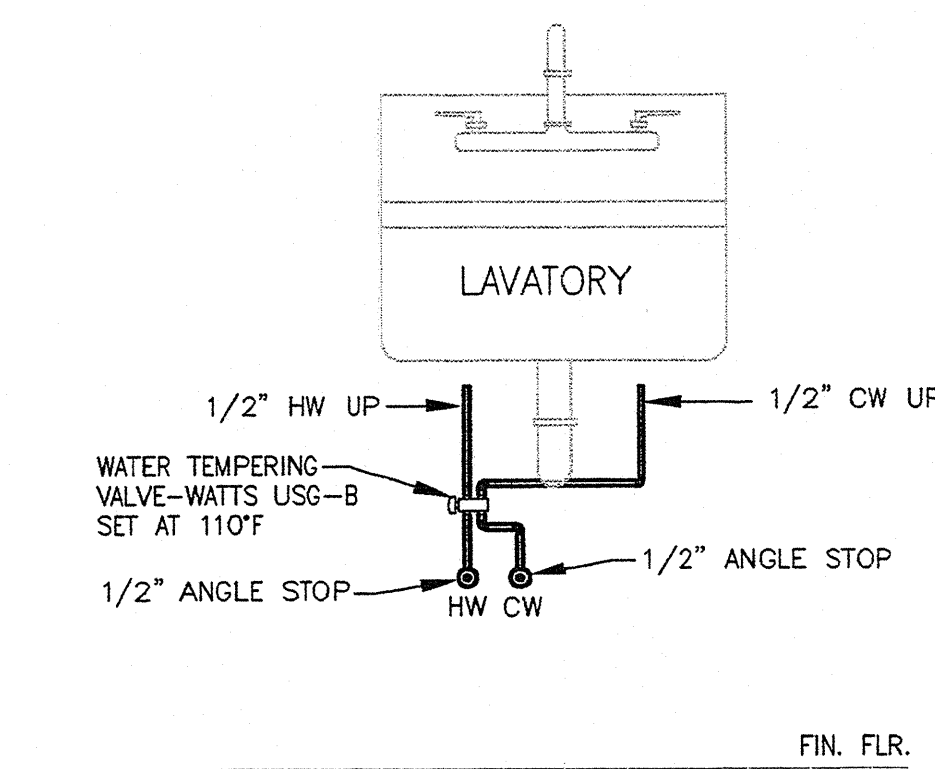


11 WATER TEMPERING DETAIL
SCALE: NOT TO SCALE

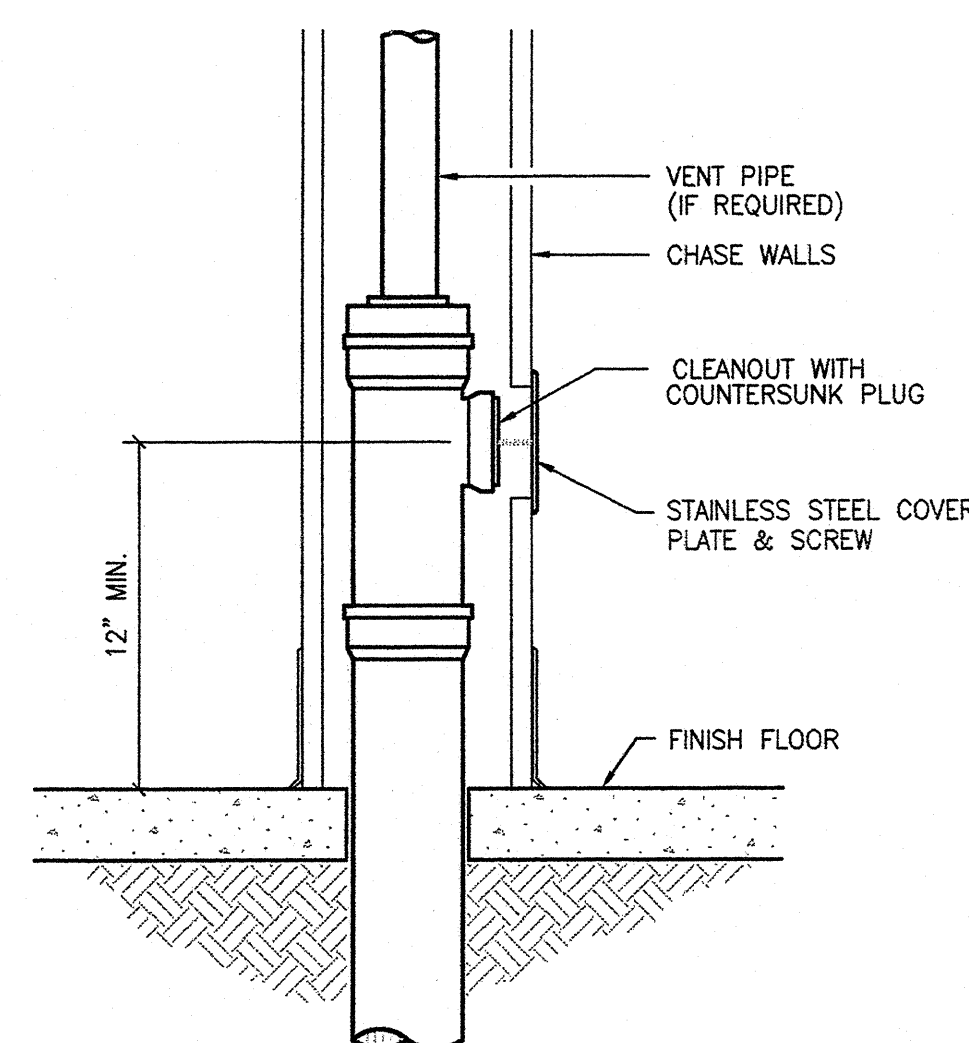


05 WALL CLEANOUT DETAIL
SCALE: NOT TO SCALE

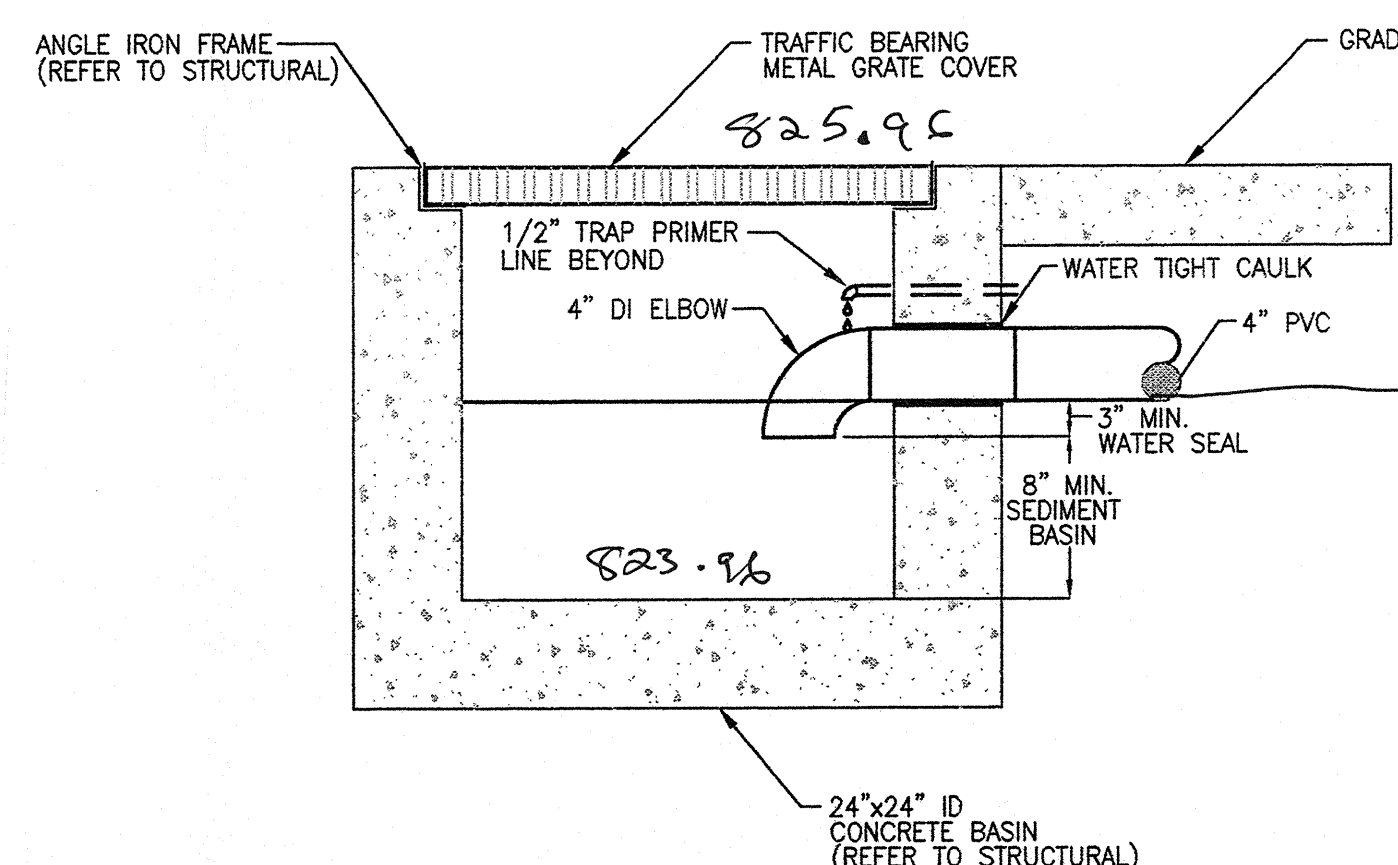


06 WASHBAY CATCH BASIN DETAIL
SCALE: NOT TO SCALE

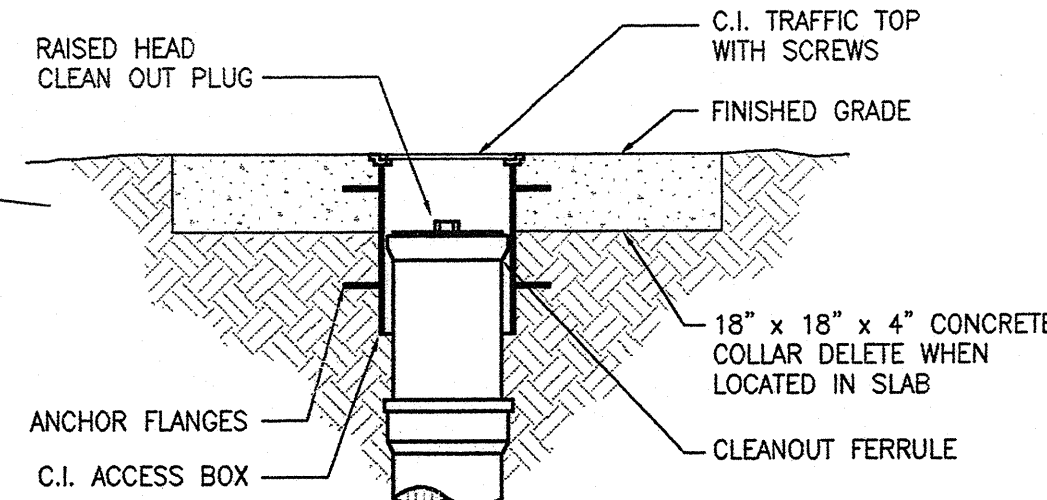


07 EXTERIOR CLEANOUT DETAIL
SCALE: NOT TO SCALE

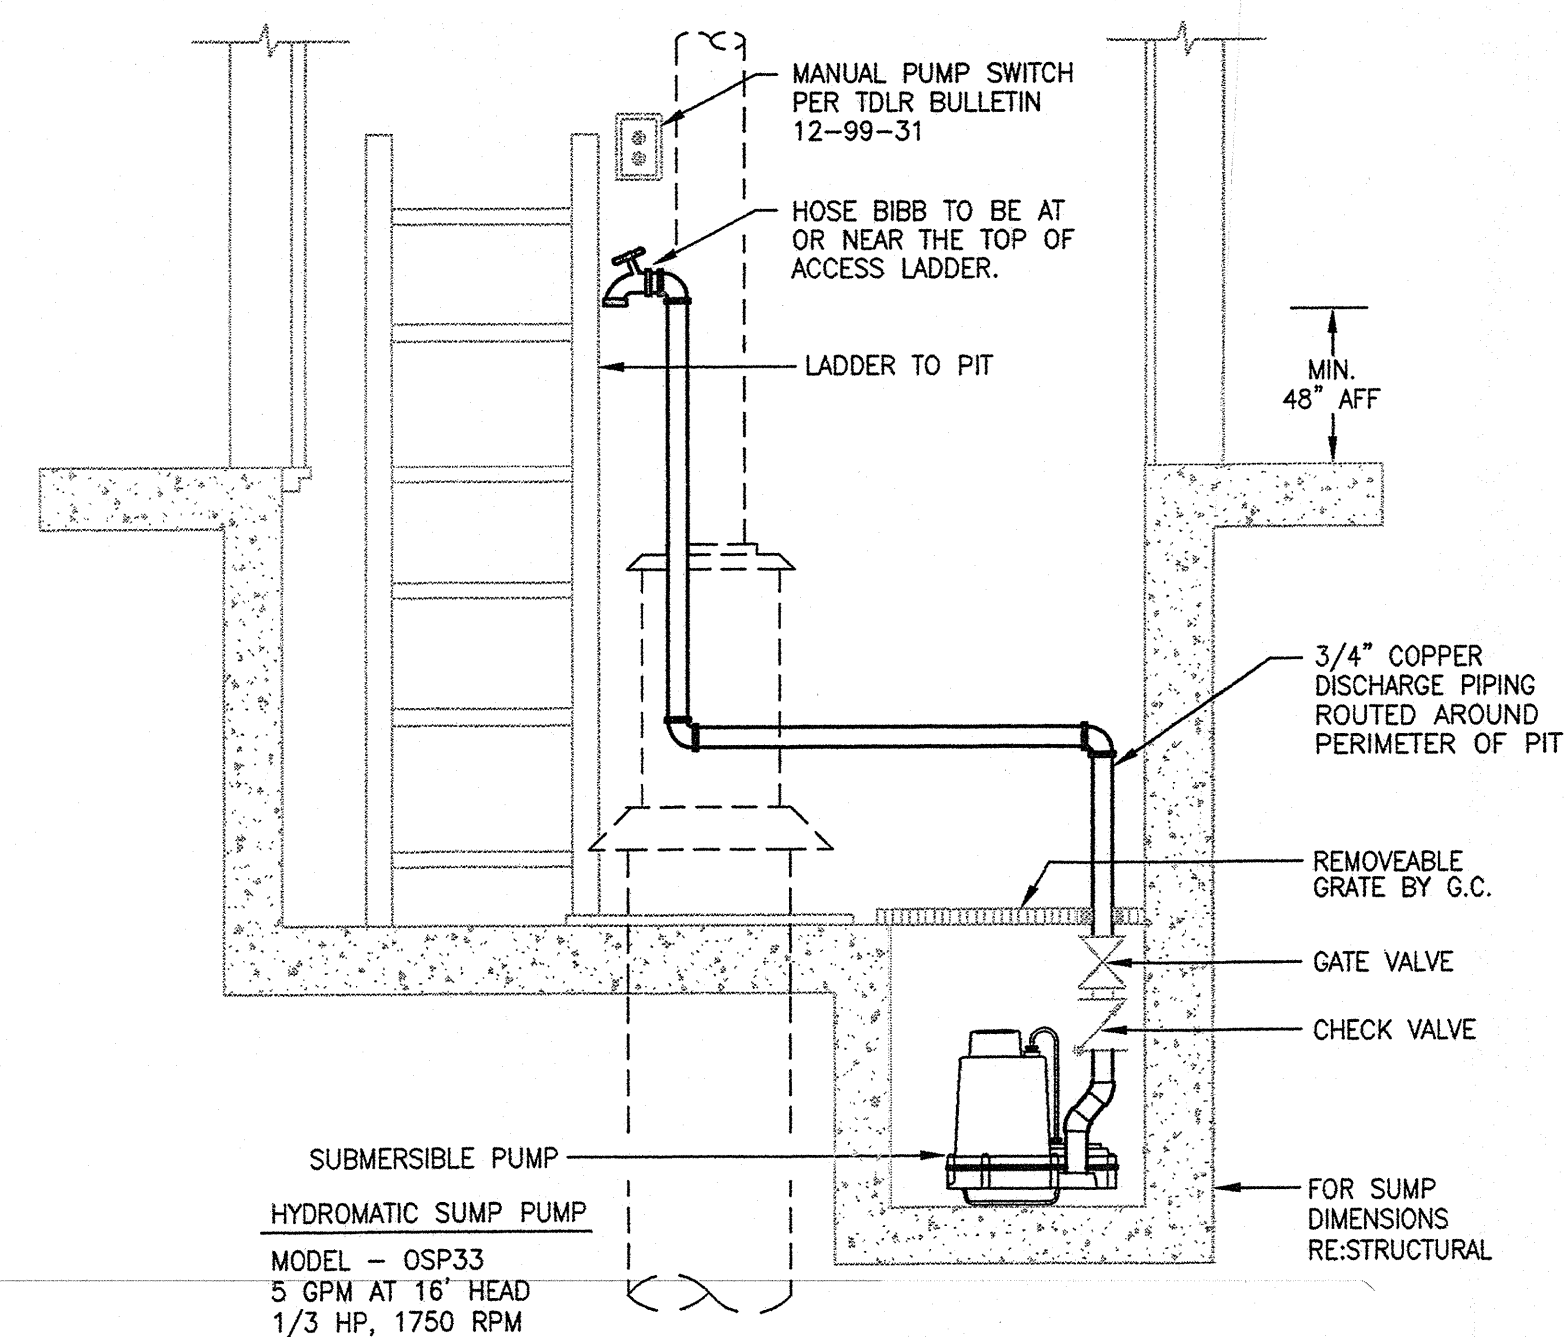

08 ELEVATOR SUMP PUMP DETAIL
SCALE: NOT TO SCALE

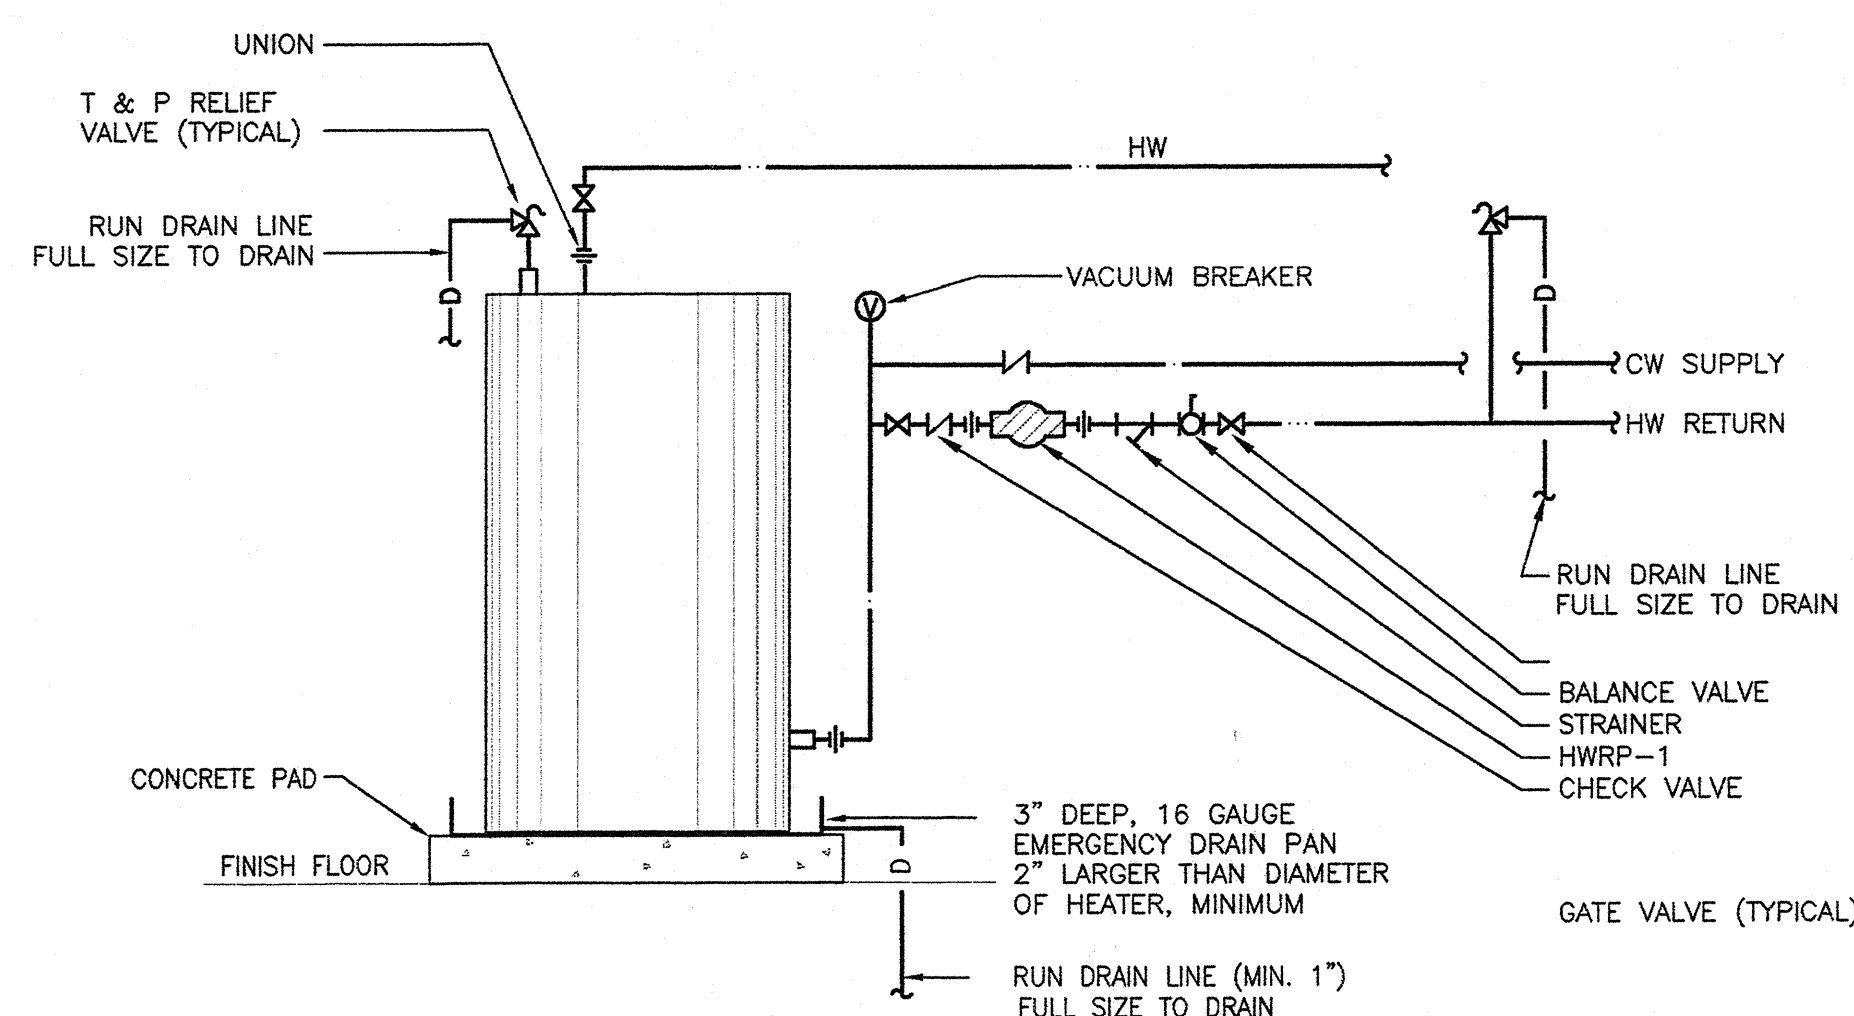

09 WATER HEATER DETAIL
N.T.S.

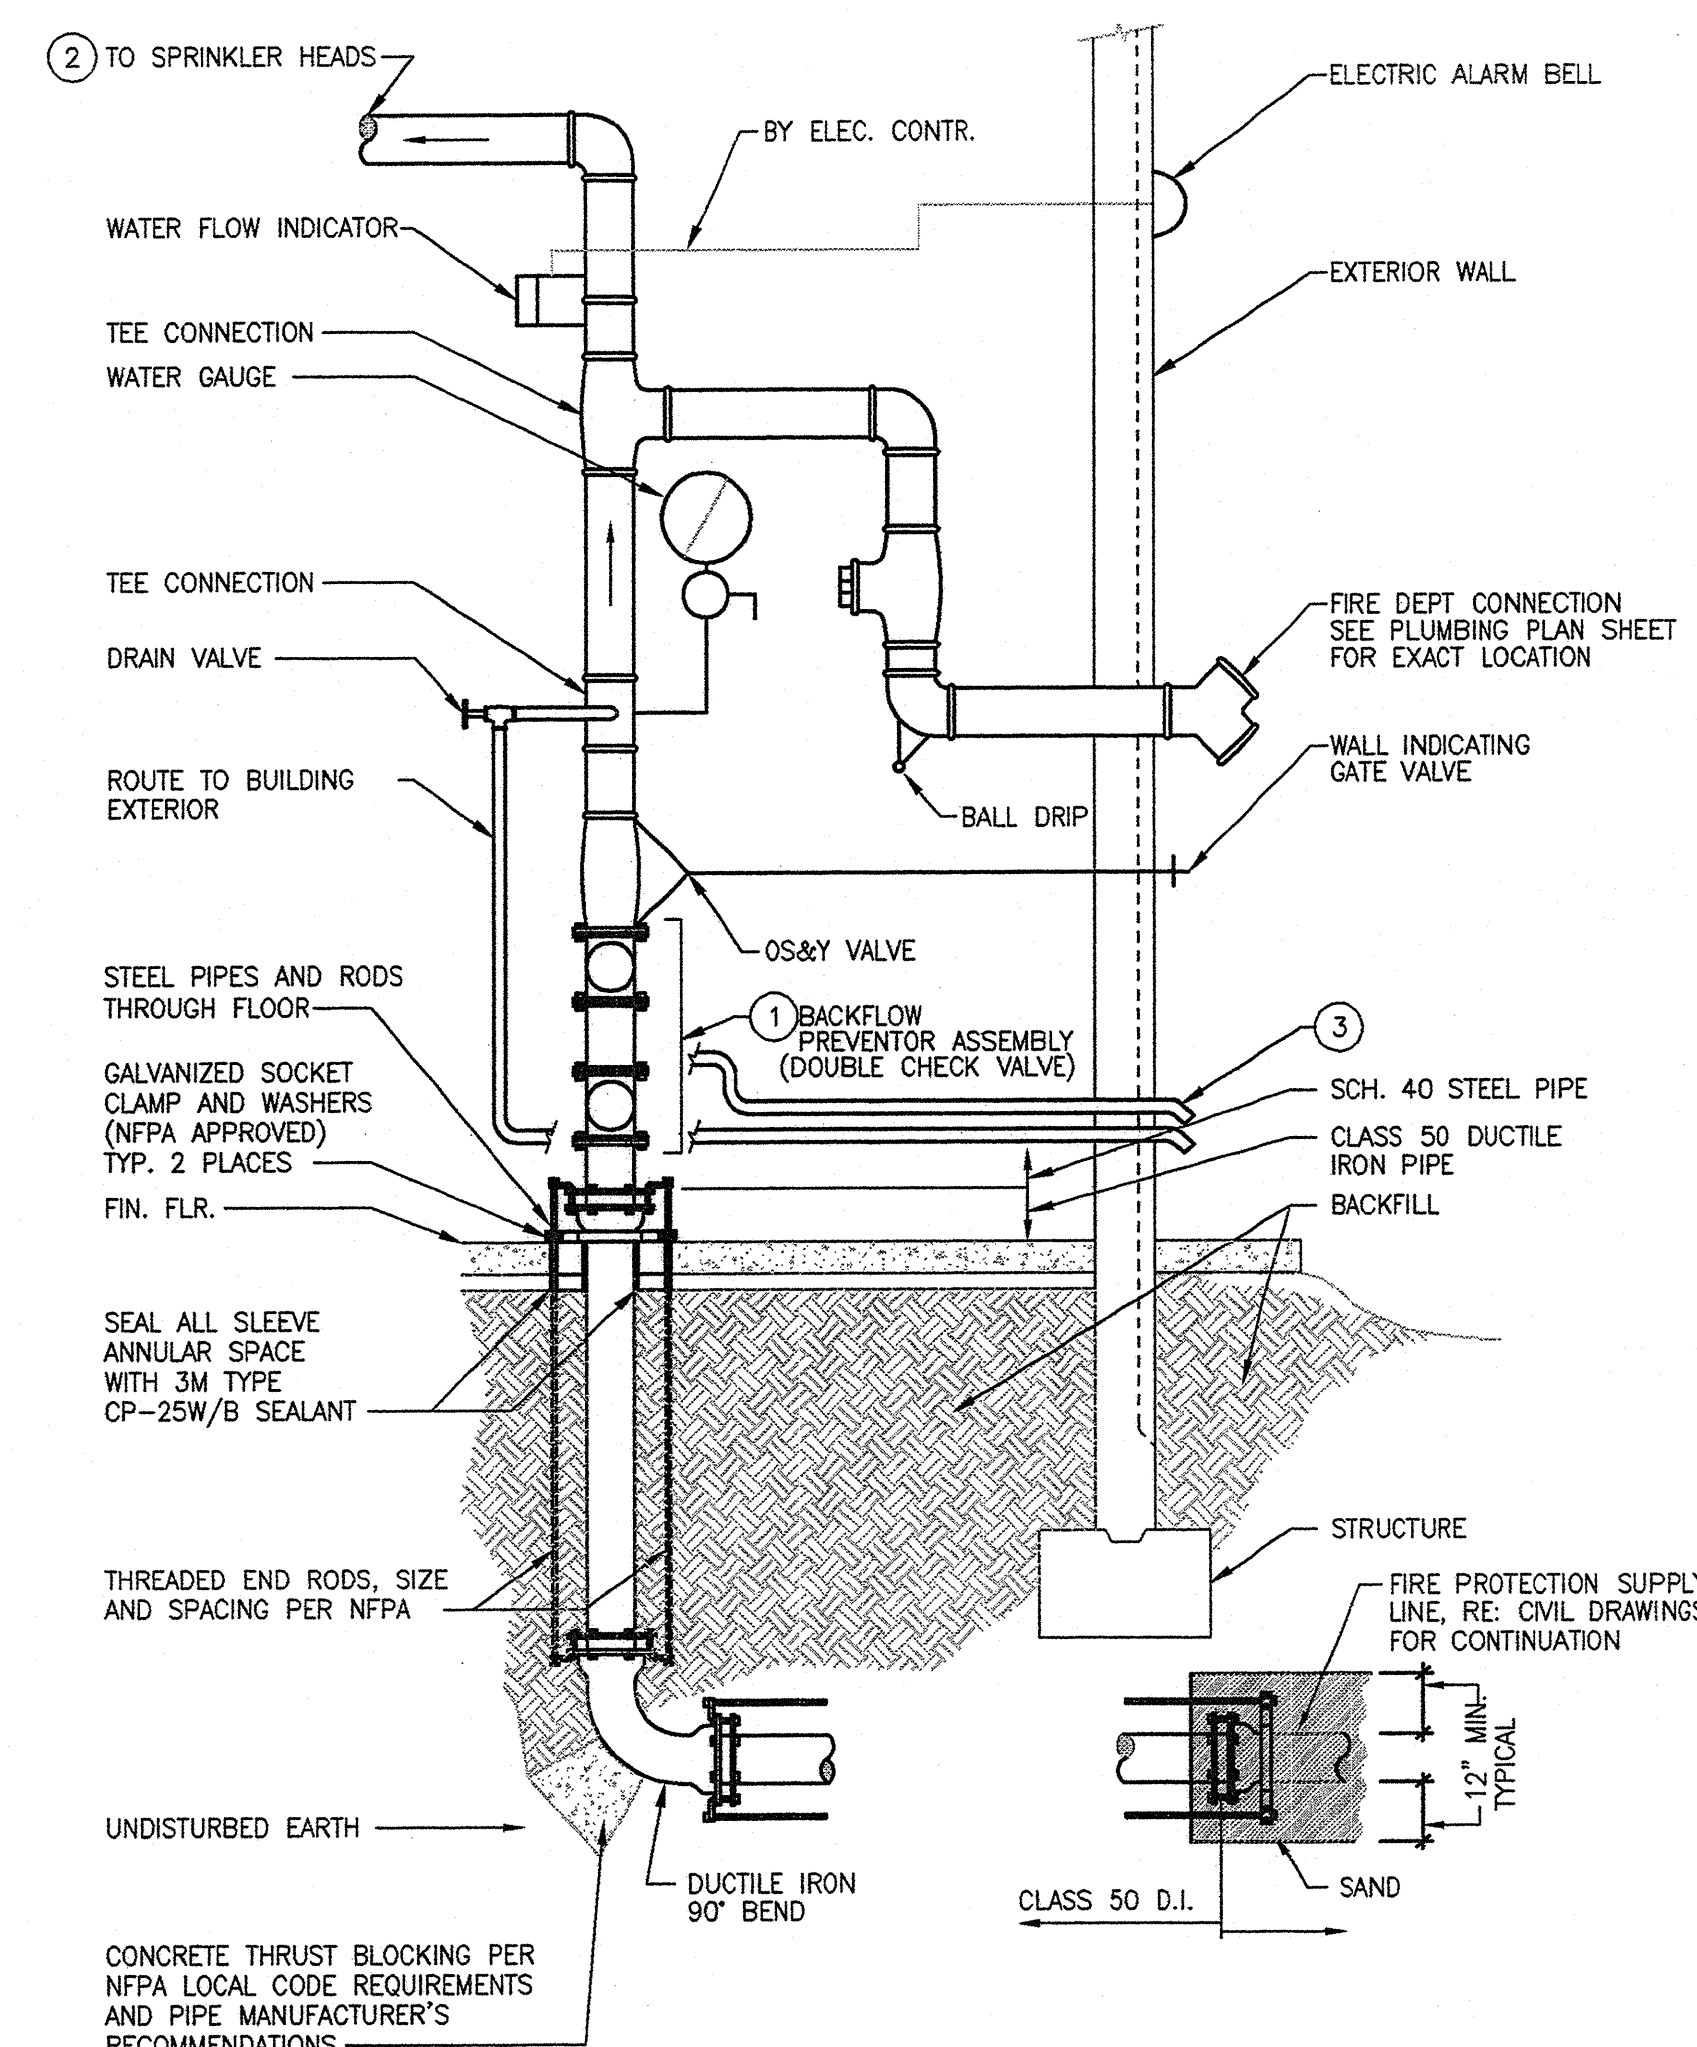

KEYED NOTES:

- BACKFLOW PREVENTER ASSEMBLY SHALL:
 - HAVE FULL UNIVERSITY OF SOUTHERN CALIFORNIA'S FOUNDATION FOR CROSS-CONNECTION CONTROL AND HYDRAULIC RESEARCH APPROVAL.
 - BE OPERATIONALLY TESTED BY A BACKFLOW TESTER REGISTERED BY THE CITY OF AUSTIN WATER AND WASTE WATER DEPARTMENT.
- REFER TO FIRE SPRINKLER SHOP DRAWINGS FOR EXACT INSTALLATION REQUIREMENTS.
- ROUTE FIRE SPRINKLER DRAIN AND BACKFLOW PREVENTER DISCHARGE THROUGH WALL TO BUILDING EXTERIOR. TERMINATE AT 45° ELBOW TURN DOWN AT 12" ABOVE PAVING.

GENERAL NOTE:
COAT ALL METAL PARTS
WITH FOSTER 60-28 MASTIC,
(UNDERGROUND ONLY)


Myers & Associates

This document, the ideas and designs incorporated herein are and shall remain the property of Myers & Associates. These documents are not to be used or altered, in whole or in part, for other than the original intended use, nor are they to be assigned to any third party without written permission from Myers & Associates. ©
M & A Job no: 01-016

AN AUTOMOTIVE DEALERSHIP
ROGER BEASLEY VOLVO
INTERSTATE HIGHWAY 35 SOUTH
GEORGETOWN, TEXAS

ELSSER ARCHITECTURAL INC.
ARCHITECTURE AND PLANNING
P.O. BOX 883 GEORGETOWN, TX 78627
610 550-5553 FAX (610) 550-5811 www.elser-h.com

CONSULTANT SEAL:

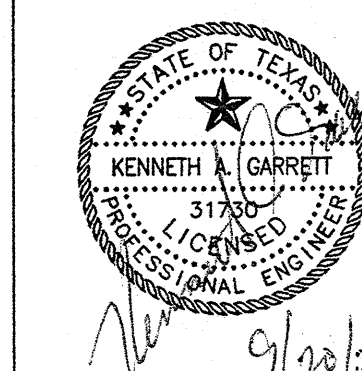

DATE: 09/20/07

REVISION DATE:

PROJECT NO.
020008

SHEET NO.

P2.2

FIXTURE AND EQUIPMENT SCHEDULE					
MARK	FIXTURE / EQUIPMENT	MODEL NO.	SIZE / CAPACITY	TRIM / ACCESSORIES	REMARKS
WC-1	WATER CLOSET	AMERICAN STANDARD 3043.102 MADERA 17" H EL	FLUSH VALVE TOP SPUD	WHITE, CHURCH 9500C SEAT, WITH SLOAN ROYAL 111 FLUSH VALVE	ADA COMPLIANT 1.6 GPF, 10" ROUGH-IN
WC-2	WATER CLOSET	AMERICAN STANDARD 2234.015 MADERA EL	FLUSH VALVE TOP SPUD	WHITE, CHURCH 9500C SEAT, WITH SLOAN ROYAL 111 FLUSH VALVE	1.6 GPF, 10" ROUGH-IN
UR-1	URINAL	AMERICAN STANDARD 6501.010 WASHBROOK	FLUSH VALVE TOP SPUD	WHITE, WITH SLOAN ROYAL 186.1 FLUSH VALVE, AND SS STRAINER	ADA COMPLIANT 1.0 GPF MOUNT UR-1 AT ADA HEIGHT
L-1	COUNTER MOUNT LAVATORY	AMERICAN STANDARD 0476.028 AQUALYN	20.5" X 17" OVAL	WHITE, WITH 2385.403 FAUCET, SUPPLIES WITH STOPS, WALL HANGER, CHROME PLATED P-TRAP, STRAINER DRAIN & SUPPLY INSUL. PER A.D.A. REQUIREMENTS	ADA COMPLIANT
L-2	WALL MOUNT LAVATORY	AMERICAN STANDARD 0321.026 DECLYN	19" X 17"	WHITE, WITH 2385.403 FAUCET, SUPPLIES WITH STOPS, WALL HANGER, CHROME PLATED P-TRAP, STRAINER DRAIN & SUPPLY INSUL. PER A.D.A. REQUIREMENTS	ADA COMPLIANT
SK-1	SINGLE COMP. KITCHEN SINK STAINLESS STEEL	ELKAY GEGR-2521L	25" X 21"	LK-4100F FAUCET, LK-35-L DRAIN	ADA COMPLIANT THREE FAUCET HOLES
SK-2	BAR SINK STAINLESS STEEL	ELKAY BLRAD1516-55	15" X 15"	LK-2432 FAUCET, LK-35-L DRAIN	ADA COMPLIANT TWO FAUCET HOLES
MS-1	FLOOR MOUNT SERVICE SINK	FIAT MSB-2424	24" X 24"	WITH 830-AA FAUCET, 832-AA HOSE/ BRACKET, E-77-AA VINYL BUMPER GUARD, MSB-2424 SS WALL GUARD, DRAIN AND P-TRAP	
EWC	DUAL HEIGHT DRINKING FOUNTAIN	ELKAY EZSTLBC		WITH ELKAY LKAPREZL APRON, 8.0 GPH, 120V/1P, 3.7 AMPS, 325 WATTS	A.D.A. COMPLIANT
EW	EMERGENCY EYE/FACE WASH	HAWS 7000BT		PROVIDE WITH THERMOSTATIC MIXING VALVE	A.D.A. COMPLIANT
WH-1	WATER HEATER	A.O. SMITH DEN-52	50 GALLON (2) 4500 WATT ELEMENTS	208 V., 1-PH. ELECTRICAL SERVICE WIRED FOR NON-SIMULTANEOUS OPERATION	23 GPH @ 80°F RISE
FD-1	FLOOR DRAIN	ZURN ZN-415	3" PIPE SIZE	WITH 6" DIA. TYPE B STRAINER, P-TRAP WITH TRAP PRIMER CONNECTION	POLISHED NICKEL BRONZE FINISH
FD-2	FLOOR DRAIN	ZURN ZN-415	3" PIPE SIZE	WITH 6" DIA. TYPE H TRAFFIC RATED STRAINER, P-TRAP WITH TRAP PRIMER CONNECTION	POLISHED NICKEL BRONZE FINISH
FD-3	CATCH BASIN		4" PIPE SIZE	FABRICATED CATCH BASIN PROVIDE TRAP PRIMER CONNECTION	REFER TO DETAIL
FD-4	FLOOR DRAIN	ZURN ZN-415	3" PIPE SIZE	WITH 6" DIA. TYPE B STRAINER, ZN-328 (6") FUNNEL, P-TRAP WITH TRAP PRIMER CONNECTION	POLISHED NICKEL BRONZE FINISH
HD	HUB DRAIN	ZURN ZN-326	2" PIPE SIZE	INDIRECT WASTE DRAIN (6" FUNNEL), P-TRAP WITH TRAP PRIMER CONNECTION	
SA	SHOCK ARRESTOR	ZURN SHOKTROL	2" PIPE SIZE	BELLOWS TYPE	
TP	TRAP PRIMER	PRECISION PLUMBING PR-500		1/2" COPPER FITTINGS	
WCO	WALL CLEANOUT	ZURN Z-1441-BP		COATED CAST IRON BODY W/ THREADED BRONZE PLUG, ROUND SS COVER	
FCO	FLOOR CLEANOUT	ZURN ZN-1400-K-BP		COATED CAST IRON BODY W/POL. NICKEL-BRONZE TOP, THREADED BRONZE PLUG, ANCHOR FLANGE	
ECO/DCO	EXTERIOR CLEANOUT	ZURN ZN-1400-HB-K-BP		COATED CAST IRON BODY W/ HEAVY DUTY TOP, THREADED BRONZE PLUG, ANCHOR FLANGE	
IM	REFRIGERATOR/ICE/MAKER WALL BOX	DAITY 36680		HIGH IMPACT POLYSTYRENE RECESSED BOX WITH FACEPLATE, 1/4 TURN COMPRESSION VALVE, 1/2" CPVC TUBING	3 SPEED (SET AT SPEED 1)
HWRCP	HOT WATER RECIRCULATION PUMP	GRUNDFOS UPS 15-42F	3 GPM @ 7 FT HEAD 120 V., 0.40 A., 45 W 1/25 HP MOTOR	IN-LINE SINGLE STAGE WET ROTOR TYPE WITH MOTOR MOUNTED DIRECTLY TO THE PUMP VOLUME, PROVIDE THERMOSTAT TIMER ASSEMBLY.	
HB-1	HOSE BIBB	WOODFORD #26C SERIES	1/2"	ANTI-SIPHON WALL HYDRANT 1/2" COPPER SWEAT INLET, UNPOLISHED BRASS FINISH	FURNISH WITH METAL HANDLE
HB-2	HOSE BIBB	WOODFORD #B67C SERIES	1/2"	FREEZELESS, ANTI-SIPHON, AUTOMATIC DRAINING WALL HYDRANT W/ FLUSH BOX, 1/2" COPPER SWEAT INLET, UNPOLISHED BRASS FINISH	FURNISH WITH LOOSE KEY FOR DOOR AND FAUCET
HB-3	HOSE BIBB	WOODFORD #17C SERIES	1/2"	FREEZELESS, ANTI-SIPHON WALL HYDRANT, 1/2" COPPER SWEAT INLET, UNPOLISHED BRASS FINISH	FURNISH WITH METAL HANDLE
SMI	SAND/MUD INTERCEPTOR	HILL COUNTRY CONCRETE PRODUCTS	1500 GAL	2 COMPARTMENT CONCRETE BASIN WITH (2) 24" DIA MANHOLE LIDS	
SOI	SAND/OIL INTERCEPTOR	PARK EQUIPMENT SOCMP-750	750 GAL	2 COMPARTMENT CONCRETE BASIN WITH (2) 24" DIA MANHOLE LIDS AND COALESCEING MEDIA PACK	
	WATER SOFTENER SYSTEM			SIZE FOR 100 GPM DOMESTIC WATER DEMAND	

EQUIPMENT SCHEDULE NOTES

--- SPEEDWAY STR-1715A OR STCR-1915A STOPS AND 17 GAUGE CHROME PLATED BRASS FIXTURE P-TRAPS FOR ALL
---S, AND DRINKING FOUNTAINS UNLESS NOTED OTHERWISE.

---ER PIPING WITH TRAP PRIMERS ACCESSIBLE BEHIND ACCESS PANEL AND DOOR.

IN WATER PIPING SYSTEM.

*PROVED MANUFACTURER'S LIST.

---SULATION FOR A.D.A. COMPLIANCE; "LAV GUARD", BY TRUEBRO, INC.

GENERAL PLUMBING NOTES

- THE CONTRACTOR IS TO VISIT THE SITE PRIOR TO BID TO FAMILIARIZE HIMSELF WITH ALL CONDITIONS AS THEY EXIST. SUBMISSION OF BID INDICATES THE CONTRACTOR'S UNDERSTANDING OF EXISTING CONDITIONS AND HIS WILLINGNESS TO WORK WITH THESE CONDITIONS. NO ADDITIONAL TIME OR MONEY WILL BE ALLOTTED DUE TO LACK OF COORDINATION WITH EXISTING CONDITIONS OR OTHER TRADES.
- ALL WORK SHALL COMPLY WITH THE APPLICABLE LOCAL, STATE, AND FEDERAL CODES AND ORDINANCES. FOLLOW RECOMMENDED PRACTICES AS SET DOWN BY ASME, SMACNA, ASHRAE, NFPA, STANDARD BUILDING CODE, STANDARD MECHANICAL CODE, STANDARD PLUMBING CODE, NATIONAL ELECTRIC CODE, AGA AND OSHA, AS THEY APPLY TO THIS PROJECT, EXCEPT IN CASES WHERE STATUTES GOVERN.
- ALL CONTRACTORS SHALL COORDINATE THROUGH THE PROJECT CONSTRUCTION MANAGER.
- ALL PIPING DIMENSIONS ARE NOMINAL PIPE SIZES, PER ASTM AND ANSI STANDARDS.
- ALL EQUIPMENT CLEARANCE DIMENSIONS ARE TO NEAREST OBJECTS OR STRUCTURES SHOWN.
- TRANSITION FROM PIPE SIZE SHOWN TO EQUIPMENT. ALLOW FOR CLEARANCE BETWEEN STRUCTURAL JOISTS.
- CONFIRM LOCATION AND MOUNTING HEIGHT OF ALL PLUMBING EQUIPMENT WITH OWNER AND CONSTRUCTION MANAGER AND OTHER TRADES PRIOR TO INSTALLATION.
- COORDINATE PLACEMENT AND SUPPORTS FOR ALL EQUIPMENT WITH STRUCTURAL ENGINEER DURING STRUCTURAL SHOP DRAWING PHASE.
- BEFORE ANY CUTTING OR TRENCHING OPERATIONS BEGIN, VERIFY WITH OWNER'S REPRESENTATIVE UTILITY COMPANIES AND OTHER INTERESTED PARTIES THAT ALL AVAILABLE INFORMATION HAS BEEN PROVIDED CONCERNING EXISTING UTILITY LOCATION. VERIFY LOCATIONS GIVEN, CONTACT ARCHITECT UPON UNCOVERING UNKNOWN UTILITIES FOR FURTHER DIRECTION. INDICATE ALL UNCOVERED UTILITIES ON RECORD DRAWINGS. COORDINATE ALL UTILITY TIE-INS WITH OWNER.
- FIRE SEAL AROUND ALL PIPING AT PENETRATIONS THROUGH FIRE WALLS, CEILINGS AND TUNNELS.
- MAINTAIN MINIMUM CLEARANCES AROUND EQUIPMENT ACCESS AREAS PER MANUFACTURER'S RECOMMENDATIONS.
- PROVIDE ENGRAVED LABELS FOR ALL EQUIPMENT AND ASSOCIATED SUPPORT EQUIPMENT.
- THE PLUMBING CONTRACTOR IS TO COORDINATE THE ELECTRICAL CHARACTERISTICS OF ALL EQUIPMENT WITH THE ELECTRICAL CONTRACTOR PRIOR TO ELECTRICAL ROUGH-IN. NO ADDITIONAL TIME OR MONEY WILL BE ALLOTTED DUE TO LACK OF COORDINATION.
- THE CONTRACTOR IS TO DEMONSTRATE OPERATION OF PLUMBING EQUIPMENT AND RELATED SYSTEMS TO MAINTENANCE PERSONNEL UPON COMPLETION OF THE PROJECT. THE CONTRACTOR SHALL SUBMIT THREE (3) SETS OF SPARE PARTS LISTS, MANUALS AND OPERATING PROCEDURES FOR ALL EQUIPMENT TO PERSONNEL AT THE TIME OF DEMONSTRATION. PROVIDE OWNER WITH A TYPED LIST OF ALL NEW AND EXISTING EQUIPMENT, INDICATING MANUFACTURER, MODEL NUMBER, SERIAL NUMBER, VOLTAGE, PHASE, HORSEPOWER RATINGS, ETC.
- FIELD LOCATE AND ROUTE ALL REQUIRED PIPING THAT IS NOT CLEARLY SHOWN IN THE DRAWINGS.
- ALL HOT AND COLD WATER PIPING TO BE ENTIRELY INSULATED PER THE PROJECT SPECIFICATIONS.
- THE DRAWINGS ARE DIAGRAMMATIC ONLY AND SHALL NOT BE SCALED. THE CONTRACTOR IS RESPONSIBLE FOR COORDINATING WITH ALL OTHER TRADES AND WITH EXISTING CONDITIONS. THE CONTRACTOR SHALL NOT INSTALL OR FABRICATE ANY WORK SHOWN UNTIL ALL SUCH WORK IS FULLY COORDINATED. NOT ALL OFFSETS AND FITTINGS ARE SHOWN. PROVIDE OFFSETS AND FITTINGS AS REQUIRED BY FIELD CONDITIONS AT NO ADDITIONAL COSTS TO THE OWNER.
- GUARANTEE WORK FOR ONE (1) YEAR FROM THE DATE OF FINAL ACCEPTANCE OF THE PROJECT AND DURING THAT PERIOD MAKE GOOD ANY FAULTS OR IMPERFECTIONS THAT MAY ARISE DUE TO DEFECTS OR OMISSIONS IN MATERIALS OR WORKMANSHIP.
- SYMBOLS ARE ILLUSTRATIVE IN NATURE AND ARE PROVIDED ONLY FOR USE OF REFERENCE.
- PLUMBING CONTRACTOR SHALL PROVIDE ALL INCIDENTAL PARTS AND FITTINGS TO MAKE FOR A COMPLETE INSTALLATION OF ALL PLUMBING EQUIPMENT AND FIXTURES.
- AFTER WASTEWATER PIPING IS TESTED PER CODE, CONTACT OWNER FOR OBSERVATION OF FLOOR DRAINS TO CHECK FOR PROPER DRAINAGE.

PLUMBING ABBREVIATION

AFF	ABOVE FINISHED FLOOR	IWH	INSTANTANEOUS WATER HEATER
BFP	BACKFLOW PREVENTOR	LAV	LAVATORY
BFF	BELOW FINISHED FLOOR	MECH	MECHANICAL
CLD	CLOTHES DRYER	NTS	NOT TO SCALE
CLW	CLOTHES WASHER	NO.	NUMBER
CO	CLEANOUT	PH	PHASE
CW	COLD WATER	PLEG	PLUMBING
DIA	DIAMETER	RPZ	REDUCED PRESSURE ZONE
DCO	DOUBLE CLEAN OUT	SI	SOLIDS INTERCEPTOR
DN	DOWN	SK	SINK
DWG	DRAWING	TP	TRAP PRIMER
ECO	EXTERIOR CLEAN OUT	TYP	TYPICAL
EWC	ELECTRIC WATER COOLER	UR	URINAL
EW	ELECTRIC WATER HEATER	UNO	UNLESS NOTED OTHERWISE
FCO	FLOOR CLEAN OUT	V	VENT (PLUMBING)
FD	FLOOR DRAIN	VTR	VENT THROUGH ROOF
GW	GREASE WASTE	W/	WITH
OWH	GAS WATER HEATER	WC	WATER CLOSET
HD	HUB DRAIN	WCO	WALL CLEANOUT
HP	HORSEPOWER	WH	WATER HEATER
HT	HOT WATER	WHA	WATER HAMMER ARRESTOR
HW	HOT WATER	WCB	WASHER CONNECTION BOX
HWR	HOT WATER RETURN		

FIXTURE CONNECTION SCHEDULE

MARK	CW	HW	WASTE	VENT
WATER CLOSET (FLUSH VALVE)	1"	-	4"	2"
URINAL	3/4"	-	2"	2"
LAVATORY *	1/2"	1/2"	2"	1-1/2"
SINK	1/2"	1/2"	2"	1-1/2"
SERVICE SINK	3/4"	3/4"	3"	2"
EWC	1/2"	-	2"	1-1/2"

* HOT AND COLD WATER REQUIRED UNLESS NOTED OTHERWISE ON PLUMBING FIXTURE SCHEDULE.

PLUMBING CALCULATIONS

FIXTURE	QUANTITY		WATER F.U.		SEWER F.U.	
	NEW	EXISTING	EACH	TOTAL	EACH	TOTAL
WC	12		10	120	6	72
UR	3		5	15	4	12
LAV	13		2	26	1	13
SINK (GENERAL)	3		2	6	2	6
SINK (SERVICE)	1		3	3	3	3
EWC	2		0.25	0.5	0.5	1
CATCH BASIN	4				8	32
C.W. TOTAL GPM			171 FU	83 GPM		
S. S. TOTAL GPM						139 FU

1997 SPC TABLE E102:

Myers & Associates

This document, the ideas and designs incorporated herein are and shall remain the property of Myers & Associates. These documents are not to be used or altered, in whole or in part, for other than the original intended use, nor are they to be assigned to any third party without written permission from Myers & Associates. ©

M & A Job no.: 01-016


AN AUTOMOTIVE DEALERSHIP

ROGER BEASLEY VOLVO

INTERSTATE HIGHWAY 35 SOUTH
GEORGETOWN, TEXAS


ELSASSER
ARCHITECTURAL
INC.

ARCHITECTURE AND PLANNING

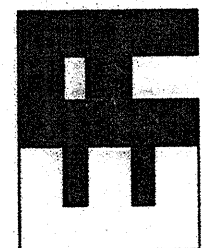

P.O. BOX 883 GEORGETOWN, TX 78627
(612) 980-5883 FAX (612) 980-2616 www.eai-b.com

CONSULTANT SEAL:

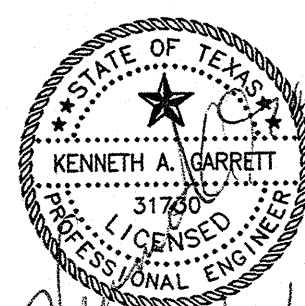


DATE: 04/20/02

REVISION DATE:

PROJECT NO.
020006

SHEET NO.

P2.3

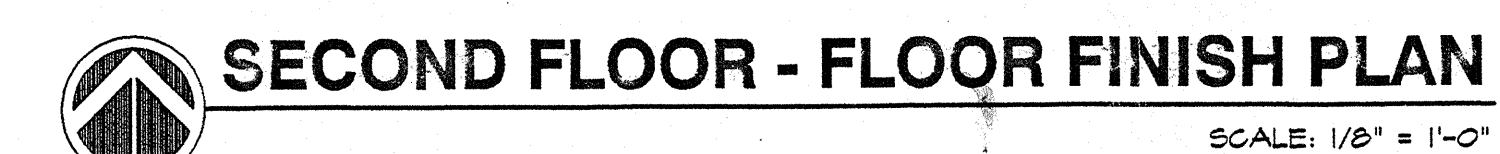

LEGEND:

CT-1	FLOOR FINISH TYPE, REFER TO A6.3 FOR SPECIFICATIONS
------	---

A9.0